
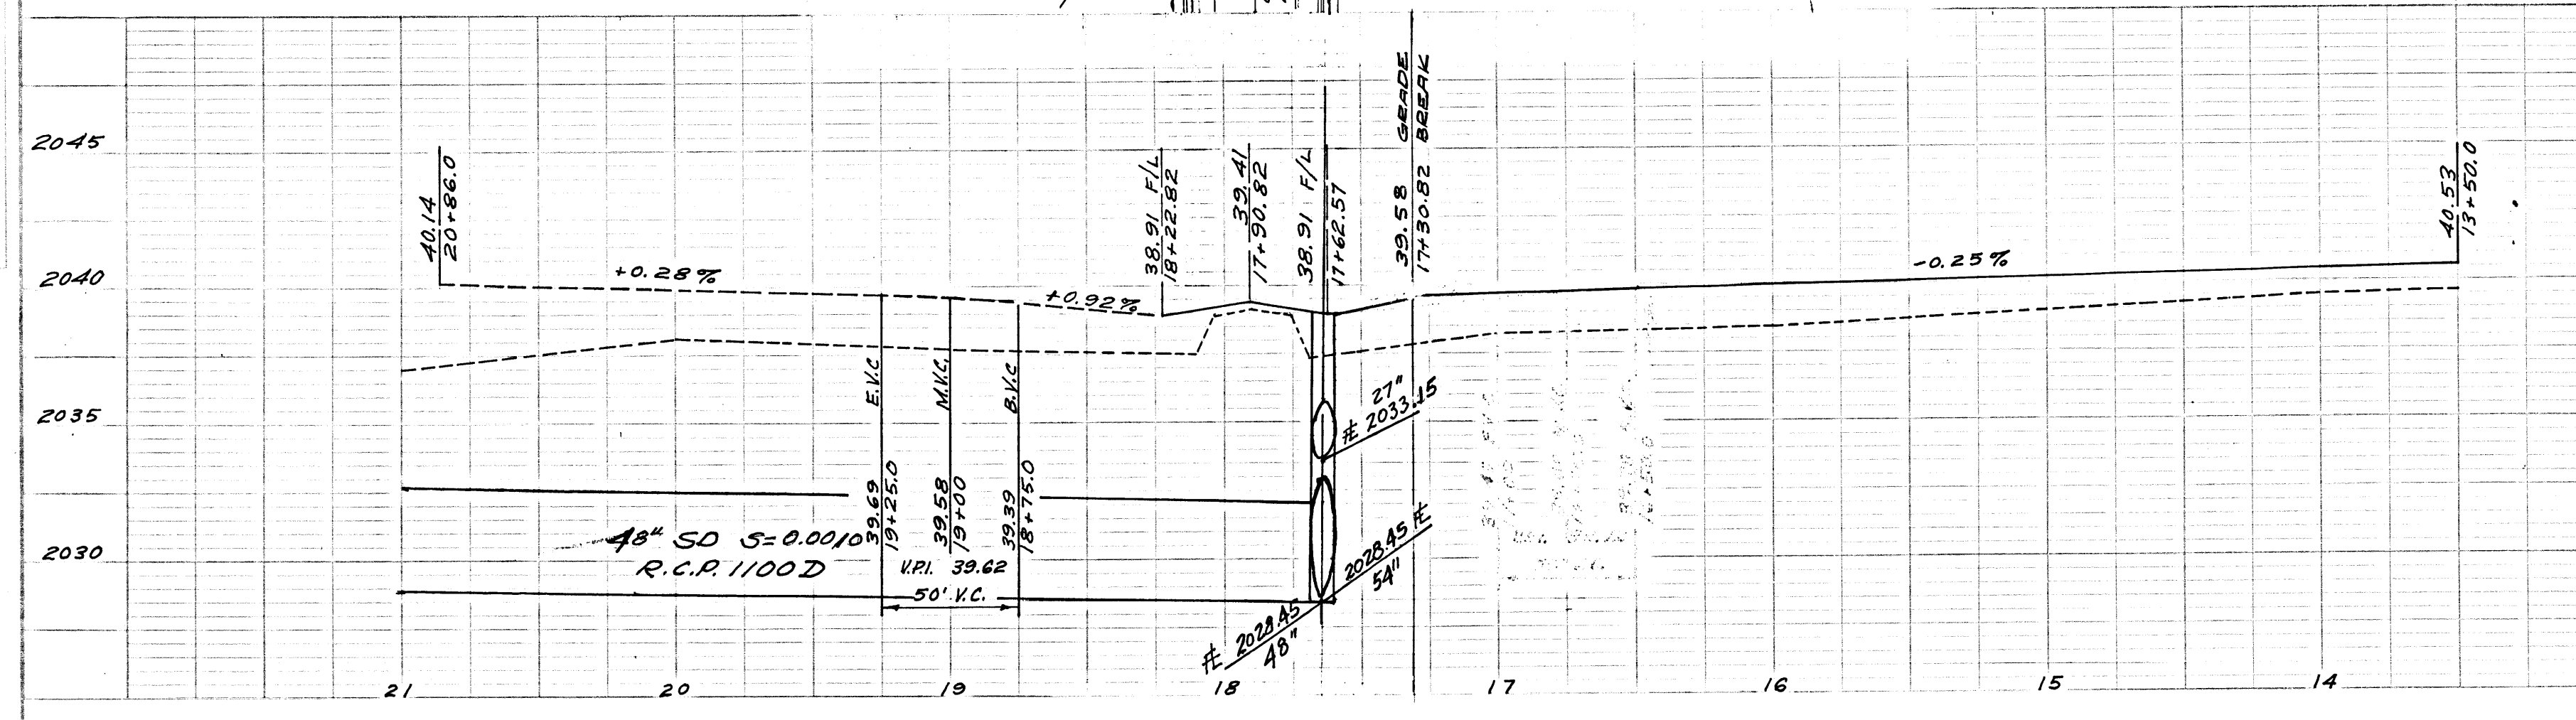
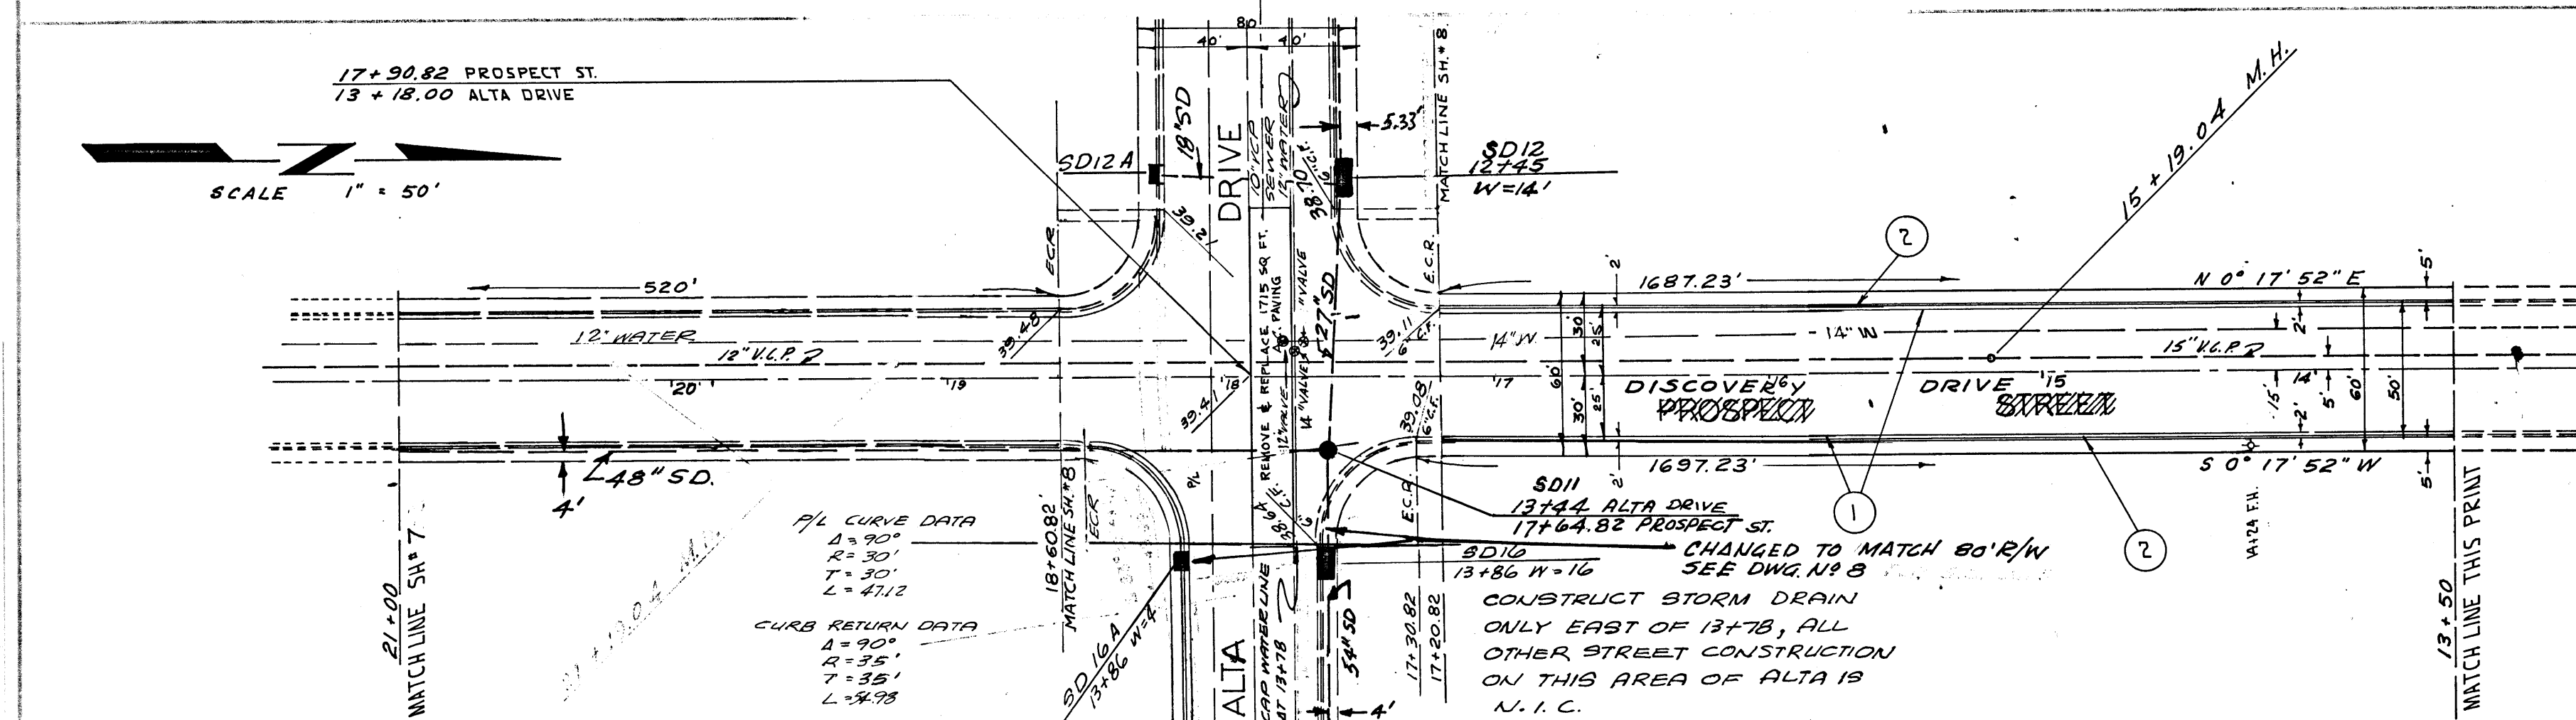



PLN
 DATE
 NOTE BOOK
 NOT CHECKED
 NO.

PLN
 DATE
 NOTE BOOK
 NOT CHECKED
 NO.

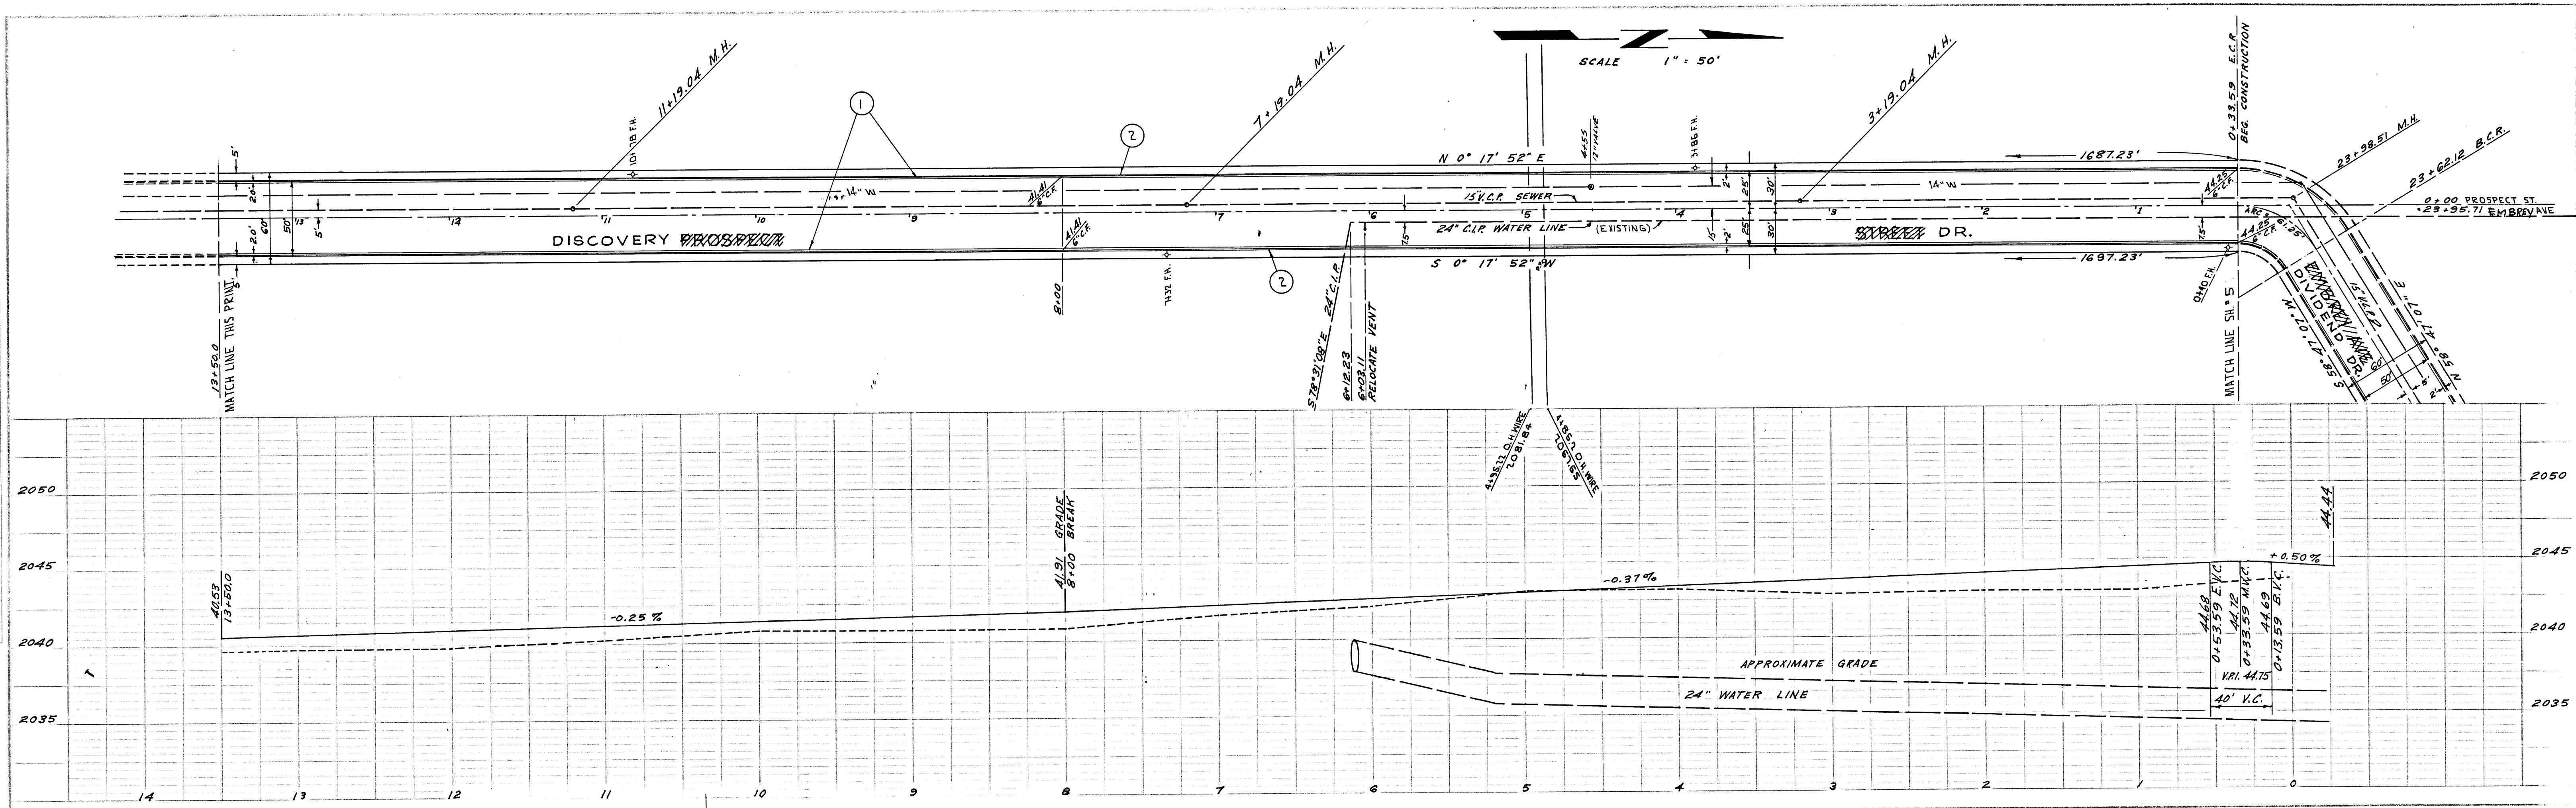

NOTE! UTILITY INFORMATION WAS DERIVED FROM DATA FURNISHED BY UTILITY COMPANIES. CONTRACTOR MUST CONFIRM LOCATION OF UTILITIES BEFORE COMMENCING EXCAVATION.

T.B.M. SPIKE IN POWER POLE N.W. COR. HIGHLAND & ALTA. ELEV. 2048.45 TO CONVERT TO CITY DATUM ADD 1.33' TO ALL ELEV.

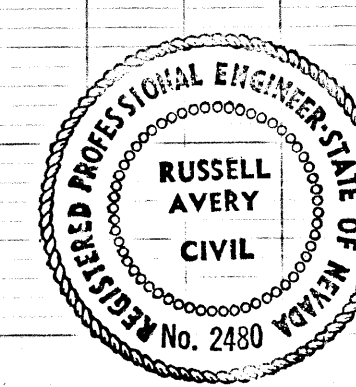

AS BUILT		
JULY 23 1970		
UNION PACIFIC RAILROAD CO		
CITY OF LAS VEGAS NEVADA		
ENGINEERING DEPT.		
DISCOVERY DR.		
STA 0+400 TO 17+31		
Assoc. <i>Russell Avery</i>	DATE 10-1-68	SC.(H) 1"=50'
DR. <i>J.D. Duda</i>	6-12-69	SC.(V) 1"=5'
		F. BK. NO.
		P. J.O. NO.
APPROVED BY CITY ENGR. <i>[Signature]</i>	6-20-69	DRAWING NO. 6