


PLAN	DATE	BY
SUBMITTED		
NOTED		
NOTED		
NOTED		
NO.		

PROFILE	DATE	BY
SUBMITTED		
NOTED		
NOTED		
NOTED		
NO.		

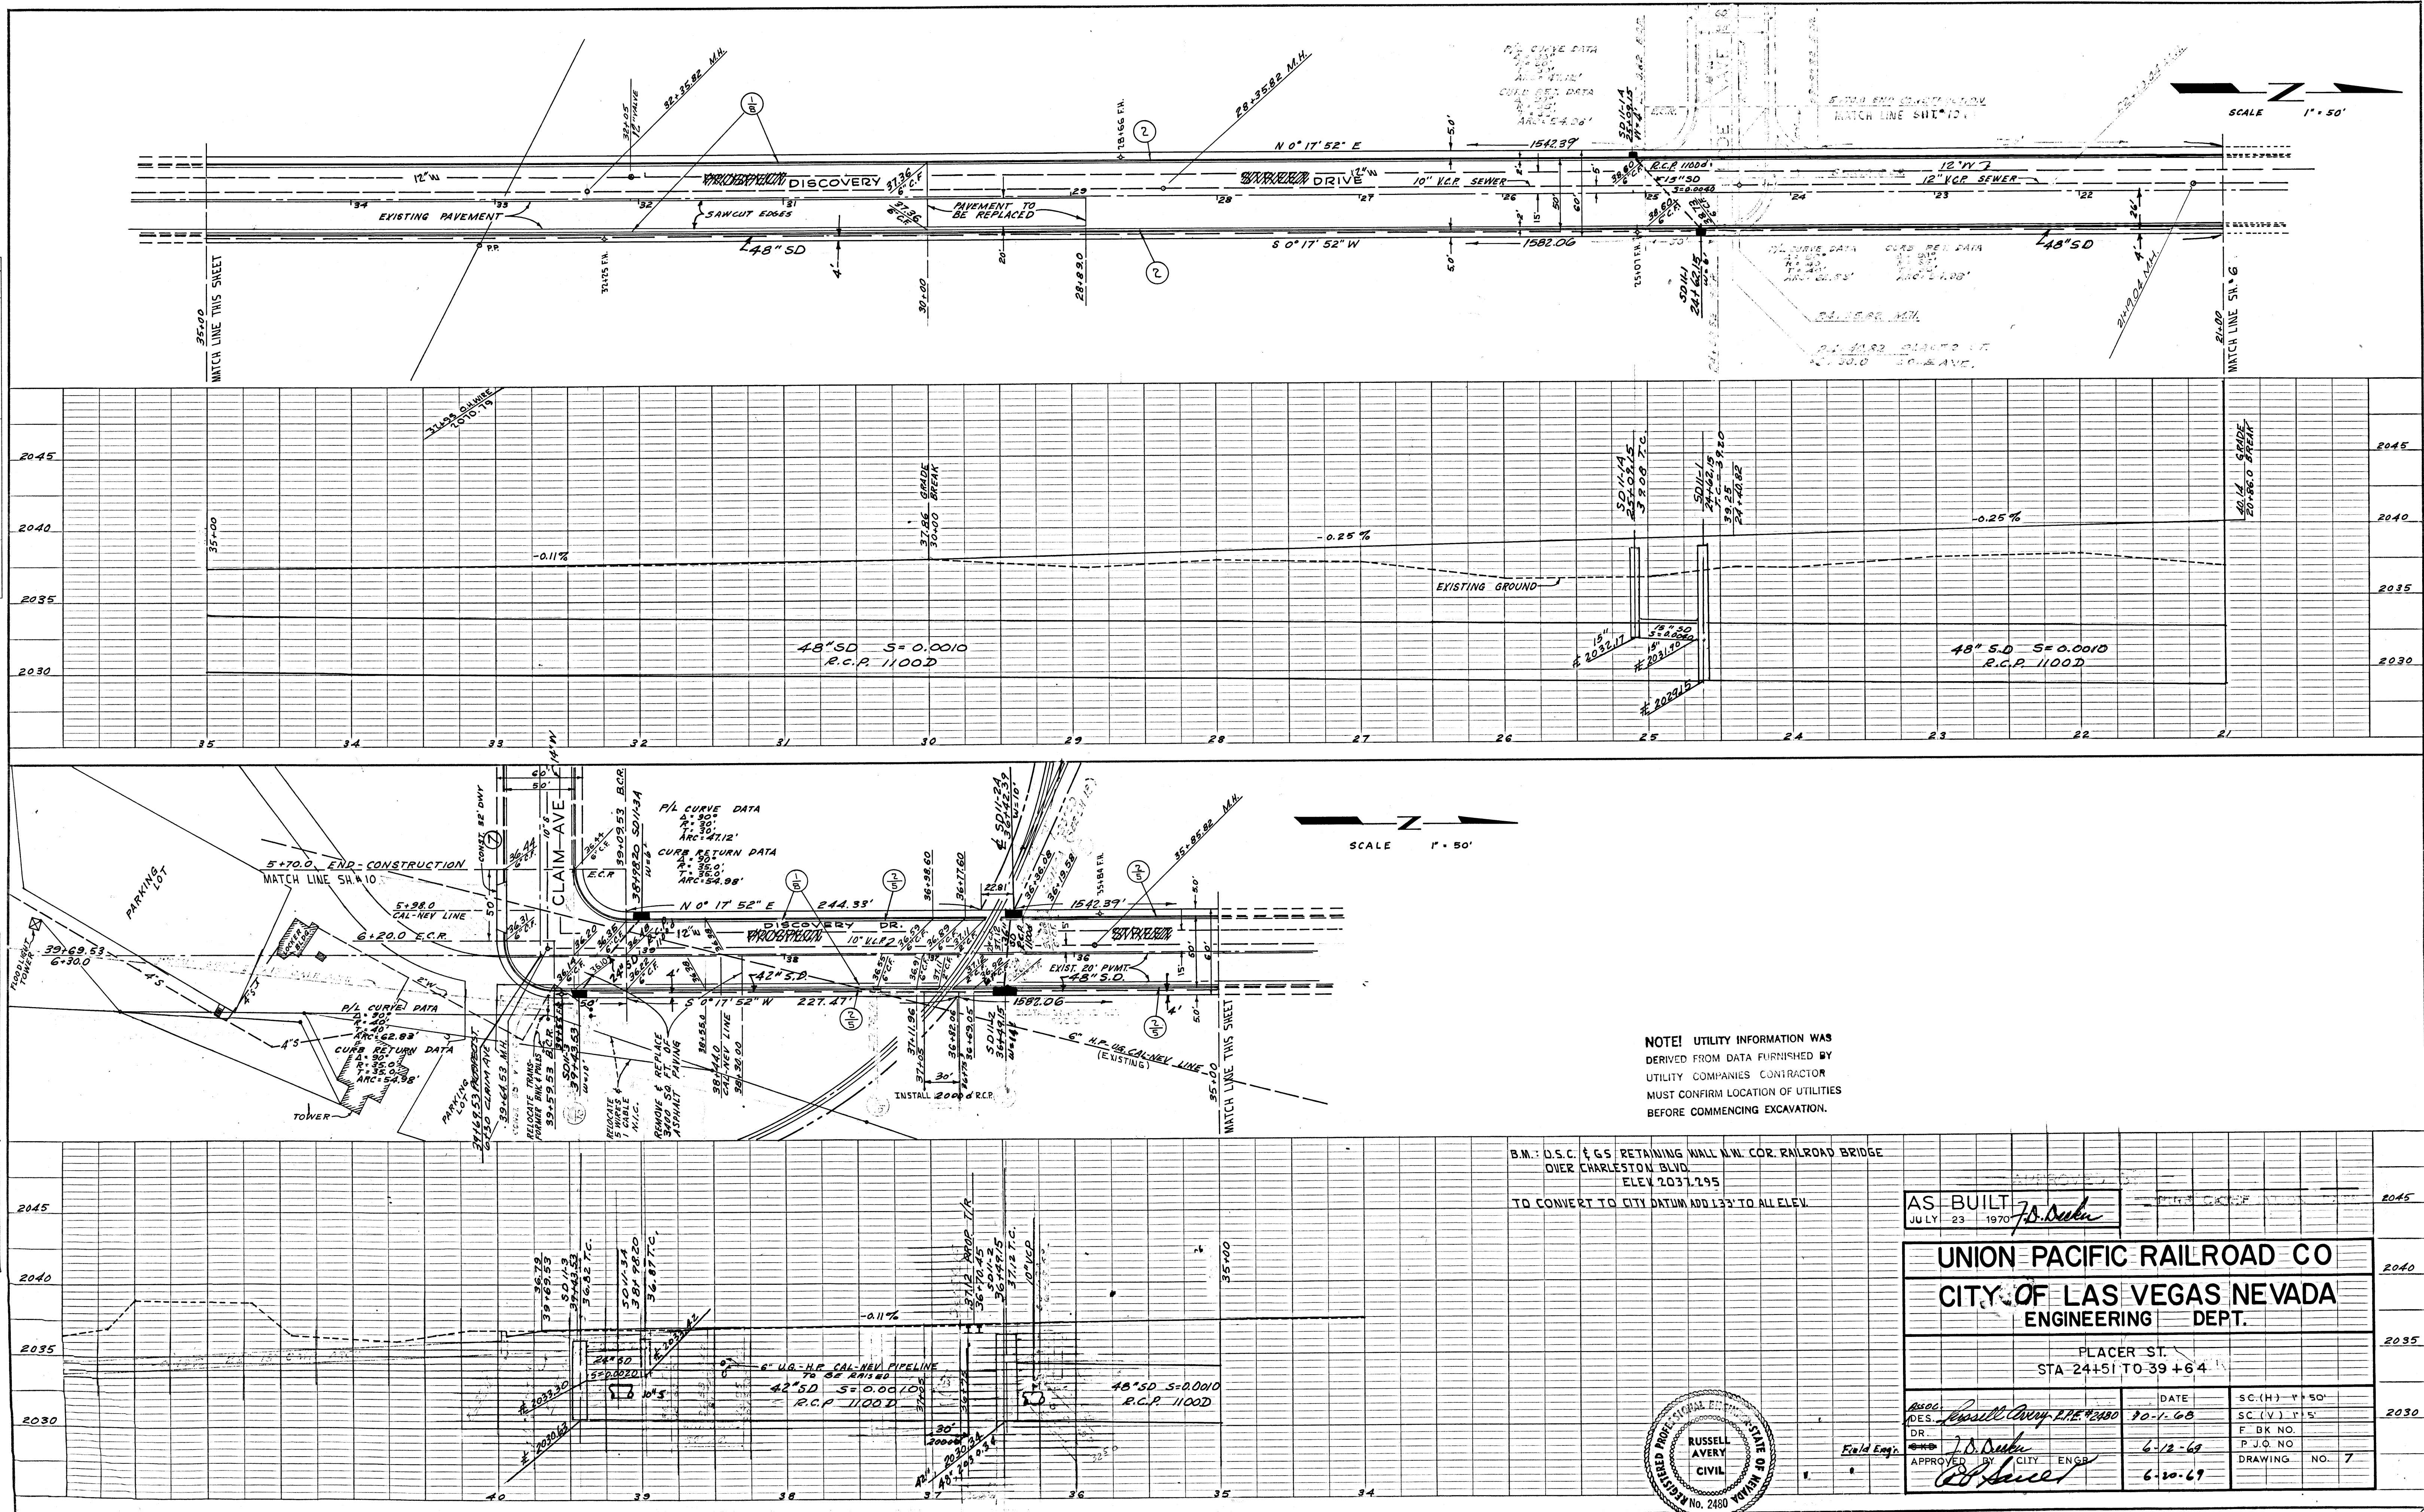

B.M.: U.S.C. & G.S. RETAINING WALL N.W. COR. RAILROAD BRIDGE
OVER CHARLESTON BLVD.
ELEV. 2031.295
TO CONVERT TO CITY DATUM ADD 1.32' TO ALLELEV.

AS BUILT		JULY 23 1970	
UNION PACIFIC RAILROAD CO			
CITY OF LAS VEGAS NEVADA			
ENGINEERING DEPT.			
PLACER ST. STA 24+51 TO 39+64			
DES. BY RUSSELL AVERY	DATE 7-1-68	SC (H) 1" = 50'	2045
DR. BY RUSSELL AVERY	DATE 6-12-68	SC (V) 1" = 5'	2040
APPROVED BY RUSSELL AVERY	DATE 6-20-69	F.B.K. NO.	2035
		P.J.O. NO.	2030
		DRAWING NO. 7	

