


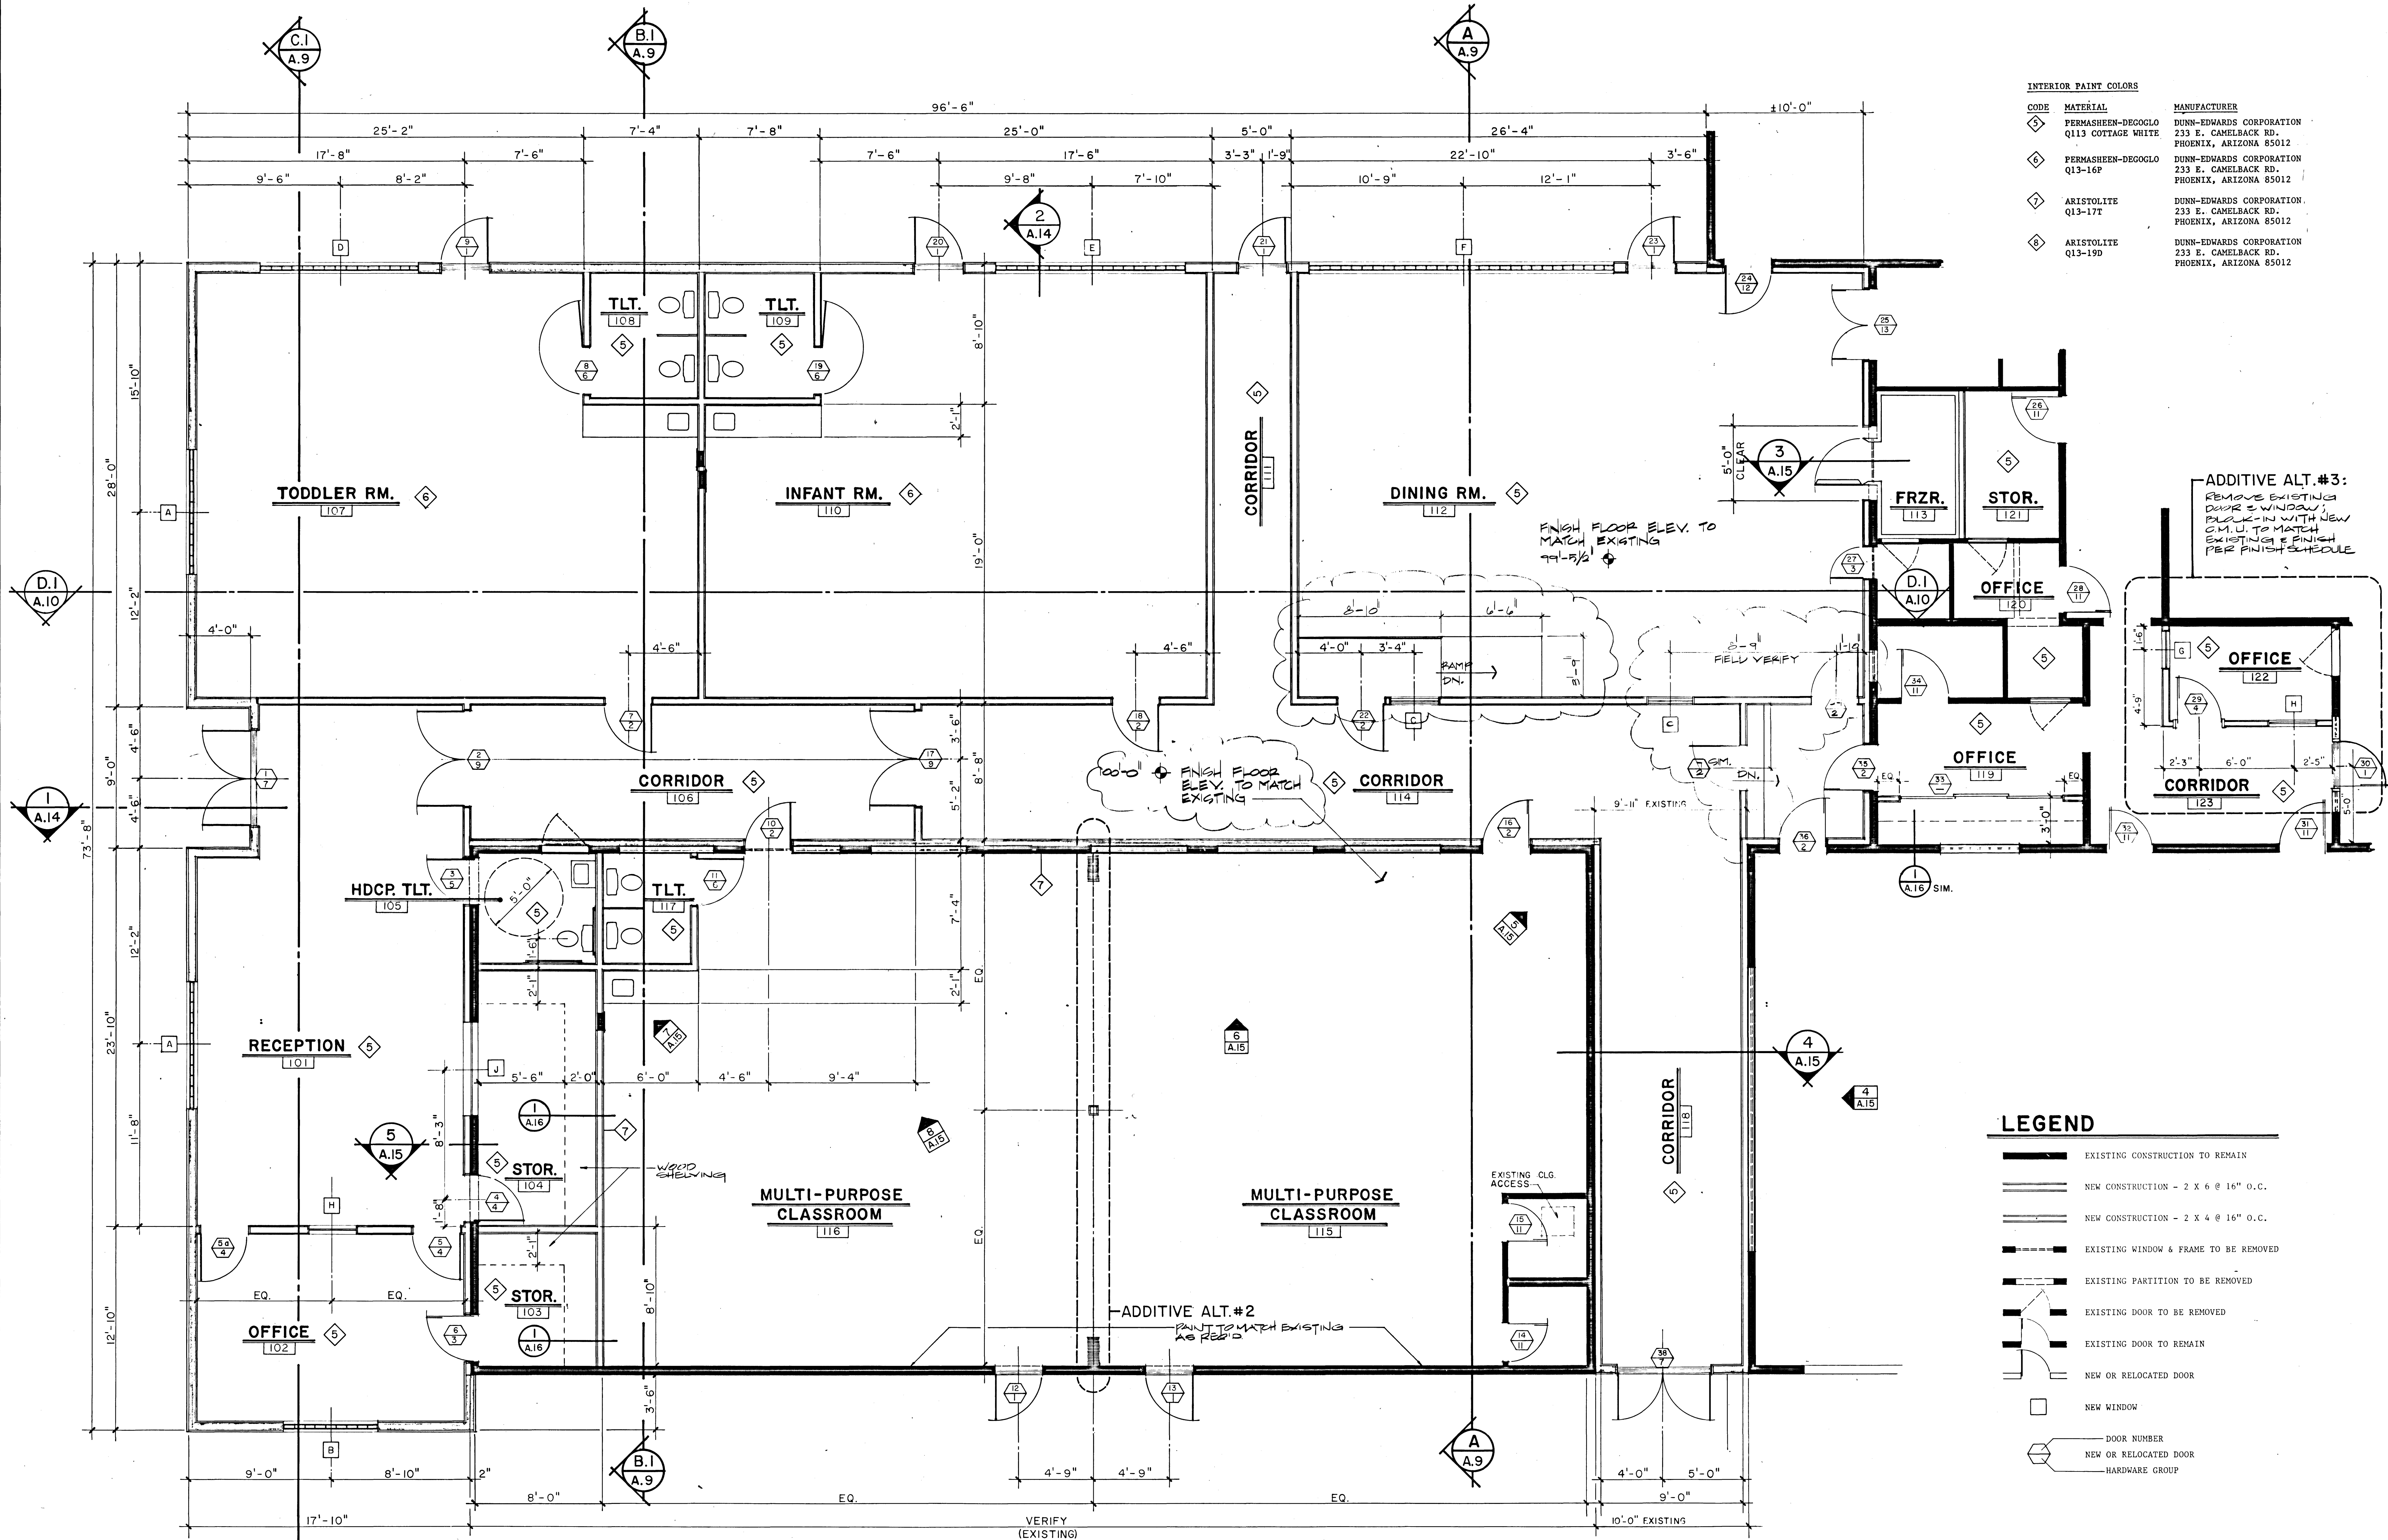

PARTIAL FLOOR PLAN (NEW CONSTRUCTION)

1/4" = 1'-0"

INTERIOR PAINT COLORS

CODE	MATERIAL	MANUFACTURER
1	PERMASHEEN-DEGLO Q113 COTTAGE WHITE	DUNN-EDWARDS CORPORATION 233 E. CANELBACK RD. PHOENIX, ARIZONA 85012
2	PERMASHEEN-DEGLO Q13-16P	DUNN-EDWARDS CORPORATION 233 E. CANELBACK RD. PHOENIX, ARIZONA 85012
3	ARISTOLITE Q13-17T	DUNN-EDWARDS CORPORATION 233 E. CANELBACK RD. PHOENIX, ARIZONA 85012
4	ARISTOLITE Q13-19D	DUNN-EDWARDS CORPORATION 233 E. CANELBACK RD. PHOENIX, ARIZONA 85012

ADDITIVE ALT.#3:
REMOVE EXISTING
DOOR & WINDOW,
PLACE IN WITH NEW
C.M.U. TO MATCH
EXISTING & FINISH
PER FINISH SCHEDULE

LEGEND

- EXISTING CONSTRUCTION TO REMAIN
- NEW CONSTRUCTION - 2 X 6 @ 16" O.C.
- NEW CONSTRUCTION - 2 X 4 @ 16" O.C.
- EXISTING WINDOW & FRAME TO BE REMOVED
- EXISTING PARTITION TO BE REMOVED
- EXISTING DOOR TO BE REMOVED
- EXISTING DOOR TO REMAIN
- NEW OR RELOCATED DOOR
- NEW WINDOW
- DOOR NUMBER
- NEW OR RELOCATED DOOR
- HARDWARE GROUP

ARCHITECT • CHAD GARARCH & ASSOCIATES A.I.A.

2000 FIFTH AVENUE, SUITE 201, LAS VEGAS, NV 89102 (702) 333-4444
2000 PASEO DEL PRADO, C-108, LAS VEGAS, NV 89102 (702) 333-4444

PHASE I (VARIETY CLUB)

"D" STREET / JEFFERSON AVENUE
NEIGHBORHOOD FACILITY PROJECT

FLOOR PLAN

drawn by: RB
issue dates:
11/3/88
11/22/88 bidding

revisions:
2/1/89 2nd bidding


job no.: 8737

A.4

12

CITY OF LAS VEGAS
400 EAST STEWART AVENUE
LAS VEGAS, NEVADA 89101

671-25

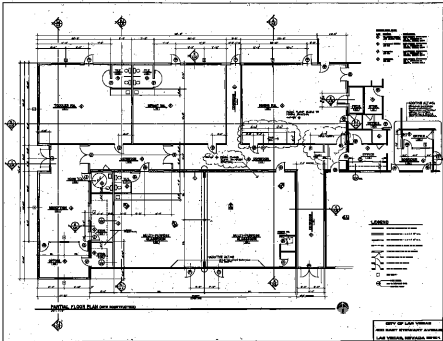

ARCHITECT - GEORGE W. HARRIS & ASSOCIATES, L.L.C.
 1000 W. 10TH STREET, SUITE 100
 LOS ANGELES, CALIFORNIA 90057

PROJECT - EXISTING FLOOR PLAN
 1000 W. 10TH STREET, SUITE 100
 LOS ANGELES, CALIFORNIA 90057

DATE - 10/1/00

PROJECT - EXISTING FLOOR PLAN

DATE - 10/1/00

A. 4
 12

10/1/00