




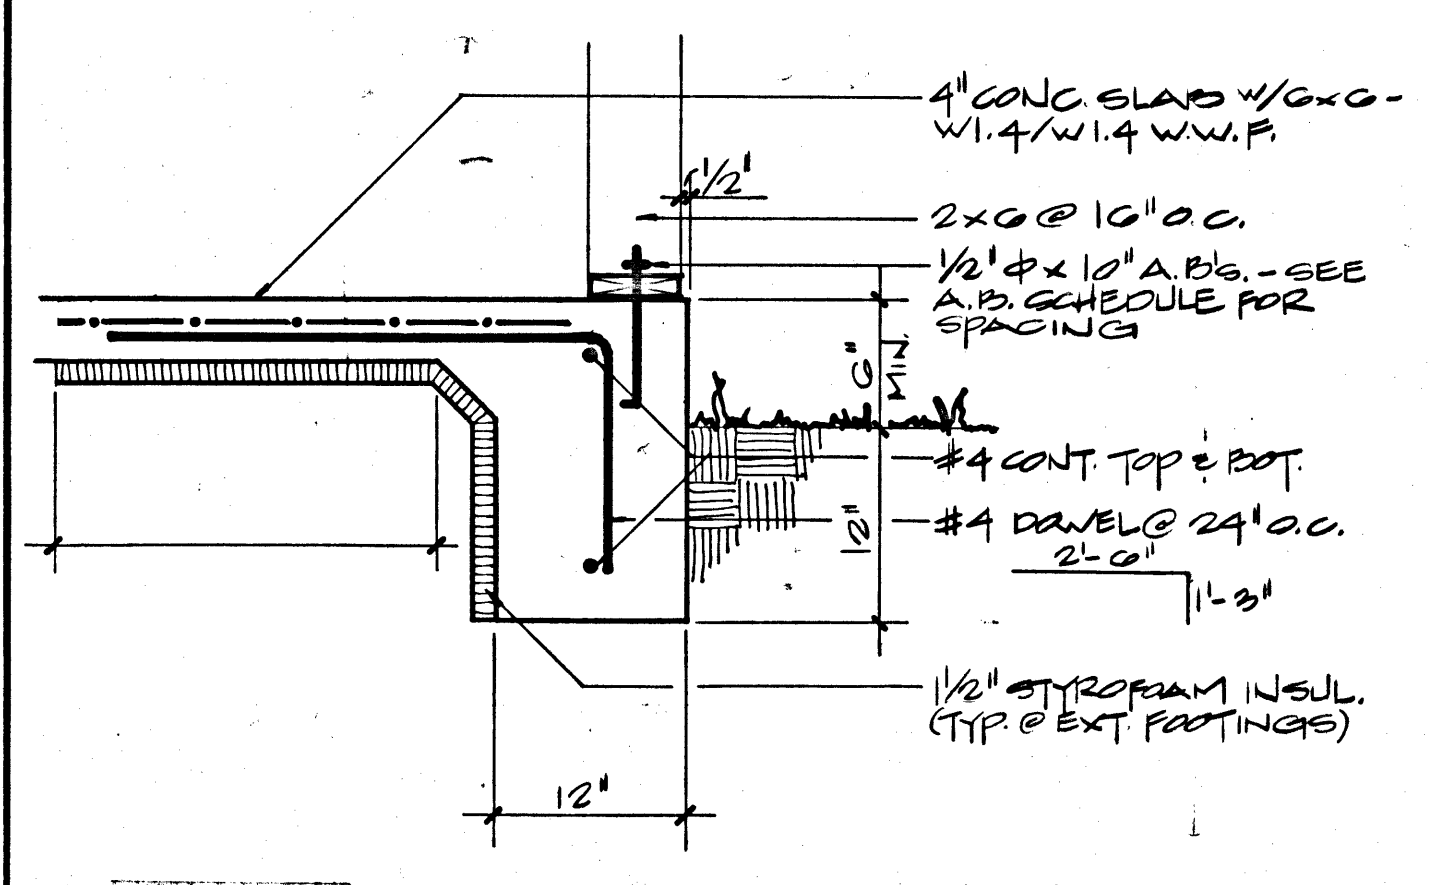


DETAIL 1
1" = 1'-0"

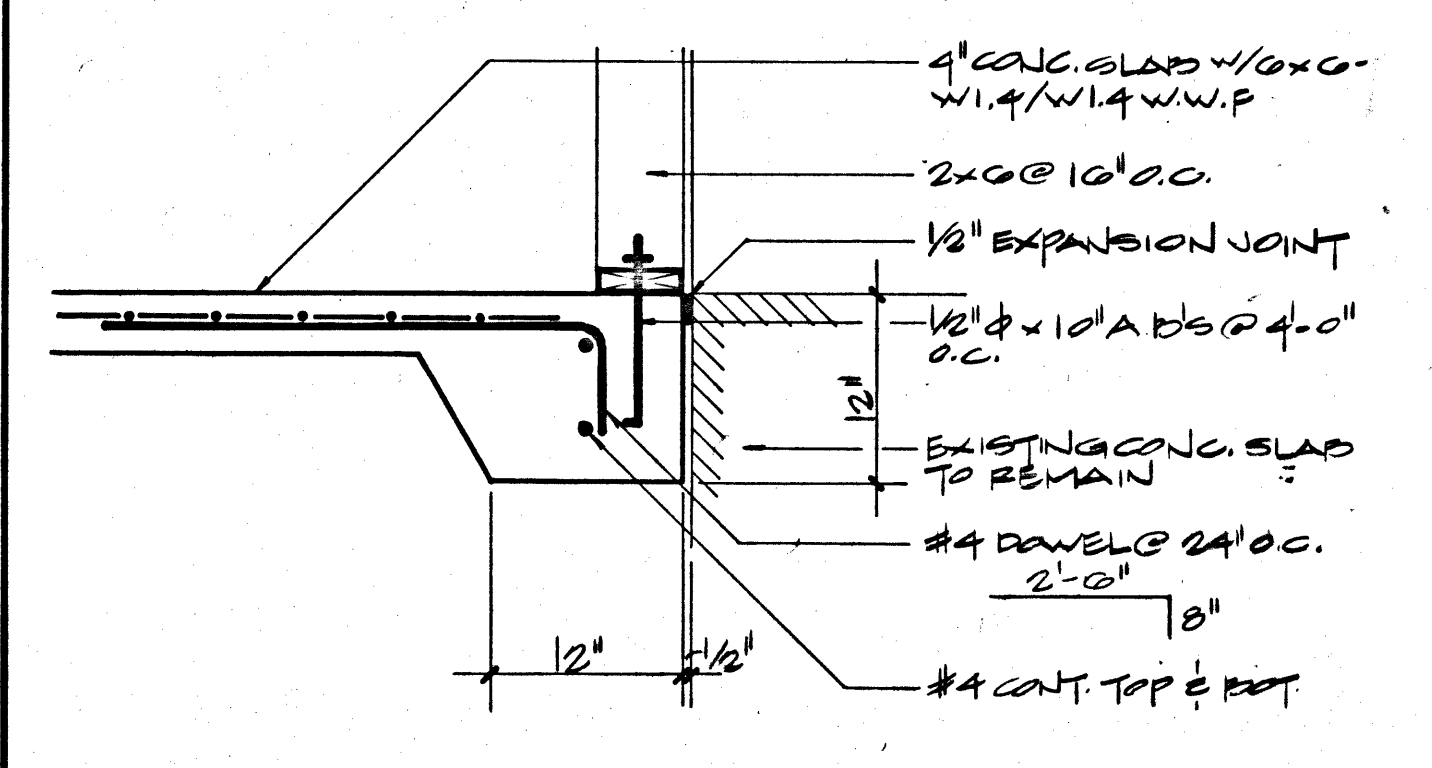


DETAIL 2
1" = 1'-0"

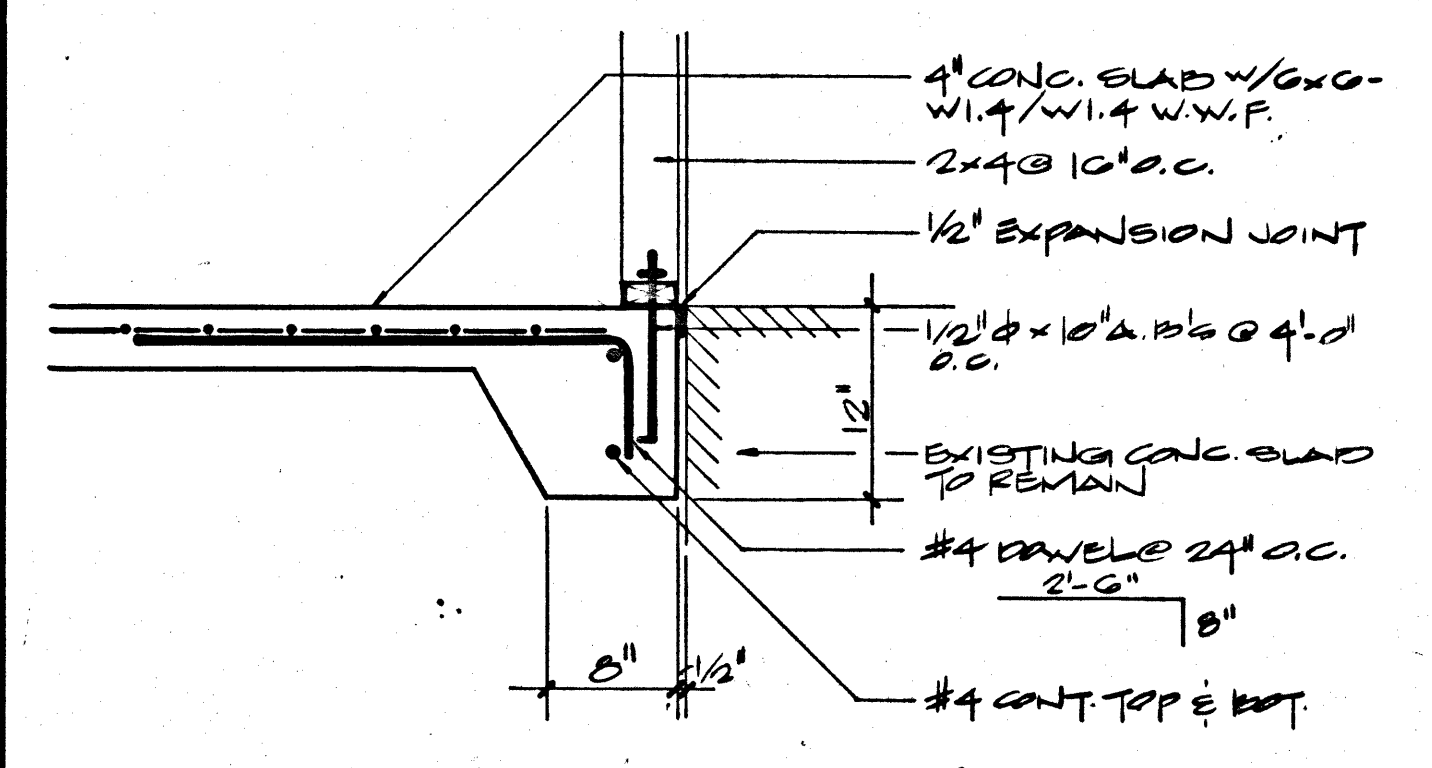


DETAIL 3
1" = 1'-0"

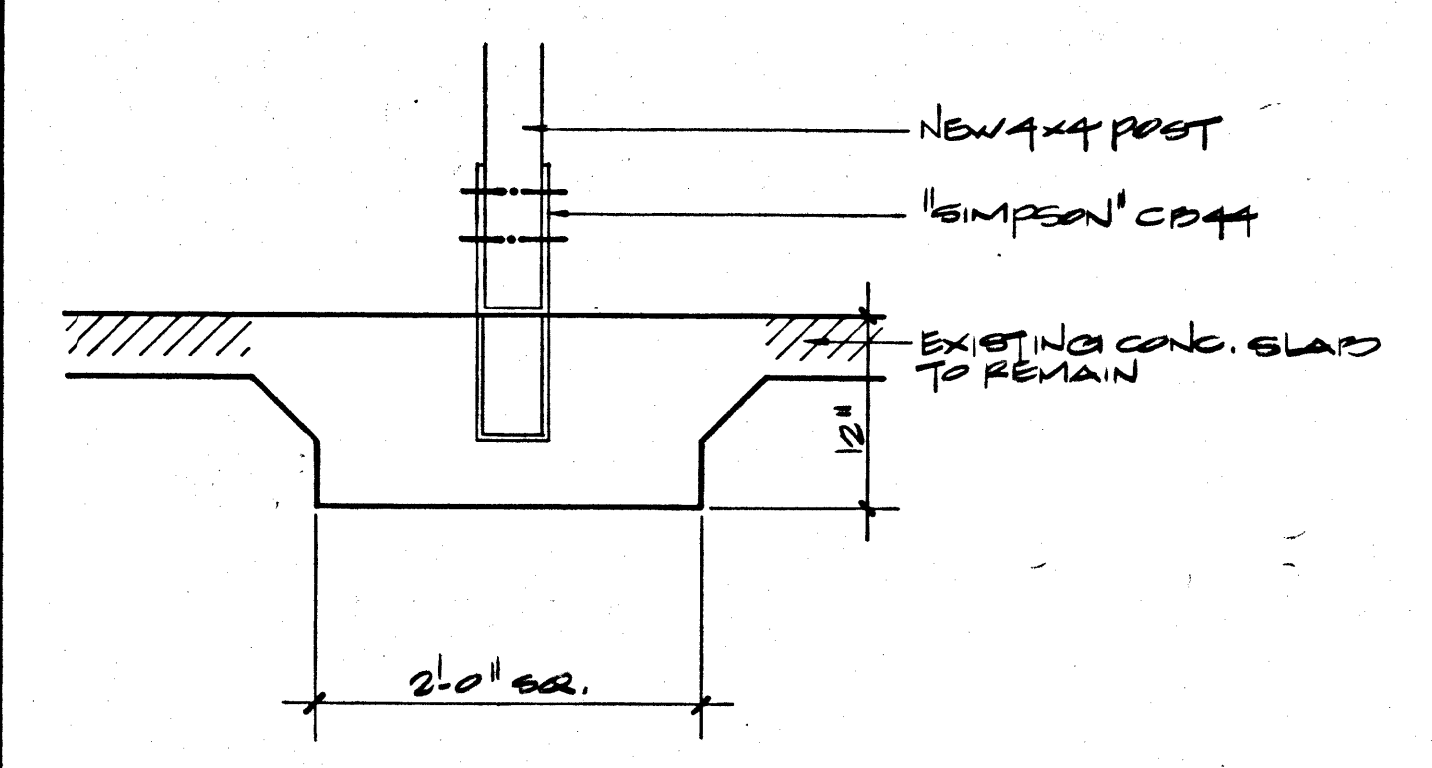

DETAIL 4
1" = 1'-0"

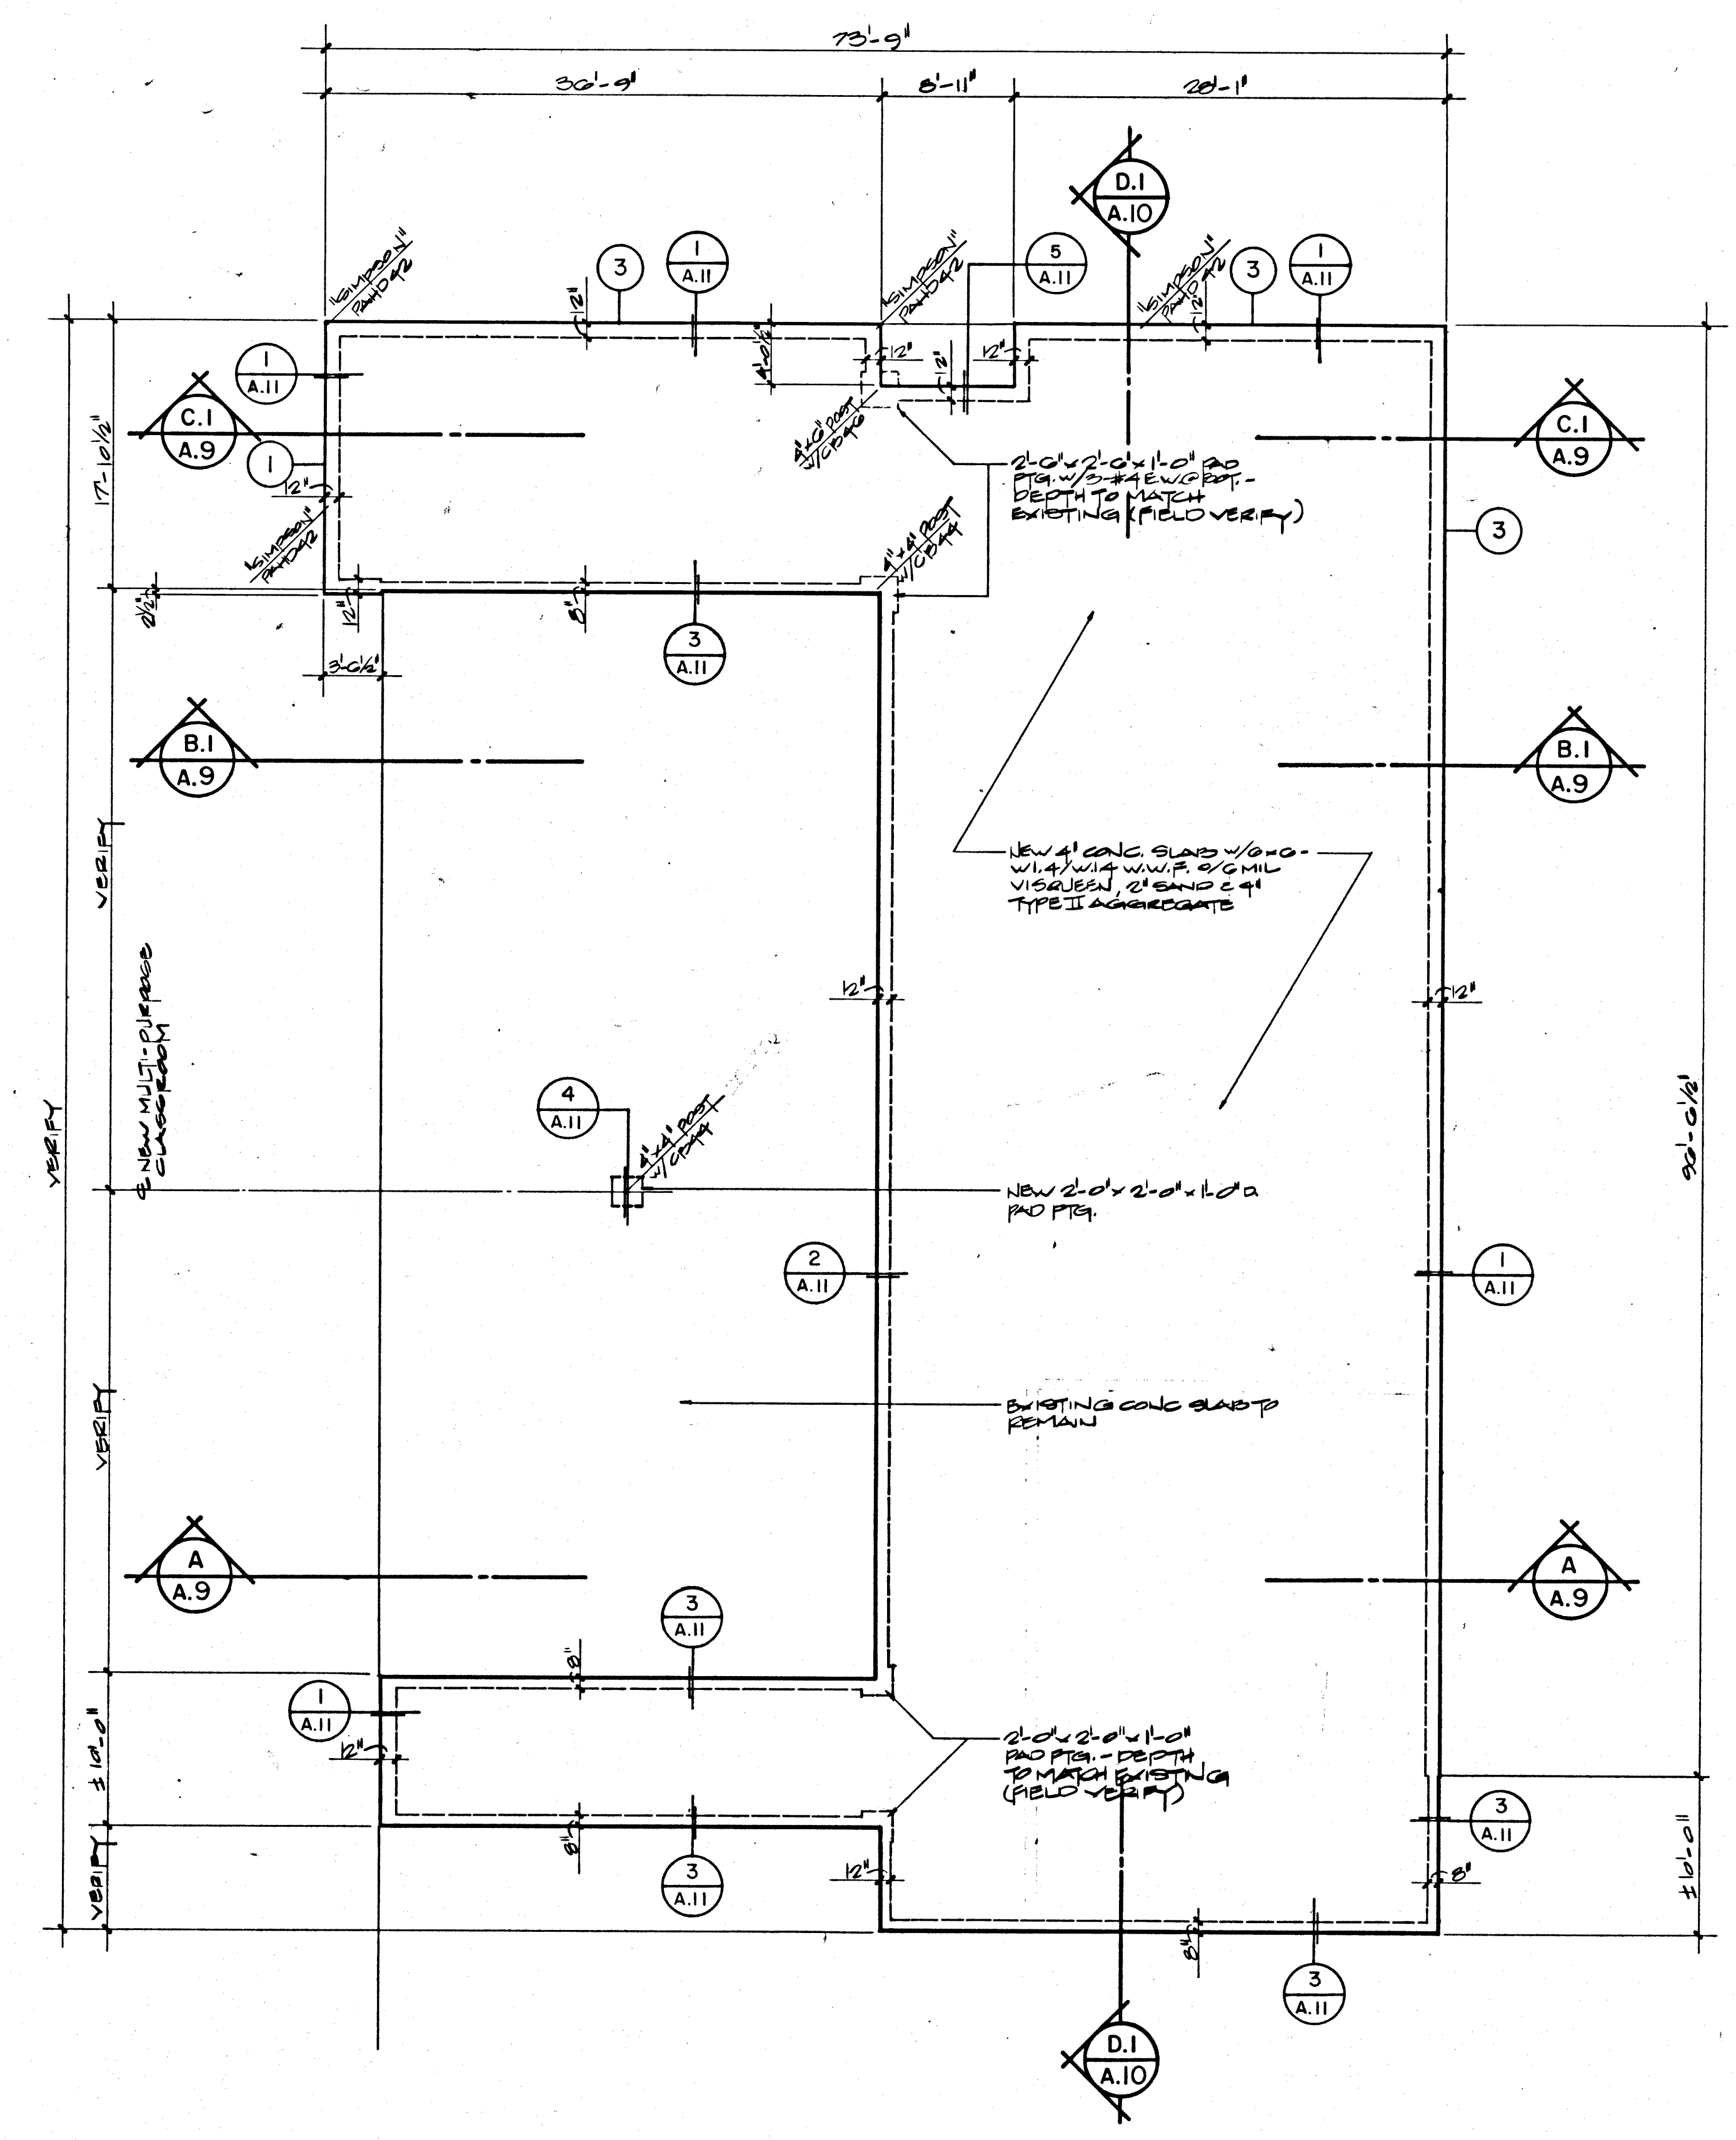

FOUNDATION PLAN
1/8" = 1'-0"

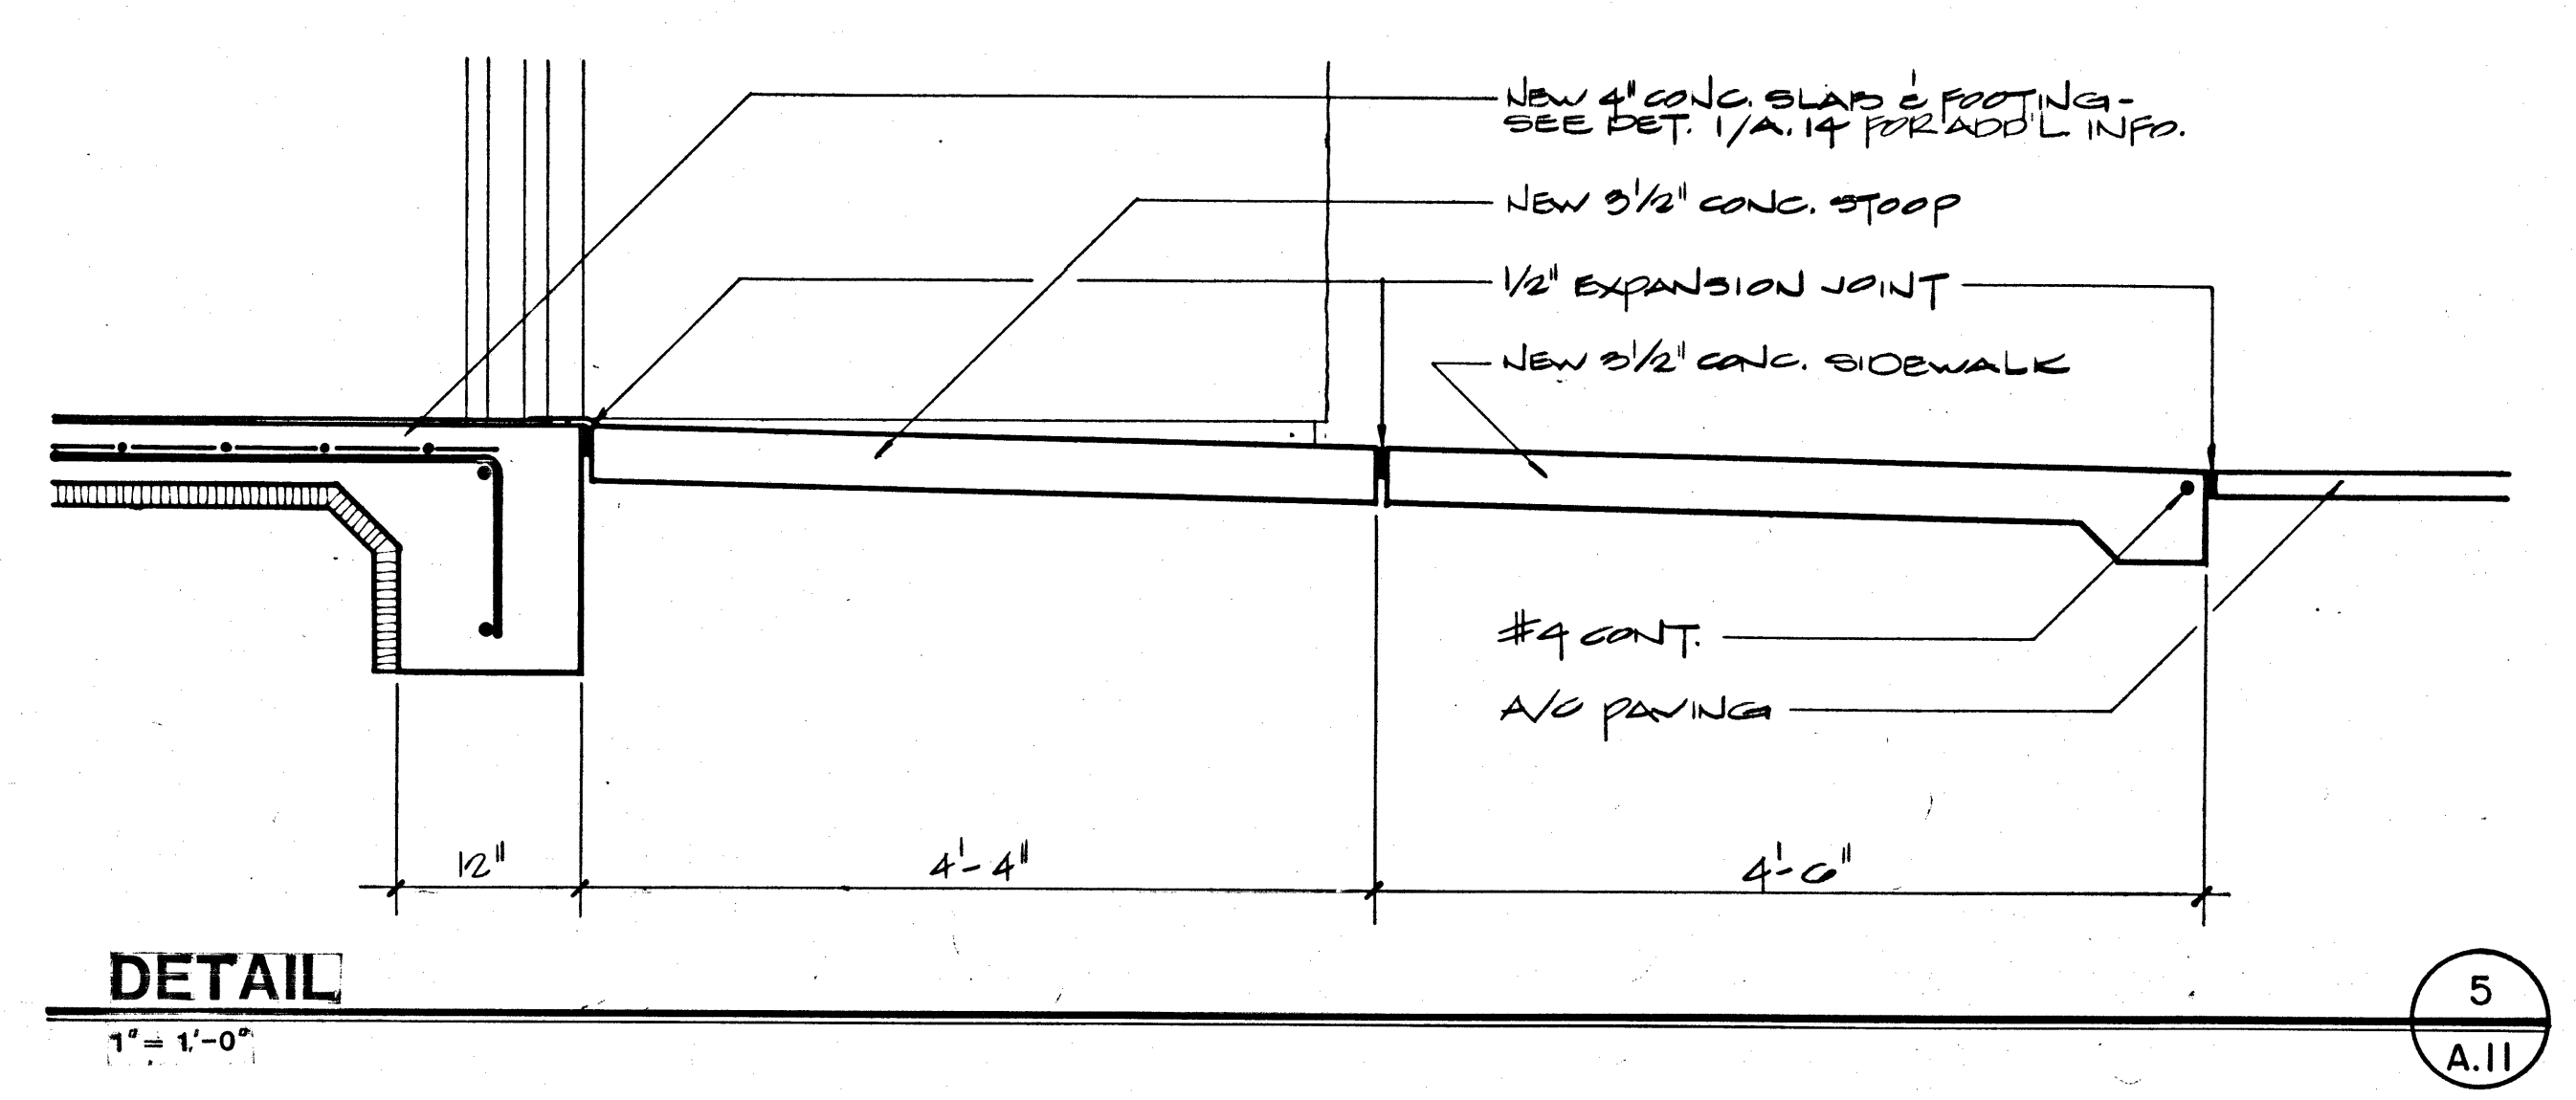

DETAIL 5
1" = 1'-0"

ANCHOR BOLT SCHEDULE

- 1 1/2" Ø A.B's @ 20" O.C.
- 2 1/2" Ø A.B's @ 36" O.C.
- 3 1/2" Ø A.B's @ 40" O.C.

NOTE: ALL OTHER ANCHOR BOLT SPACING TO BE 1/2" Ø A.B's @ 48" O.C.

RECORD DRAWING

CITY OF LAS VEGAS
400 EAST STEWART AVENUE
LAS VEGAS, NEVADA 89101

ARCHITECT • CIRAID CARADICH & ASSOCIATES A.I.A.
2320 FIFTH AVENUE, SUITE 201, SAN DIEGO, CA 92101 (619) 233-7296
2300 PASEO DEL PRADO, C-108, LAS VEGAS, NV 89102 (702) 357-4445

PHASE I (VARIETY CLUB)
"D" STREET / JEFFERSON AVENUE
NEIGHBORHOOD FACILITY PROJECT

FOUNDATION PLAN

drawn by: R.B.
issue dates:
11/3/88
11/22/88 bidding
revisions:
2/1/89 2nd bidding

job no.: 8737 LV

A.II

19

671-25

1. TITLE
2. PROJECT
3. LOCATION
4. DATE




1. NAME
2. ADDRESS
3. CITY
4. STATE
5. ZIP

1. NAME
2. ADDRESS
3. CITY
4. STATE
5. ZIP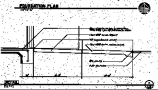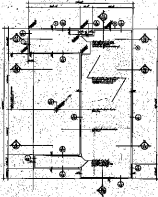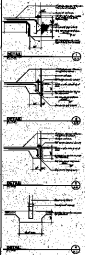

RECORD DRAWING

1. NAME
2. ADDRESS
3. CITY
4. STATE
5. ZIP