



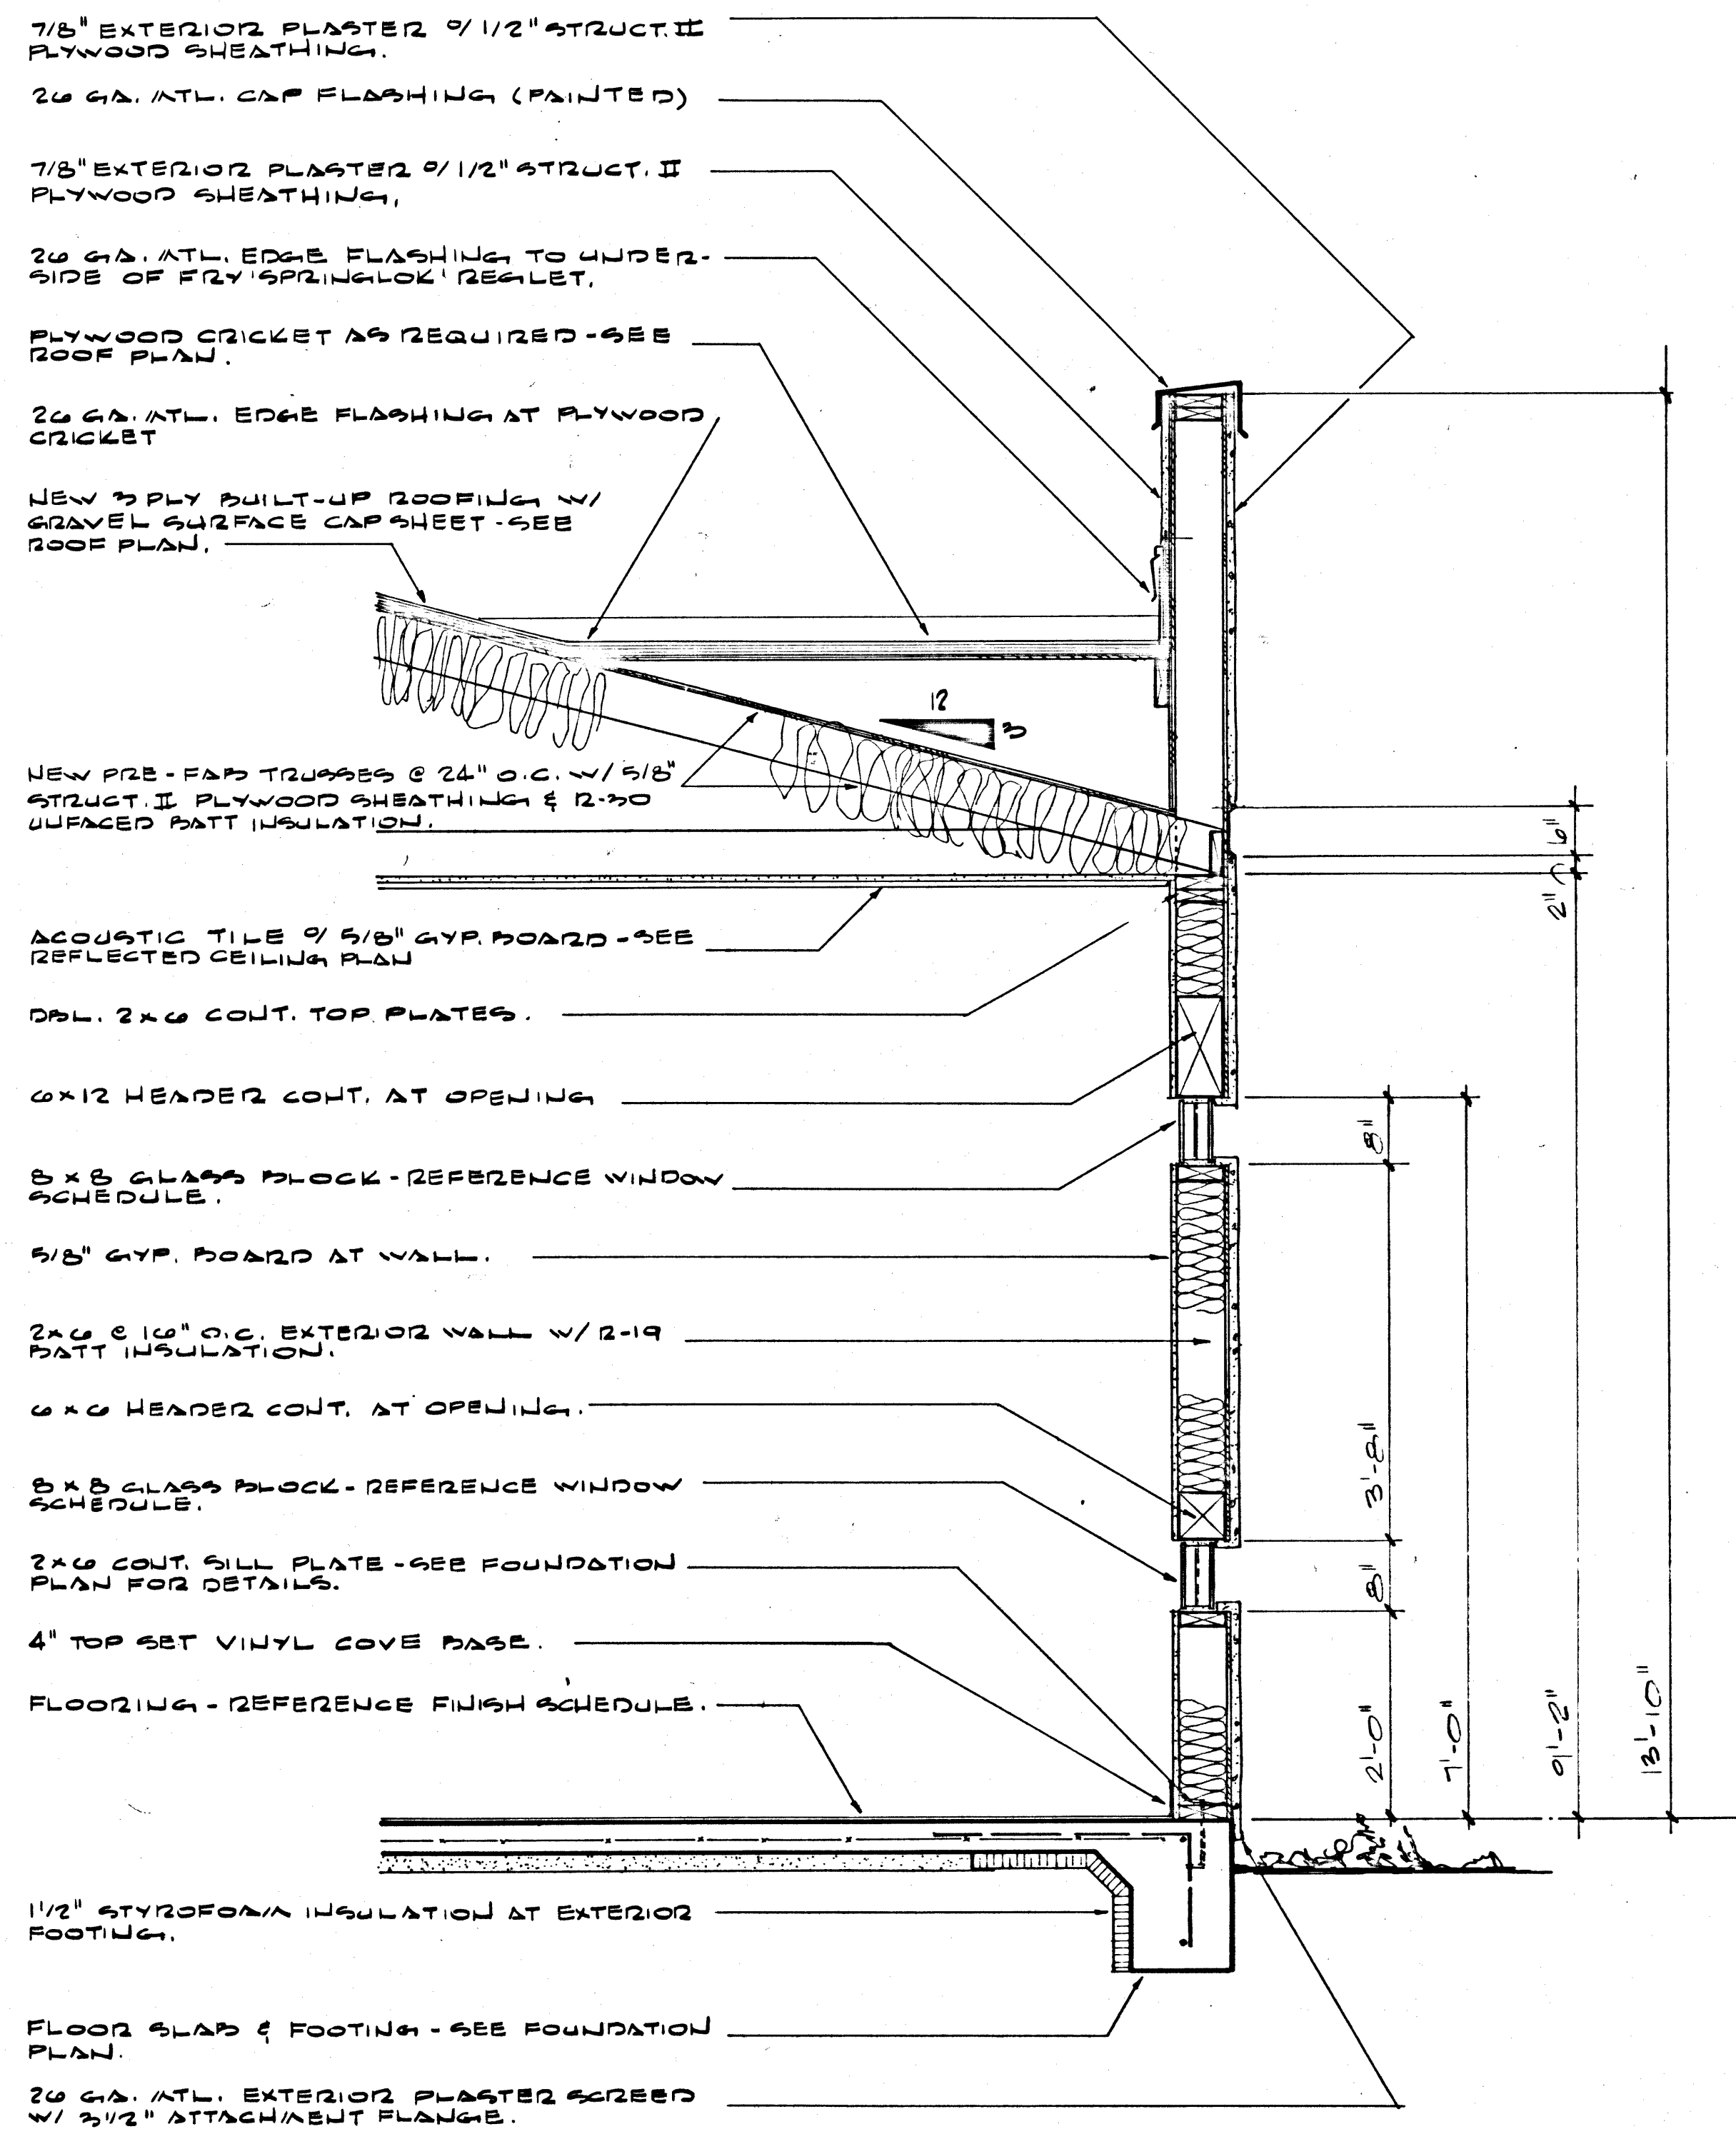

WALL SECTION

3/4" = 1'-0"


2
A.14

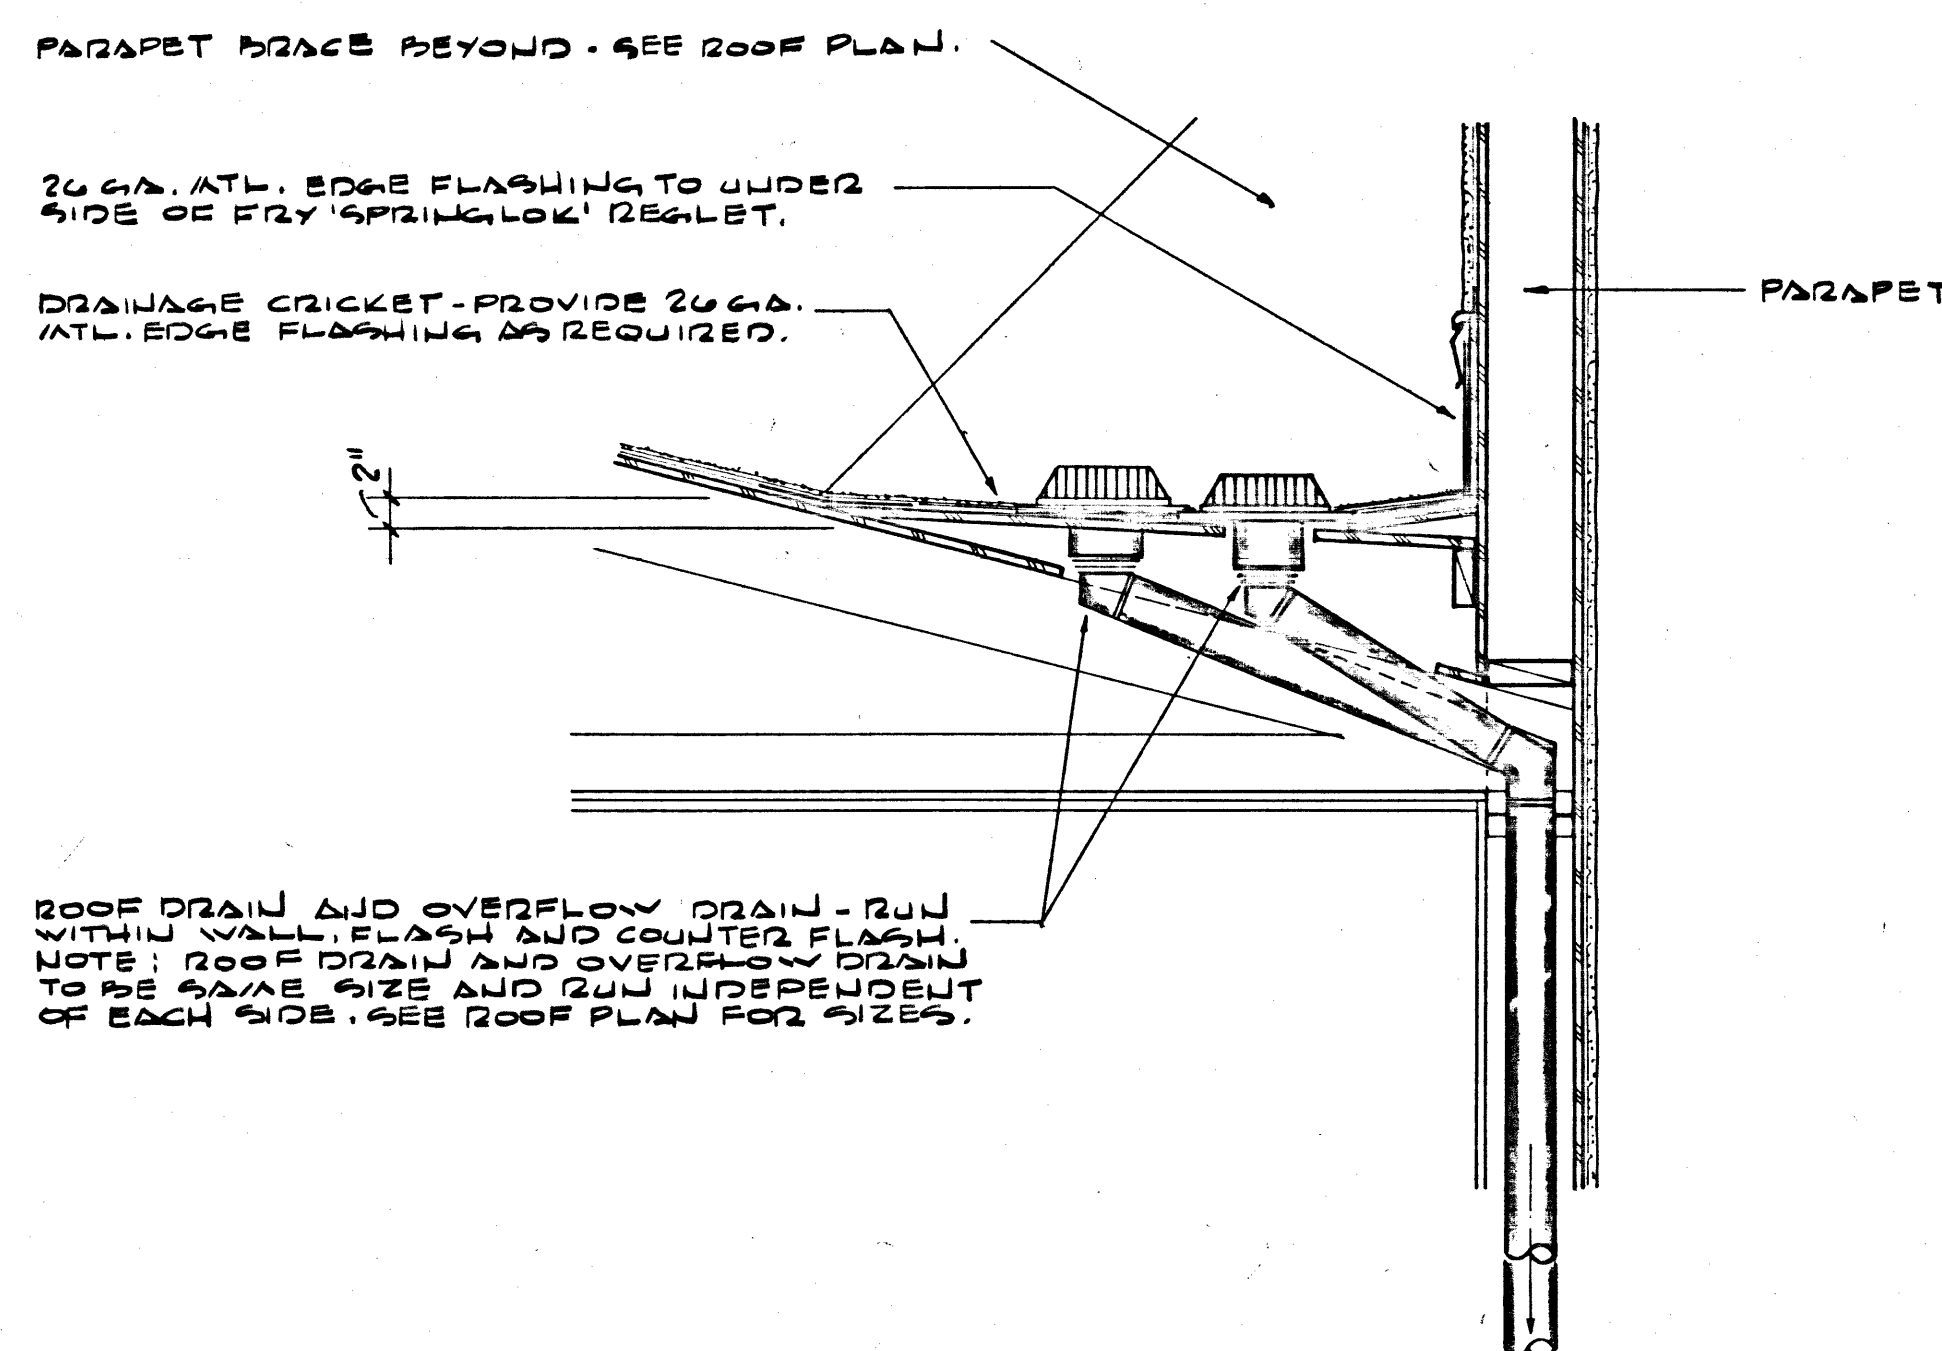

DETAIL - ROOF DRAIN

3\"/>


5
A.14

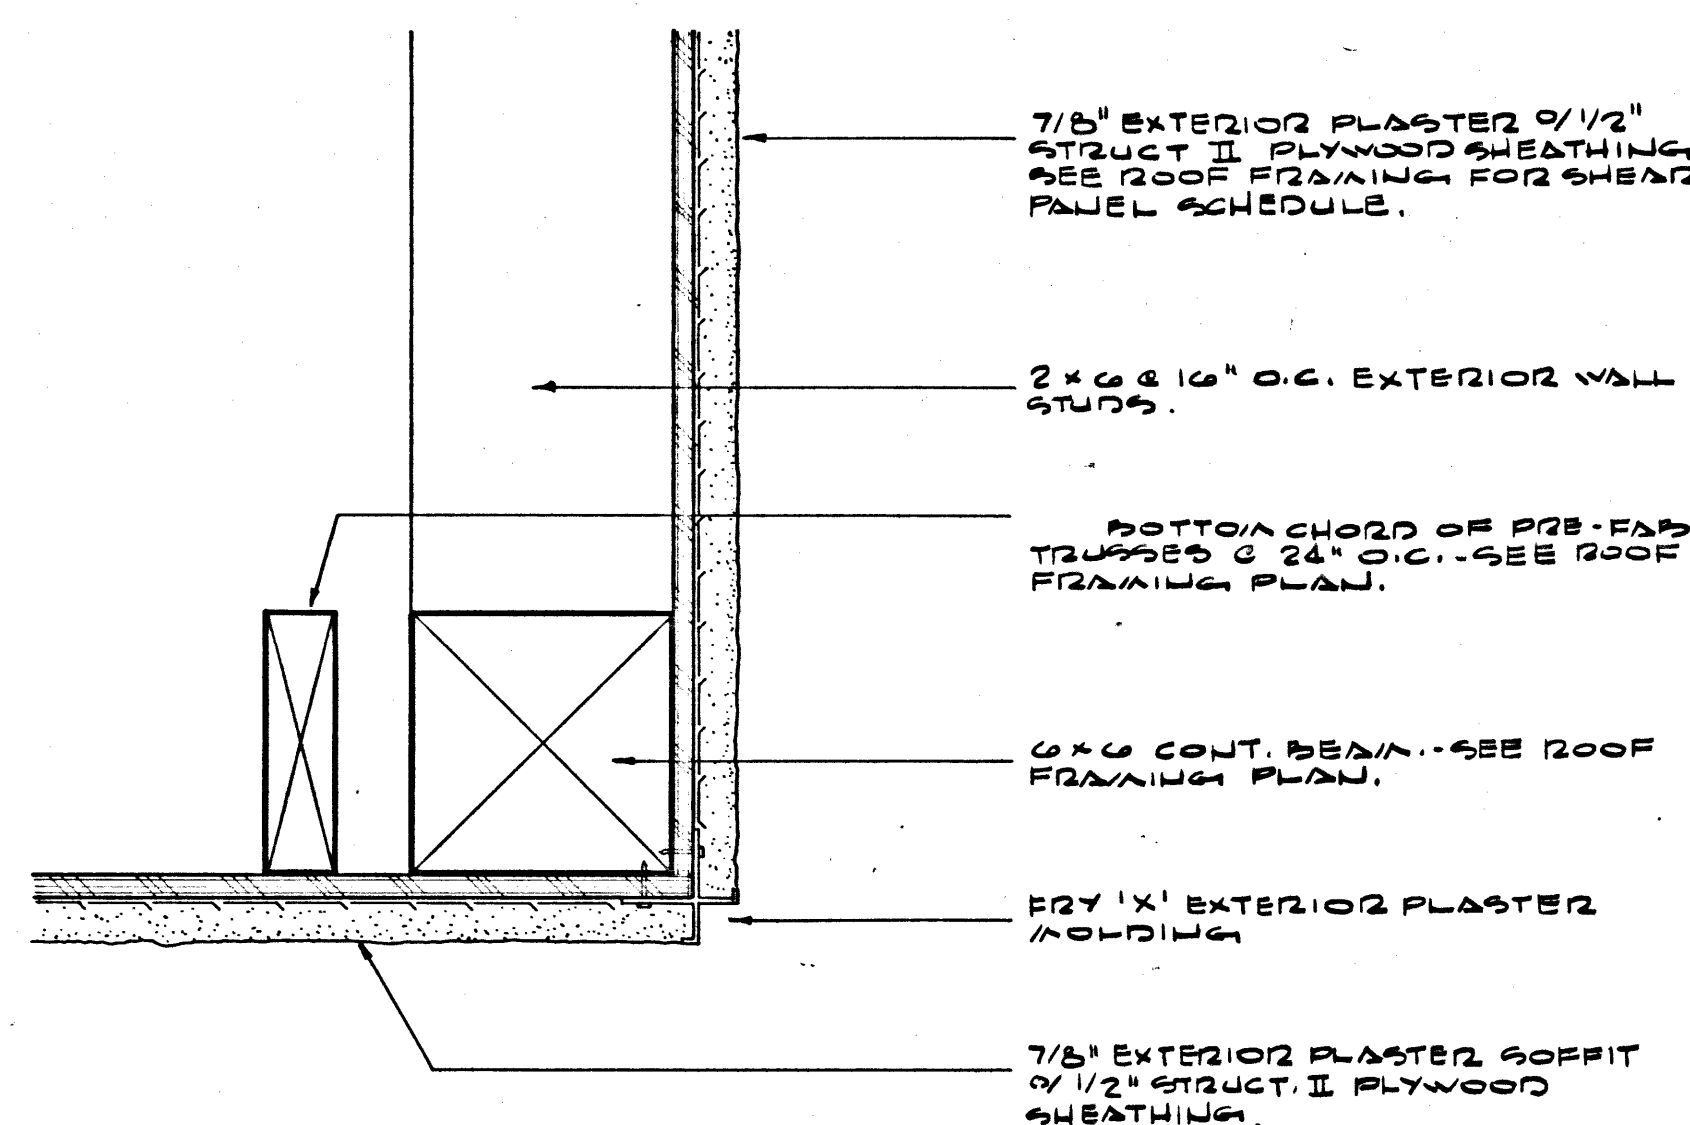

DETAIL - MOLDING

3\"/>


4
A.14

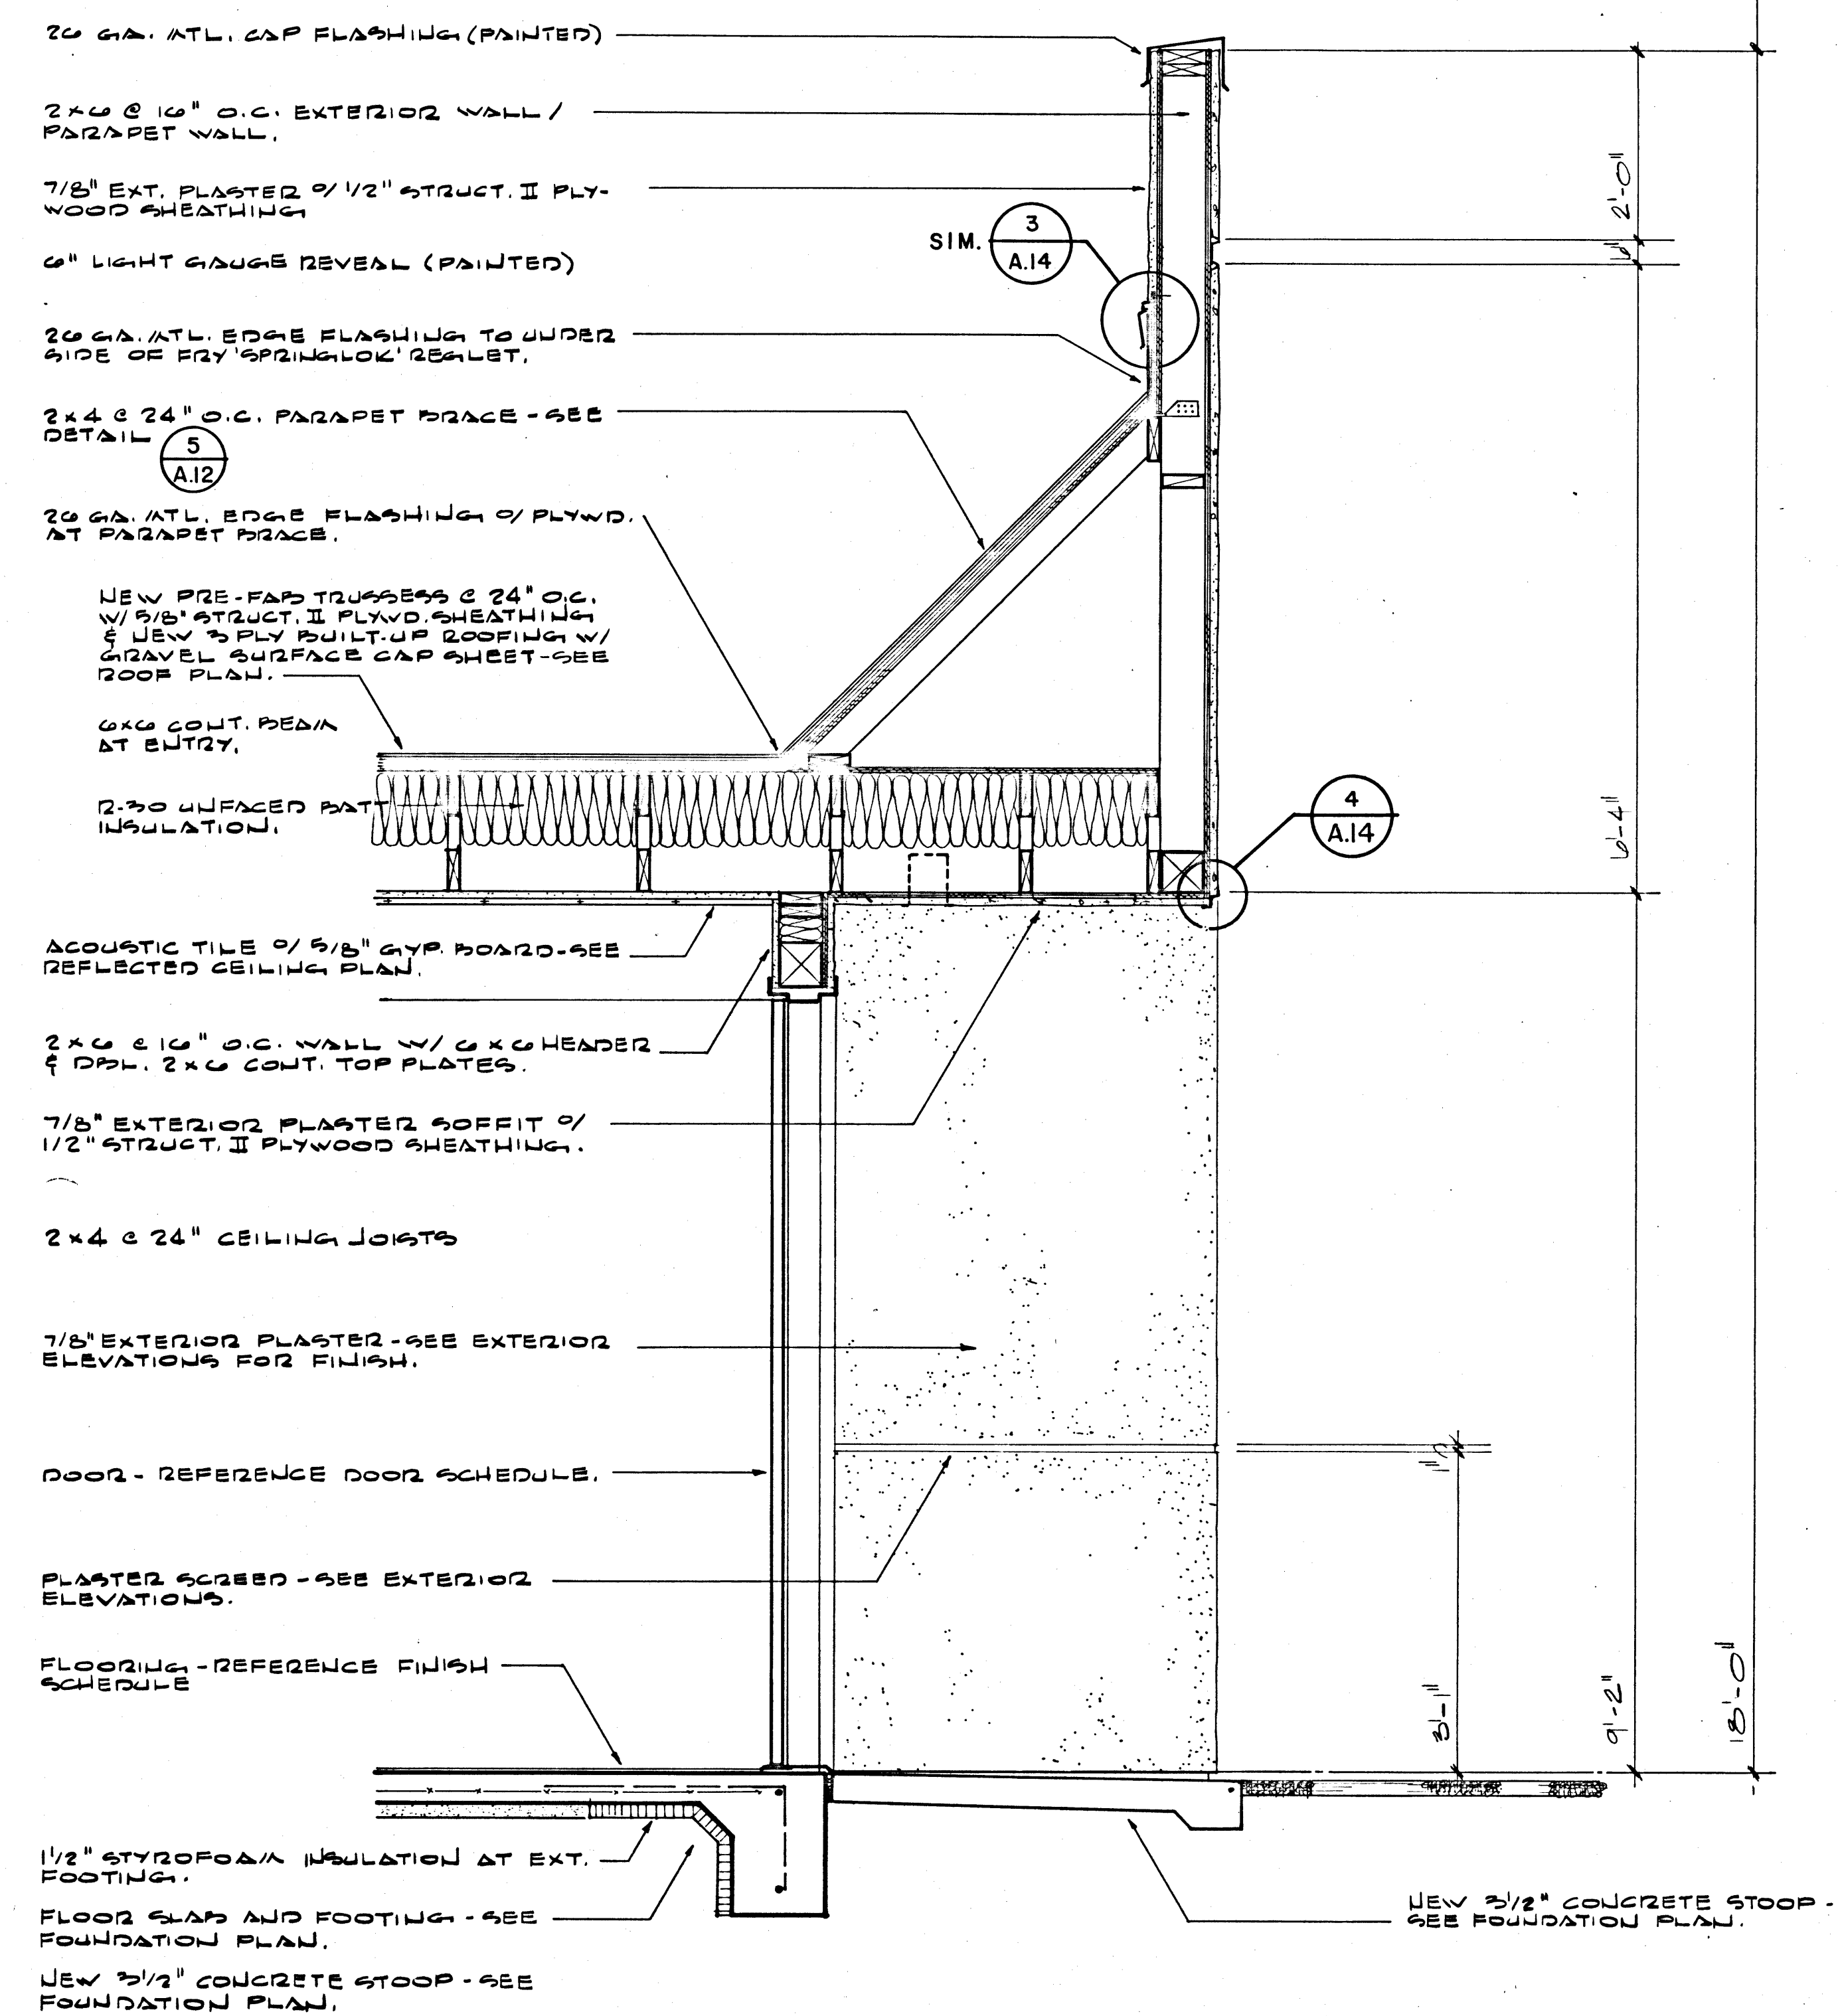

WALL SECTION

3/4" = 1'-0"

1
A.14

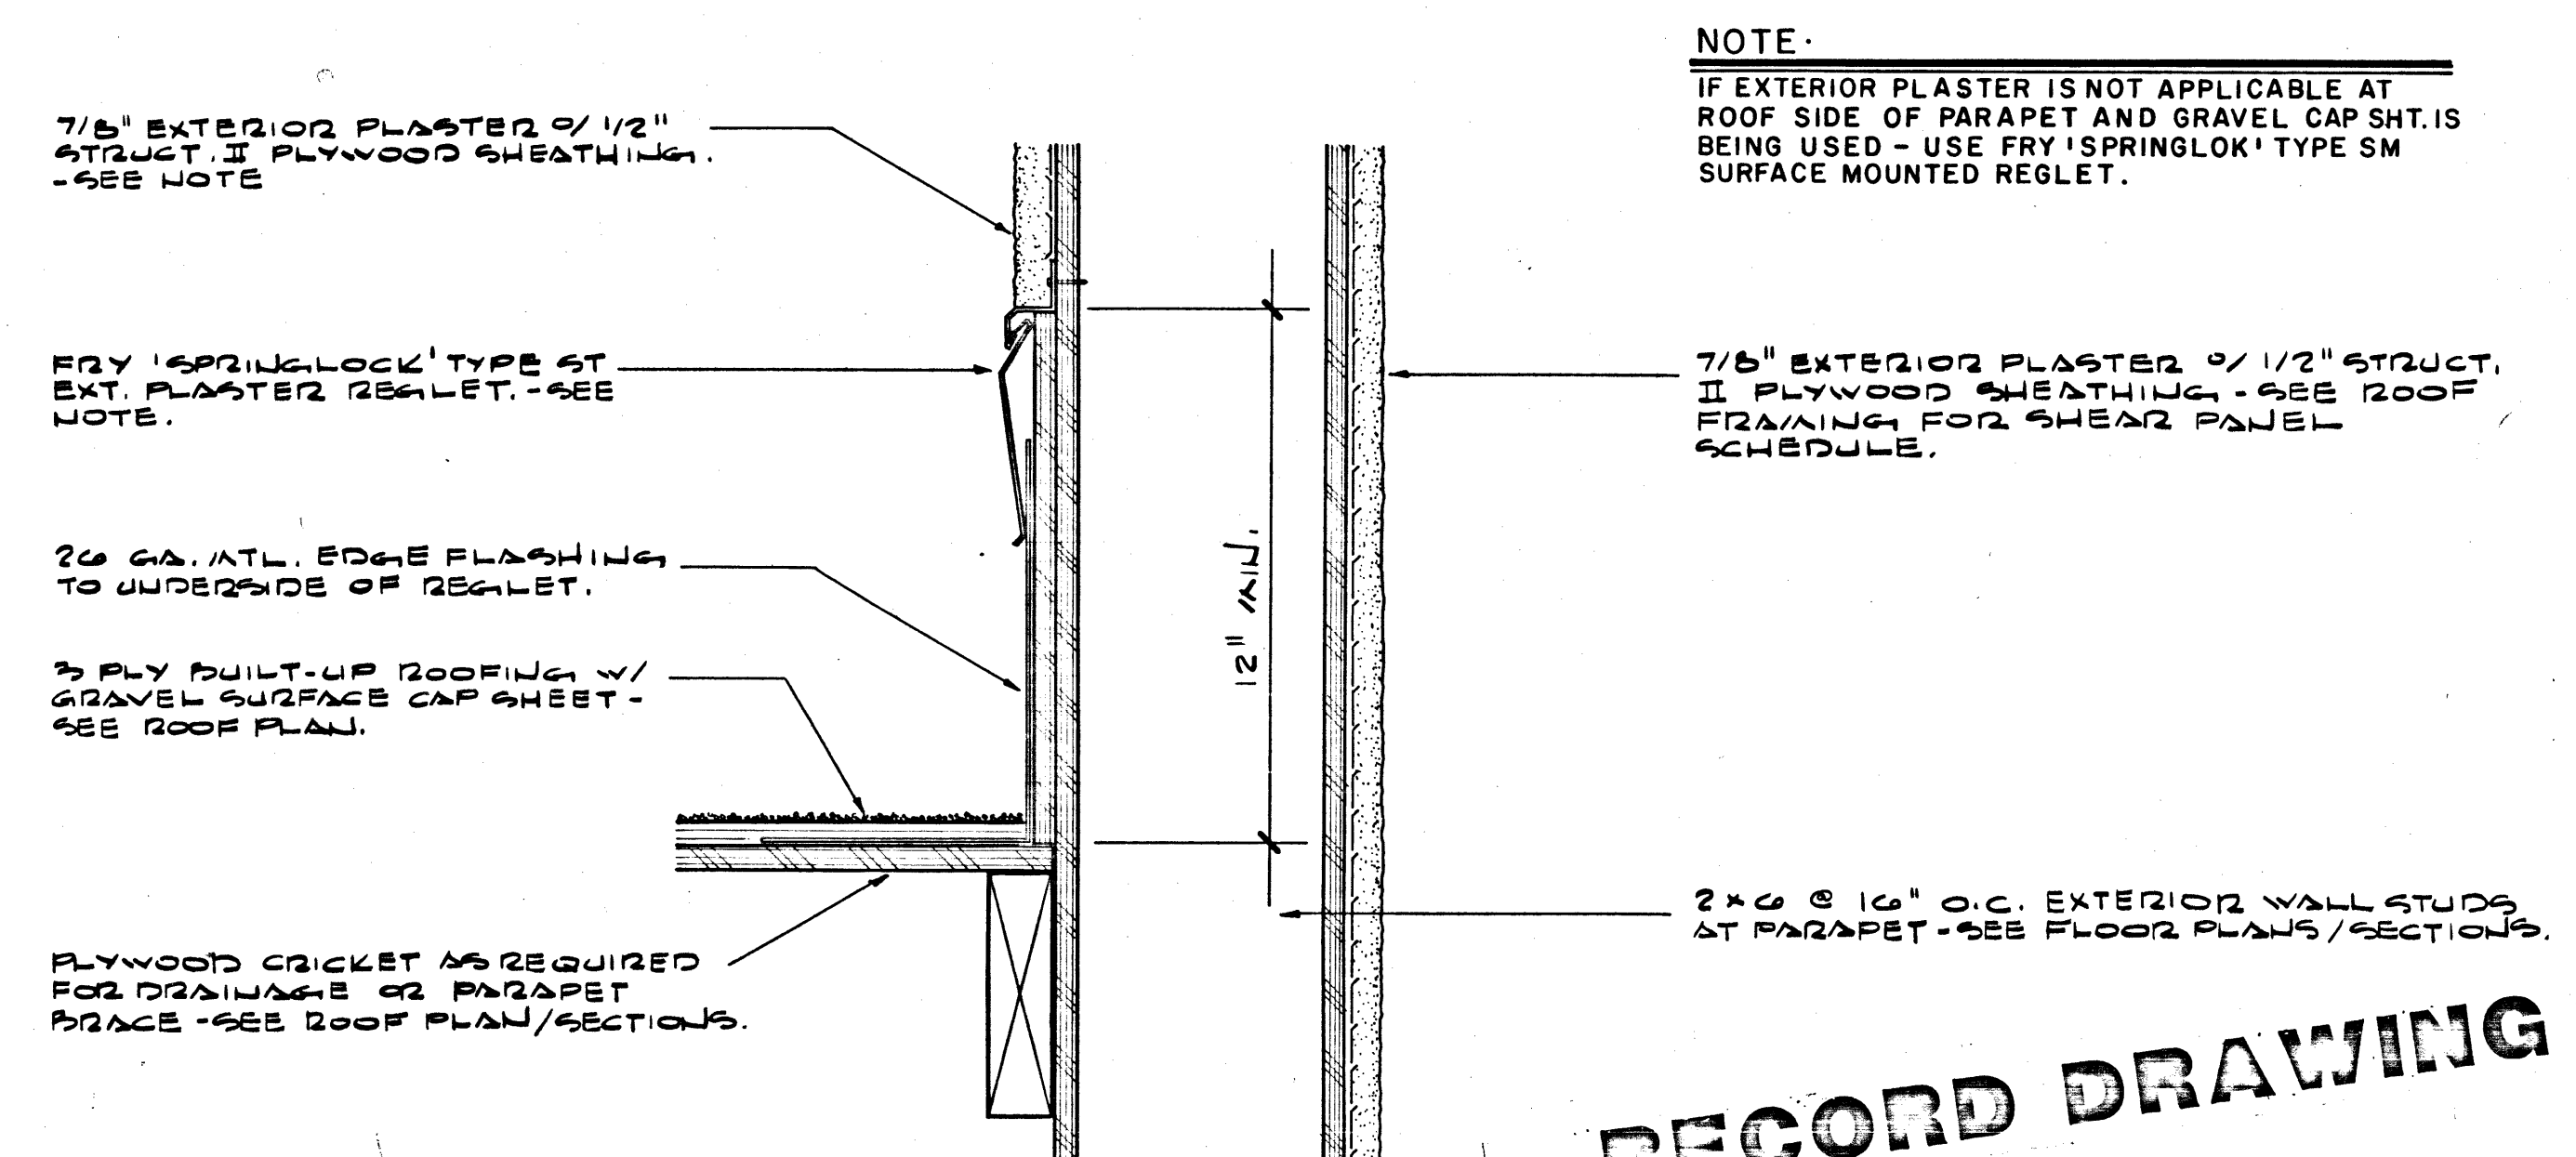

DETAIL - REGLET

3\"/>

3
A.14

RECORD DRAWING
CITY OF LAS VEGAS
400 EAST STEWART AVENUE
LAS VEGAS, NEVADA 89101






ARCHITECT • GERARD CARADICH & ASSOCIATES A.I.A.
2330 FIFTH AVENUE, SUITE 201, SAN DIEGO, CA 92101 (619) 233-7296
2300 PASO DEL PRADO, C-108, LAS VEGAS, NV 89102 (702) 357-4445

PHASE I (VARIETY CLUB)
"D" STREET / JEFFERSON AVENUE
NEIGHBORHOOD FACILITY PROJECT

WALL SECTIONS
and
DETAILS

drawn by: dan L. nelder
issue date: 11/3/88
11/22/88 bidding
revisions:
2/1/89 2nd bidding
job no.: 8737 LV

A.14
22

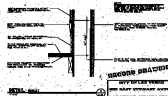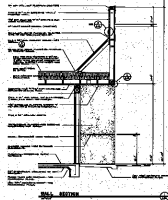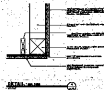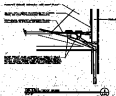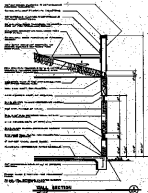

ARCHITECT - JAMES H. HARRIS
 1000 N. 10TH ST. S.W.
 ALBUQUERQUE, N.M. 87102

PLANS 11 VERTICAL SCALE 1/4"
 1" = 1'-0" (VERTICAL SCALE)
 1" = 1'-0" (HORIZONTAL SCALE)

11

11

