

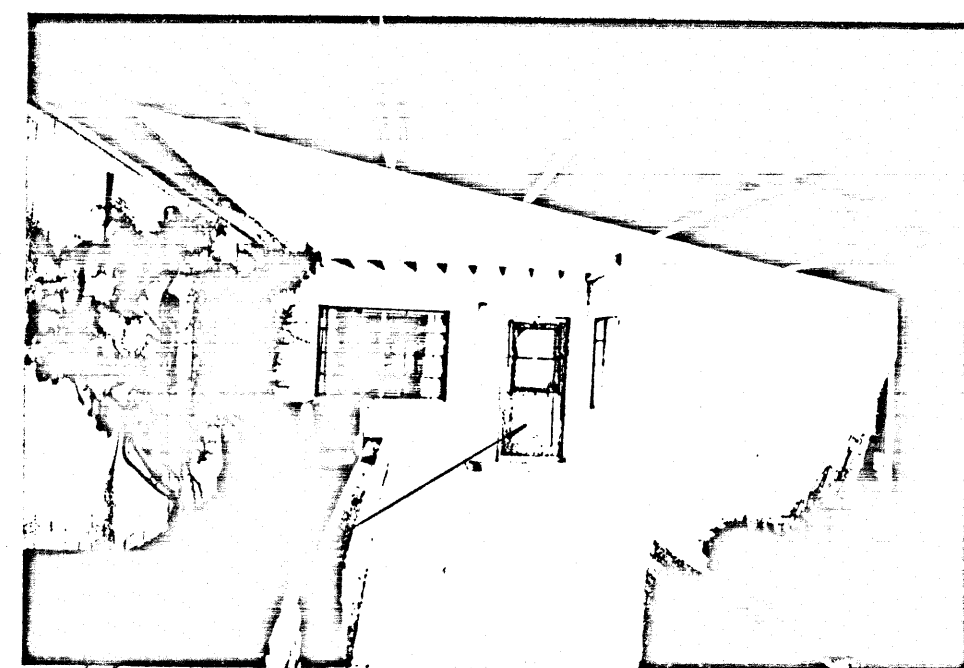


PHOTO DETAIL

1
A.15

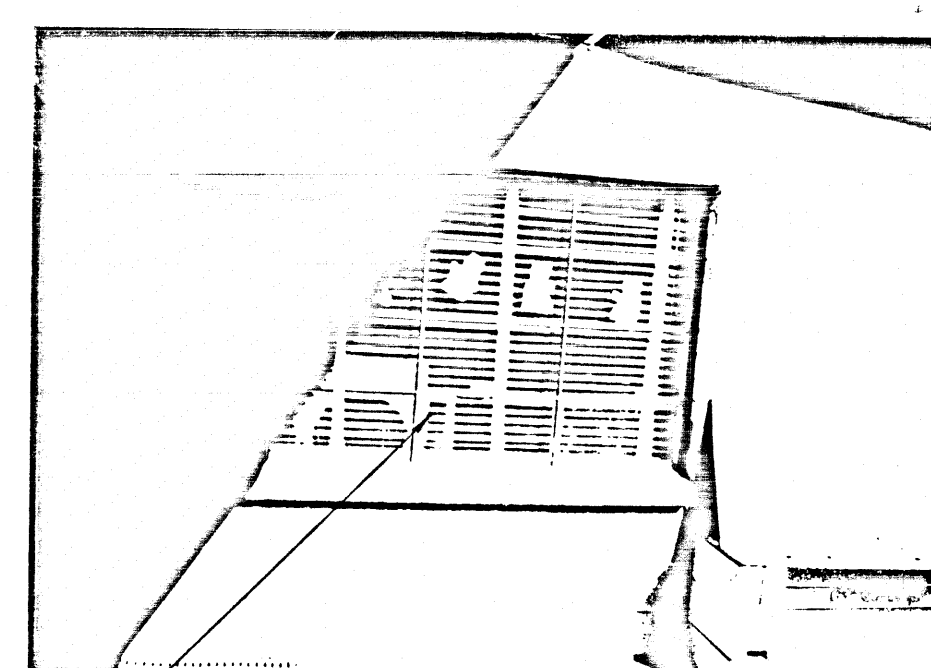


PHOTO DETAIL

2
A.15


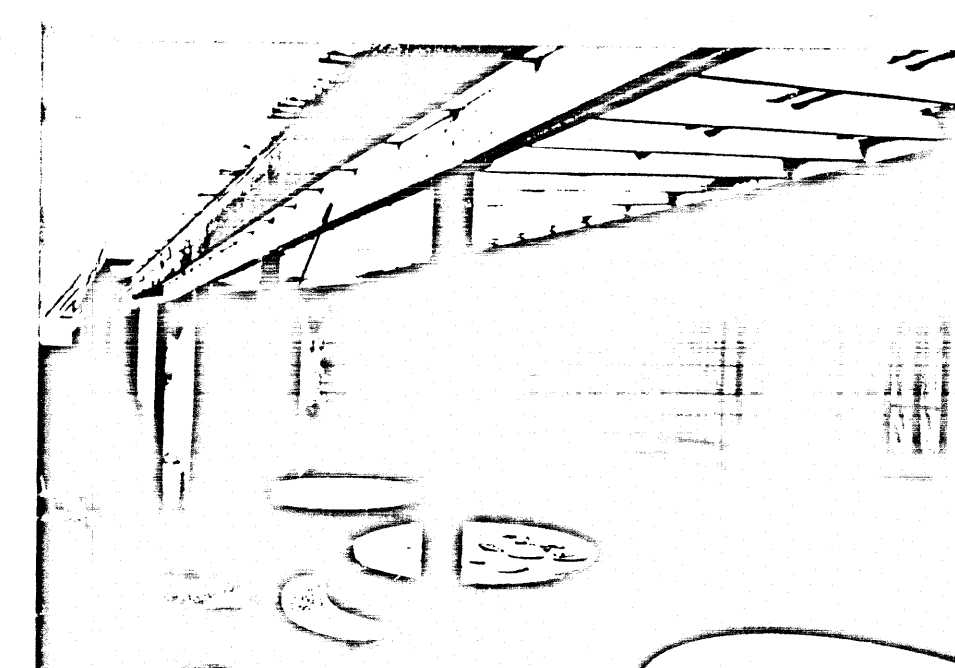


PHOTO DETAIL

3
A.15

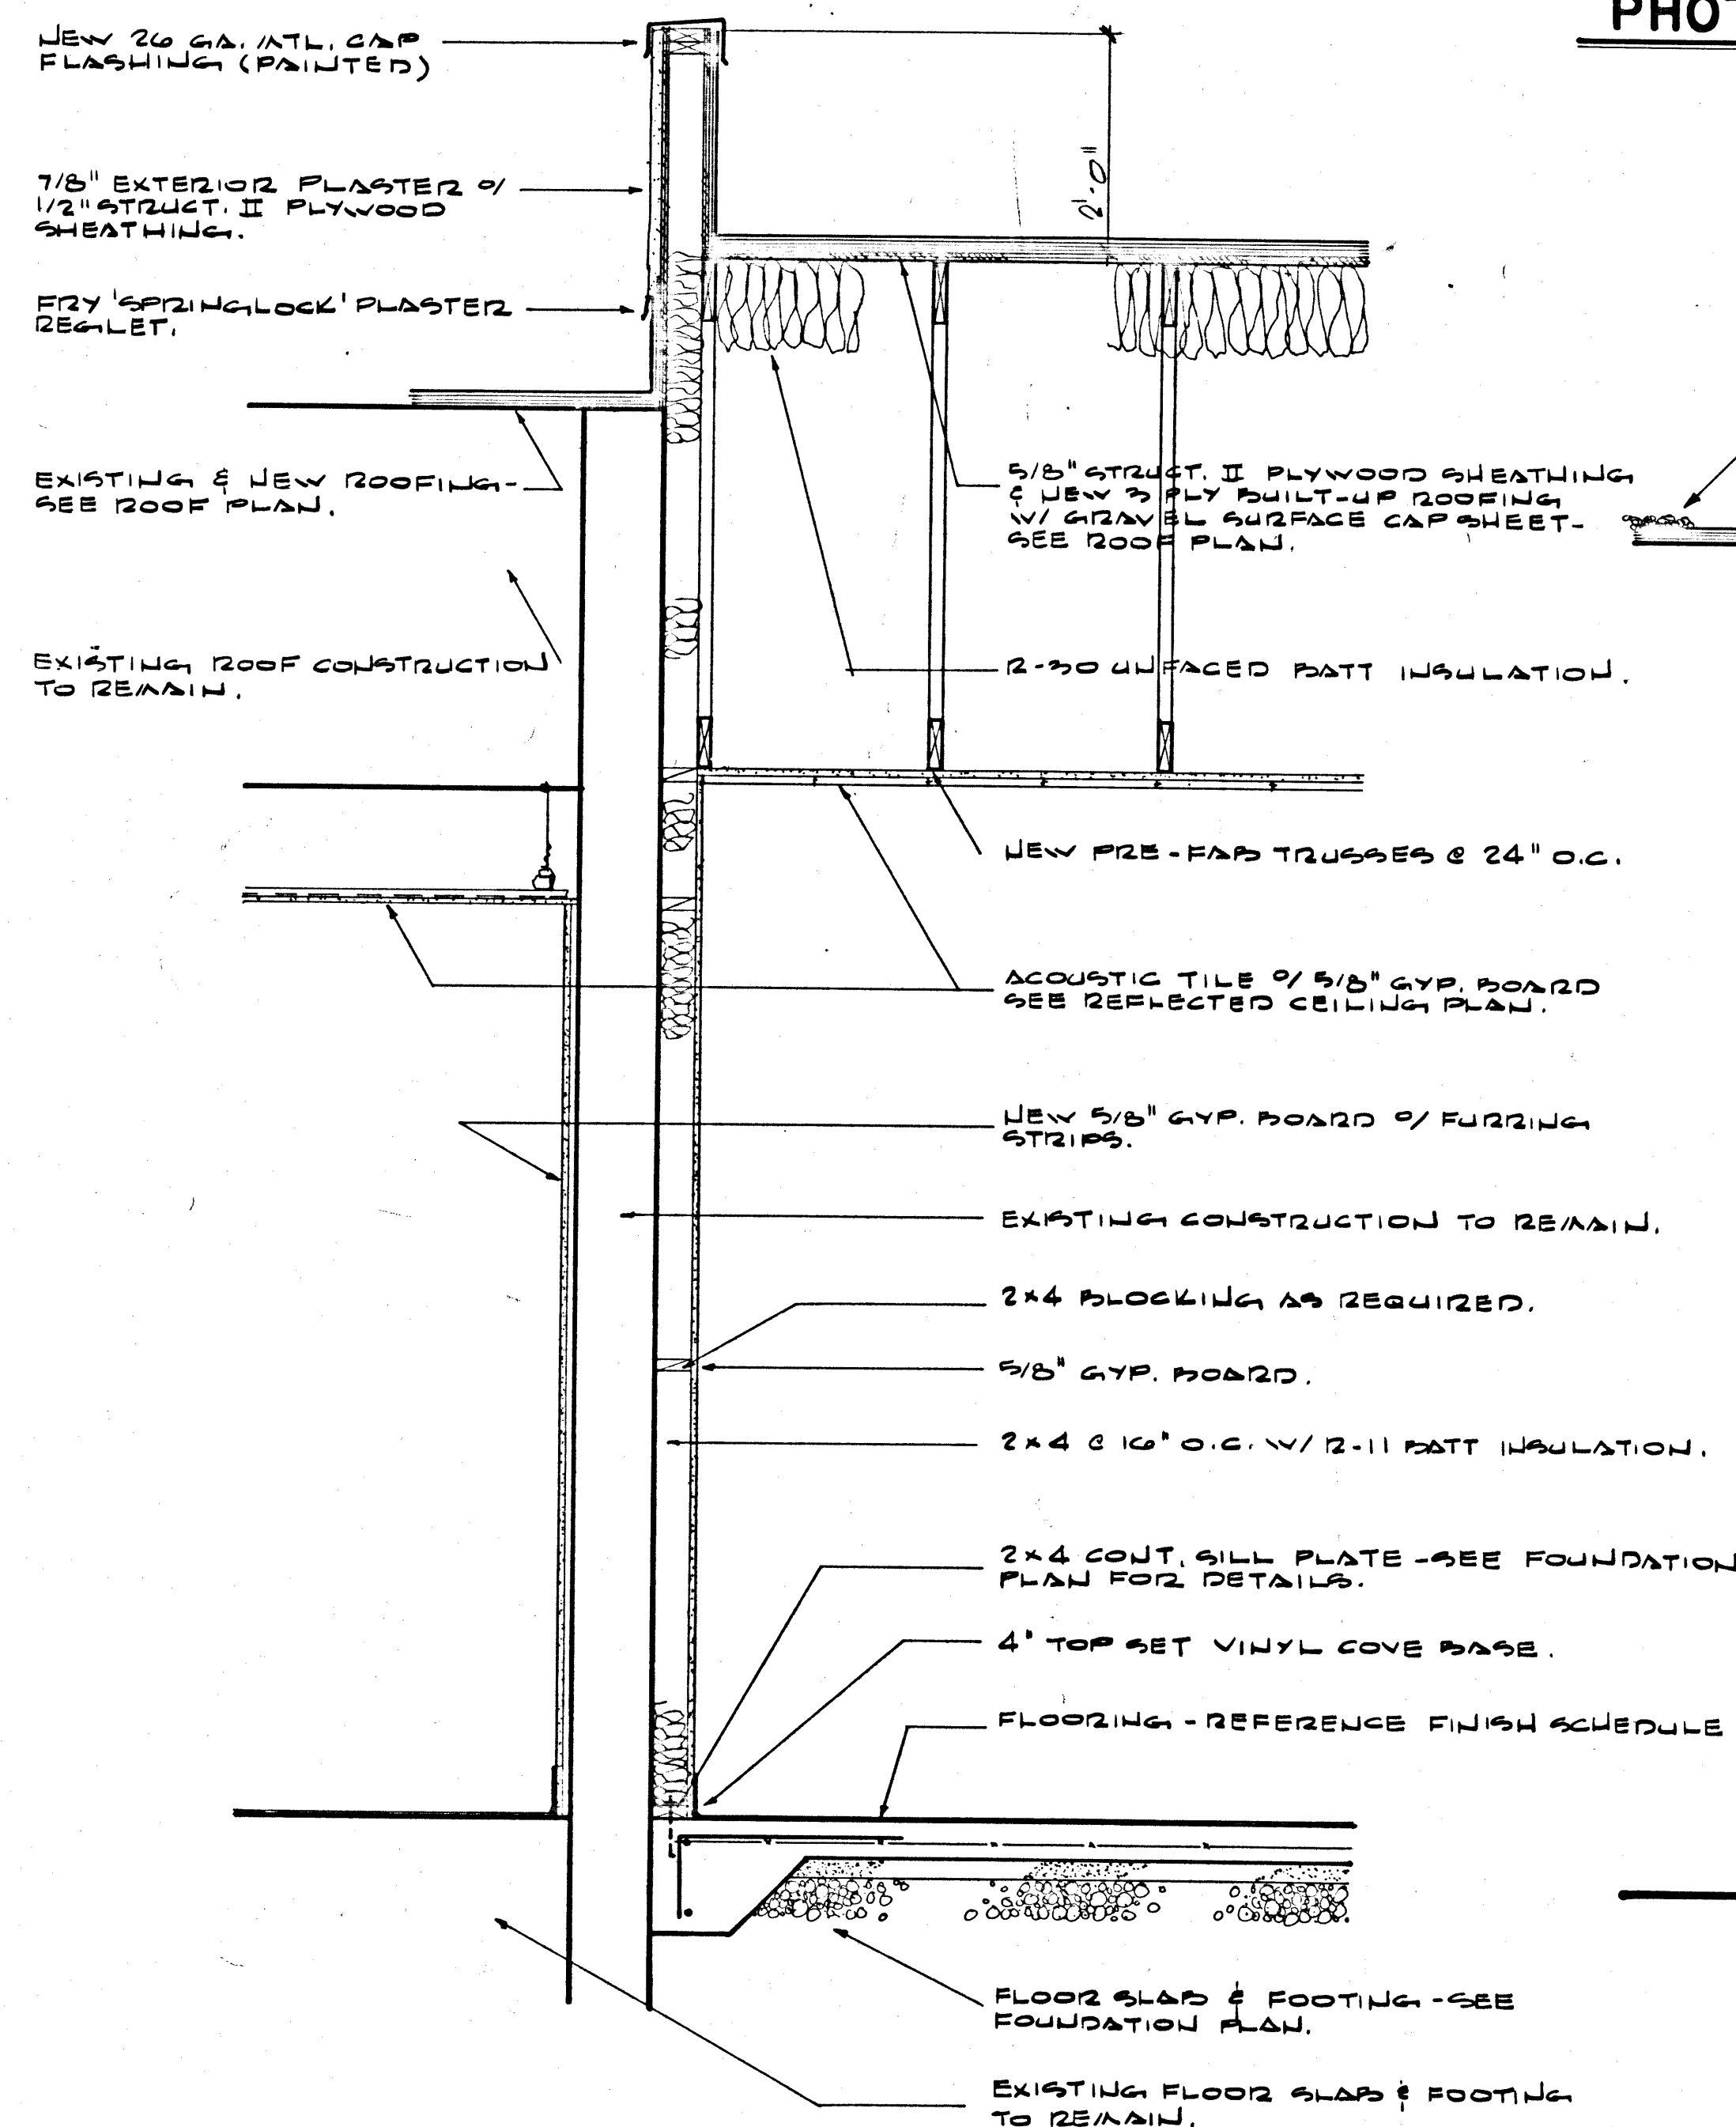

WALL SECTION -

3/4" = 1'-0"

5
A.15

WALL SECTION -

3/4" = 1'-0"

4
A.15

WALL SECTION -

3/4" = 1'-0"

3
A.15

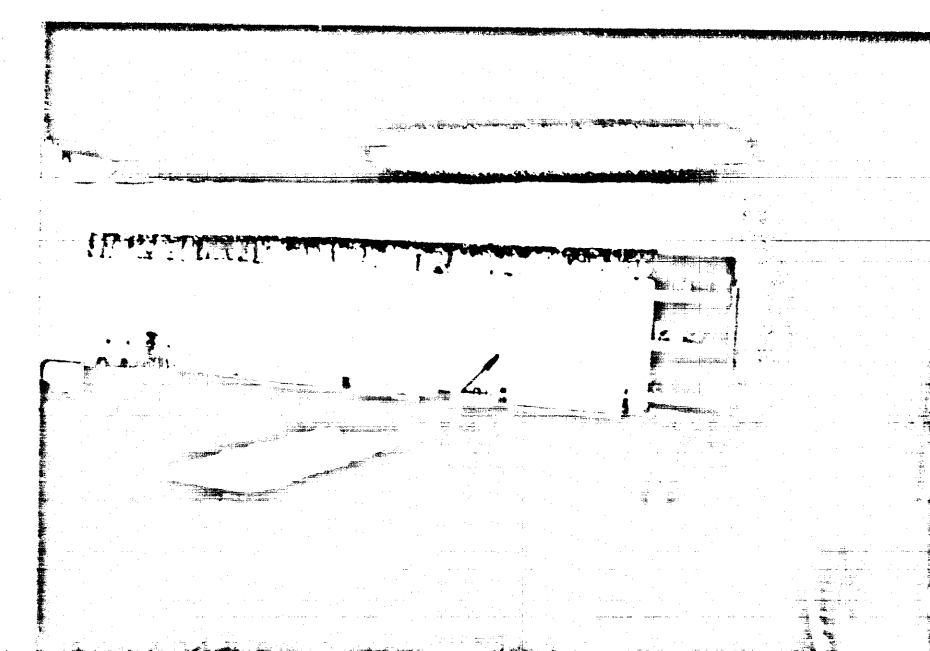


PHOTO DETAIL

4
A.15

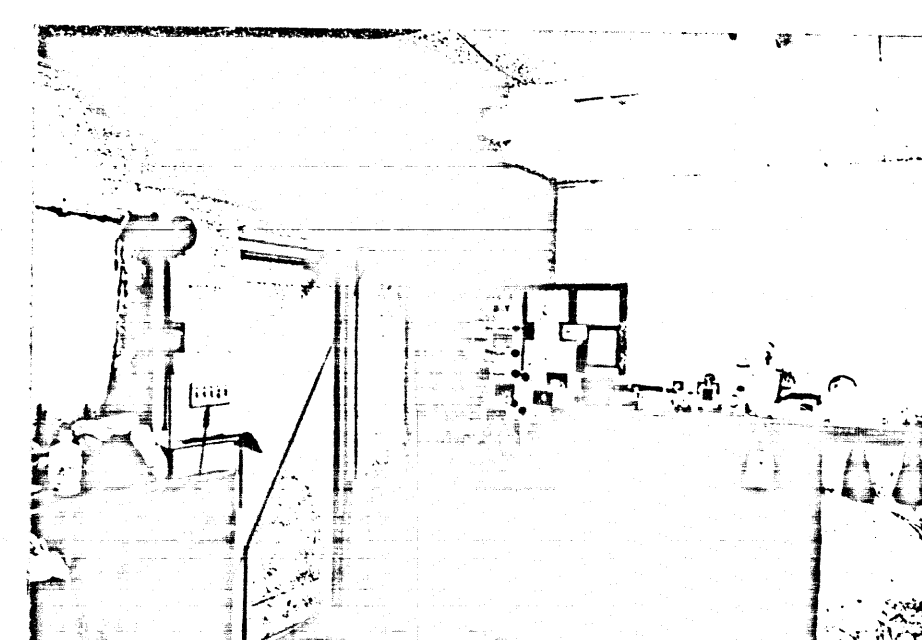


PHOTO DETAIL

5
A.15

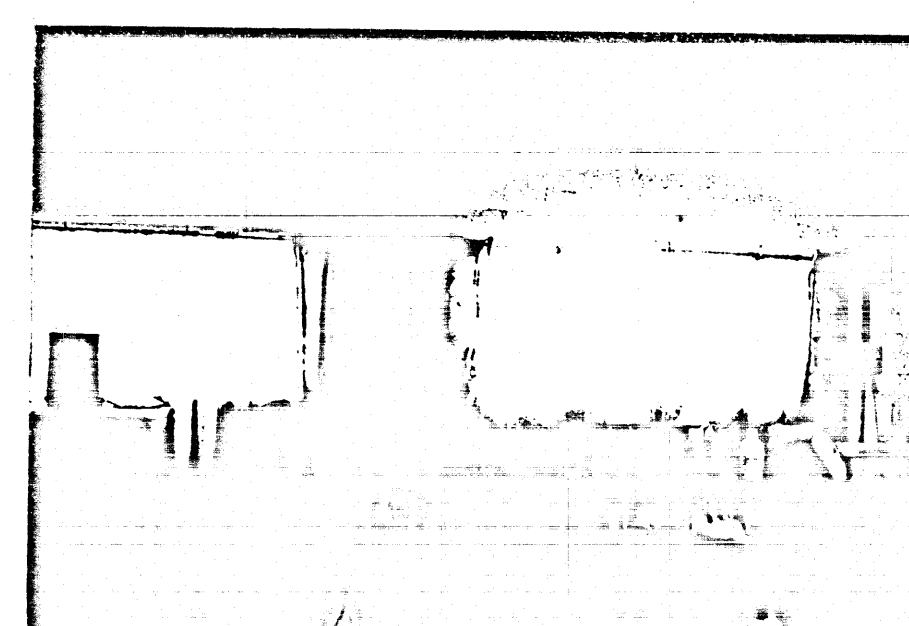


PHOTO DETAIL

6
A.15

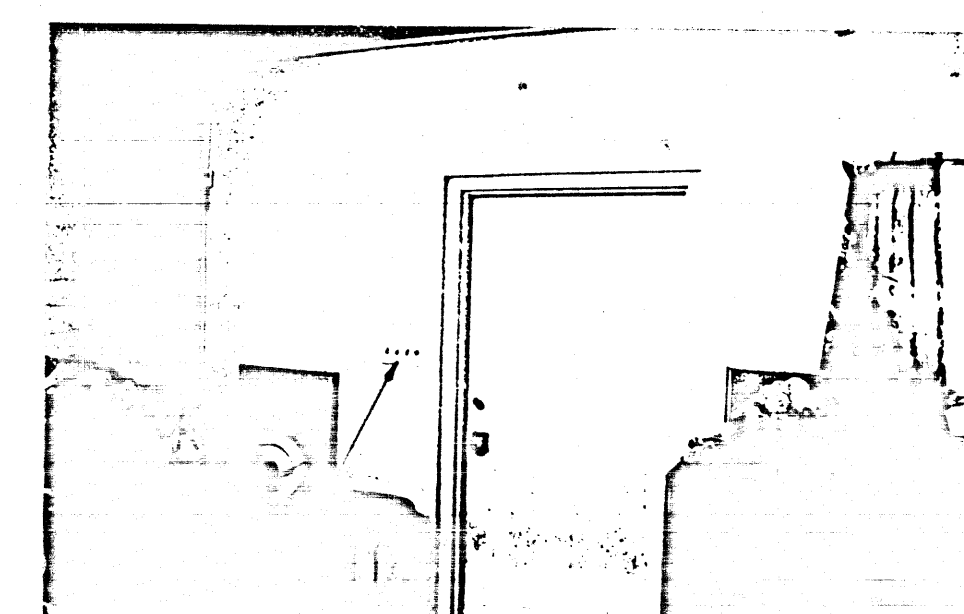


PHOTO DETAIL

7
A.15



PHOTO DETAIL

8
A.15

RECORD DRAWING

CITY OF LAS VEGAS
400 EAST STEWART AVENUE
LAS VEGAS, NEVADA 89101

ARCHITECT • GERALD CARADACH & ASSOCIATES A.I.A.

PHASE I (VARIETY CLUB)
"D" STREET / JEFFERSON AVENUE
NEIGHBORHOOD FACILITY PROJECT

WALL SECTIONS


drawn by: dan l. neider
issue dates:
11/3/88
11/22/88 bidding
revisions:
2/1/89 2nd bidding

job no.: 8737 LV.

A.15

23

de Built 1/7/25

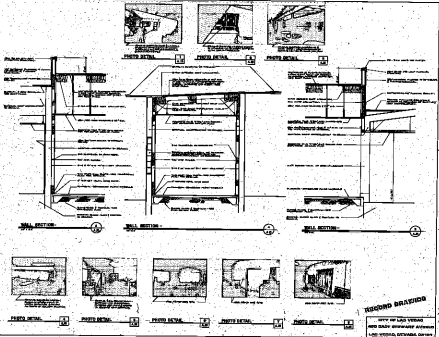

ARCHITECT - GEORGE HARRIS & ASSOCIATES
 1000 10TH AVENUE, SUITE 100
 DENVER, COLORADO 80202
 PROJECT - 1000 10TH AVENUE
 DRAWING - 1000 10TH AVENUE
 SCALE - 1/8" = 1'-0"
 DATE - 10/10/80
 SHEET - A.15
 1000 10TH AVENUE
 DENVER, COLORADO 80202
 1000 10TH AVENUE
 DENVER, COLORADO 80202