


AIR DEVICE SCHEDULE

SYMBOL OR I.D. NO.	D-1	D-2	D-3		G-1	G-2		R-1	R-2
MANUFACTURER	TITUS	TITUS	TITUS		TITUS	TITUS		TITUS	TITUS
MODEL NUMBER	PAS	PAS	PAS		PAR	PAR		300RS	300RS
TYPE	PERF. FACE DIFFUSER	PERF. FACE DIFFUSER	PERF. FACE DIFFUSER		PERF. FACE RETURN	PERF. FACE RETURN		SIDEWALL REGISTER	SIDEWALL REGISTER
SERVICE	SUPPLY	SUPPLY	SUPPLY		RETURN	RETURN		SUPPLY	SUPPLY
NECK SIZE (IN.)	(1) 6x6	8x8	10x10		14x14	18x18		12x4	14x6
FACE SIZE (IN.)	12x12	16x16	20x20		16x16	20x20		14x6	16x8
CFM RANGE	0-125	126-220	221-350		0-500	501-1170		90	175
THROW (FT. AT 50 FPM)	3	6	8		-	-		15	20
MAX. DUCT VELOCITY (FPM)	500	500	500		400	500		400	400
MAX. PRESSURE DROP (IN.)	0.04	0.05	0.07		0.05	0.07		0.05	0.05
NC RATING	13	18	24		13	15		16	12
MOUNTING	SURFACE	SURFACE	SURFACE		SURFACE	SURFACE		SURFACE	SURFACE
FINISH	OFF-WHITE	OFF-WHITE	OFF-WHITE		OFF-WHITE	OFF-WHITE		OFF-WHITE	OFF-WHITE
DAMPER	(2) DBVD	DBVD	DBVD		DBVD	DBVD		DBVD	DBVD

NOTES:


(1) PROVIDE SQUARE TO ROUND TRANSITION AS APPLICABLE.

(2) WHERE CALLED FOR ON THE PLANS PROVIDE (CFD) CEILING FIRE DAMPER EQUAL TO RUSKIN # CFDR ± OMIT DBVD ON THOSE PARTICULAR AIR DEVICES.

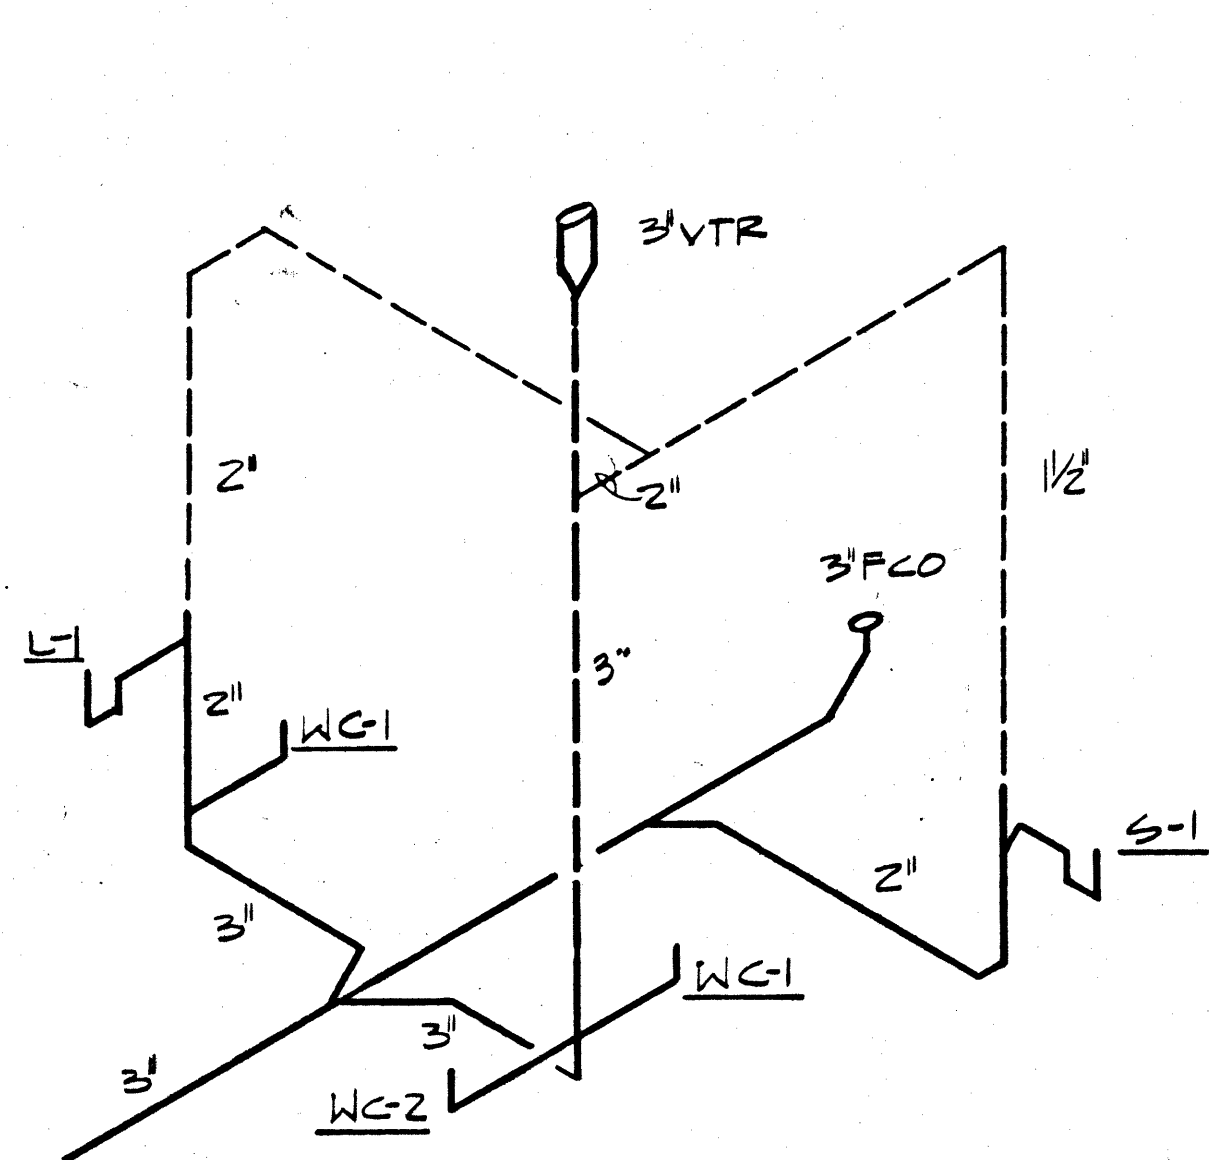


SOIL / WASTE / VENT DIAGRAM

RMS. 105 & 117

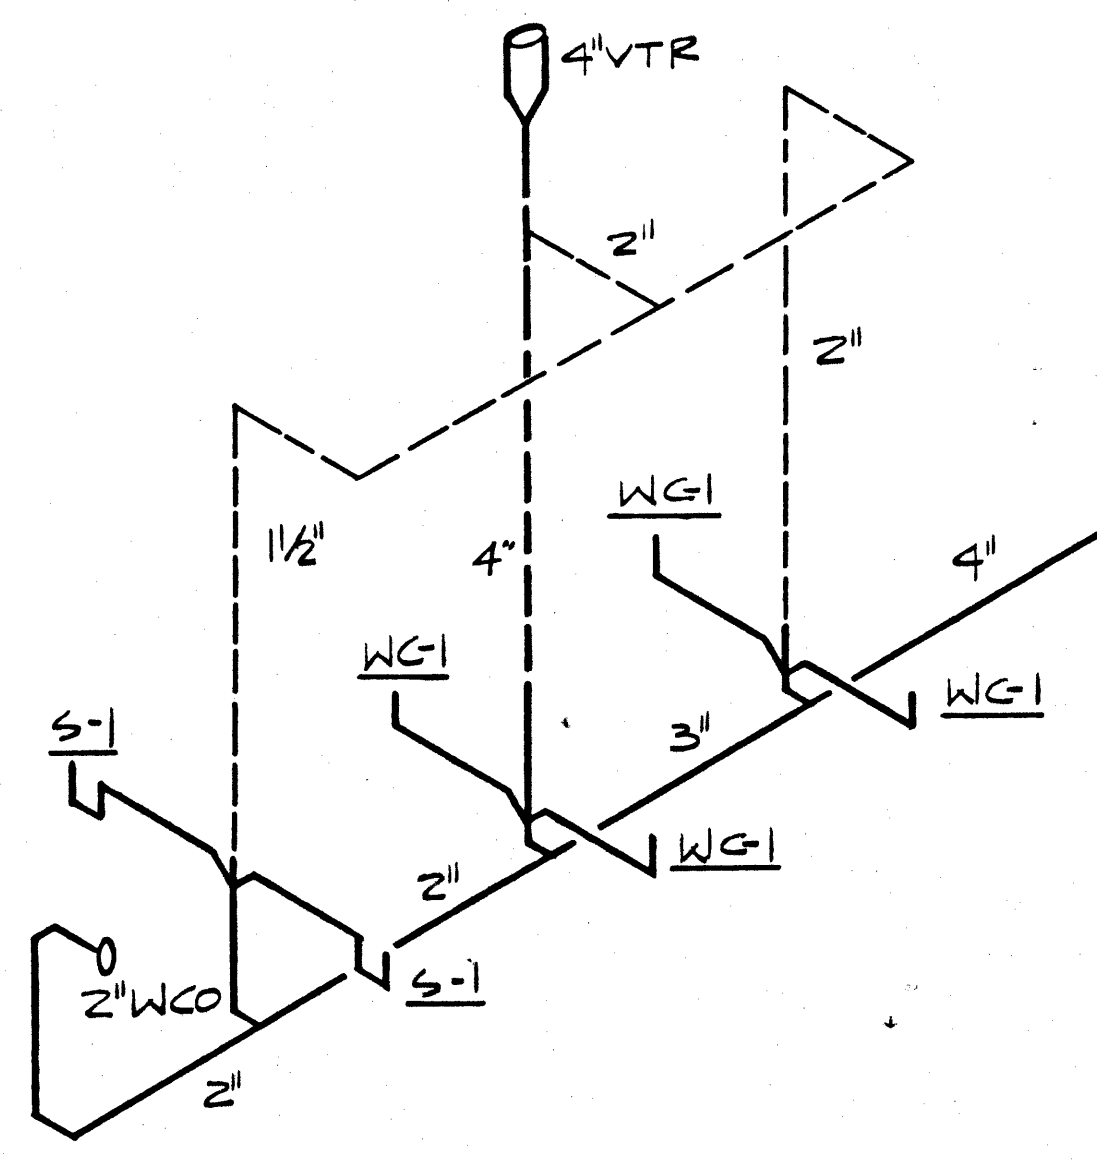


SOIL / WASTE / VENT DIAGRAM

RMS. 107, 108, 109 & 110

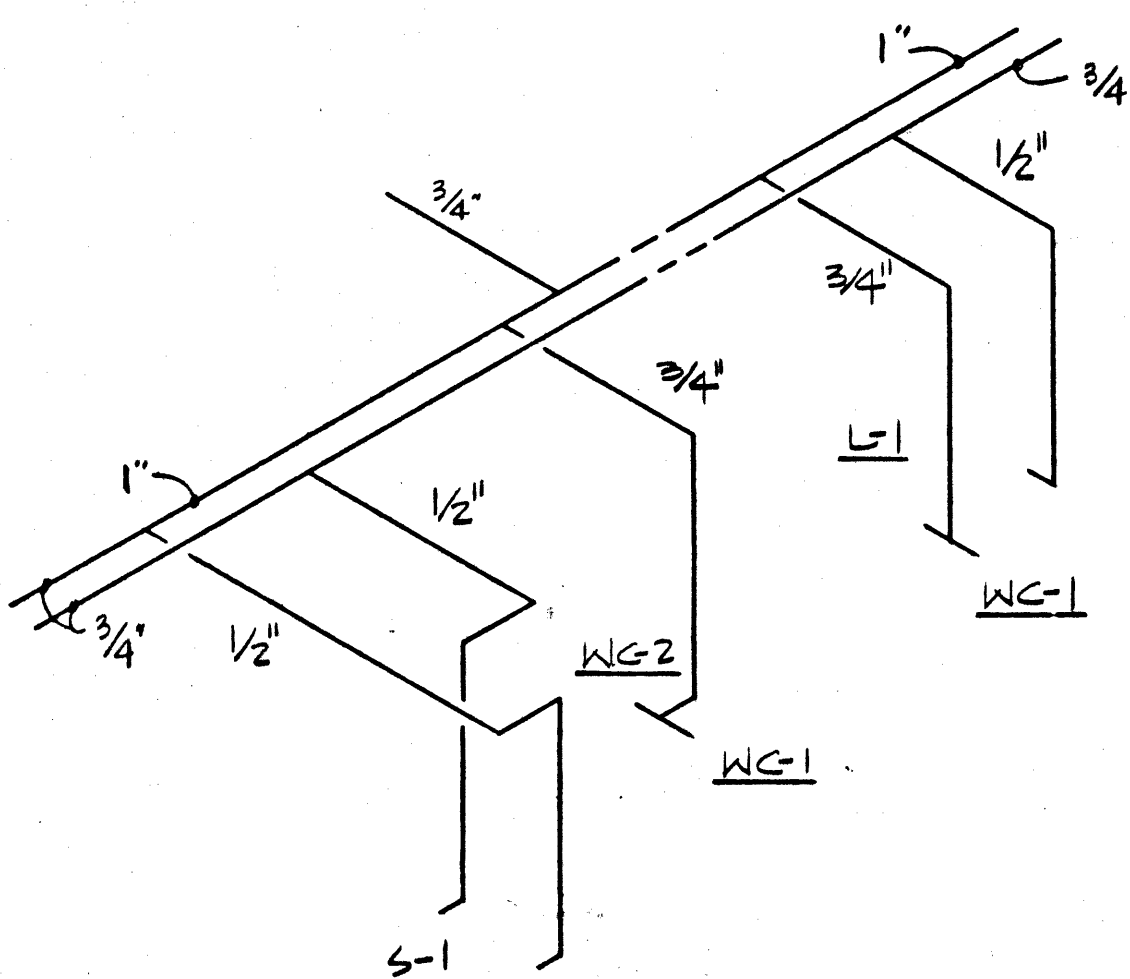

H & C WATER DIAGRAM

RMS. 105 & 117

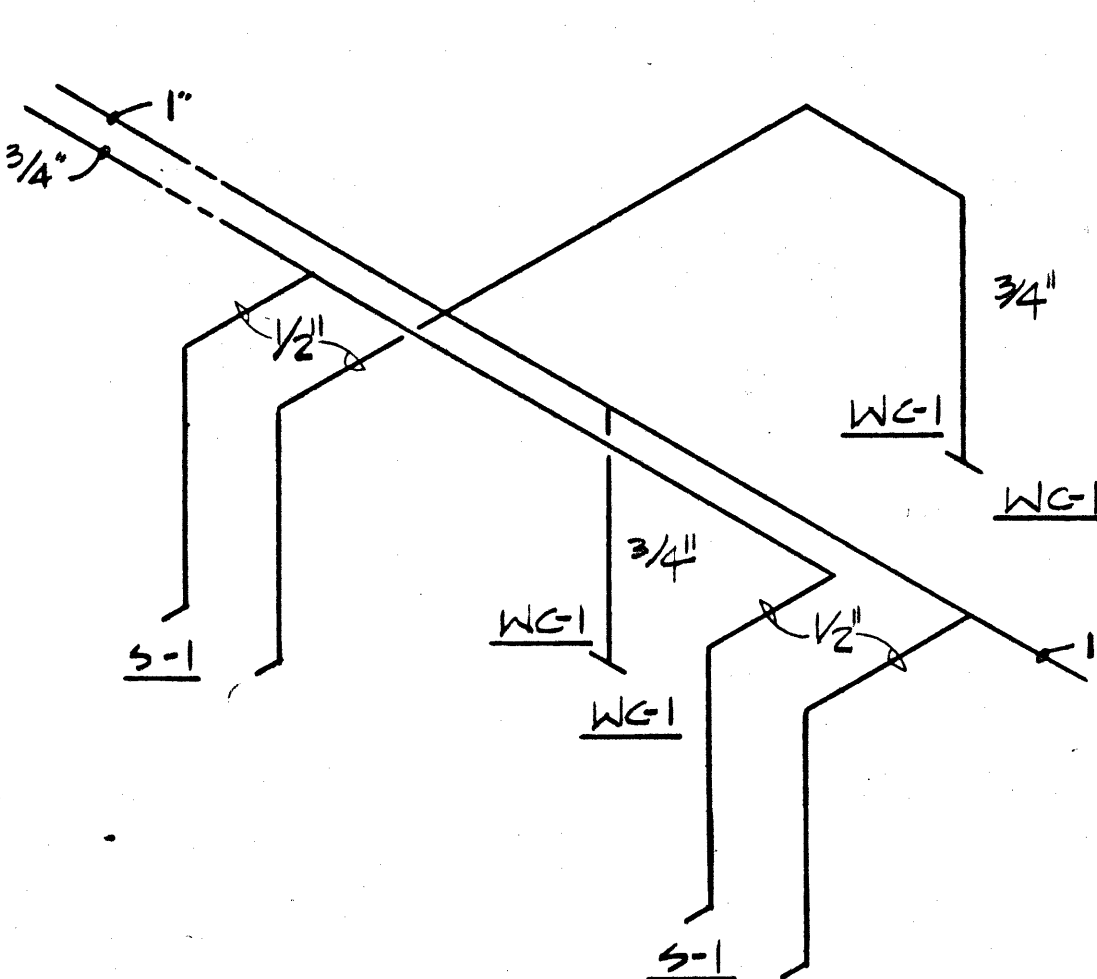

H & C WATER DIAGRAM

RMS. 107, 108, 109 & 110

ROOFTOP HVAC UNIT SCHEDULE

SYMBOL OR I.D. NO.	RT-1	RT-2	RT-3	RT-4
TYPE	GAS PAK	GAS PAK	GAS PAK	GAS PAK
MANUFACTURER	DAY & NIGHT	DAY & NIGHT	DAY & NIGHT	DAY & NIGHT
MODEL	585HJ042060	585HJ042060	585HJ048060	585HJ042060
O.A.T. SUMMER (DB/WB DEGREES F)	106/71	106/71	106/71	106/71
O.A.T. WINTER (DB DEGREES F)	26	26	26	26
ALTITUDE (FT.)	2162	2162	2162	2162
BAROMETRIC PRESSURE	27.656	27.656	27.656	27.656
OPERATING WEIGHT	625 #	550 #	700 #	1800 #
STD. CFM	1294	1294	1478	2172
ACTUAL CFM	1400	1400	1600	2000
MIN. OUTDOOR AIR (CFM)	140	140	240	450
EXTERNAL S.P.	0.35	0.35	0.35	0.35
RPM	HIGH	HIGH	HIGH	900
H.P.	1/2	1/2	1/2	1 1/2
FILTERS	(1) TA	TA	TA	TA
FUEL	NAT. GAS	NAT. GAS	NAT. GAS	NAT. GAS
INPUT (MBTU)	60	60	80	86/146
OUTPUT (MBTU)	46	47	63	63.6/116.8
BURNER TYPE	STD.	STD.	STD.	STD.
HEAT EXCHANGER	STD.	STD.	STD.	STD.
E.A.T. (DEGREES F)	-	-	-	-
L.A.T. (DEGREES F)	-	-	-	-
SENSIBLE CAPACITY (MBTU)	28.1	31.0	35.2	66.2
TOTAL CAPACITY (MBTU)	31.6	37.5	44.6	86.2
E.A.T. (DB/WB DEGREES F)	-	-	-	-
L.A.T. (DB/WB DEGREES F)	-	-	-	-
REFRIGERANT	R-22	R-22	R-22	R-22
VOLT-PHASE-HZ	208/230-1-60	208/230-1-60	208/230-1-60	208/230-1-60
FLA	29.8	30.1	42.7	
STARTERS	INTEGRAL	INTEGRAL	INTEGRAL	INTEGRAL
DISCONNECT	SEE ELEC.	SEE ELEC.	SEE ELEC.	SEE ELEC.

NOTES:


(1) PROVIDE 1" THROWAWAY FILTERS IN ACCORD W/ UNIT MFGRS. STANDARDS.

EXHAUST FAN SCHEDULE

SYMBOL OR I.D. NUMBER	EF-1
MANUFACTURER	FENN
MODEL NUMBER	ZB
TYPE	(1) CEILING
OPERATING WEIGHT	30 #
SERVICE	EXHAUST
STANDARD CFM	152
ACTUAL CFM	165
BLADE TYPE	STD
RPM	1050
TIP SPEED (FPM)	-
E.S.P. (IN. H ₂ O)	0.25
CLASS	-
OUTLET VELOCITY (FPM)	-
MOTOR H.P. (WATTS)	(105)
VOLTS-PHASE-HERTZ	115-1-60
STARTER TYPE	BY E.C.
SOUND ATTENUATION	-
ROOF CURB	-
DISCONNECT	PLUG-IN
BIRD SCREEN	-
MOUNTING COLLAR	-
BACKDRAFT DAMPER	-
ISOLATION BASE	-

NOTES:

(1) PROVIDE WALL CAP/ROOF JACK AS CALLED FOR ON PLANS.

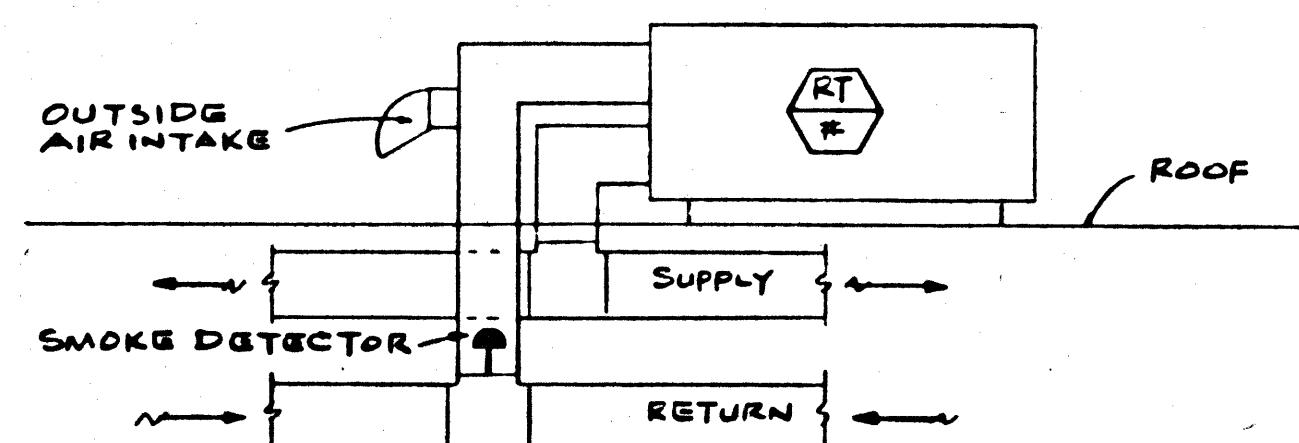

SMOKE DETECTOR DIAGRAM

NTS

NOTES:

1. SYSTEM RTA SHALL BE EQUIPPED WITH AN IONIZATION TYPE SHUT-OFF SMOKE DETECTOR.
2. ACTIVATION OF THE SMOKE DETECTOR SHALL CAUSE THE AIR MOVING UNIT TO SHUT DOWN.
3. MOUNT SMOKE DETECTOR IN MAIN RETURN AIR DUCT AHEAD OF OUTSIDE AIR INTAKE. MOUNT SMOKE DETECTOR IN A LOCATION WHICH IS READILY ACCESSIBLE FOR MAINTENANCE & REPLACEMENT.
4. WIRING SHALL BE DONE IN ACCORDANCE W/ REQUIREMENTS OF NEC & ELECTRICAL SECTION OF SPECIFICATIONS.
5. SUBMIT SHOP DRAWINGS OF DETECTOR, WIRING, LOCATION & INSTALLATION FOR APPROVAL.

MECHANICAL LEGEND

ABBR.	SYMBOL	DESCRIPTION
SUP	→	SUPPLY
RET	←	RETURN
EXH	↗	EXHAUST
O.A.	↗	OUTSIDE AIR
FLEX. D.	~	FLEXIBLE DUCT
FD	—▲—	FUSIBLE LINK FIRE DAMPER
M.V.D.	—■—	MANUAL VOLUME DAMPER
T.	⊙	THERMOSTAT
CD	⊙	CEILING DIFFUSER
REG.	—	REGISTER W/O B.O.
GR.	—	GRILLE W/O B.O.
D.L.	Q	DOOR LOUVER
U.C.	—	UNDER CUT
RO.	Φ	ROUND
CFM	—	CUBIC FEET PER MINUTE
S.O.W.	—	SOIL, WASTE OR SEWER BELOW GRADE
S.O.W.	—	SOIL, WASTE OR SEWER ABOVE GRADE
V	—	VENT
SD	—	STORM DRAIN BELOW GRADE
SD	—	STORM DRAIN ABOVE GRADE
CW	—	COLD WATER
HW	—	HOT WATER
G	—	GAS - LOW PRESSURE
D	—	DRAIN
BV	⊙	BALL VALVE
GV	⊙	GATE VALVE
GC	—	GAS COCK
FD	⊙	FLOOR DRAIN
FS	⊙	FLOOR SINK
FOGCO	⊙	FLOOR OR GRADE CLEANOUT
WCO	⊙	WALL CLEANOUT
HB	—	HOSE BIBB
WH	—	WALL HYDRANT
V.T.R.	⊙	VENT THRU ROOF
RO	⊙	ROOF DRAIN
O.F.D.	⊙	OVERFLOW DRAIN
—	⊙	ACCESS DOOR
SOV	⊙	SHUT OFF VALVE
P.O.C.	⊙	POINT OF CONNECTION
CFD	⊙	CEILING FIRE DAMPER
SD	⊙	SMOKE DETECTOR

PLUMBING FIXTURE SCHEDULE

ABBR.	FIXTURE	ROUGH-IN SIZES (inches)					REMARKS
		HW	CW	V	TRAP	SO/W	
L-1	LAVATORY	1/2	1/2	1 1/2	1 1/2	2	
S-1	SINK	1/2	1/2	1 1/2	1 1/2	1 1/2	
WC-1	WATER CLOSET	—	1/2	2	INT.	3	
WC-2	WATER CLOSET	—	1/2	2	INT.	3	
WH-1	WATER HEATER	3/4	3/4	—	—	—	
FS	FLOOR SINK	—	—	1 1/2	INT.	2	
HB	HOSE BIBB	—	3/4	—	—	—	

PLUMBING FIXTURE SPECIFICATIONS

- WC-1 WATER CLOSET
KOHLER PRIMARY TOILET NO. K-4319-ET FLOOR MOUNTED VITREOUS CHINA SIPHON JET ELONGATED TOILET WITH TANK, FURNISHED IN WHITE, KOHLER NO. K-4686-C ELONGATED OPEN FRONT TOILET SEAT FURNISHED IN WHITE, AND CHROME PLATED BRASSCRAFT SUPPLY.
- WC-2 WATER CLOSET
BRIGGS CONSERVOR MODEL 4718 FLOOR MOUNTED VITREOUS CHINA SIPHON JET ELONGATED FRONT WITH CLOSE-COUPLED TANK FURNISHED IN WHITE, OLSONITE MODEL 95 TOILET SEAT LESS COVER FURNISHED IN WHITE, AND CHROME PLATED BRASSCRAFT SUPPLY.
- L-1 LAVATORY
BRIGGS MILTON 1 MODEL NO. 6601 (20" X 18") WALL HUNG VITREOUS CHINA FURNISHED IN WHITE, MOEN MODEL NO. 4096-A EASY GRIP HANDLE FAUCET, ROYAL BRASS MODEL NO. 39-400 GRID DRAIN ASSEMBLY, 17 GAUGE BRASS CHROME PLATED P-TRAP (1-1/4" X 1-1/2"), CHROME PLATED BRASSCRAFT SUPPLIES, AND J.R. SMITH FIG. 800 WALL MOUNTED SUPPORT PLATE.
- S-1 SINK
DAYTON KINGSFORD MODEL NO. D-11719, 3 FAUCET HOLES, SELF-RIMMING STAINLESS STEEL SINGLE COMPARTMENT SINK, MOEN MODEL NO. 7531-8 KITCHEN FAUCET, DAYTON DUO-STRAINER MODEL NO. D-1125, 17 GAUGE BRASS CHROME PLATED TAILPIECE (1-1/2"), 17 GAUGE BRASS CHROME PLATED P-TRAP (1-1/2") AND CHROME PLATED BRASSCRAFT SUPPLIES.
- FS FLOOR SINK
COMMERCIAL ENAMELING COMPANY MODEL 908 WITH GRATE AS REQUIRED.
- HB-1 HOSE BIBB
WOODFORD MODEL 25C AUTOMATIC DRAINING FREEZELESS WALL FAUCET WITH VACUUM BREAKER.
- RO/ORD ROOF DRAIN AND OVERFLOW DRAIN
TECH. SPECIALTIES COMBINATION ROOF DRAIN WITH DOME GRATE AND OVERFLOW DRAIN ASSEMBLY.
- WH-1 WATER HEATER
AMERICAN MODEL NO. ER320, 2-4.5 KW ELEMENTS (FOR NON-SIMULTANEOUS OPERATION) 200V/18/60HZ, 18 GPH RECOVERY AT 100 DEGREE RISE, 30 GALLON GLASS-LINED STORAGE TANK, FURNISHED COMPLETE WITH TEMPERATURE AND PRESSURE RELIEF VALVE.
- SP-1 SUMP PUMP
PACO PUMPS MODEL P1P700, SUBMERSIBLE SUMP PUMP, 1/3 HP, 115V/18/60 HZ WITH AUTOMATIC SOLID STATE LEVEL CONTROL SWITCH.
- NOTE: ABOVE ITEMS WERE USED AS A BASIS OF DESIGN, OTHER MANUFACTURER'S PRODUCTS WILL BE ACCEPTABLE WITH THE OWNERS APPROVAL.

HARRIS
ENGINEERS, INC.
MECHANICAL/ELECTRICAL CONSULTANTS
2785 East Desert Inn Road, Suite 200
Las Vegas, Nevada 89121
702/788-0228

CITY OF LAS VEGAS
400 EAST STEWART AVENUE
LAS VEGAS, NEVADA 89101

ARCHITECT • GERALD GARAPICH &
ASSOCIATES A.I.A.

PHASE I (VARIETY CLUB)
"D" STREET / JEFFERSON AVENUE
NEIGHBORHOOD FACILITY PROJECT

SCHEDULES AND LEGEND

drawn by: DY
issue dates:
11/3/88
11/22/88 bidding

revisions:
2/1/89 2nd. bidding

Job no.:

M.1

26

As Built 671-25

[illegible]

1	2	3	466
---	---	---	---	---	---	---	---	---	----	----	-----	-----	
© 2000 Blackwell Science Ltd, *Journal of Internal Medicine* 247: 399–406

[illegible]

1999, 2000, 2001, 2680, 26



1997, 1998, 1999, 2678, 26



[Home](#)
[About Us](#)
[Contact Us](#)
[Privacy Policy](#)

1. **Introduction**
 2. **Background**
 3. **Methodology**
 4. **Results**
 5. **Conclusion**
 6. **References**
 7. **Appendix**
 8. **Index**
 9. **Table of Contents**
 10. **Figure 1**
 11. **Figure 2**
 12. **Figure 3**
 217. **Figure 208**

Account	Debit	Credit
1000 Cash		1000
1010 Accounts Receivable	1000	
1020 Inventory		1000
1030 Prepaid Insurance		1000
1040 Equipment		1000
1050 Accumulated Depreciation		1000
1060 Land		1000
1070 Buildings		1000
1080 Intangible Assets		1000
2000 Accounts Payable		1000
2010 Notes Payable		1000
2020 Long-Term Debt		1000
2030 Equity		1000
2040 Retained Earnings		1000
2050 Dividends	1000	
2060 Revenue		1000
2070 Expenses	1000	
2080 Income Tax Expense		1000
2090 Other Income		1000
2100 Other Expenses	1000	
2110 Depreciation Expense	1000	
2120 Amortization Expense	1000	
2130 Impairment Expense	1000	
2140 Loss on Sale of Assets	1000	
2150 Gain on Sale of Assets		1000
2160 Interest Income		1000
2170 Interest Expense	1000	
2180 Dividend Income		1000
2190 Dividend Expense	1000	
2200 Other Income		1000
2210 Other Expenses	1000	
2220 Depreciation Expense	1000	
2230 Amortization Expense	1000	
2240 Impairment Expense	1000	
2250 Loss on Sale of Assets	1000	
2260 Gain on Sale of Assets		1000
2270 Interest Income		1000
2280 Interest Expense	1000	
2290 Dividend Income		1000
2300 Dividend Expense	1000	
2310 Other Income		1000
2320 Other Expenses	1000	
2330 Depreciation Expense	1000	
2340 Amortization Expense	1000	
2350 Impairment Expense	1000	
2360 Loss on Sale of Assets	1000	
2370 Gain on Sale of Assets		1000
2380 Interest Income		1000
2390 Interest Expense	1000	
2400 Dividend Income		1000
2410 Dividend Expense	1000	
2420 Other Income		1000
2430 Other Expenses	1000	
2440 Depreciation Expense	1000	
2450 Amortization Expense	1000	
2460 Impairment Expense	1000	
2470 Loss on Sale of Assets	1000	
2480 Gain on Sale of Assets		1000
2490 Interest Income		1000
2500 Interest Expense	1000	
2510 Dividend Income		1000
2520 Dividend Expense	1000	
2530 Other Income		1000
2540 Other Expenses	1000	
2550 Depreciation Expense	1000	
2560 Amortization Expense	1000	
2570 Impairment Expense	1000	
2580 Loss on Sale of Assets	1000	
2590 Gain on Sale of Assets		1000
2600 Interest Income		1000
2610 Interest Expense	1000	
2620 Dividend Income		1000
2630 Dividend Expense	1000	
2640 Other Income		1000
2650 Other Expenses	1000	
2660 Depreciation Expense	1000	
2670 Amortization Expense	1000	
2680 Impairment Expense	1000	
2690 Loss on Sale of Assets	1000	
2700 Gain on Sale of Assets		1000
2710 Interest Income		1000
2720 Interest Expense	1000	
2730 Dividend Income		1000
2740 Dividend Expense	1000	
2750 Other Income		1000
2760 Other Expenses	1000	
2770 Depreciation Expense	1000	
2780 Amortization Expense	1000	
2790 Impairment Expense	1000	
2800 Loss on Sale of Assets	1000	
2810 Gain on Sale of Assets		1000
2820 Interest Income		1000
2830 Interest Expense	1000	
2840 Dividend Income		1000
2850 Dividend Expense	1000	
2860 Other Income		1000
2870 Other Expenses	1000	
2880 Depreciation Expense	1000	
2890 Amortization Expense	1000	
2900 Impairment Expense	1000	
2910 Loss on Sale of Assets	1000	
2920 Gain on Sale of Assets		1000
2930 Interest Income		1000
2940 Interest Expense	1000	
2950 Dividend Income		1000
2960 Dividend Expense	1000	
2970 Other Income		1000
2980 Other Expenses	1000	
2990 Depreciation Expense	1000	
3000 Amortization Expense	1000	
3010 Impairment Expense	1000	
3020 Loss on Sale of Assets	1000	
3030 Gain on Sale of Assets		1000
3040 Interest Income		1000
3050 Interest Expense	1000	
3060 Dividend		

[illegible][illegible]

1. **THE CLASS PLANET**
2. **HOW TO CLASSIFY YOUR WORK**
3. **HOW TO GET THE MOST OUT OF YOUR CLASS**
4. **HOW TO GET THE MOST OUT OF YOUR CLASS**
5. **HOW TO GET THE MOST OUT OF YOUR CLASS**
6. **HOW TO GET THE MOST OUT OF YOUR CLASS**

PLANNING PROFILE SCHEDULE				
DATE	PERIOD	SCHEDULED WORK PERIOD		
1	1/1/78			
2	1/2/78			
3	1/3/78			
31	1/31/78			

PLANNING YOUR RESEARCH

1. **What is the purpose of your research?**

2. **What are the research questions?**

3. **What are the hypotheses?**

4. **What are the variables?**

5. **What are the methods?**

6. **What are the results?**

7. **What are the conclusions?**

8. **What are the implications?**

9. **What are the limitations?**

10. **What are the future directions?**

STAFF **MAN** **WOMAN** **CHILD**
STAFF **MAN** **WOMAN** **CHILD**
STAFF **MAN** **WOMAN** **CHILD**