


KEYNOTES

- 1 EXISTING BUILDING TO REMAIN
- 2 EXISTING CHAIN LINK FENCE TO REMAIN
- 3 EXISTING CONC. BLK. WALL TO REMAIN
- 4 EXISTING CONC. WALKS TO REMAIN
- 5 EXISTING A/C PAVING TO REMAIN
PERMITS NEW SEAL COAT
- 6 EXISTING LANDSCAPING
- 7 EXISTING CHAIN LINK FENCE TO BE REMOVED
AND RESEAL
- 8 EXISTING CONC. BLK. WALL TO BE REMOVED
- 9 EXISTING CONC. SLAB & WALKS TO BE REMOVED
- 10 EXISTING CONC. PLAY BLDG. TO BE REMOVED
- 11 EXISTING TREES TO BE RELOCATED
- 12 EXISTING GRAVEL
- 13 EXISTING CURB TO REMAIN
- 14 EXISTING A/C PAVING TO BE REMOVED
- 15 EXISTING LIGHT POLE TO BE REMOVED

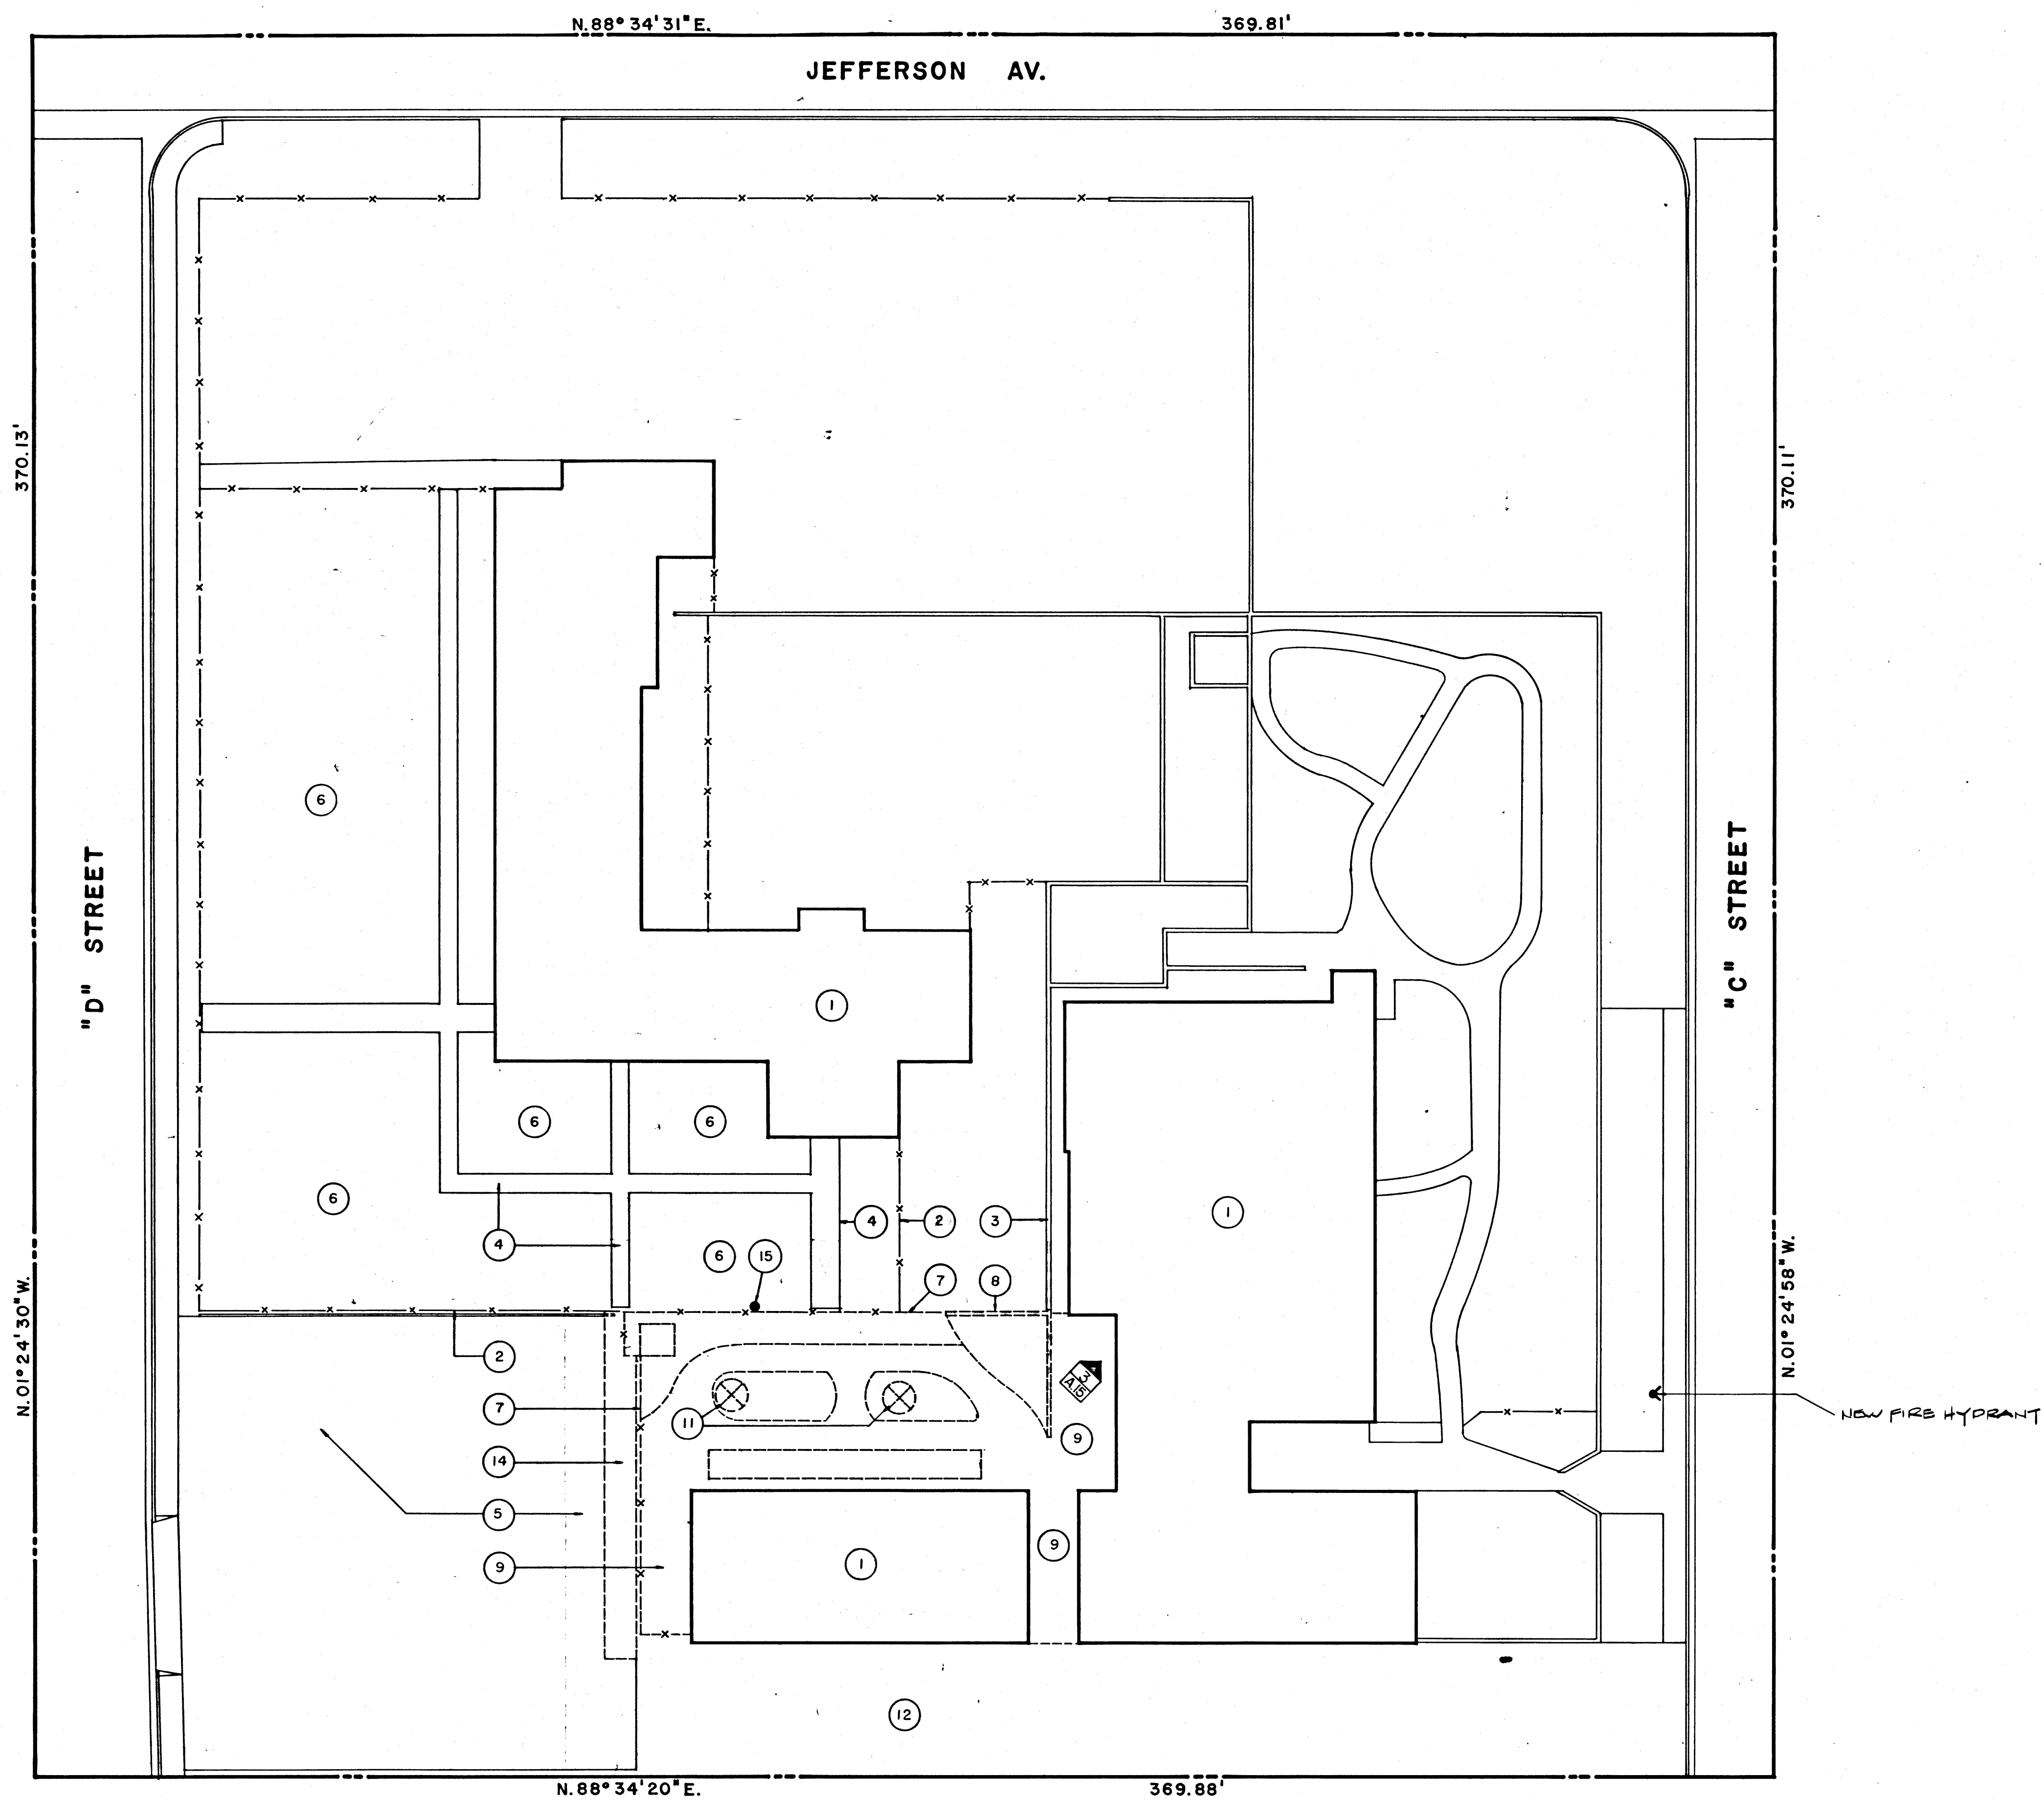

DEMOLITION SITE PLAN

1" = 20'

RECORD DRAWING

CITY OF LAS VEGAS
400 EAST STEWART AVENUE
LAS VEGAS, NEVADA 89101

ARCHITECT • CRAIG CAPADICH &
ASSOCIATES A.I.A.

2000 FIFTH AVENUE, SUITE 201, SAN DIEGO, CA 92101 (619) 233-7296
2000 PIEDRO DEL PRADO, C-1058, LAS VEGAS, NV 89002 (702) 387-4445

PHASE I (VARIETY CLUB)
"D" STREET / JEFFERSON AVENUE
NEIGHBORHOOD FACILITY PROJECT

DEMOLITION PLAN

drawn by: RB
issue dates:
11/3/88
11/22/88 bidding

revisions:
2/1/89 2nd bidding


job no.: 8737 LV

A.1

9

As Built 6/11/25

- LEGEND**
- 1. EXISTING BUILDING
 - 2. EXISTING DRIVE
 - 3. EXISTING DRIVE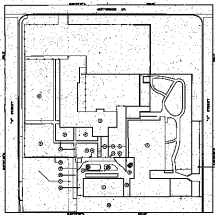
REDACTED SITE PLAN

RECORD DRAWING

REVISED BY: [Redacted]
 DATE: [Redacted]
 DRAWN BY: [Redacted]
 CHECKED BY: [Redacted]
 APPROVED BY: [Redacted]