



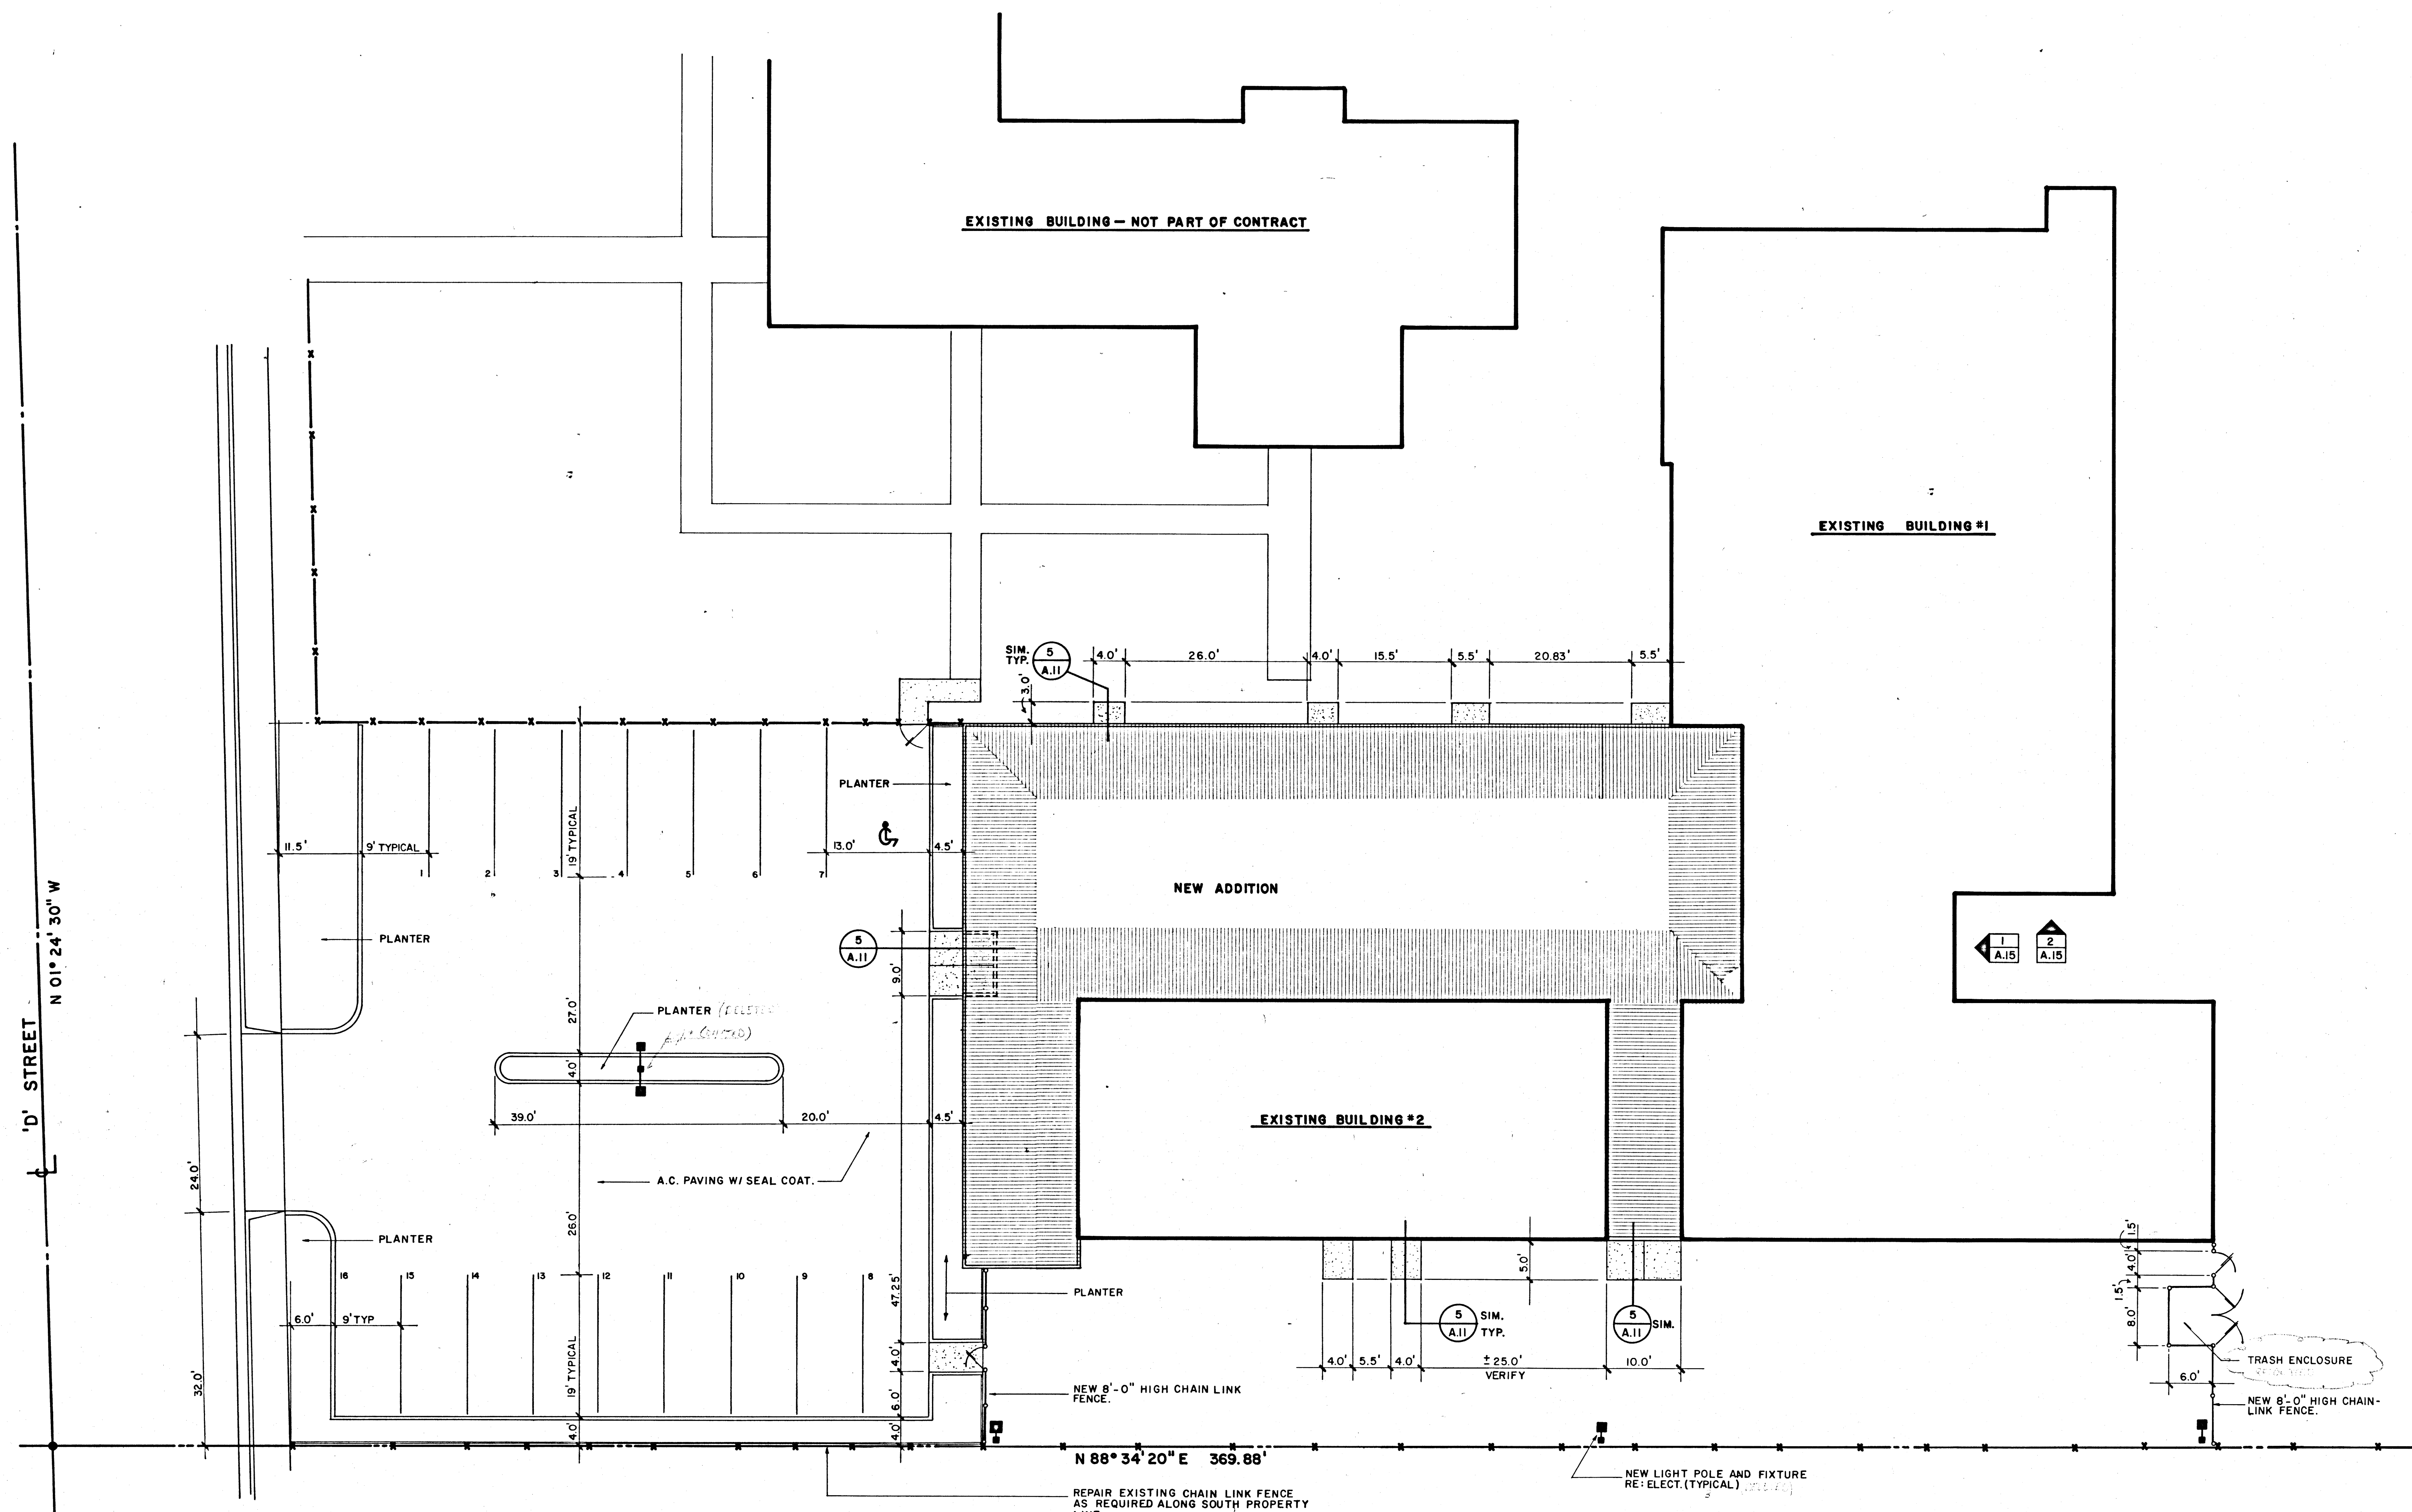

SITE PLAN

1" = 10.00'

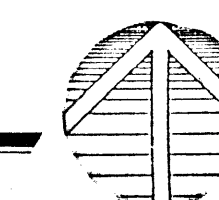


RECORD DRAWING

**CITY OF LAS VEGAS
400 EAST STEWART AVENUE
LAS VEGAS, NEVADA 89101**

ARCHITECT • GERALD GARAPICH & ASSOCIATES A.I.A.
2320 FIFTH AVENUE, SUITE 201, SAN DIEGO, CA 92101 (619) 233-7296
2300 PASO DEL PRADO, C-108, LAS VEGAS, NV 89102 (702) 367-4445

PHASE I (VARIETY CLUB)
"D" STREET / JEFFERSON AVENUE
NEIGHBORHOOD FACILITY PROJECT

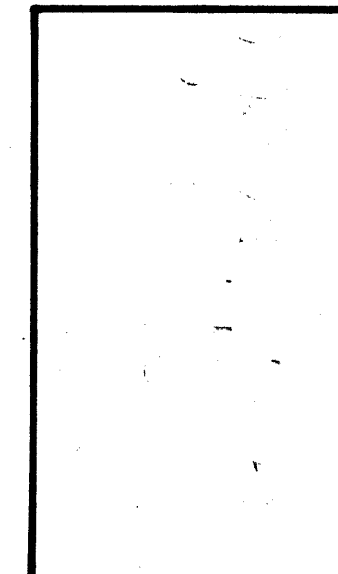

SITE PLAN

drawn by: don l. nelder
issue date: 11/3/88


11/22/88 bidding

revisions:
2/1/89 2nd bidding

job no.: 8737LV

A.2

10

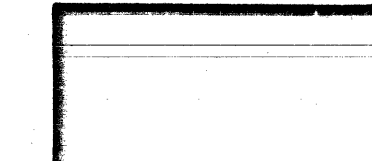

As Built 671-25

