



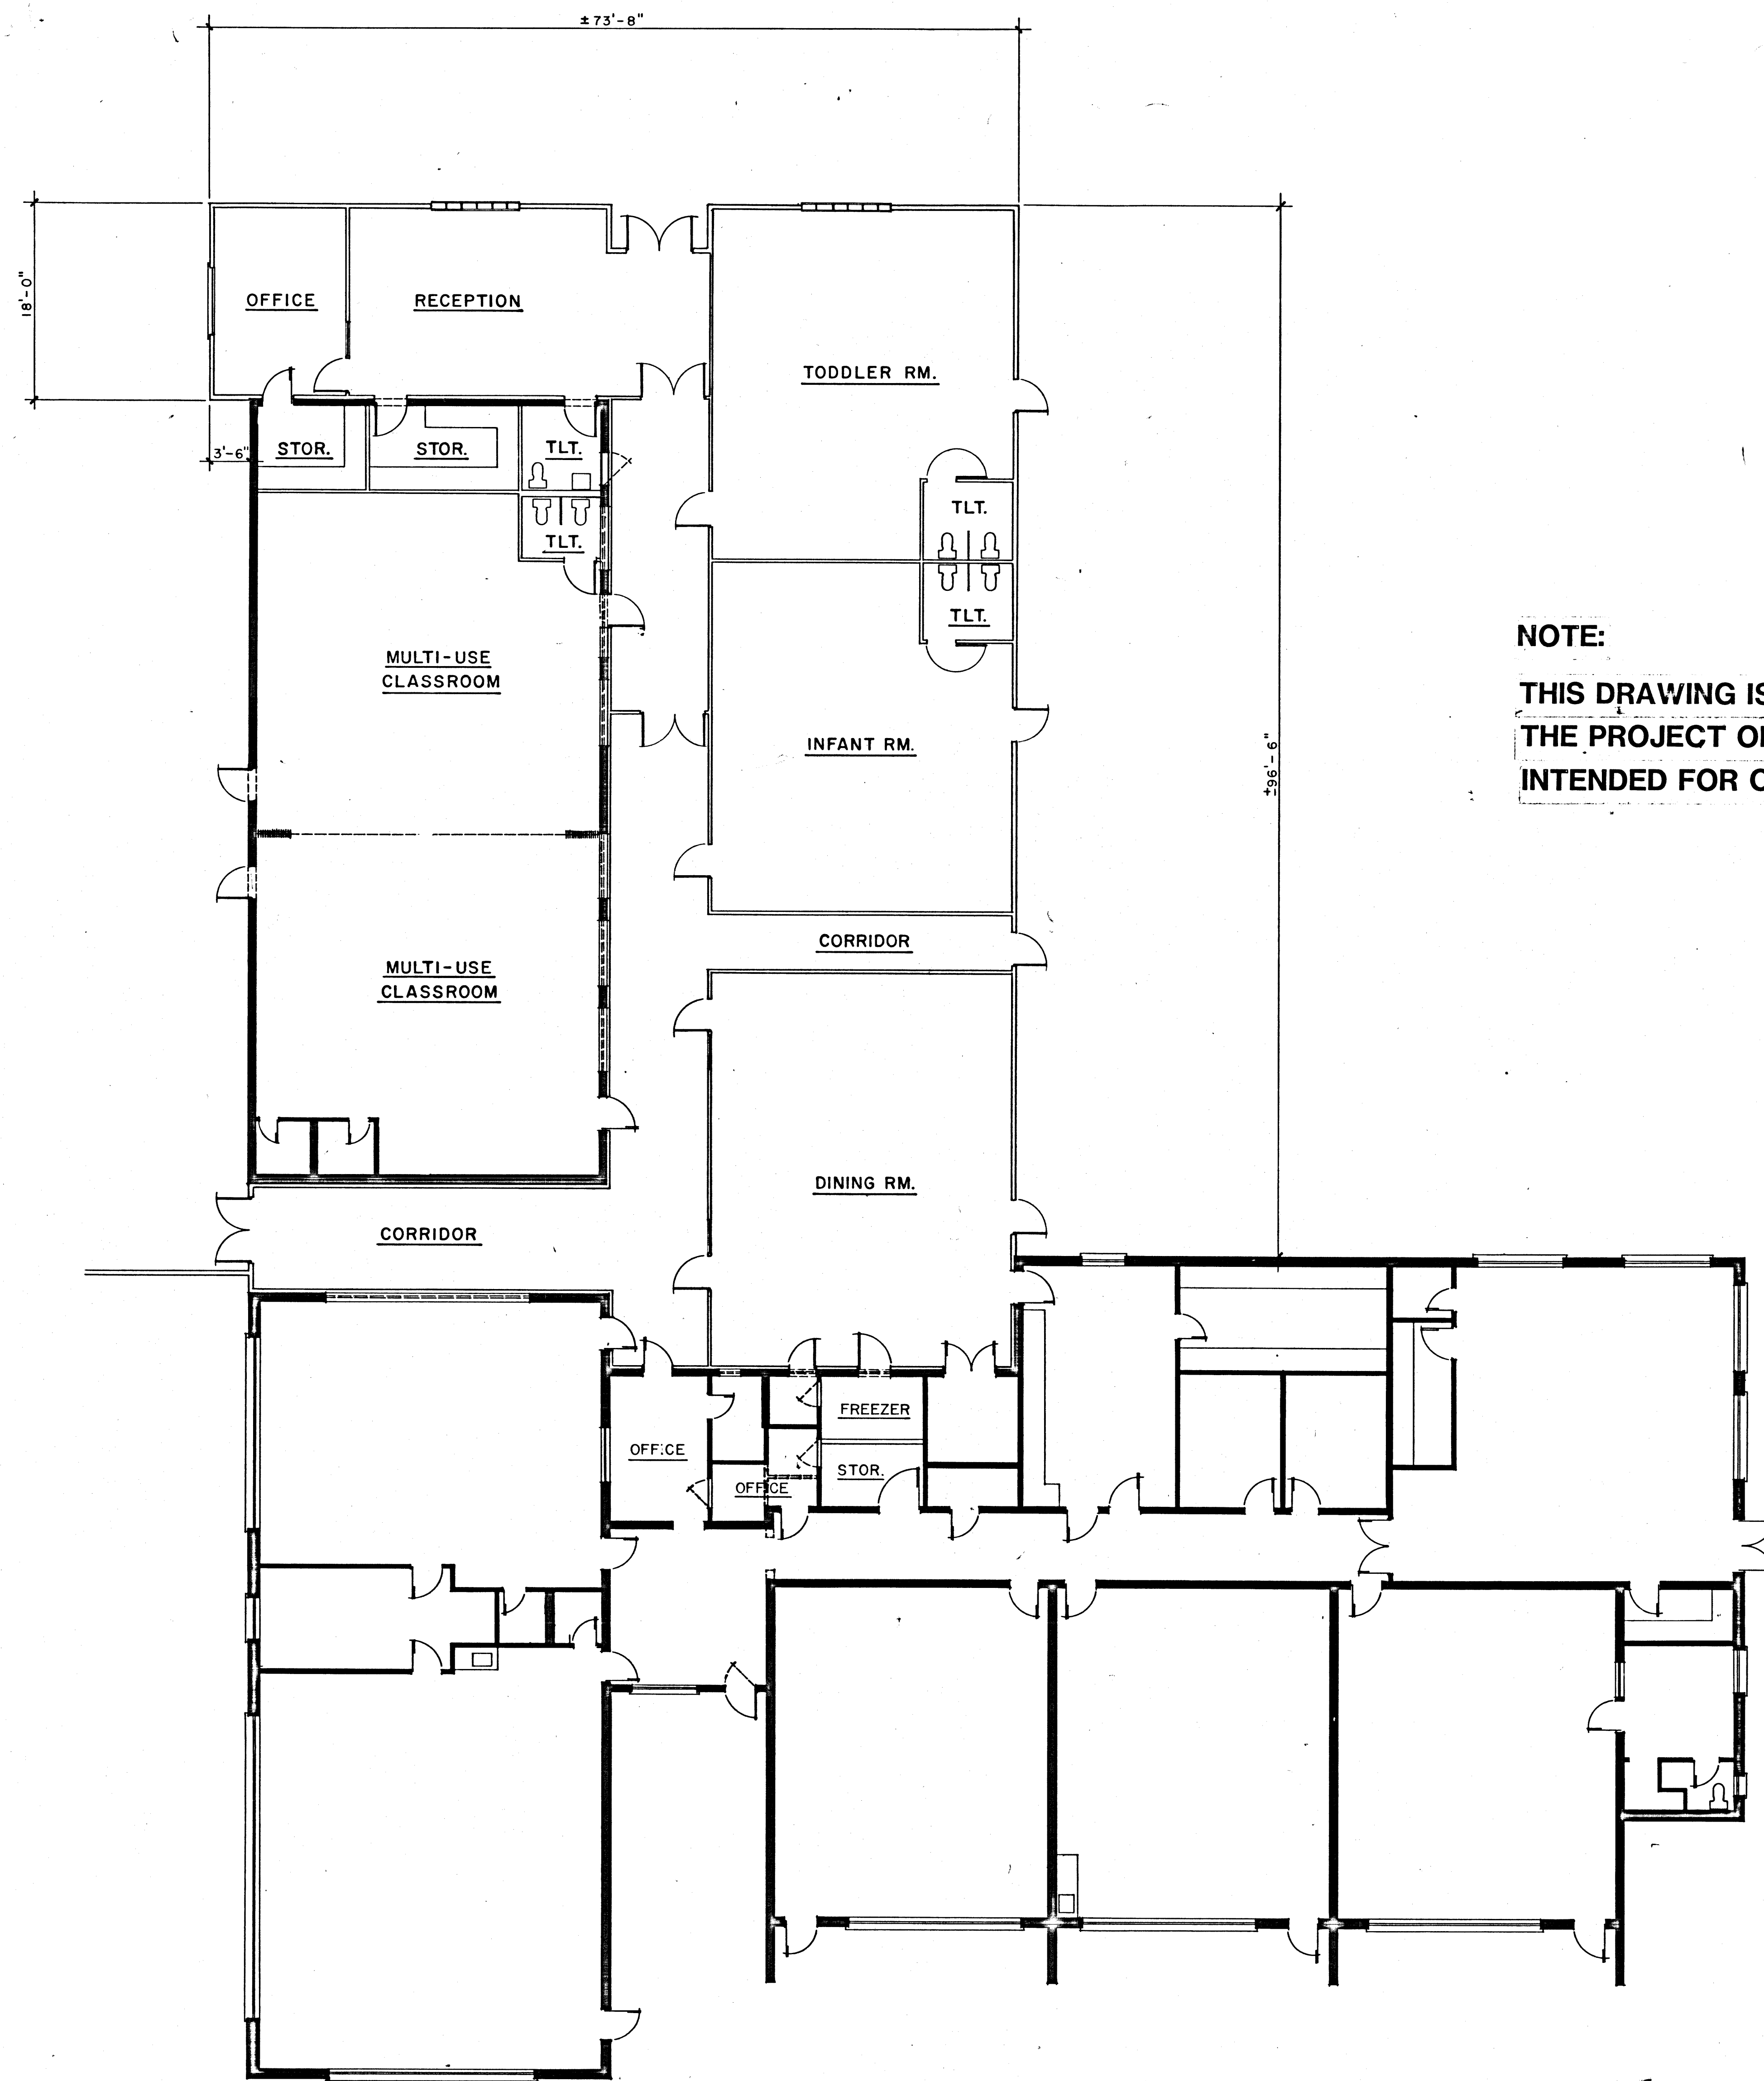

OVERALL FLOOR PLAN (NEW/EXISTING)

1/8" = 1'-0"

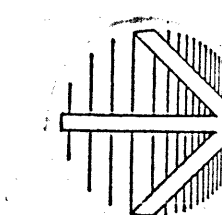

RECORD DRAWING

CITY OF LAS VEGAS
400 EAST STEWART AVENUE
LAS VEGAS, NEVADA 89101

ARCHITECT • GERALD CARAPICH &
ASSOCIATES A.I.A.

2200 FIFTH AVENUE, SUITE 201, SAN DIEGO, CA 92101 (619) 583-7286
2200 PASEO DEL PRADO, C-108, LAS VEGAS, NV 89102 (702) 367-4446

PHASE I (VARIETY CLUB)

700 STREET / JEFFERSON AVENUE
NEIGHBORHOOD FACILITY PROJECT

OVERALL
FLOOR PLAN

drawn by: RB
issue dates:
11/3/88
11/22/88 bidding

revisions:
2/1/89 2nd bidding

job no.: 8737LV

A.3

11

