


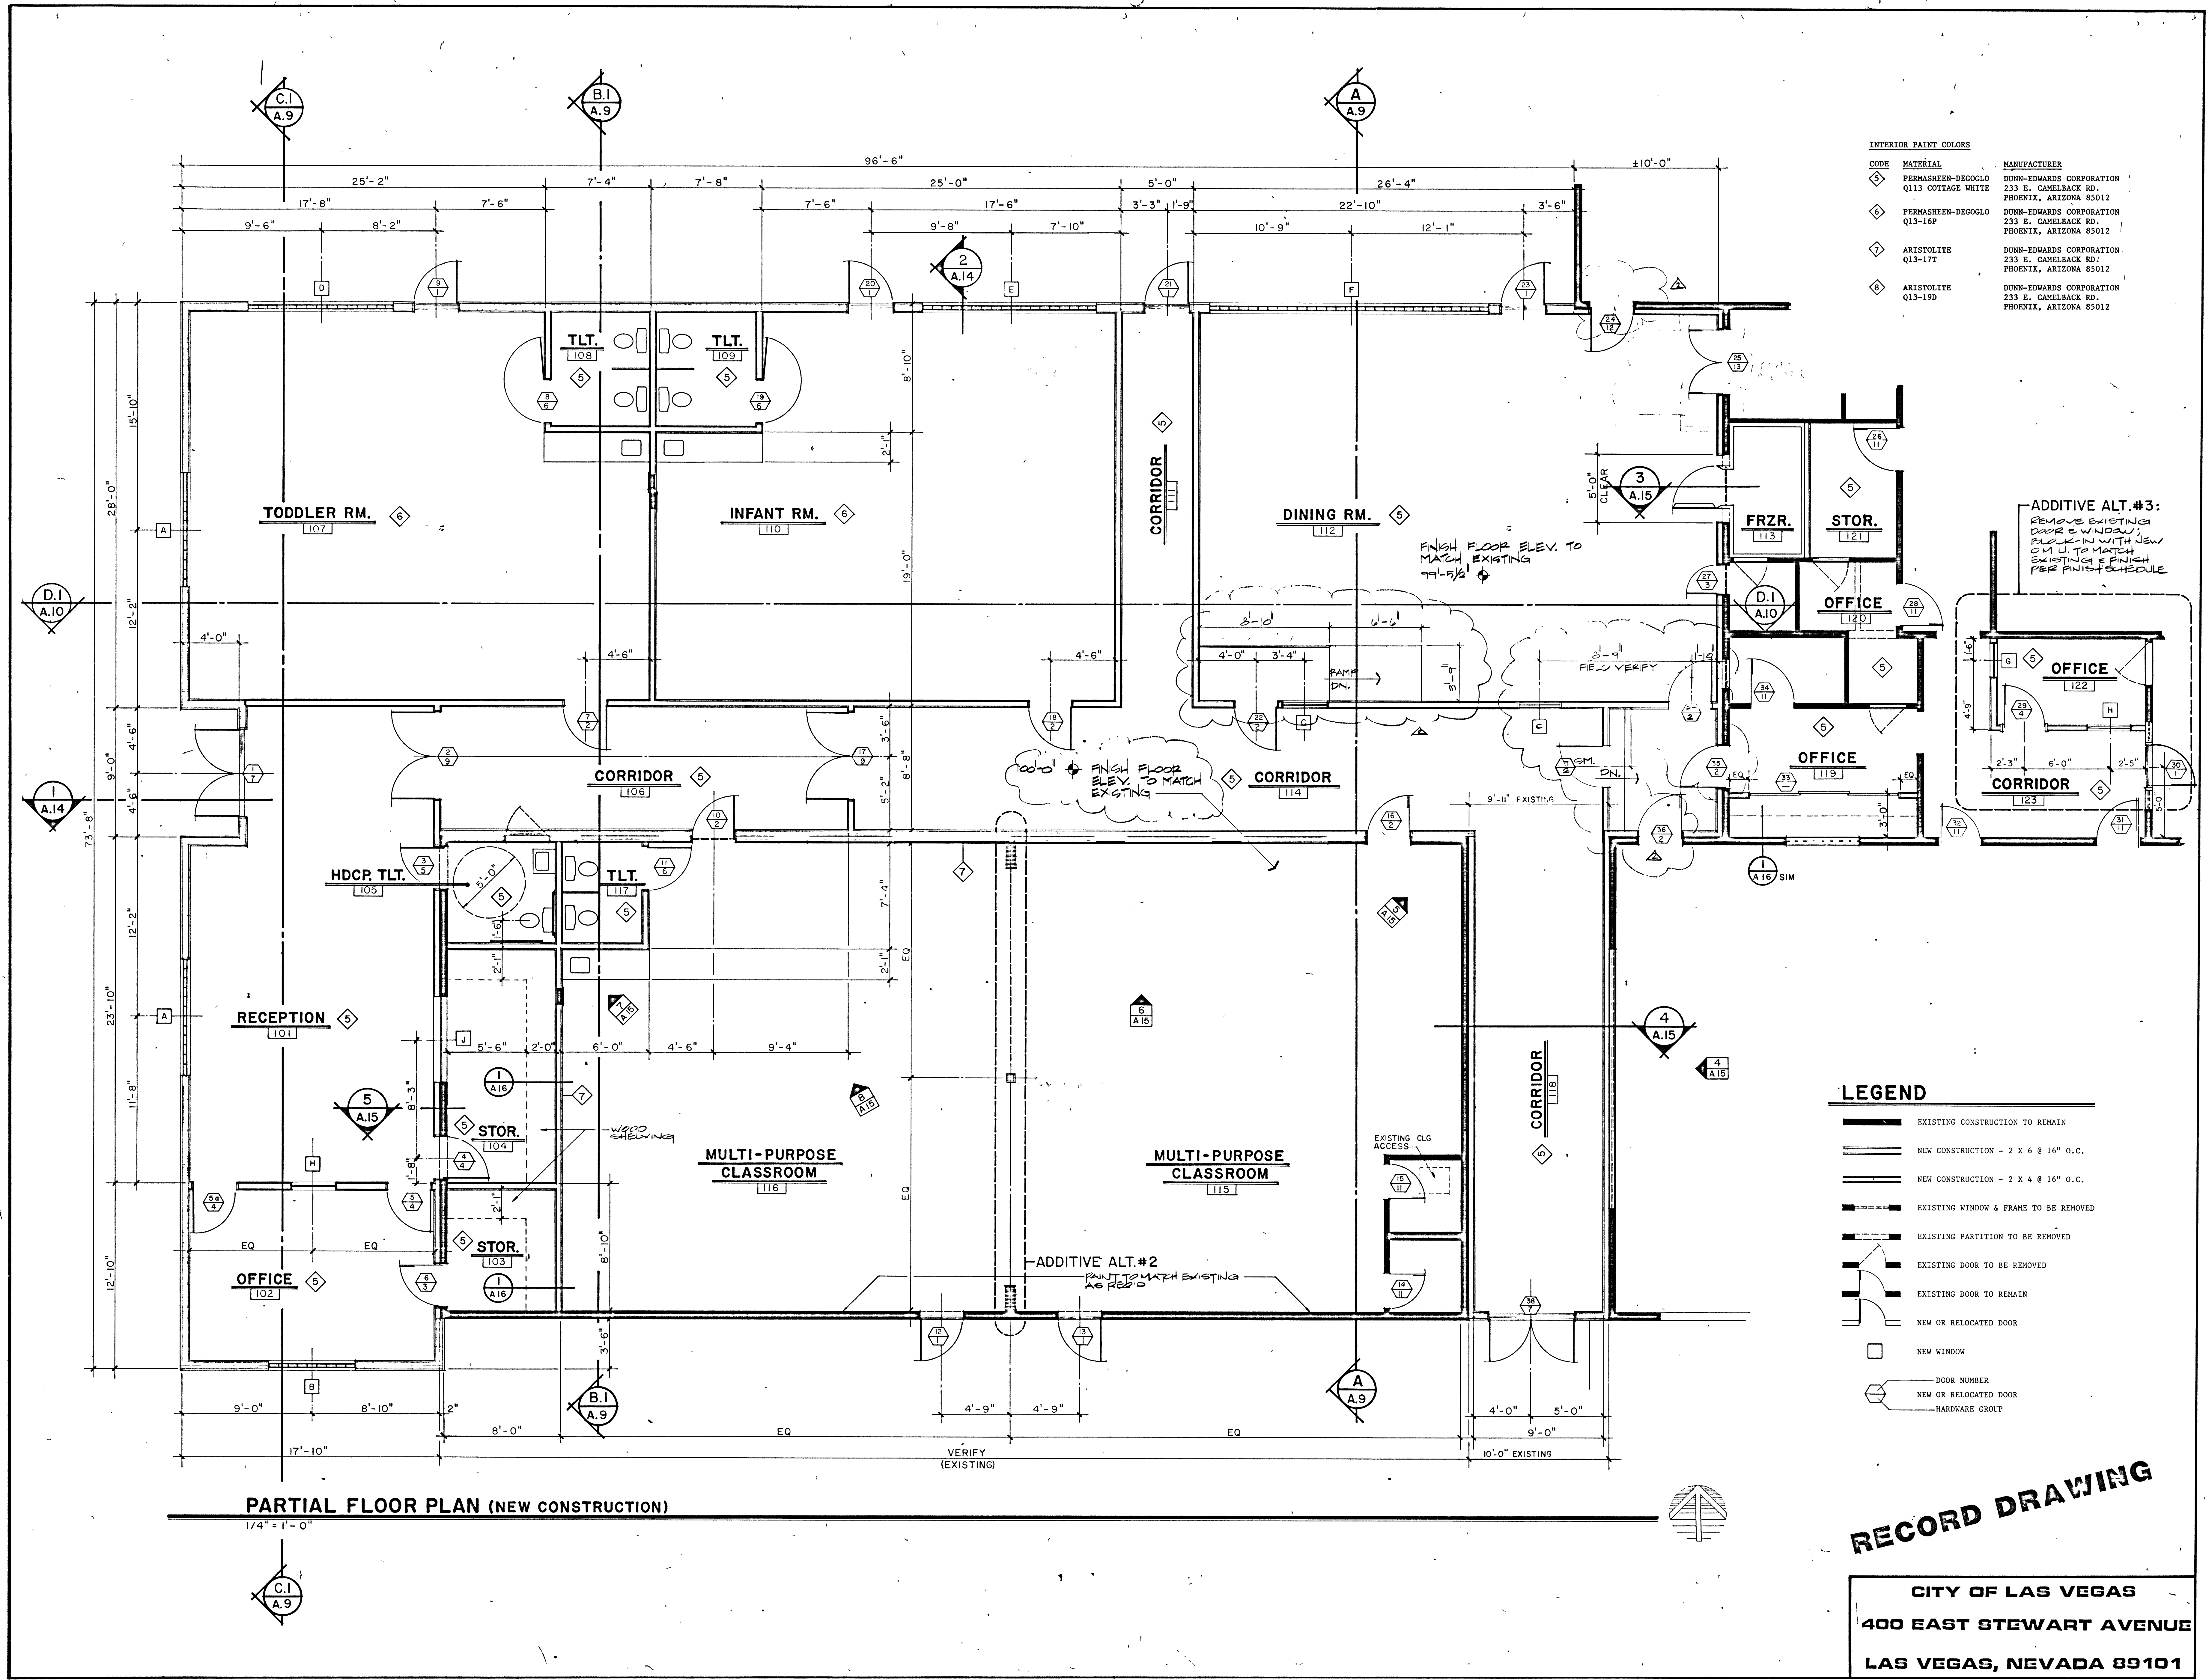

INTERIOR PAINT COLORS

| CODE | MATERIAL                              | MANUFACTURER                                                         |
|------|---------------------------------------|----------------------------------------------------------------------|
| 5    | PERMASHEEN-DEGOGLO Q113 COTTAGE WHITE | DUNN-EDWARDS CORPORATION 233 E. CAMELBACK RD. PHOENIX, ARIZONA 85012 |
| 6    | PERMASHEEN-DEGOGLO Q13-16P            | DUNN-EDWARDS CORPORATION 233 E. CAMELBACK RD. PHOENIX, ARIZONA 85012 |
| 7    | ARISTOLITE Q13-17T                    | DUNN-EDWARDS CORPORATION 233 E. CAMELBACK RD. PHOENIX, ARIZONA 85012 |
| 8    | ARISTOLITE Q13-19D                    | DUNN-EDWARDS CORPORATION 233 E. CAMELBACK RD. PHOENIX, ARIZONA 85012 |

LEGEND

|  |                                       |
|--|---------------------------------------|
|  | EXISTING CONSTRUCTION TO REMAIN       |
|  | NEW CONSTRUCTION - 2 X 6 @ 16" O.C.   |
|  | NEW CONSTRUCTION - 2 X 4 @ 16" O.C.   |
|  | EXISTING WINDOW & FRAME TO BE REMOVED |
|  | EXISTING PARTITION TO BE REMOVED      |
|  | EXISTING DOOR TO BE REMOVED           |
|  | EXISTING DOOR TO REMAIN               |
|  | NEW OR RELOCATED DOOR                 |
|  | NEW WINDOW                            |
|  | DOOR NUMBER                           |
|  | NEW OR RELOCATED DOOR                 |
|  | HARDWARE GROUP                        |

PARTIAL FLOOR PLAN (NEW CONSTRUCTION)

RECORD DRAWING

CITY OF LAS VEGAS  
400 EAST STEWART AVENUE  
LAS VEGAS, NEVADA 89101

ARCHITECT • GERALD CARAPICH & ASSOCIATES A.I.A.  
2330 FIFTH AVENUE, SUITE 201, SAN DIEGO, CA 92101 (619) 233-7256  
2300 PASEO DEL PRADO, C-102, LAS VEGAS, NV 89102 (702) 367-4465

PHASE I ( VARIETY CLUB )  
"D" STREET / JEFFERSON AVENUE  
NEIGHBORHOOD FACILITY PROJECT

FLOOR PLAN

drawn by: RB  
issue dates:  
11/3/88  
11/22/88 bidding  
revisions:  
2/1/89 2nd bidding  
A-0-07-27  
job no.: 8737

A.4  
12

As Built 671-25

