

1 1/2" STD. RUNNER CHANNEL of 4'-0" O.C.

9 GA. GALV. WIRE of 2'-0" O.C.

7/8" METAL "HAT" FURRING CHANNELS of 2'-0" O.C.


METAL FURRING CLIPS

5/8" TYPE "X" GYPSUM BOARD

12" x 12" x 3/4" ACOUSTICAL TILE

CEILING SUSPENSION DETAIL

NO SCALE

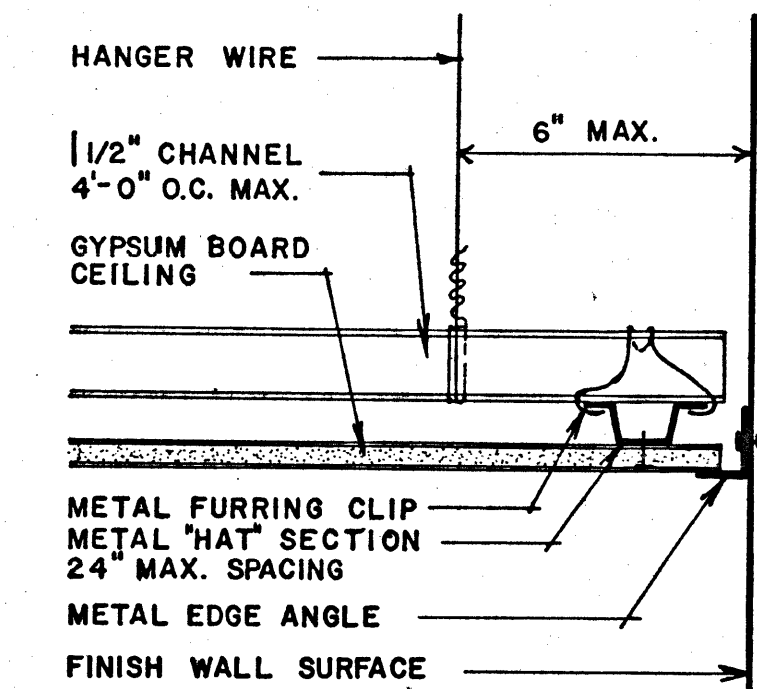

SUSPENDED GYP. BOARD
CEILING SCALE 3" = 1'-0"

	12" x 12" ACUSTICAL CEILING TILE OVER GYPSUM BOARD
	5/8" TYPE 'X' GYPSUM BOARD TAPE, BED and FINISH (FINISH - HEAVY ORANGE PEEL)
	SAME AS ABOVE - ON SUSPENSION SYSTEM
	EXTERIOR PLASTER SOFFIT
	MECHANICAL SUPPLY
	MECHANICAL RETURN
	EXHAUST FAN
	LIGHT FIXTURE
	CEILING ACCESS PANEL

CITY OF LAS VEGAS
400 EAST STEWART AVENUE
LAS VEGAS, NEVADA 89101

drawn by: dan l. neider
issue dates:
11/3/88
11/22/88 bidding
revisions:
2/1/89 2nd bidding
job no.: 8737LV

16

[illegible]

27-164

As Built $6.71 \div 2.5$

