

DRAWING SYMBOLS

	DETAIL NUMBER SHEET WHERE DRAWN	DETAIL
	SECTION NUMBER SHEET WHERE DRAWN	BUILDING SECTION
	SECTION NUMBER SHEET WHERE DRAWN	WALL SECTION
	DOOR NUMBER HARDWARE GROUP	DOOR SYMBOL
		WINDOW SYMBOL
	DETAIL NUMBER SHEET WHERE DRAWN	PHOTO DETAIL


ABBREVIATIONS

ACOUS.	ADJUSTABLE	ALUM.	APPROXIMATE	ARCH.	B.M.	B.W.	BD.	B/SIDES	BLDG.	BLK.	BM.	BOT.	C.	C.I.	C.J.	C.M.U.	C.O.T.G.	C.T.	CAB.	CIRC.	CLG.	CLR.	COL.	COMB.	COMP.	CONC.	CONN.	COORD.	CORR.	CSE.	CTR.	CU.FT.	D.F.	D.S.	DET.	DIA.	DIM.	DISP.	DO	DWG.	DR.	E.J.	E.W.	E.W.C.	E.A.	ELEV.	ELECT.	ENT.	EQ.	EQUIP.	ERECT.	ETC.
ACOUSTICAL	ADJUSTABLE	ALUMINUM	APPROXIMATE	ARCHITECTURAL	BENCH MARK	BOTH WAYS	BOARD	BOTH SIDES	BUILDING	BLOCK	BEAM	BOTTOM	CENTER LINE	CAST IRON	CONSTRUCTION JOINT	CONCRETE MASONRY UNIT	CLEAN OUT TO GRADE	CERAMIC TILE	CABINET	CIRCUIT	CEILING	CLEAR	COLLUM	COMBINATION	COMPRESSOR	CONCRETE	CONNECTION	COORDINATE	CORRUGATED	COUNTERSINK	COUNTER	CUBIC FEET	DRINKING FOUNTAIN	DOWN SPOUT	DETAIL	DIAMETER	DIMENSION	DISPENSER	DITTO	DRAWING	DOOR	EXPANSION JOINT	EACH WAY	ELECTRIC WATER COOLER	EACH	ELEVATION	ELECTRICAL	ENTRANCE	EQUAL	EQUIPMENT	ERECTION	ET CETERA
EXH.	EXIST.	EXP.	EXT.	F.D.	F.E.C.	F.B.	F.L.	FDM.	FLR.	FIN.	FT.	FTG.	G.I.	G.W.B.	GA.	GALV.	GL.	GTP.BD.	H.B.	H.M.	HD.BD.	HD.WD.	HOR.	HT.	INV.EL.	IN.	INSUL.	INT.	INV.	JST.	JT.	LAM.	LB.	LOC.	M.O.	MAS.	MAT'L	MAX.	MECH.	MET.	MEZZ.	MIN.	MISC.	N.I.C.	N.T.S.	NO.	O.C.	OPNG.	OPP.			
EXHAUST	EXISTING	EXPANSION	EXTERIOR	FLOOR DRAIN	FIRE EXTINGUISHER CABINET	FIRE HYDRANT	FLOW LINE	FOUNDATION	FLOOR	FINISH	FEET	FOOTING	GALVANIZED IRON	GYPHUM WALL BOARD	GAGE	GALVANIZED	GLASS	GYPHUM BOARD	HOSE BIB	HOLLOW METAL	HARD BOARD	HARD WOOD	HARDWARE	HORIZONTAL	HEIGHT	INVERT ELEVATION	INCH	INSULATION	INTERIOR	INVERT	JOIST	JOINT	LAMINATED	POUND	LOCATIONS	MASONRY OPENING	MASONRY	MATERIAL	MAXIMUM	MECHANICAL	METAL	MEZZANINE	MINIMUM	MISCELLANEOUS	NOT IN CONTRACT	NOT TO SCALE	NUMBER	ON CENTER	OPENING	OPPOSITE		
R.	PERIM.	P.V.C.	PARTIAL	PL.	PL.LAM.	PLYWOOD	PRE-FAB.	Q.T.	R.	R.D.	R.H.	R.S.	REF.	REINF.	REQ'D	RET.	REV.	R.M.	RND.	S.D.	SERV.	SCH.	SECT.	SHT.	SIM.	SPECS.	SQ.	ST/ST	STD.	ST'L.	STOK.	STRUCT.	SUSP.	SYM.	T.&B.	T.C.	T.G.	T.O.M.	T.S.	TEMP.	TR.	THRU.	TYP.	V.	V.C.T.	V.B.	VENT.	VERT.	W/	W.C.	WD.	W.W.F.
PLATE	PERIMETER	POLYVINYL CHLORIDE	PARTIAL	PLASTER	PLASTIC LAMINATE	PLYWOOD	PRE-FABRICATED	QUARRY TILE	RADIUS	ROOF DRAIN	ROUND HEAD	ROUGH SAWN	REFERENCE	REINFORCED	REQUIRED	RETAINING	REVISIONS	ROOM	REDWOOD	STORM DRAIN	SERVICE	SCHEDULE	SECTION	SHEET	SIMILAR	SPECIFICATIONS	SQUARE	STAINLESS STEEL	STANDARD	STEEL	STORAGE	STRUCTURAL	SUSPENDED	SYMMETRICAL	TOP AND BOTTOM	TOP OF CURB	TOP OF GRATING	TOP OF MANHOLE	TOP OF STEEL	TEMPERATURE	TRACK	THROUGH	TYPICAL	VOLT	VINYL COMPOSITION TILE	VINYL BASE	VENTILATION	VERTICAL	WITH	WATER CLOSET	WOOD	WELDED WIRE FABRIC

CODE ANALYSIS

OCCUPANCY GROUP	E-3
CONSTRUCTION TYPE (EXISTING)	VN
CONSTRUCTION TYPE (NEW ADDITION)	VN
ALLOWABLE FLOOR AREA BY CODE	9,100 SQ. FT.
EXISTING BUILDING #1	± 4,356 SQ. FT.
EXISTING BUILDING #2	± 2,550 SQ. FT.
APPROXIMATE SQUARE FOOTAGE OF EXISTING - TOTAL	6,906
NEW ADDITION - BASE BID	3,872 SQ. FT.
TOTAL	10,778 SQ. FT.
NEW ADDITION - ADDITIVE ALTERNATE #1	834 SQ. FT.
GRAND TOTAL	11,612 SQ. FT.
ALLOWABLE AREA INCREASE	UNIFORM BUILDING CODE SECTION 506 (2)
SEPARATION ON THREE SIDES 80% OF ALLOWABLE	7,280 SQ. FT.
TOTAL SQUARE FOOTAGE ALLOWED BY CODE	16,380
FIRE ALARM SYSTEM PROVIDED WITH DETECTION SYSTEM	
UNIFORM BUILDING CODE	1985 EDITION
UNIFORM PLUMBING CODE	1985 EDITION
UNIFORM ELECTRICAL CODE	1987 EDITION
ZONING REGULATION	CITY OF LAS VEGAS DATED MARCH 1, 1988

VICINITY MAP

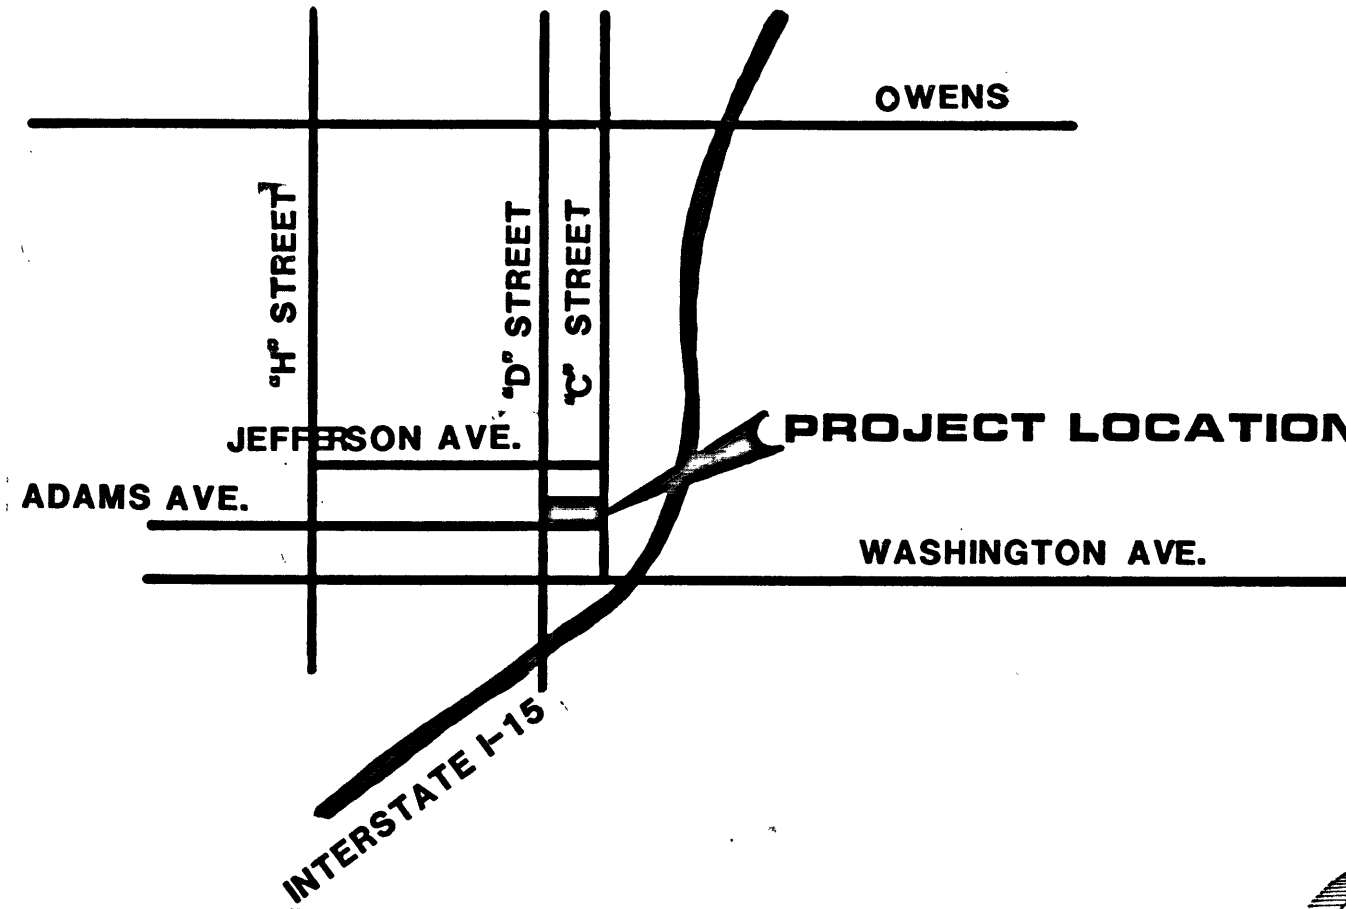

DRAWING INDEX

	SHEET NO.	CONCS. NO.
COVER SHEET		
GENERAL NOTES	GN.1	1
GENERAL NOTES	GN.2	2
CIVIL		
EXISTING SITE PLAN	C.1	3
GRADING PLAN	C.2	4
LANDSCAPING PLAN		
PLANTING PLAN	L.1	5
IRRIGATION PLAN	L.2	6
PLANTING PLAN - ADDITIVE ALTERNATE #1	L.3	7
IRRIGATION PLAN - ADDITIVE ALTERNATE #1	L.4	8
ARCHITECTURAL/STRUCTURAL		
DEMOLITION PLAN	A.1	9
SITE PLAN	A.2	10
OVERALL FLOOR PLAN	A.3	11
FLOOR PLAN	A.4	12
DOOR SCHEDULE, ROOM FINISH	A.5	13
SCHEDULES, PAINT FINISHES	A.6	14
EXTERIOR ELEVATIONS	A.7	15
EXTERIOR ELEVATION	A.8	16
REFLECTED CEILING PLAN	A.9	17
BUILDING SECTIONS	A.10	18
BUILDING SECTION	A.11	19
FOUNDATION PLAN	A.12	20
ROOF FRAMING PLAN	A.13	21
ROOF PLAN AND DETAILS	A.14	22
WALL SECTIONS AND PHOTO DETAILS	A.15	23
INTERIOR ELEVATIONS, DOOR FRAME ELEVATIONS, WINDOW ELEVATIONS, DOOR ELEVATIONS, GLAZING SCHEDULE, DOOR TYPE SCHEDULE	A.16	24
WINDOW / DOOR DETAILS	A.17	25
MECHANICAL/PLUMBING		
SCHEDULES AND LEGEND	M.1	26
PLUMBING FLOOR PLAN	M.2	27
HVAC FLOOR PLAN, DETAILS AND CALCULATIONS	M.3	28
ELECTRICAL		
SCHEDULES, DETAILS AND DIAGRAMS	E.1	29
ELECTRICAL SITE PLAN	E.2	30
LIGHTING PLAN	E.3	31
POWER AND AUXILIARY PLAN	E.4	32

RECORD DRAWING

CITY OF LAS VEGAS
400 EAST STEWART AVENUE
LAS VEGAS, NEVADA 89101

ARCHITECT • GERALD CARADICH & ASSOCIATES A.I.A.

PHASE I (VARIETY CLUB)
"D" STREET / JEFFERSON AVENUE
NEIGHBORHOOD FACILITY PROJECT

GENERAL NOTES


drawn by: dan L nelder
issue dates:
11/3/88
11/22/88 bidding

revisions:
2/1/89 2nd bidding

job no.: 8737 LV

GN. 1

1

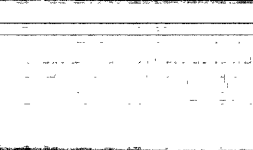

[illegible]