
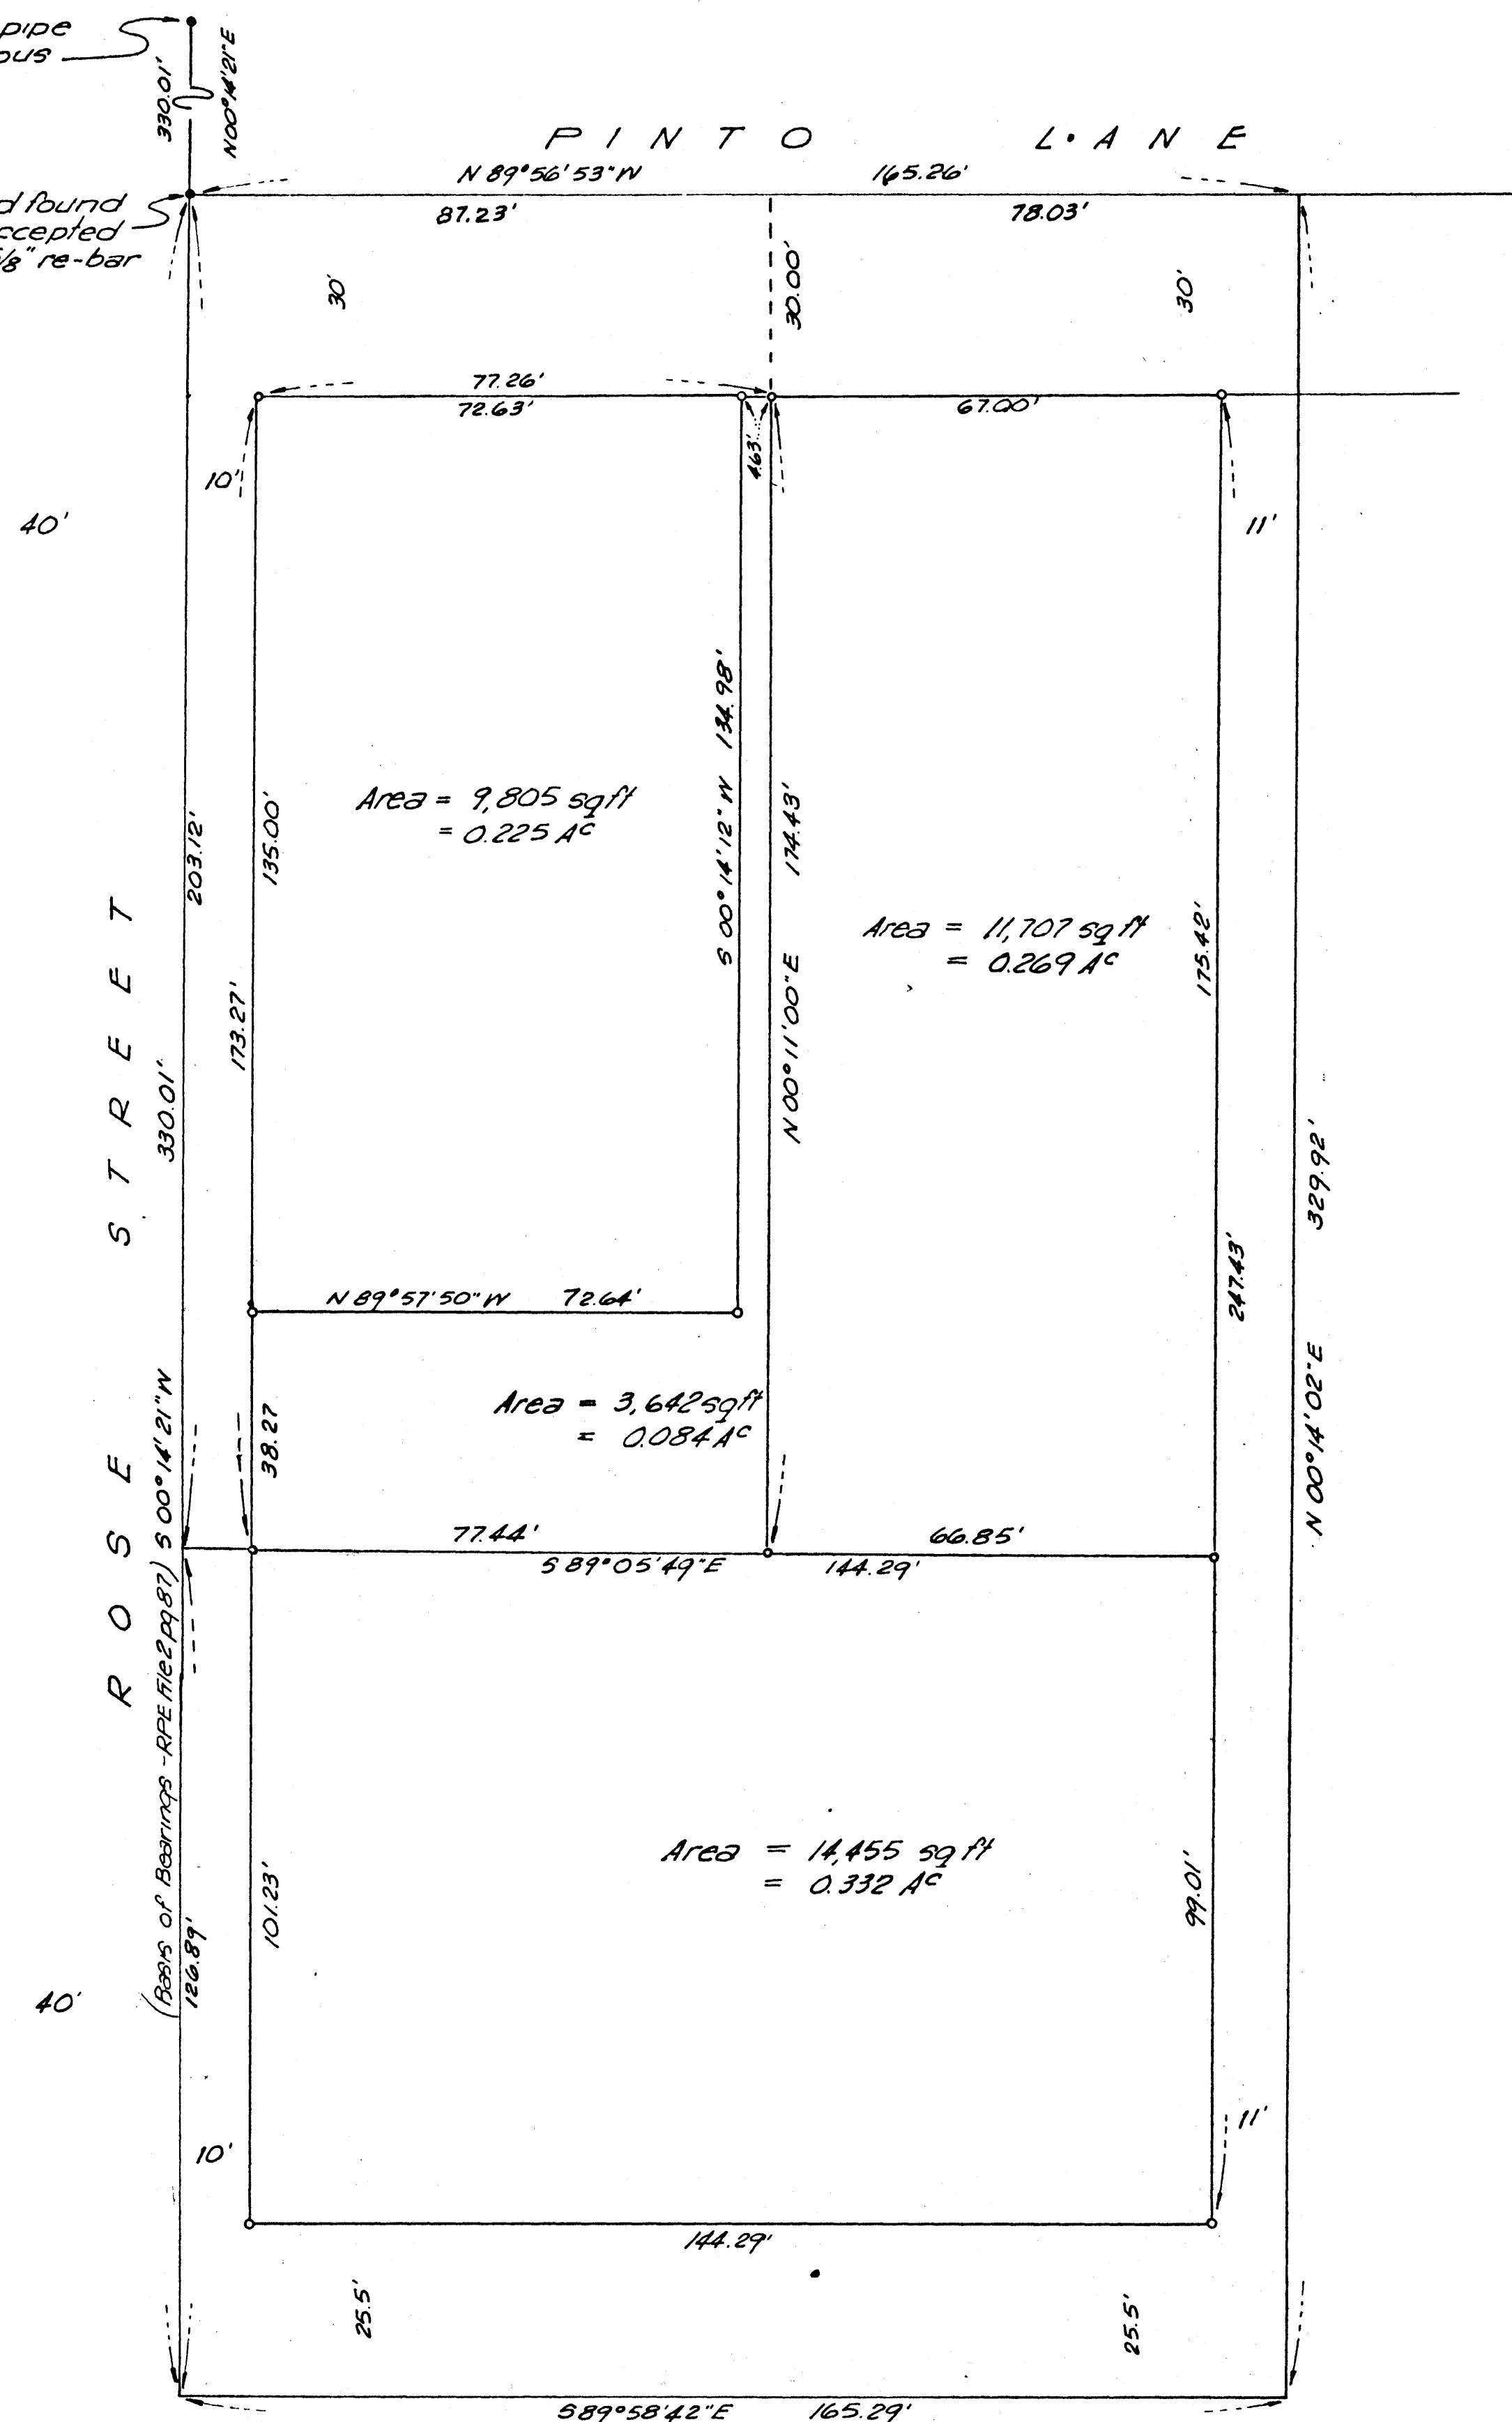


Found 1" iron pipe
used on previous
survey

Found RR spike and found
nail, checked and accepted
nail, replaced with 3/8" re-bar

576652

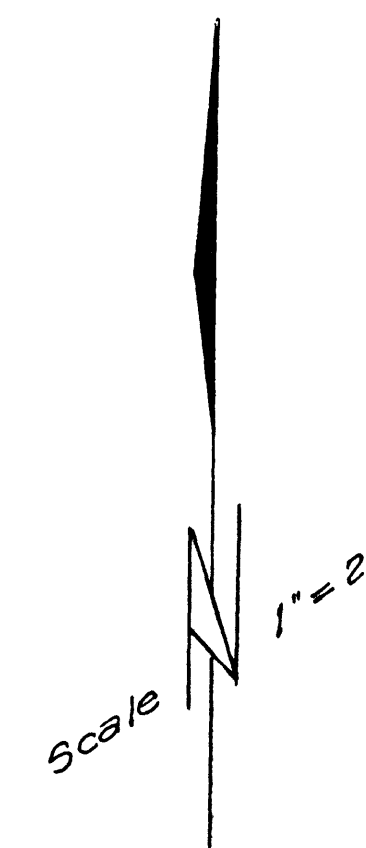

CERTIFICATE

I, Jack K. Leavitt, Registered Professional Engineer and Land Surveyor do hereby certify that this map is a true and accurate representation of the lands shown hereon. All points found or set are correctly designated. This survey was completed on May 16, 1966, at the instance of Jonathan Lodwick, and does not constitute a subdivision as defined by Nevada State Law.

Jack K. Leavitt
JACK K. LEAVITT
Registered Professional Engineer
Land Surveyor RLS 807



LEGEND
• Indicates point found - as shown
○ Indicates point set, 1/2" iron pipe
tagged RLS 807 unless otherwise designated

Basis of Bearings: The West line SE 1/4 NW 1/4 SW 1/4 Section 33 as per RPE File 2 page 87

Scale 1" = 20'

576652

NO. FILED AT THE REQUEST OF
LEAVITT & HOLLER
Date 5-19-66 at 2:05 PM
File 16 PAGE 76
of SURVEYS
OFFICIAL RECORDS BOOK No 717
CLARK COUNTY, NEVADA RECORDS
PAUL E. HORN, RECORDER
Fee \$ 2.50 E.M. Deputy

RECORD OF SURVEY
The W 1/2 NW 1/4 SE 1/4 NW 1/4 SW 1/4 Sec. 33
Township 20 South, Range 61 East, M.D.M.
Clark County, Nevada
Surveyed by:
LEAVITT & HOLLER
SURVEYORS LIMITED
Scale 1" = 20' Las Vegas, Nev.