



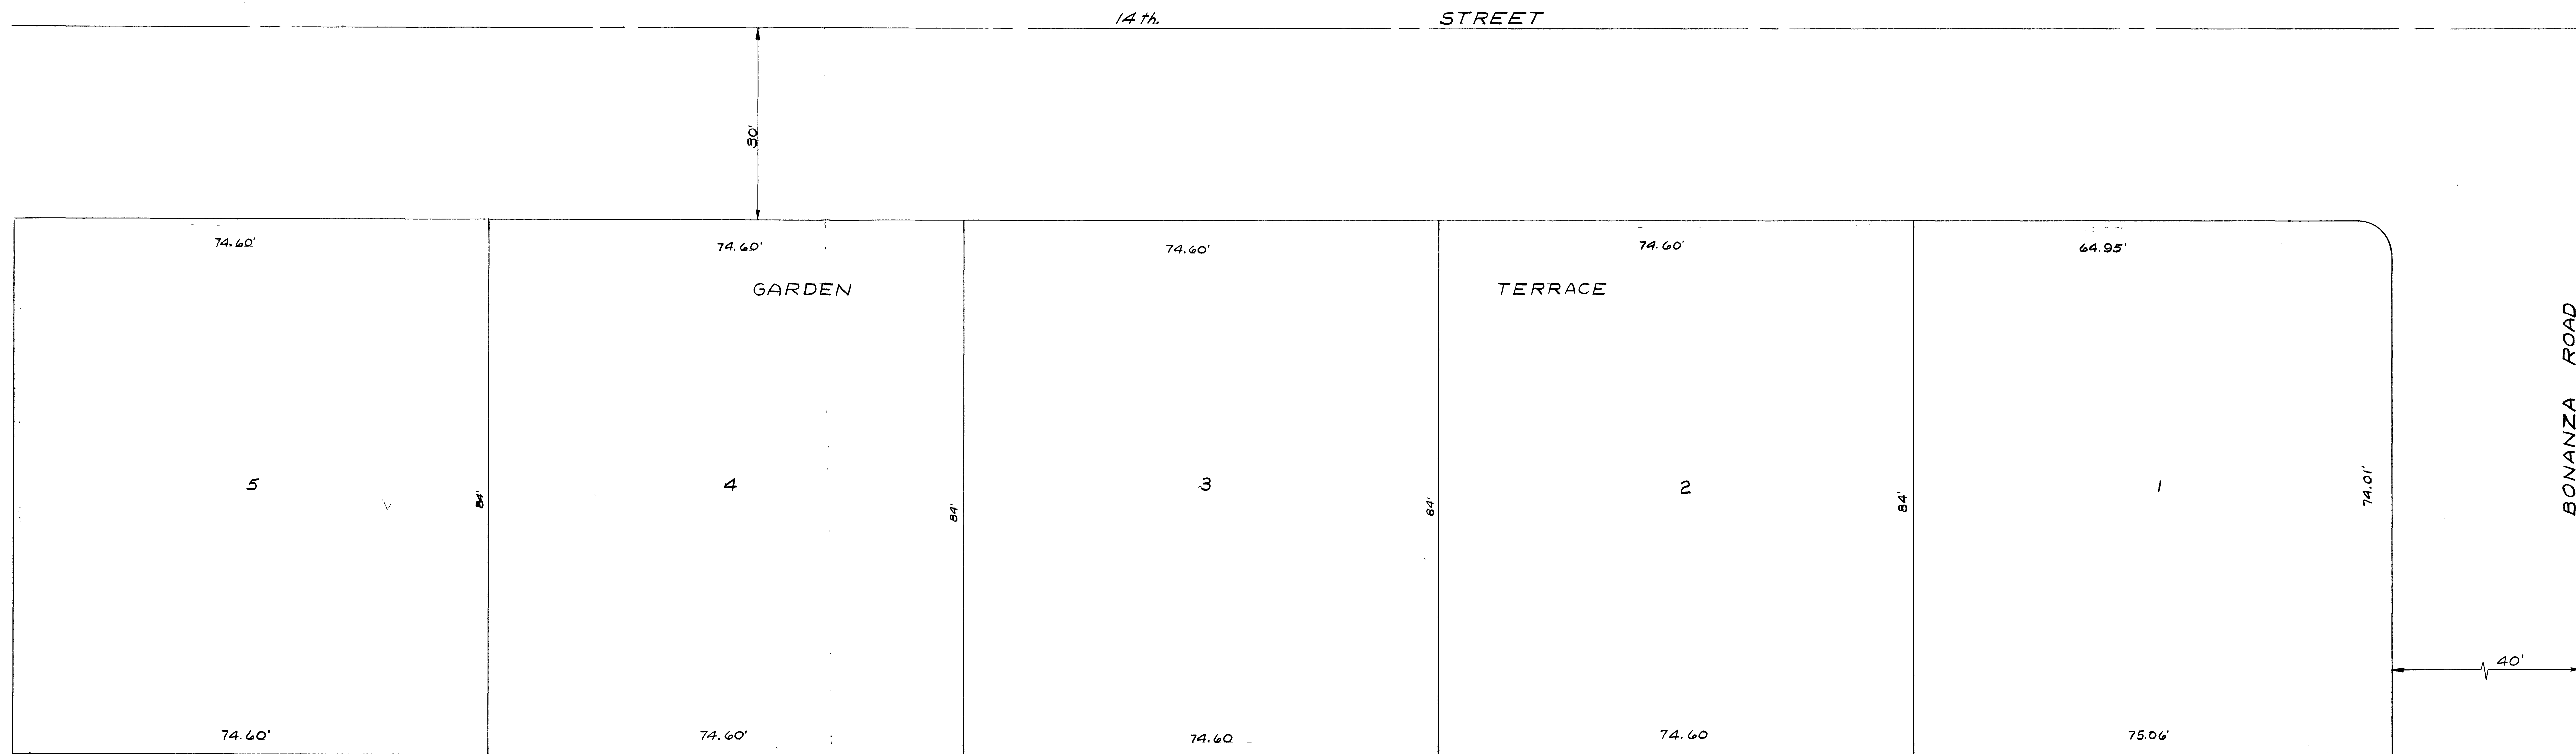

LOCATION MAP
SCALE 1" = 10'

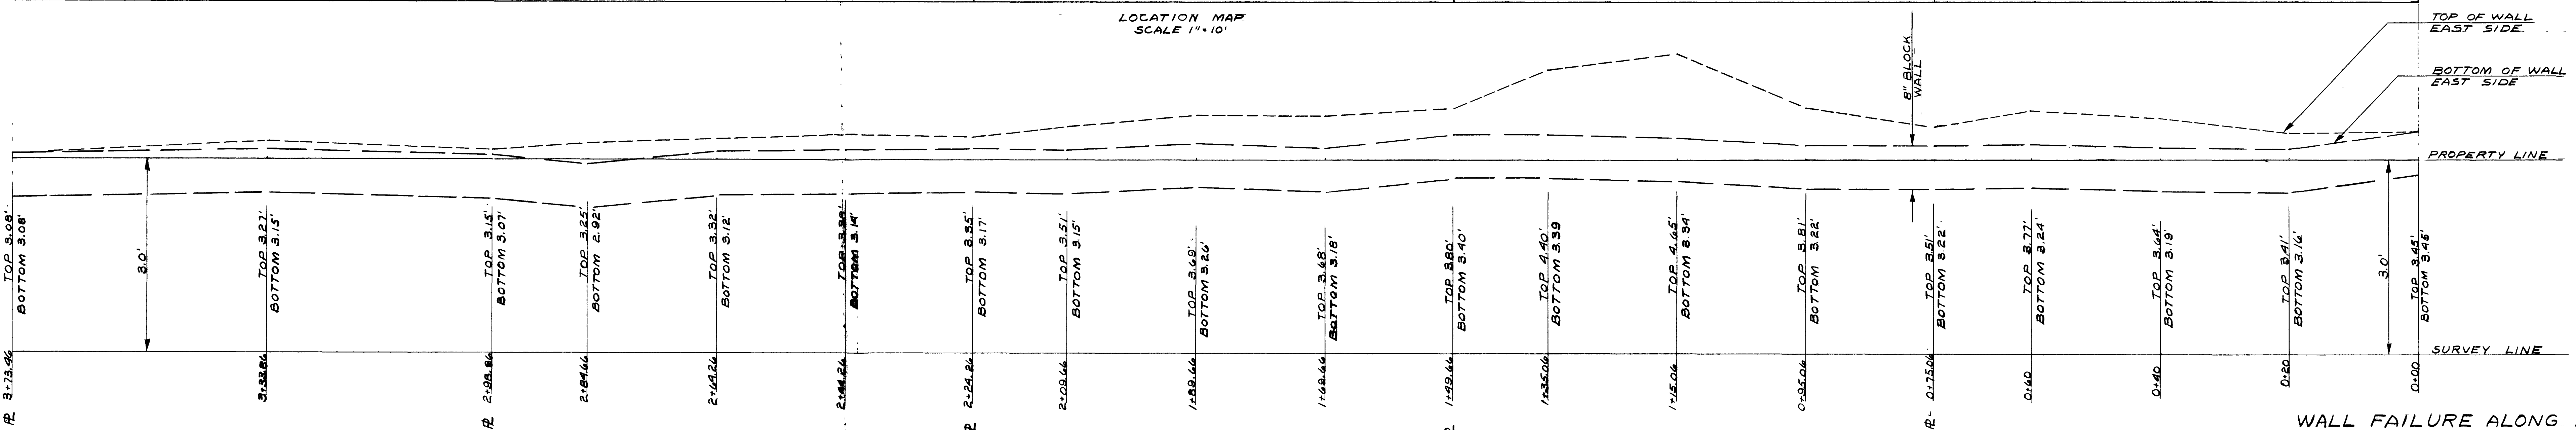


PLAN VIEW
SCALE 1" = 10' N.E.S.
1" = 1' E.E.W.

WALL FAILURE ALONG LOT
LINE - GARDEN TERRACE
UNIT NO. 1
DATE: 8-23-63 DRAWN BY: D. NELSON


34-70 107 R-809
JUL 5 1963



MAIN STREET

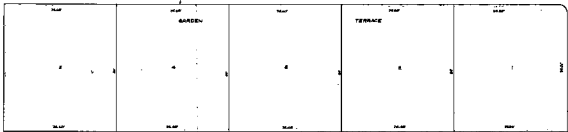

CONCRETE AND
PAVED DRIVE

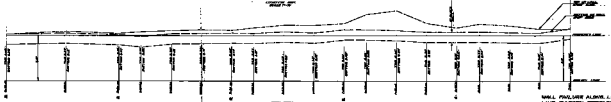

SECTION 1-1

SMALL PAVEMENT ALONG LOT
LINE - BARNES TERRACE
UNIT 100
SECTION 1-1