



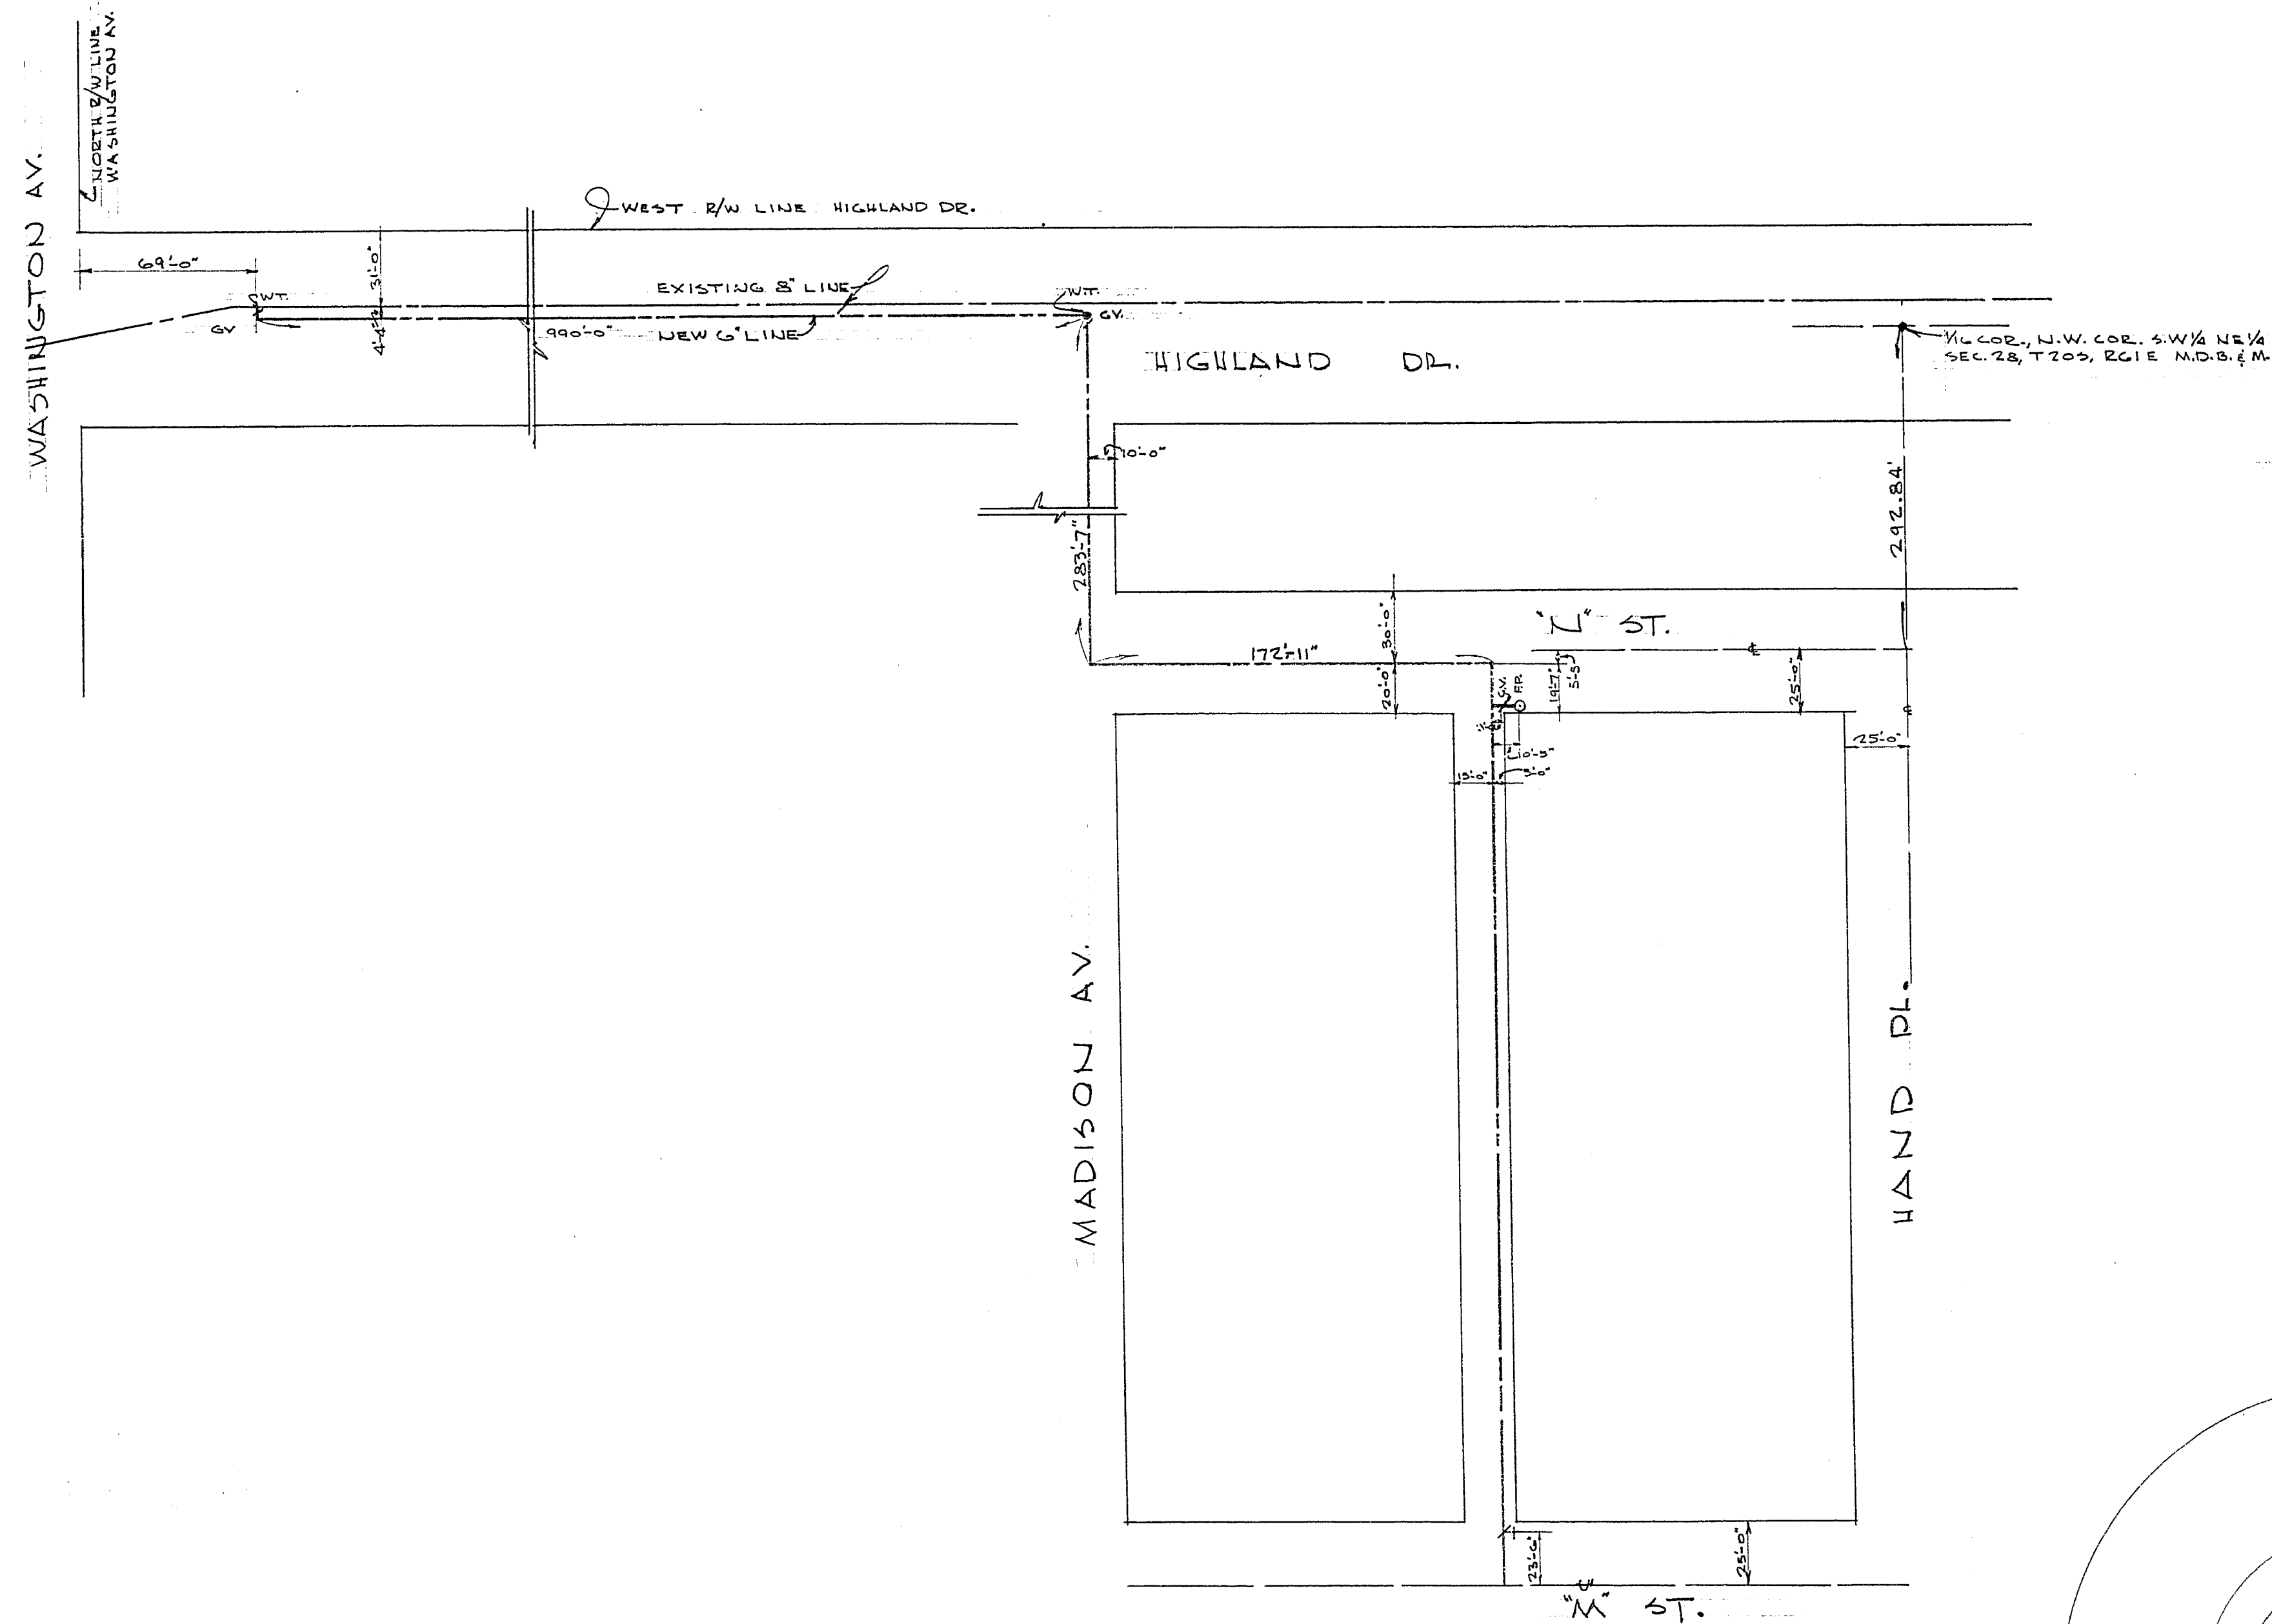

PLAN OF WATER & SEWER LINES AT THE INTERSECTION OF N ST. AND THE ALLEY BETWEEN MADISON AV. & HAND PL.
SCALE = 1" = 10'-0"

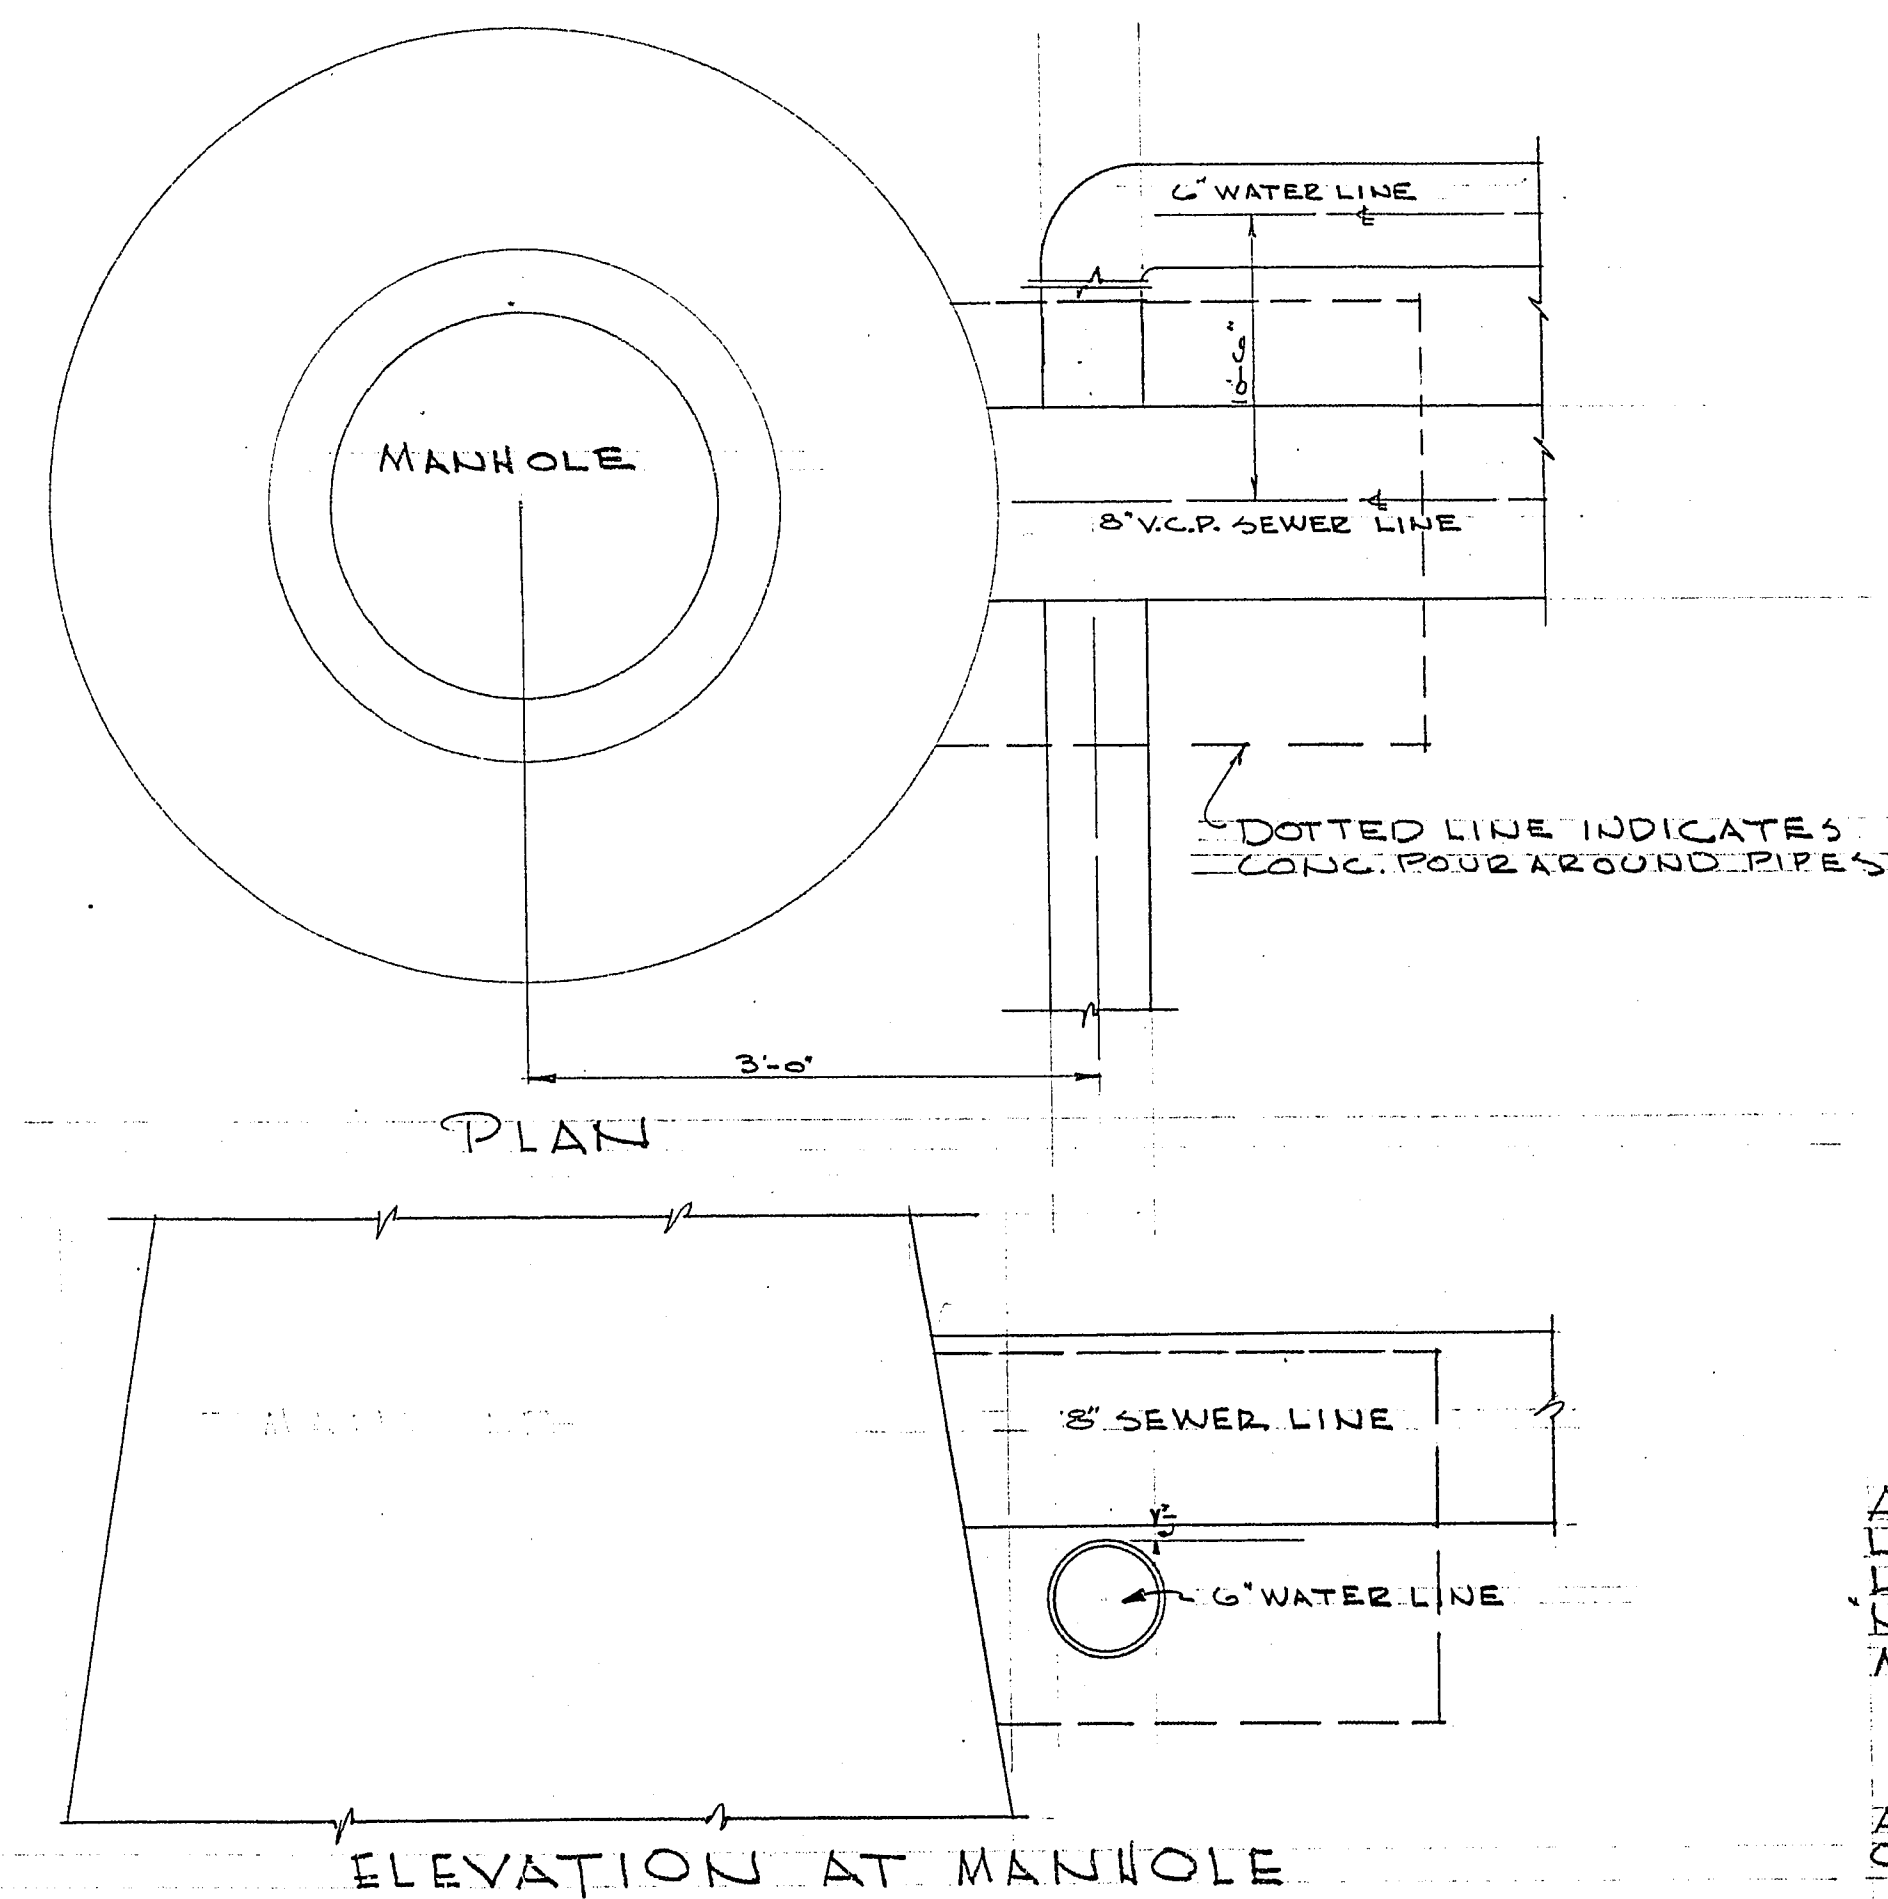

APPROVED:
FIRE CHIEF *[Signature]*

CITY OF LAS VEGAS
ENGINEERING DEPT.

Approval of this plan by the City of Las Vegas, Nevada, does not relieve the ^{Contractor} ~~subdivider~~ of responsibility for errors in calculation, design, or planning by the ^{Contractors} ~~subdividers~~ Engineer or Surveyor.

APPROVED AS TO DESIGN ONLY
Contractor will be responsible for all details, dimensions and conformity to the design drawings.

Date 3-28-57
By: *[Signature]*

City of Las Vegas, Nevada
Office of the City Engineer
Approved By: *[Signature]*
Date: 4/1/57

AS BUILT PLAN OF WATER LINE & PLAN OF WATER & SEWER LINE AT THE INTERSECTION OF N ST. & THE ALLEY BETWEEN MADISON AV. & HAND PL.

A PORTION OF THE SW 1/4 OF THE NE 1/4 OF SECTION 28, T20S, R21E, M.D.B. & M.