


WELFARE SERVICES FACILITY AT NUCLEUS PLAZA



CITY OF LAS VEGAS
for STATE OF NEVADA
DEPARTMENT OF HUMAN RESOURCES

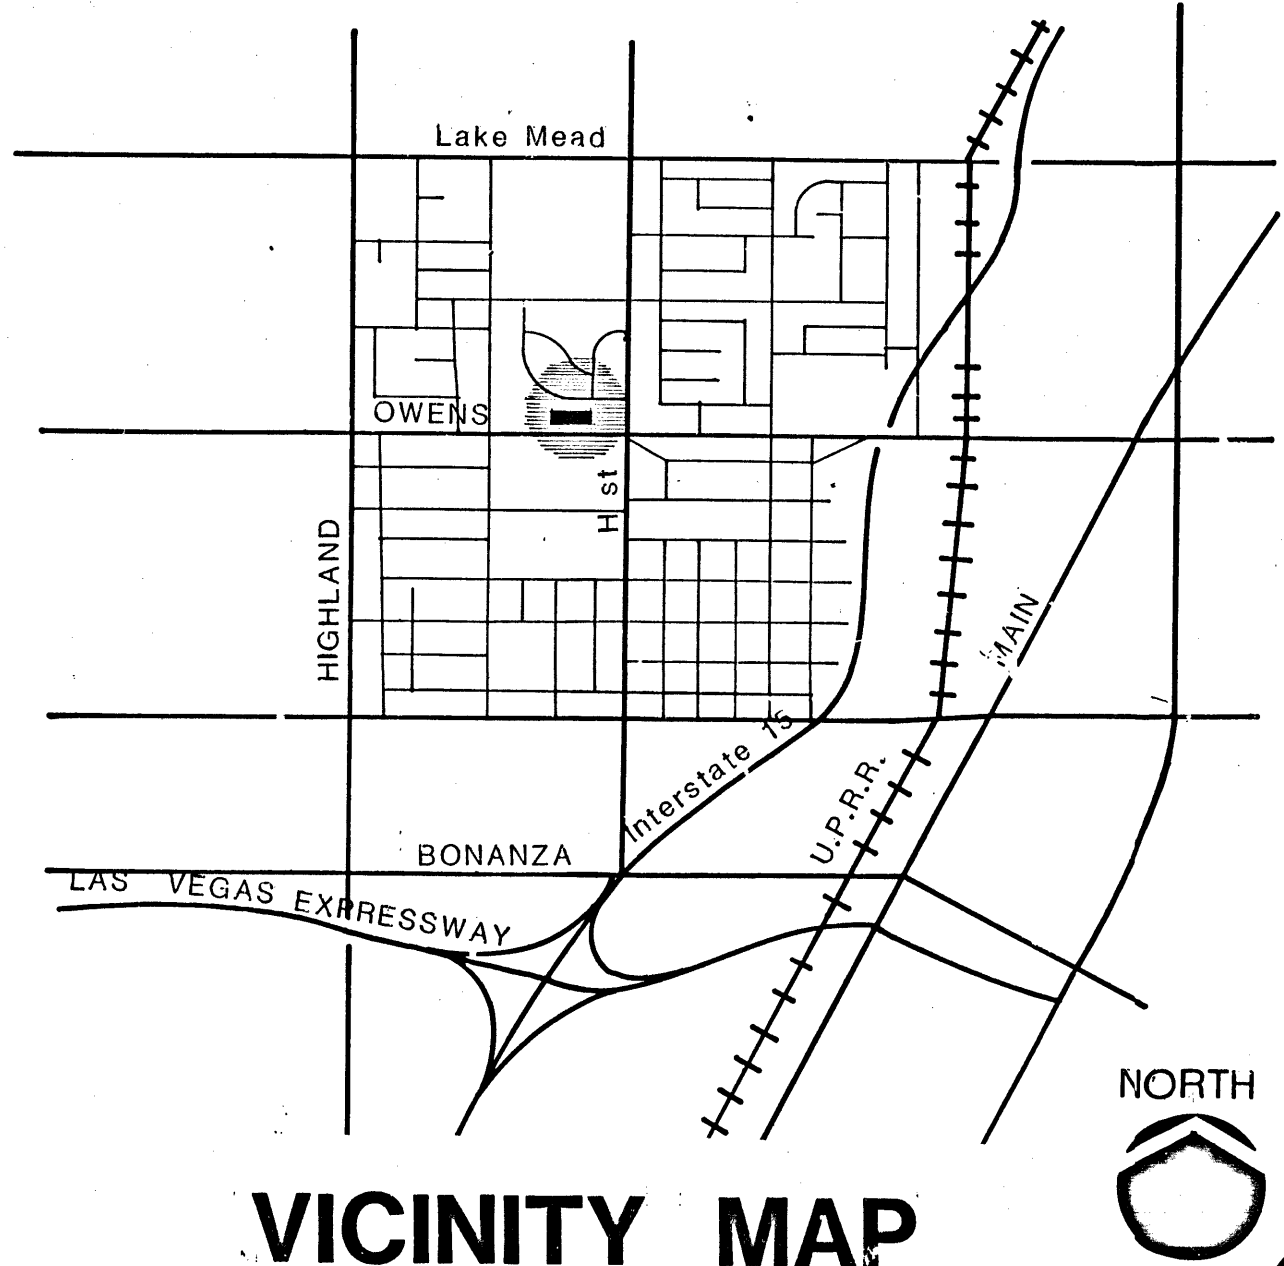

VICINITY MAP


INDEX OF DRAWINGS

ARCHITECTURAL	
A1.1	SITE PLAN
A1.2	DEMOLITION PLAN
A2.1	FLOOR PLAN
A2.2	ENLARGED PLANS FLOOR FINISH PLANS
A2.3	CASEWORK
A3.1	REFLECTED CEILING PLAN
A5.1	ELEVATIONS AND SECTIONS
A7.1	DETAILS
A7.2	PLAYROOM AND MISC. DETAILS
A8.1	SCHEDULES
MECHANICAL	
M-1	MECH. LEGEND, SCHEDULES, DETAILS & PART PLANS
M-2	PLUMBING FLOOR PLAN
M-3	AIR CONDITIONING FLOOR PLAN
ELECTRICAL	
E1.0	SYMBOL LIST, GENERAL NOTES
ED1.1	ELECTRICAL DEMOLITION
E1.1	LIGHTING
E1.2	POWER, AUXILIARY SYSTEMS
E1.3	SINGLE LINE DIAGRM, FEEDER SCHEDULE AND PANELS

BASIS OF DESIGN

1988 UNIFORM BUILDING CODE	
OCCUPANCY CLASSIFICATION:	B-2
CONSTRUCTION TYPE:	V-1
FIRE PROTECTION: (ATTIC & INTERIOR AREA)	FULLY SPRINKLERED
GROSS SQUARE FOOTAGE:	
COMPARTMENT ONE:	6,720 s.f.
COMPARTMENT TWO:	20,500 s.f.
TOTAL:	27,220 s.f.

CONTRACT DOCUMENTS

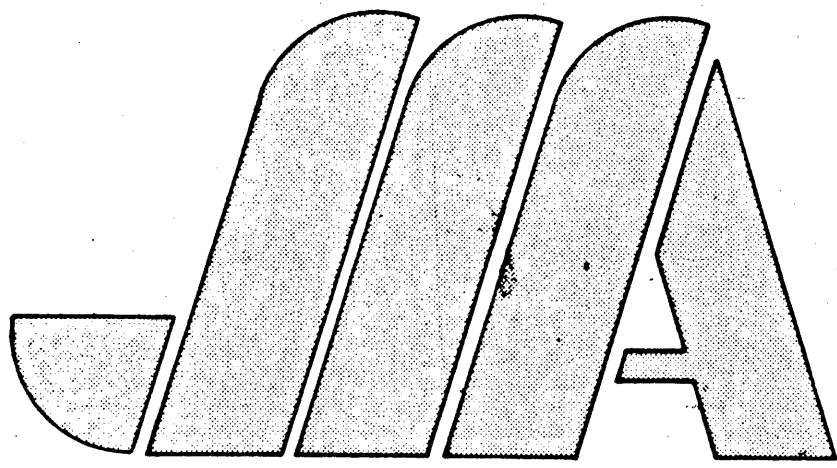

ARCHITECTURE
LANDSCAPE ARCHITECTURE
INTERIOR DESIGN

JMA ARCHITECTS & ENGINEERS, INC.
4292 S. MARYLAND PARKWAY
LAS VEGAS, NEVADA 89119-7530
(702) 731-2033

MECH/ELECT

JBA CONSULTING ENGINEERS
5040 WEST EDNA
LAS VEGAS, NEVADA 89102

STRUCTURAL


MARTIN, PELTYN & ASSOCIATES
1001 RANCHO DRIVE SOUTH
LAS VEGAS, NEVADA 89102

APPROVALS

_____	DATE
_____	DATE
_____	DATE

DUED No. 90.6375
CDBG Funded Project

City Officials
Ron L. Lurie, Mayor
Steve Miller, Ward 1 Councilman
Arnie Adamsen, Ward 2 Councilman
Bob Nolan, Ward 3 Councilman
Scott Higginson, Ward 4 Councilman
Ashley Hall, City Manager

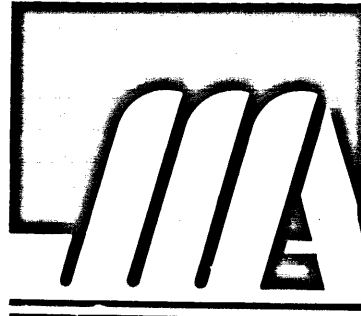

JMA ARCHITECTS & ENGINEERS, INC.
Architecture and Engineering
Research and Planning
Interior and Graphic Design

4292 S. Maryland Parkway
Las Vegas, Nevada 89119-7530
(702) 731-2033

As Built 513-57A-1.6