




1 NORTH ELEVATION
A5.1 1/4" = 1'-0"

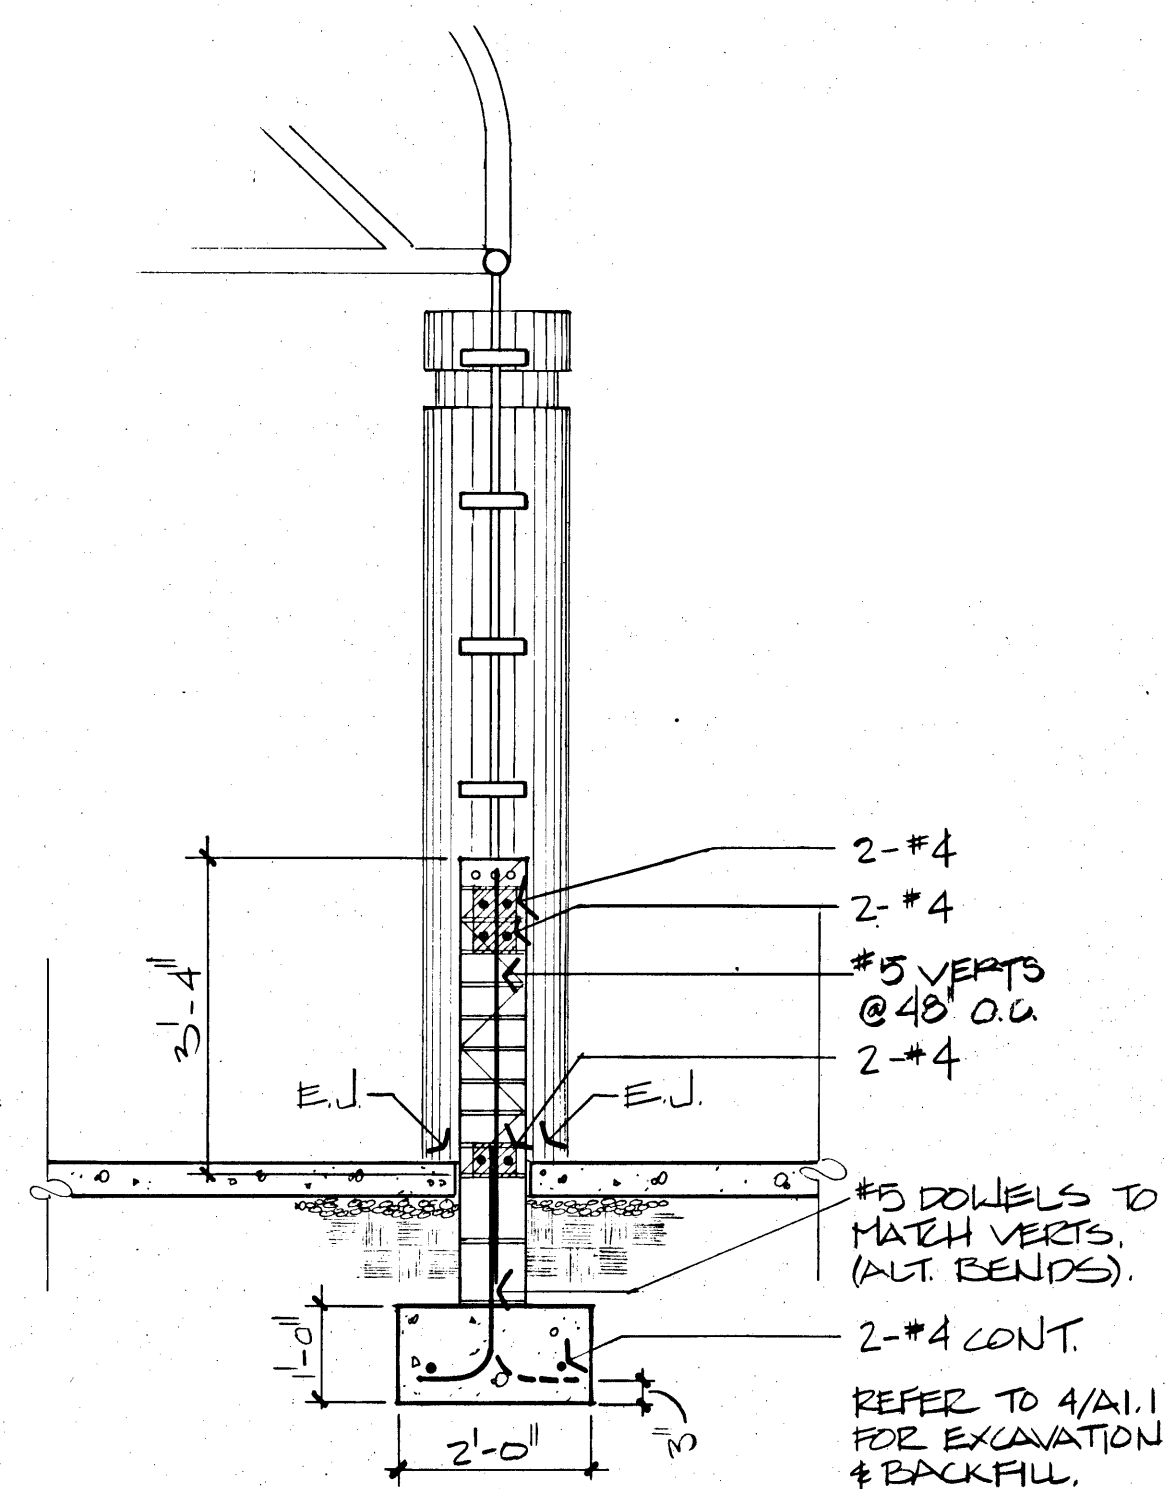


2 SECTION @ MTL GRILLE
A5.1 1/2" = 1'-0" ALTERNATE 1

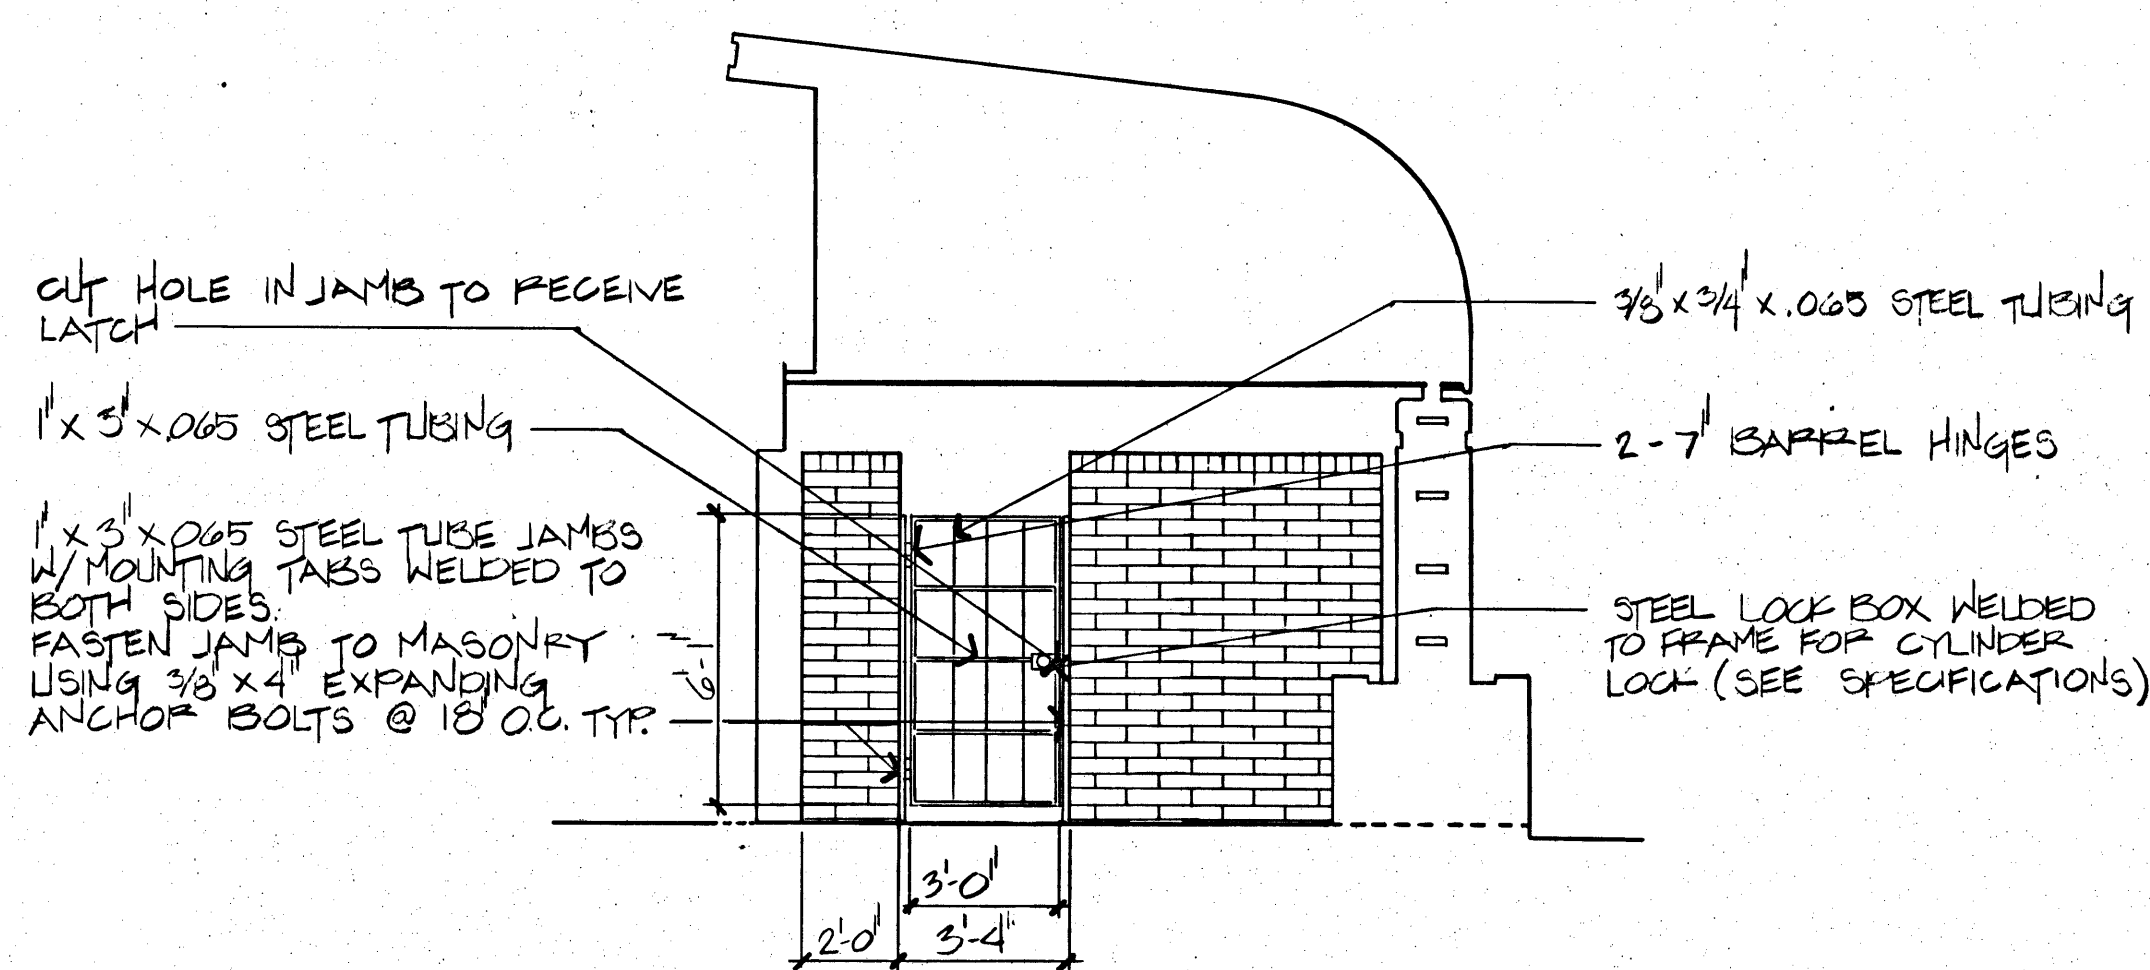


3 ELEVATION @ WALL W/ GATE
A5.1 1/4" = 1'-0" ALTERNATE 1

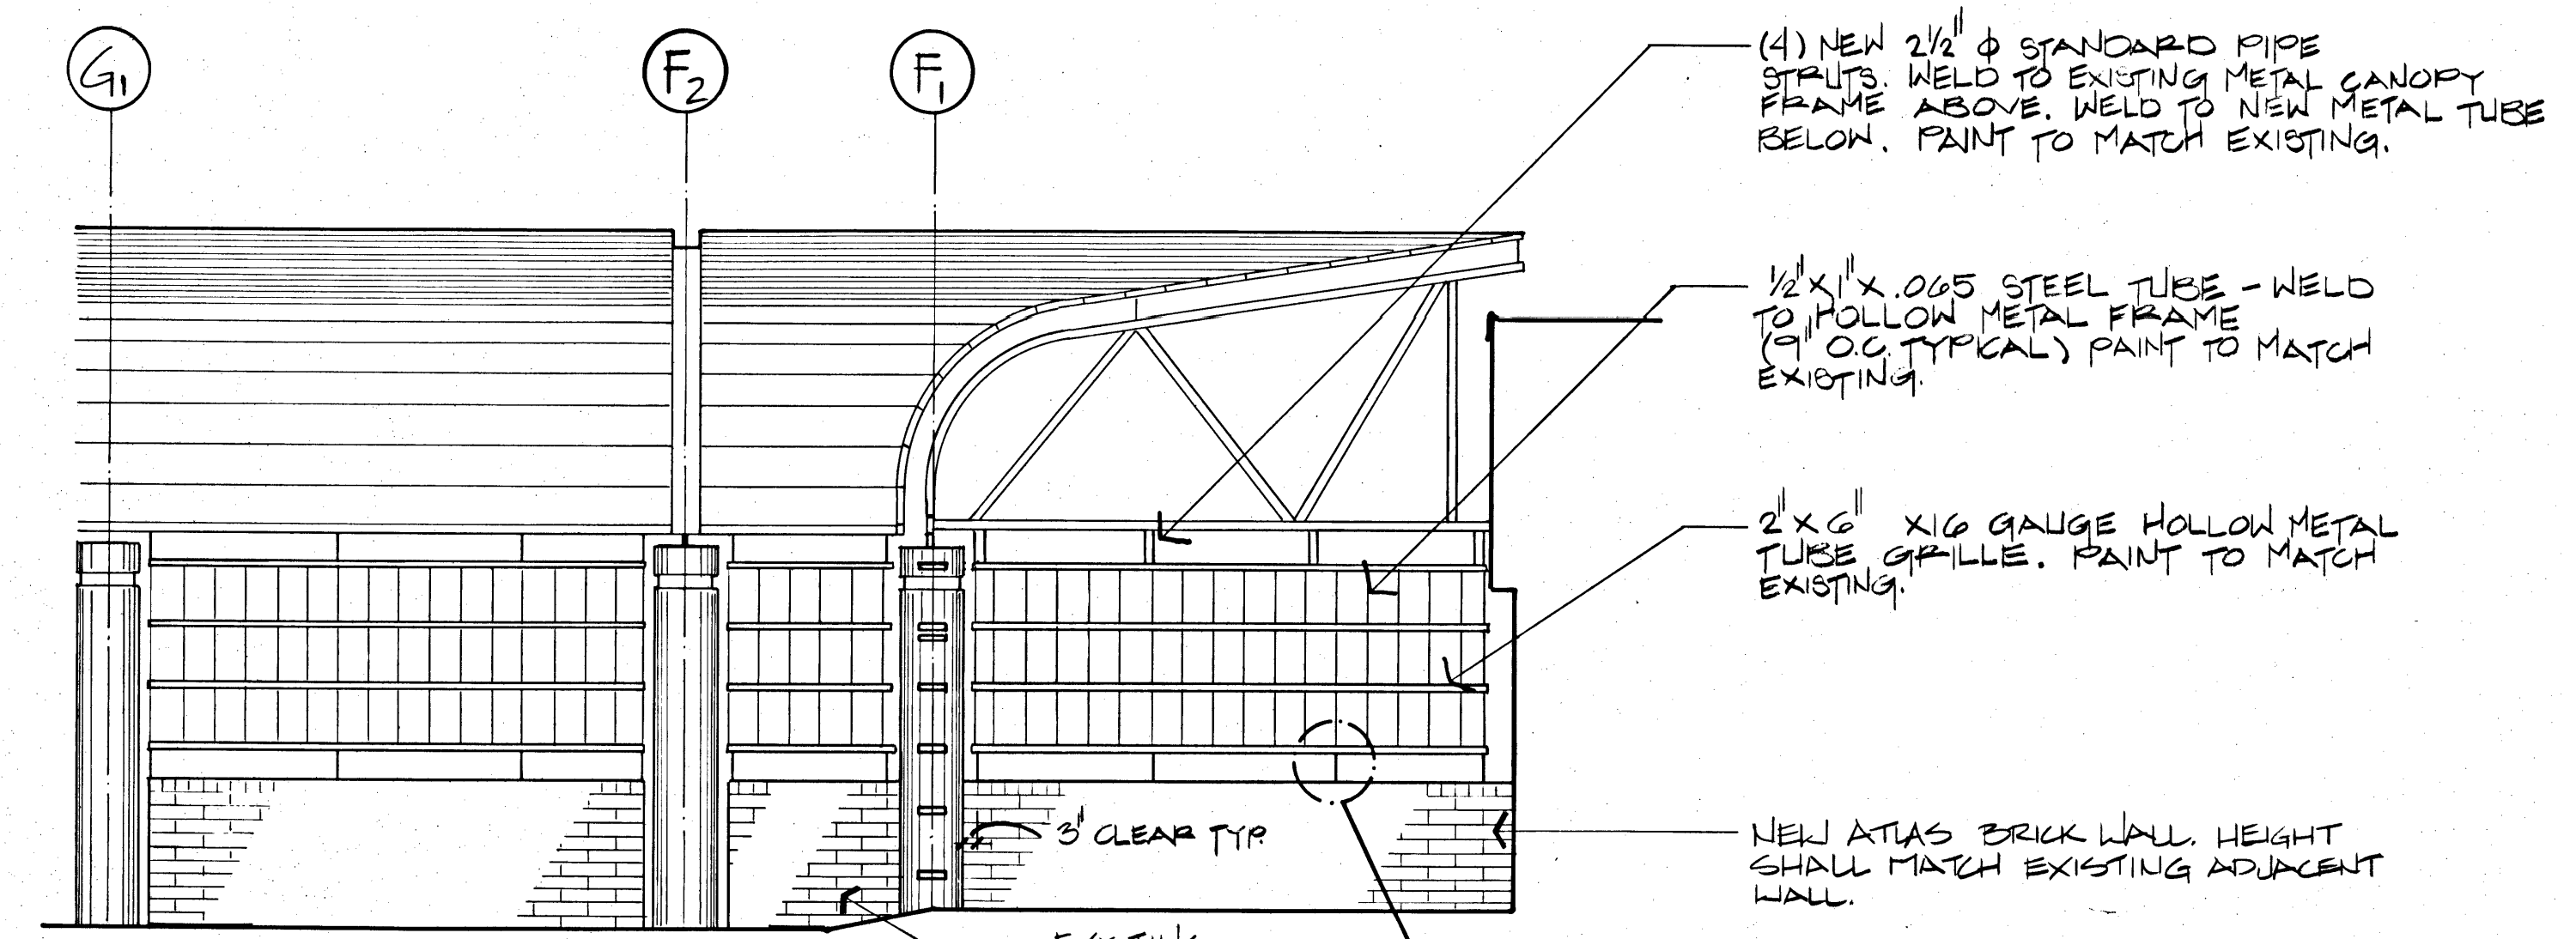


4 ELEVATION @ WALL W/ GRILLE
A5.1 1/4" = 1'-0" ALTERNATE 1

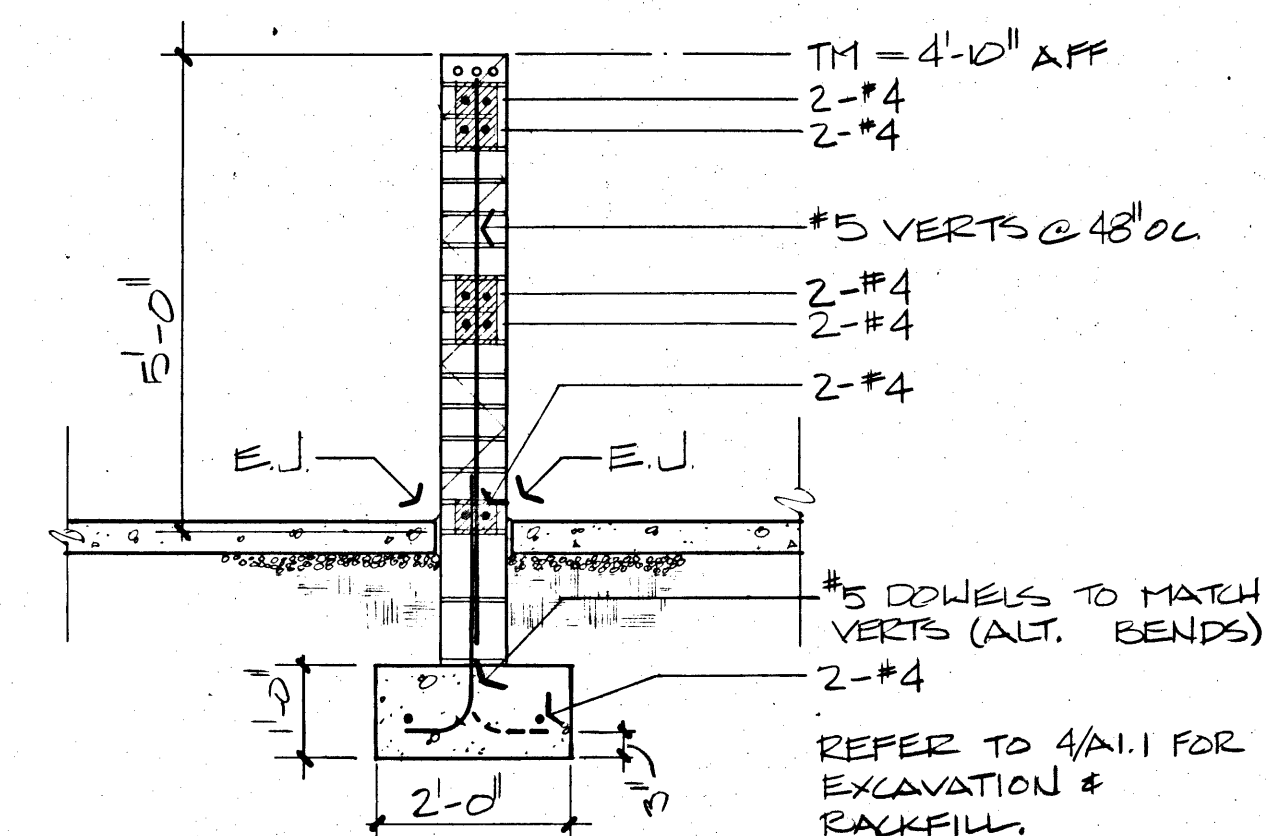


5 WALL SECTION
A5.1 1/2" = 1'-0" ALTERNATE 1

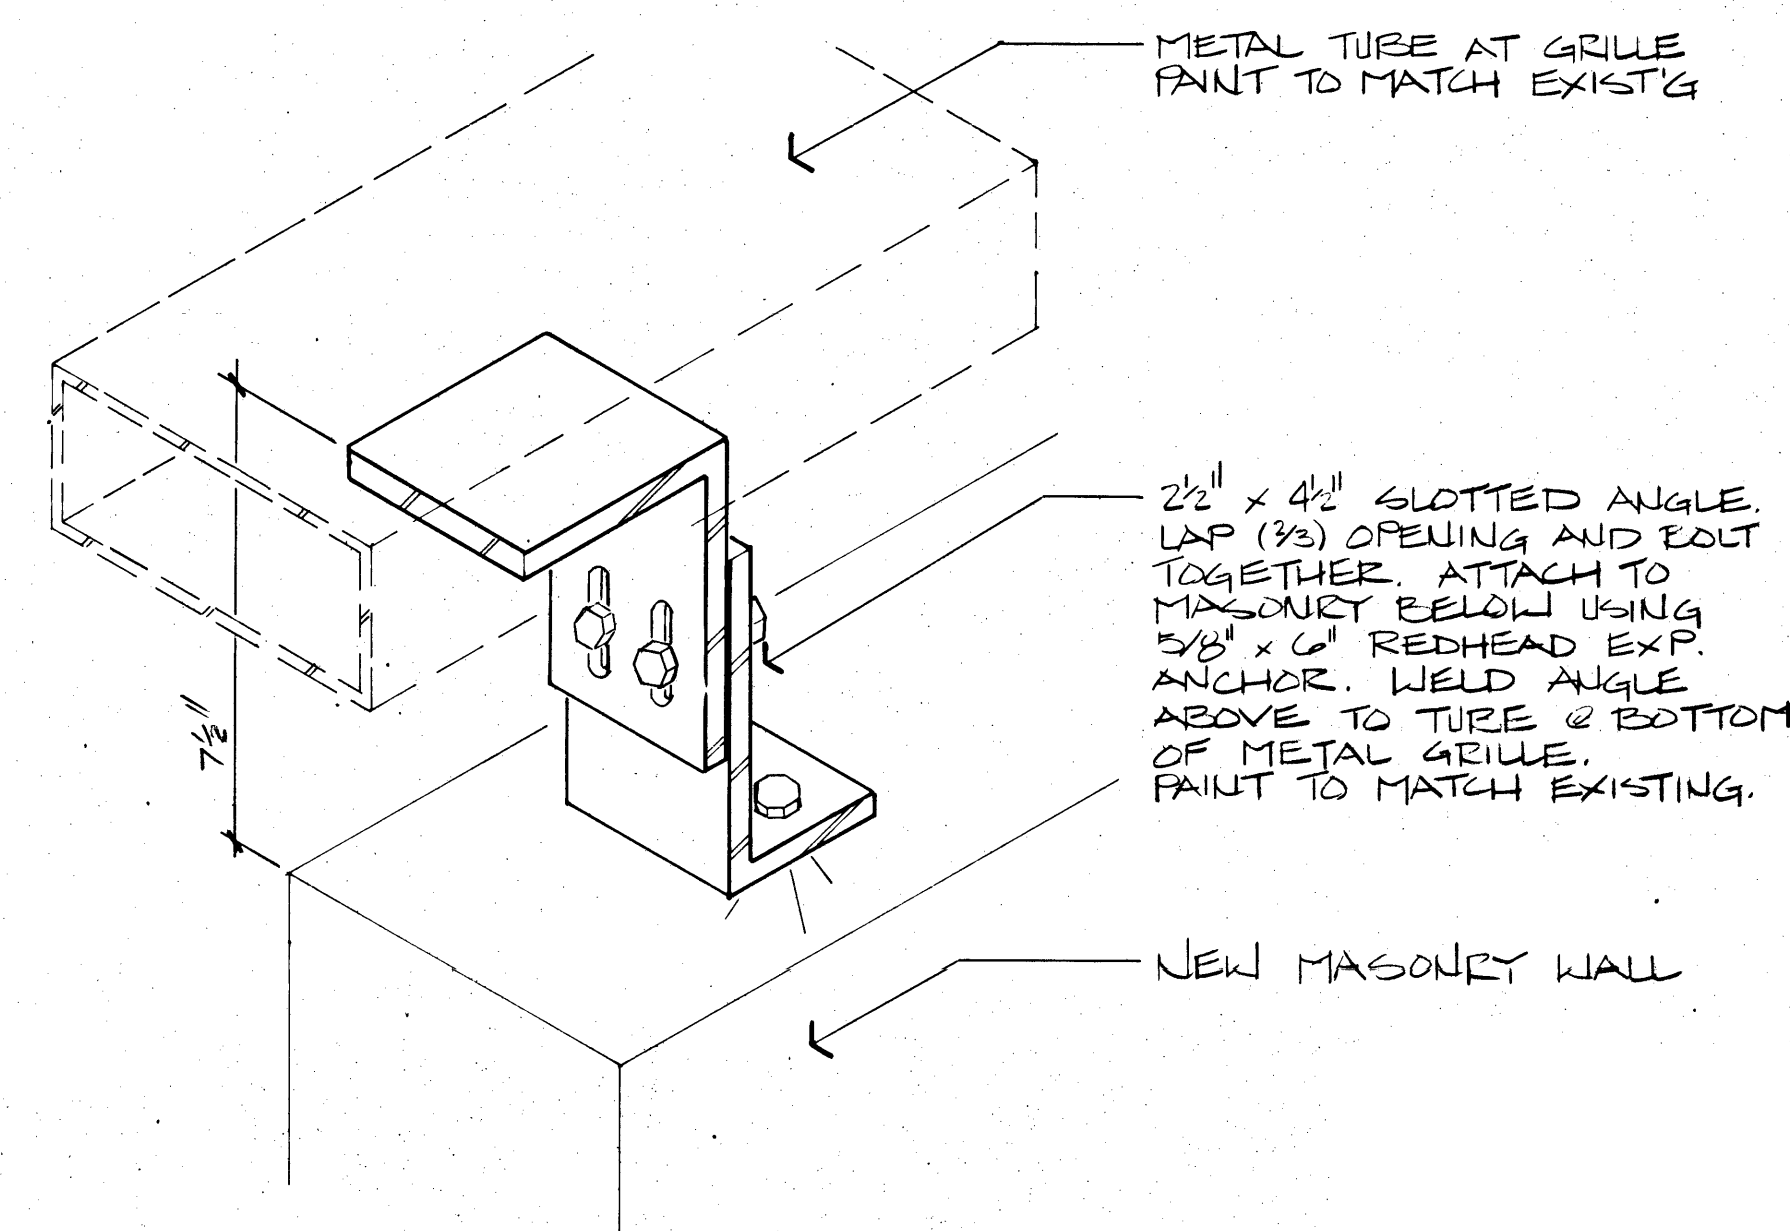


6 ATTACHMENT @ METAL GRILLE
A5.1 NO SCALE ALTERNATE 1

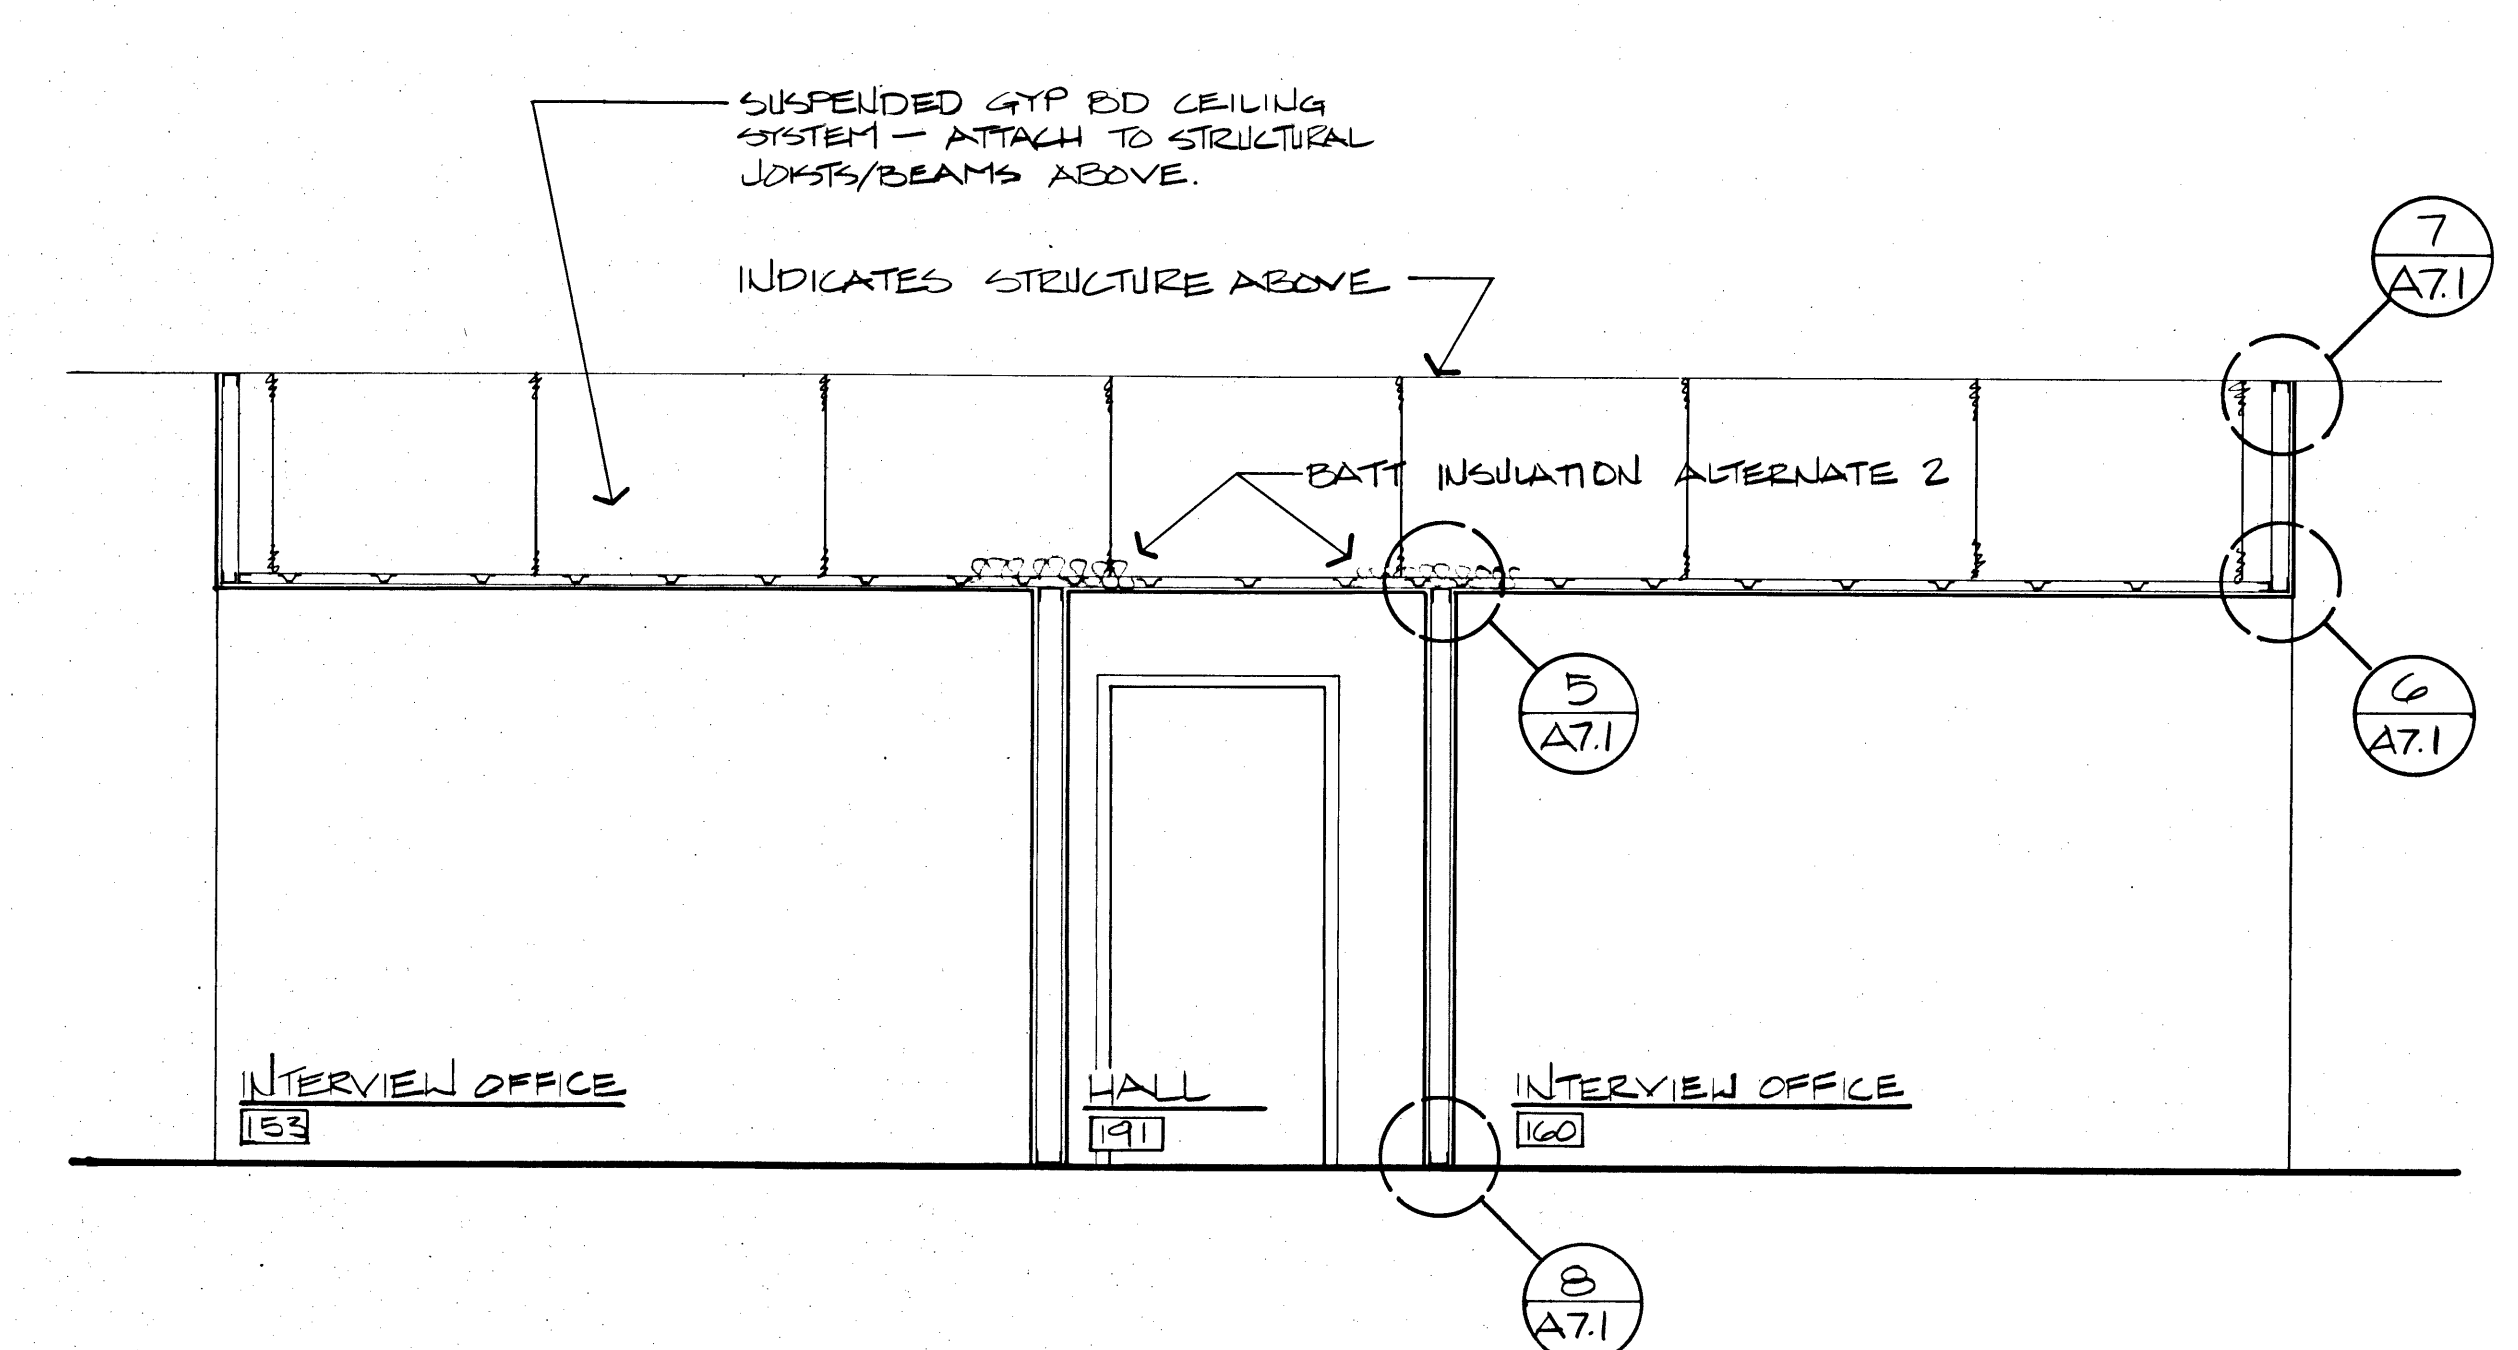

9 SECTION @ INTERVIEW OFFICES
A5.1 3/8" = 1'-0"

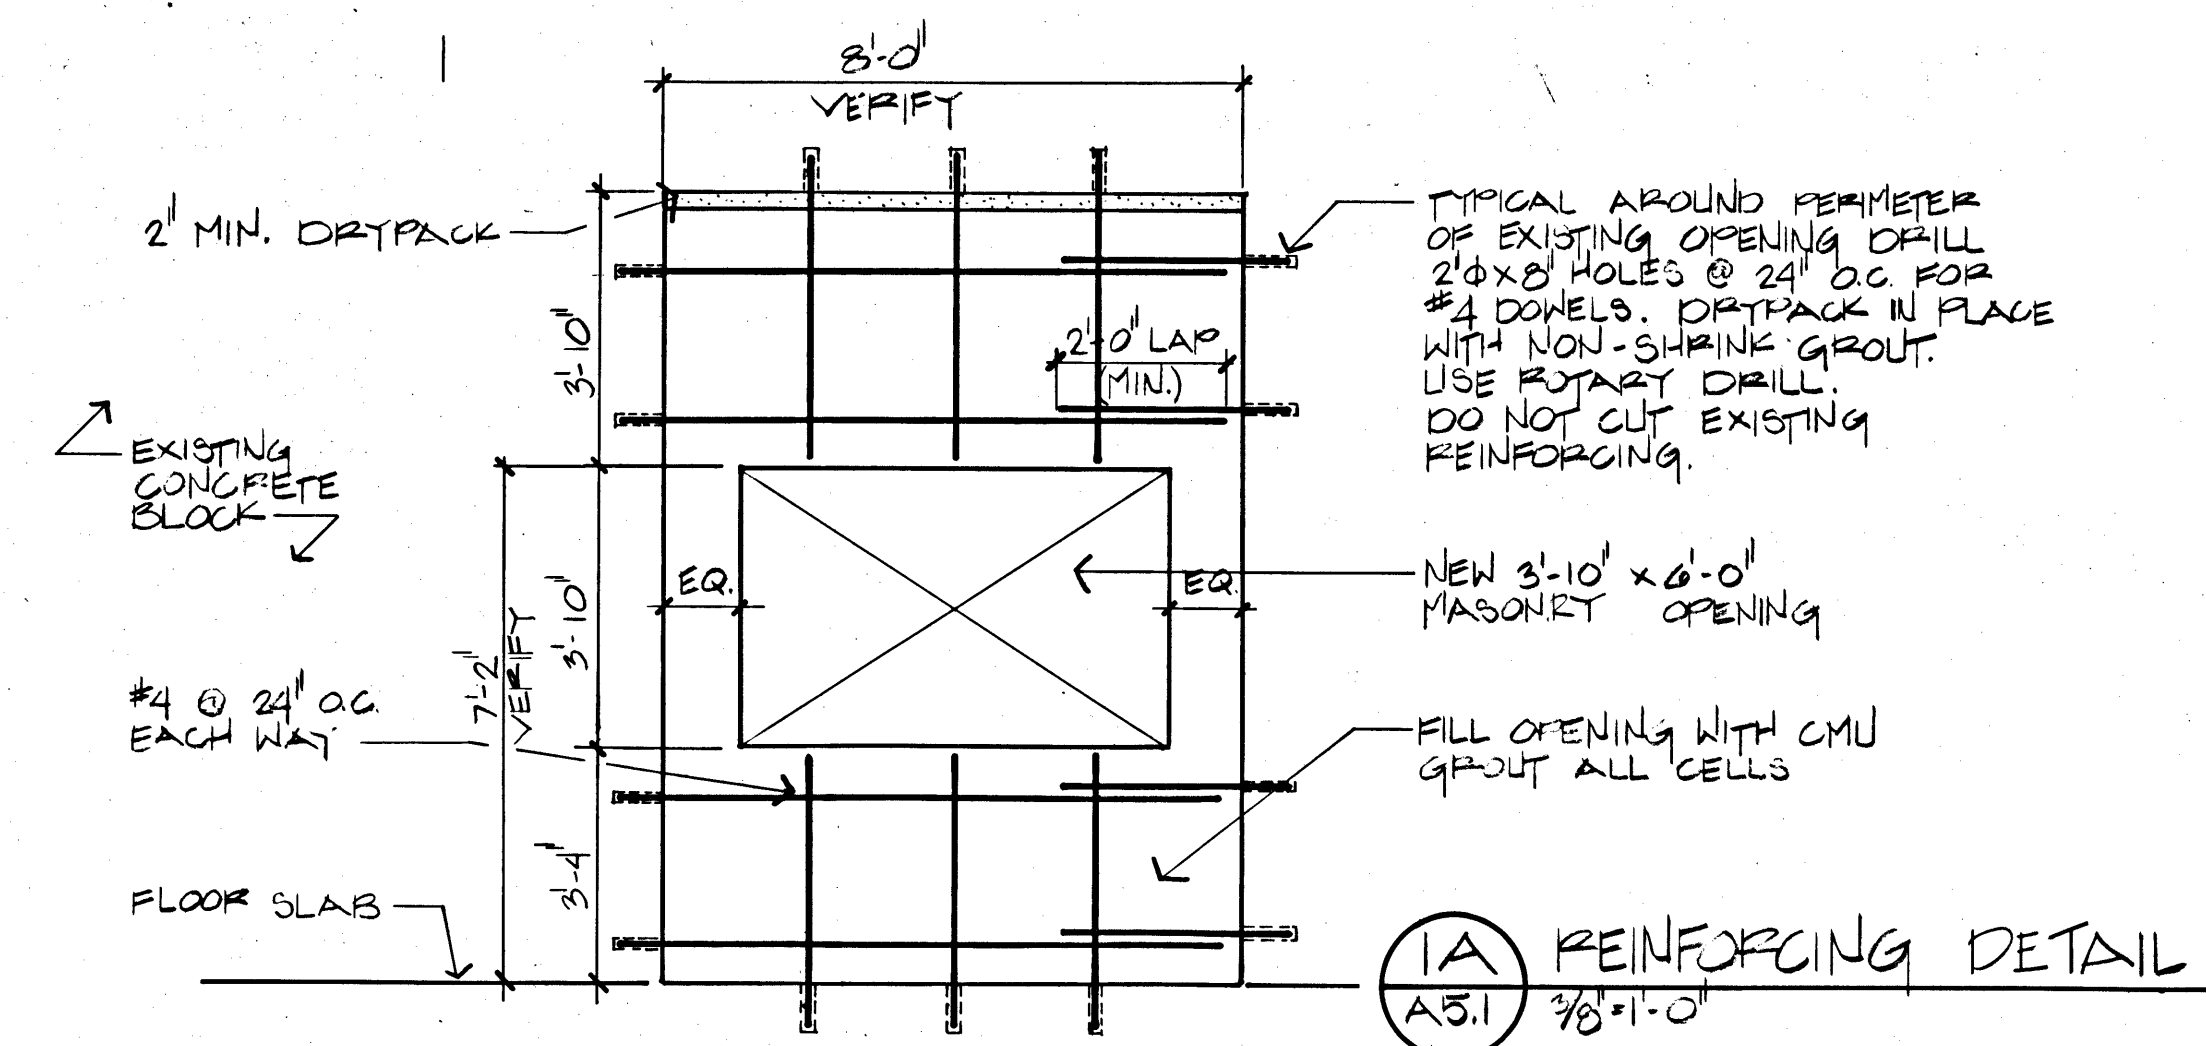

1A REINFORCING DETAIL
A5.1 3/8" = 1'-0"

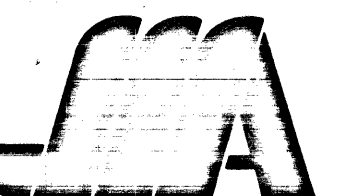

JMA ARCHITECTS & ENGINEERS, INC.

Architecture and Engineering
Research and Planning
Interior and Graphic Design
Landscape Architecture4292 S. Maryland Parkway
Las Vegas, Nevada 89119
(702) 731-2033
FAX (702) 731-2039

Consultants

Seal

Revisions

No. Date Description

15-96

Date 12/18/89

Drawn NA

Checked DC

Project No. 89237

Project

WELFARE SERVICES
FACILITY
for the
CITY OF LAS VEGAS

Drawing Title

EXTERIOR
ELEVATIONS
AND SECTIONS

Drawing No.

A5.1

As Built 513-57A