



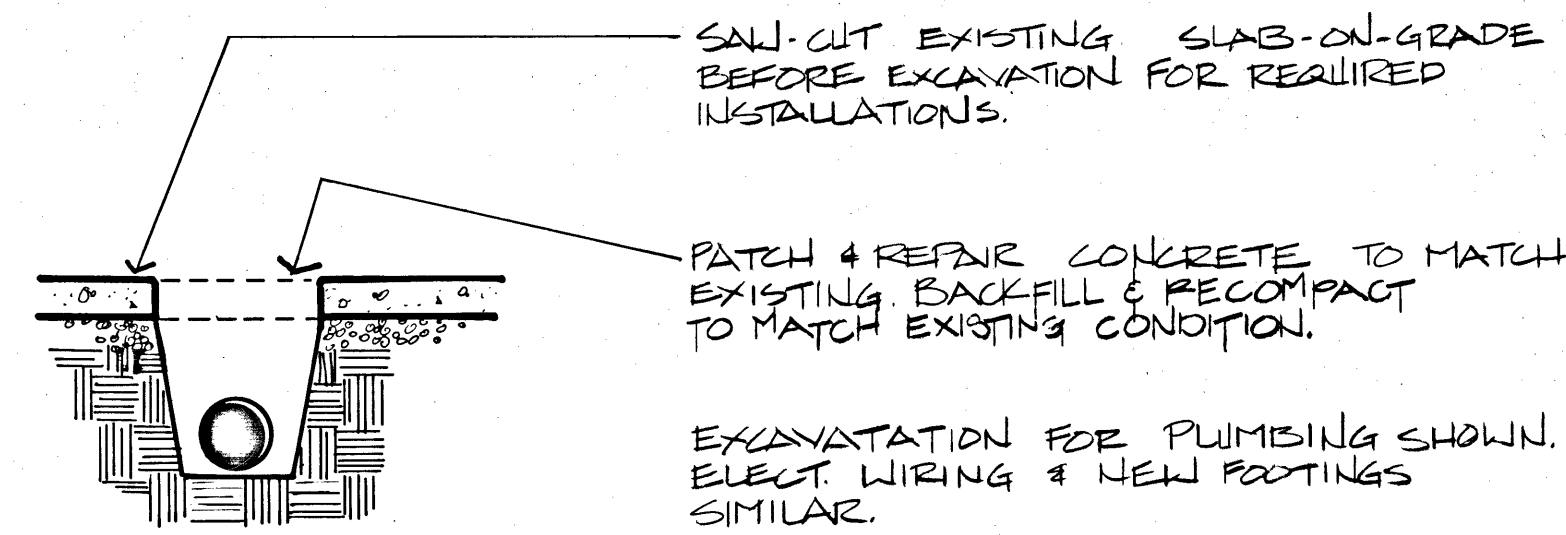

4 EXCAVATION DETAIL
ALL NO SCALE

SITE PLAN
SCALE: 1"=50'

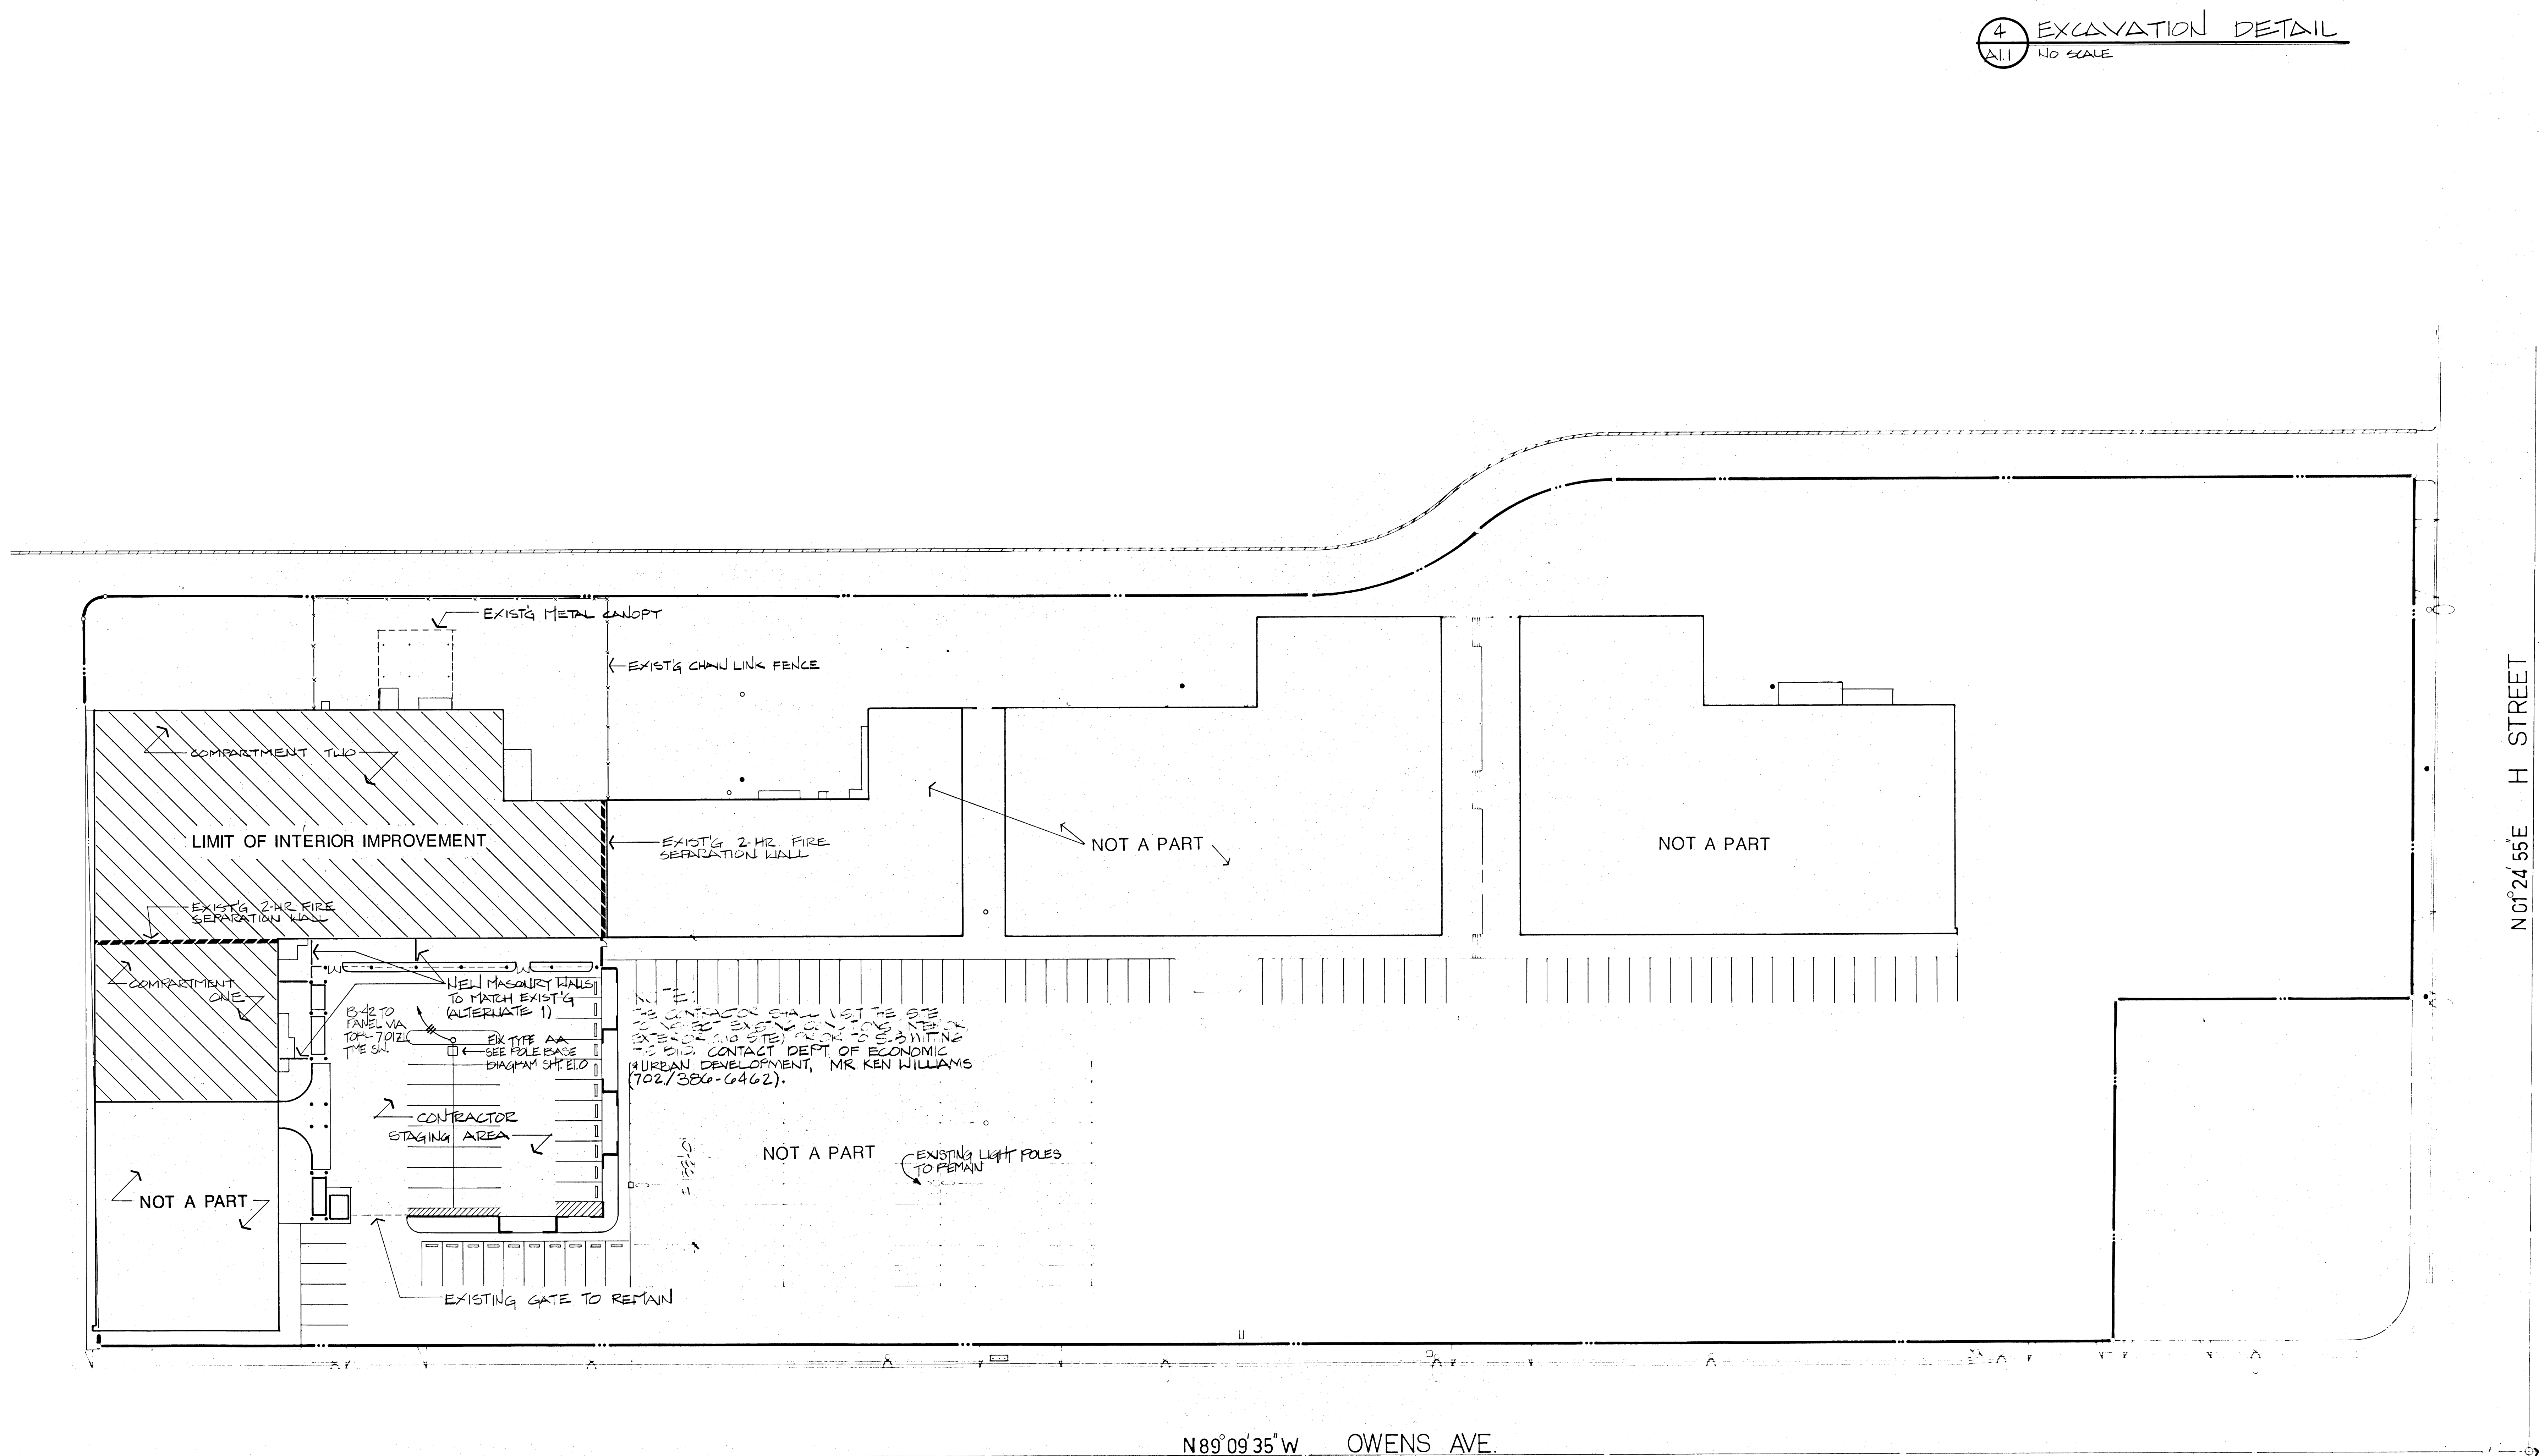

JMA
Architecture & Engineering
Research & Planning
Graphic Design
4292 S. Maryland Parkway
Las Vegas, Nevada 89103
(702) 731-2634

Consultants

The Contractor shall check and verify all dimensions and report all errors and omissions to this office prior to commencing work. These drawings are not to be sealed.

Seal

Revisions		
No.	Date	Description

Date: 12/18/89
Drawn: N.A.
Checked: D.C.
Project No.: 89237

Project:
WELFARE SERVICES FACILITY

CITY OF LAS VEGAS
OWENS AND H STREET
LAS VEGAS, NEVADA

Drawing Title:
SITE PLAN

Drawing No.:
A1.1

As Built 013-574