


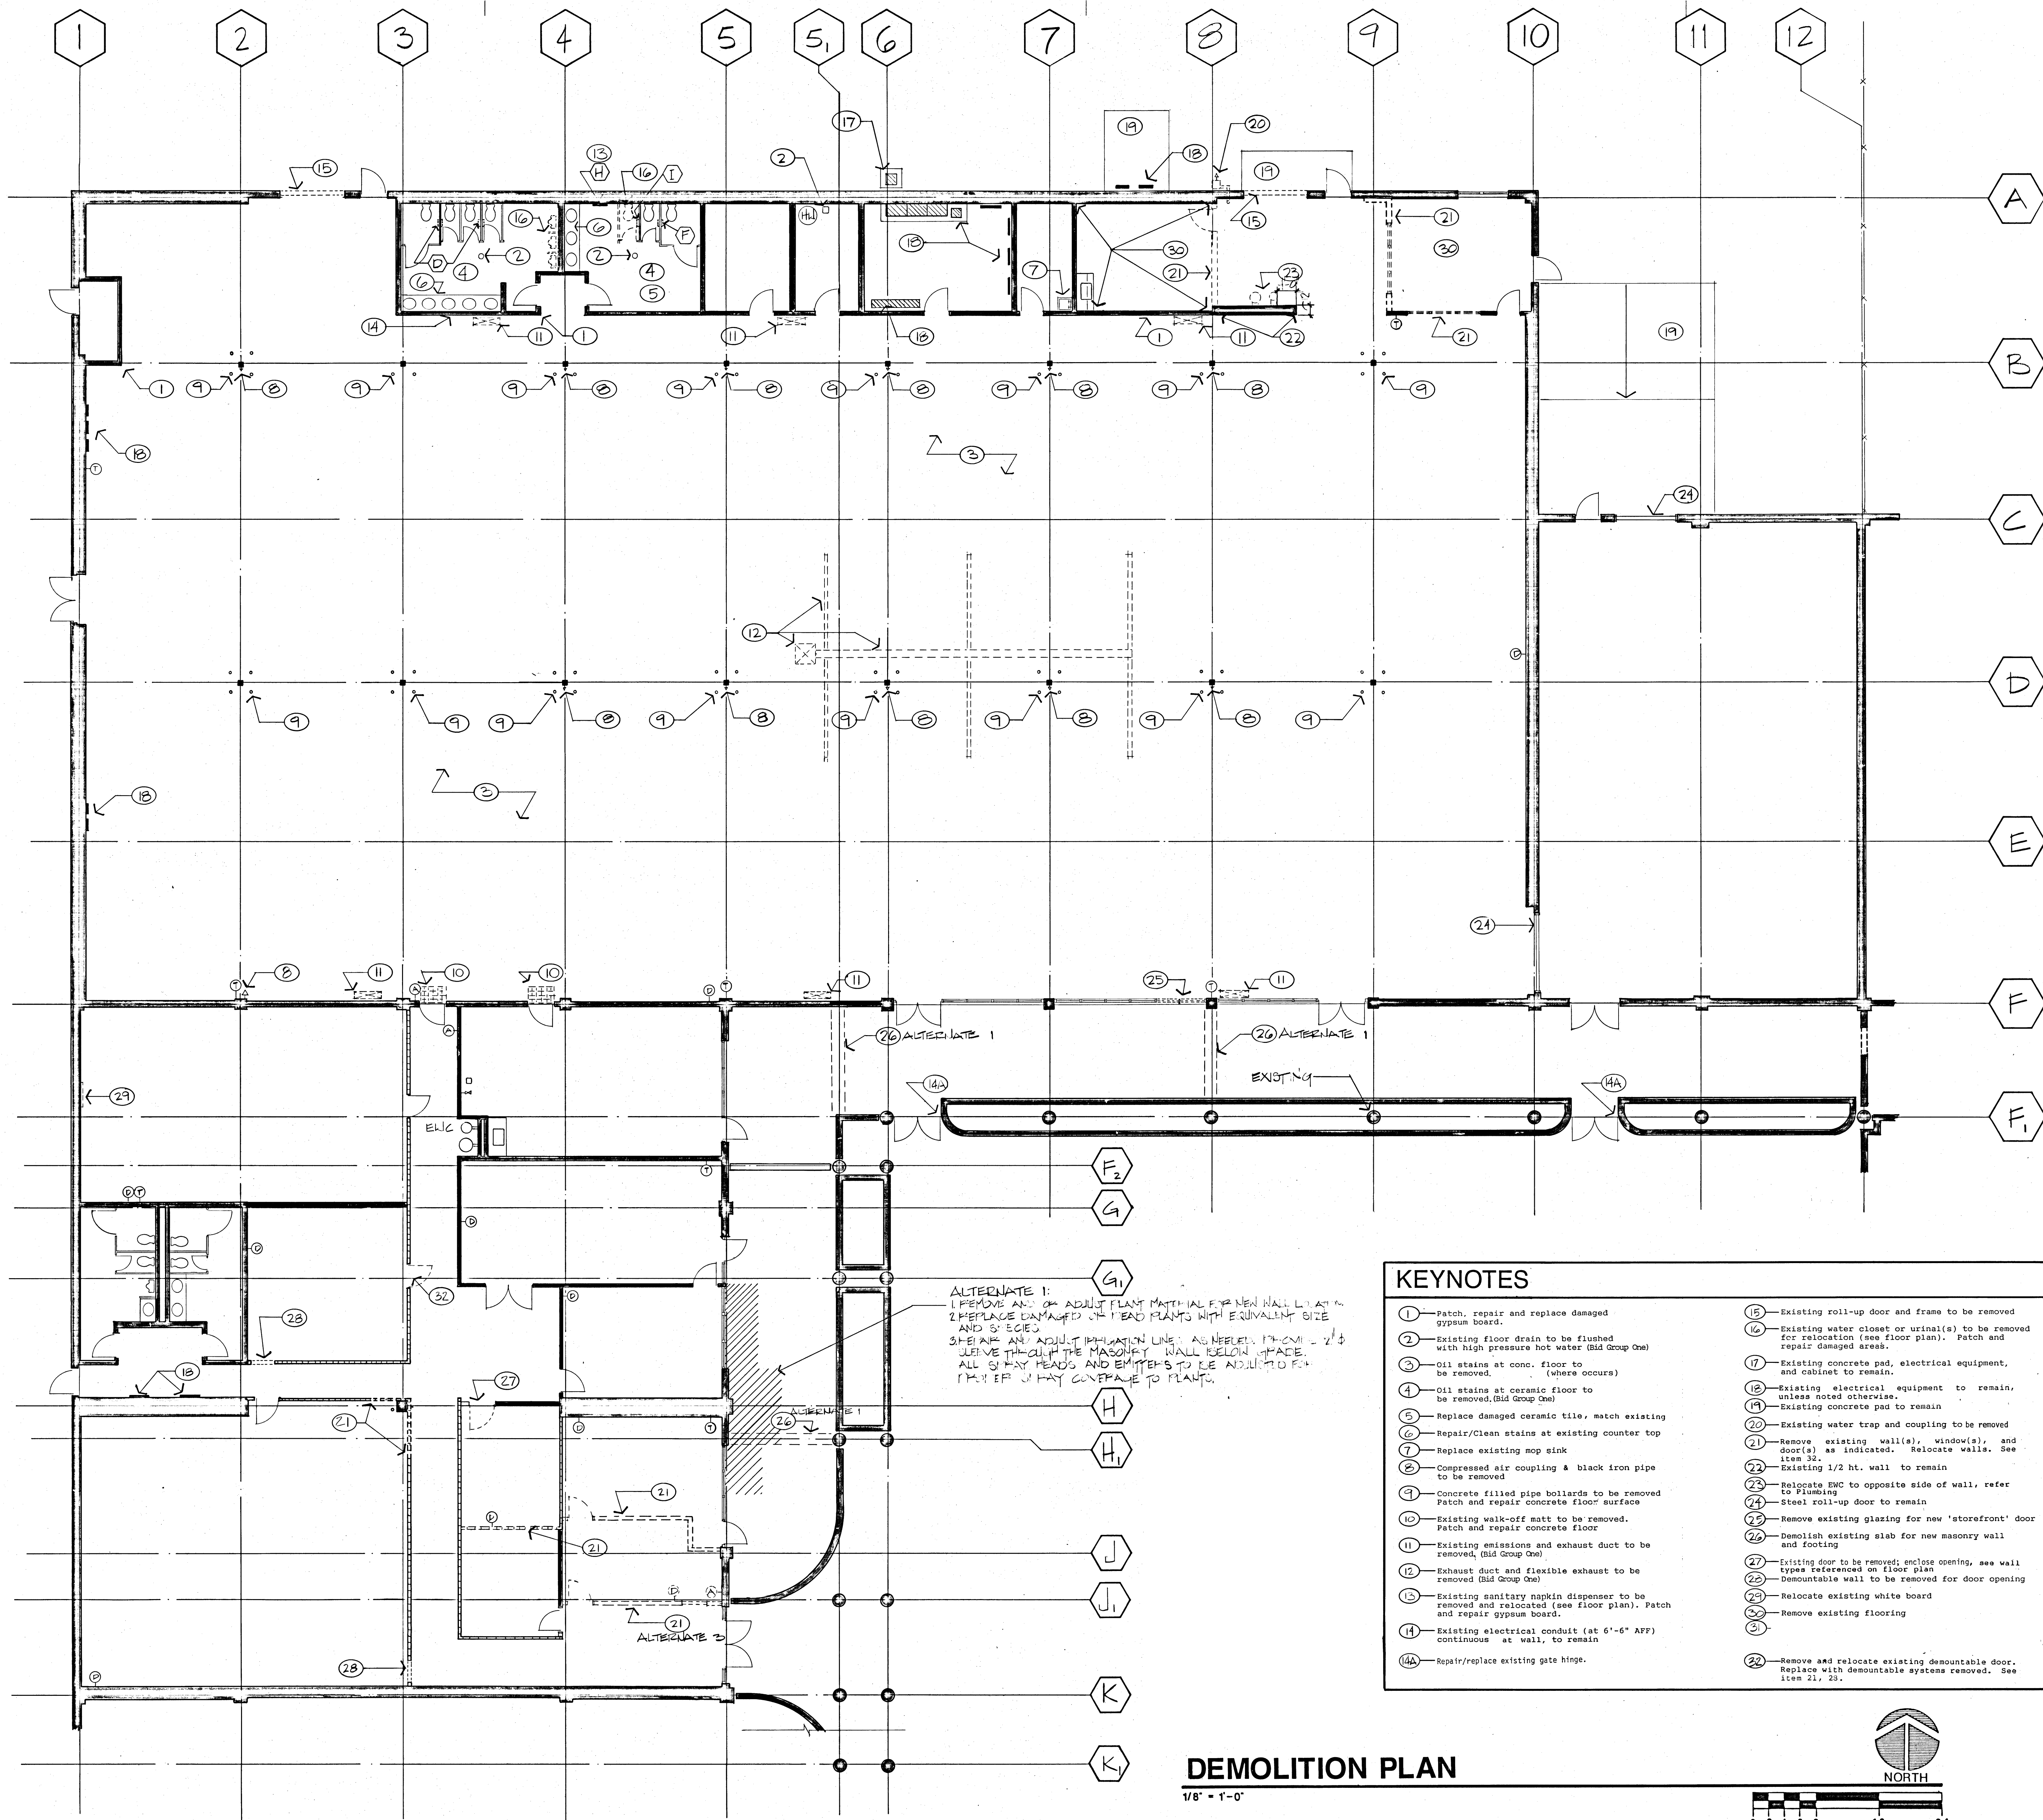

KEYNOTES		LEGEND
1	Patch, repair and replace damaged gypsum board.	Indicates toilet room accessory, see referenced item as scheduled sheet A2.2
2	Existing floor drain to be flushed with high pressure hot water (Bid Group One)	Indicates location of existing data cable
3	Oil stains at conc. floor to be removed (where occurs)	Indicates location of existing alarm devices
4	Oil stains at ceramic floor to be removed (Bid Group One)	Indicates location of existing thermostat, this sheet only
5	Replace damaged ceramic tile, match existing	Indicates existing gypsum board covering at walls
6	Repair/Clean stains at existing counter top	Indicates existing demountable walls
7	Replace existing mop sink	Indicates existing glazing systems
8	Compressed air coupling & black iron pipe to be removed	
9	Concrete filled pipe bollards to be removed. Patch and repair concrete floor surface	
10	Existing walk-off mat to be removed. Patch and repair concrete floor	
11	Existing emissions and exhaust duct to be removed (Bid Group One)	
12	Exhaust duct and flexible exhaust to be removed (Bid Group One)	
13	Existing sanitary napkin dispenser to be removed and relocated (see floor plan). Patch and repair gypsum board.	
14	Existing electrical conduit (at 6'-6" AFF) continuous at wall, to remain	
14A	Repair/replace existing gate hinge.	
15	Existing roll-up door and frame to be removed	
16	Existing water closet or urinal(s) to be removed for relocation (see floor plan). Patch and repair damaged areas.	
17	Existing concrete pad, electrical equipment, and cabinet to remain.	
18	Existing electrical equipment to remain, unless noted otherwise.	
19	Existing concrete pad to remain	
20	Existing water trap and coupling to be removed	
21	Remove existing wall(s), window(s), and door(s) as indicated. Relocate walls. See item 32.	
22	Existing 1/2 ht. wall to remain	
23	Relocate DWC to opposite side of wall, refer to plumbing	
24	Steel roll-up door to remain	
25	Remove existing glazing for new 'storefront' door	
26	Demolish existing slab for new masonry wall and footing	
27	Existing door to be removed; enclose opening, see wall types referenced on floor plan	
28	Demountable wall to be removed for door opening	
29	Relocate existing white board	
30	Remove existing flooring	
32	Remove and relocate existing demountable door. Replace with demountable systems removed. See item 21, 23.	

DEMOLITION PLAN
1/8" = 1'-0"

JMA ARCHITECTS & ENGINEERS, INC.
Architecture and Engineering
Research and Planning
Interior and Graphic Design
Landscape Architecture
4292 S. Maryland Parkway
Las Vegas, Nevada 89119
(702) 731-2033
FAX (702) 731-2039

Consultants

The Contractor shall check and verify all dimensions and report all errors or omissions to this office prior to commencing work. These drawings are not to be scaled.

Seal

Revisions
No. Date Description

15-90

Date 12/18/19
Drawn N.A.
Checked D.C.
Project No. 89237
Project
WELFARE SERVICES FACILITY
CITY OF LAS VEGAS
NUCLEUS PLAZA, NEVADA
Drawing Title
DEMOLITION PLAN
Drawing No.
A1.2

As Built 513-579