

Revisions	

**Harry Campnell Architects**  
 1850 East Flamingo Road, Suite 120, Las Vegas, NV 89119 (702) 731-0363 Fax (702) 731-9266  
 Three Drawings, all Instruments of Service, are and shall remain the Property of Harry Campnell Architects. Do Not Scale this Drawing.

**WEST LAS VEGAS ARTS CENTER**  
**DOOLITTLE PARK - LAS VEGAS, NEVADA**  
**DETAILS AS-BUILT**


Date: 8/12/93  
 Drawn By: MHS  
 Checked By: M.T.  
 Project No: 92-160  
 Scale: AS NOTED  
 Sheet No: A-5.2

3 FEB 95  
 Cam  
 Newell / Amber Keen

FILE: 163.A52

2669

671-46

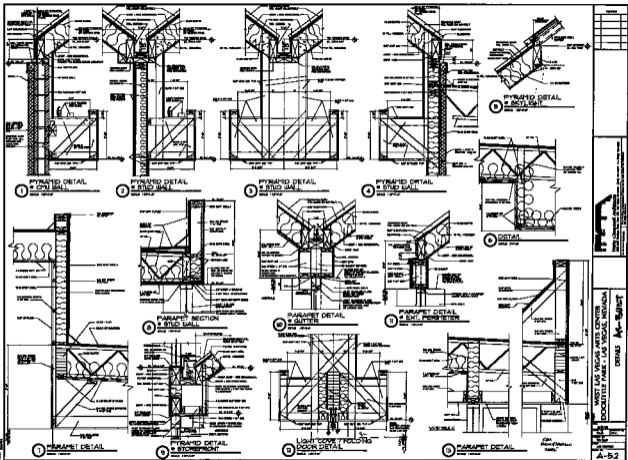

WEST LAS VEGAS AVENUE CENTER  
DOOMVILLE PARK - LAS VEGAS, NEVADA

DETAILS A4 - 1/4" = 1'-0"