




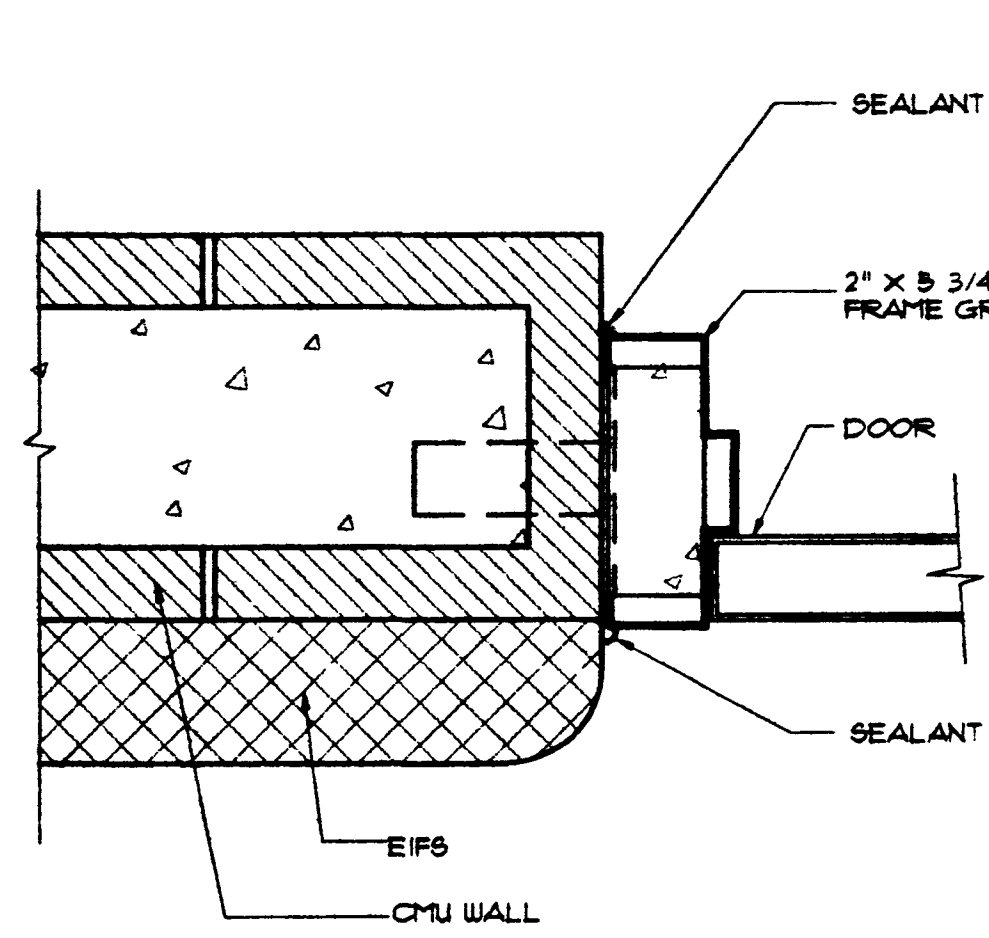


1 JAMB
SCALE: 3" = 1'-0"

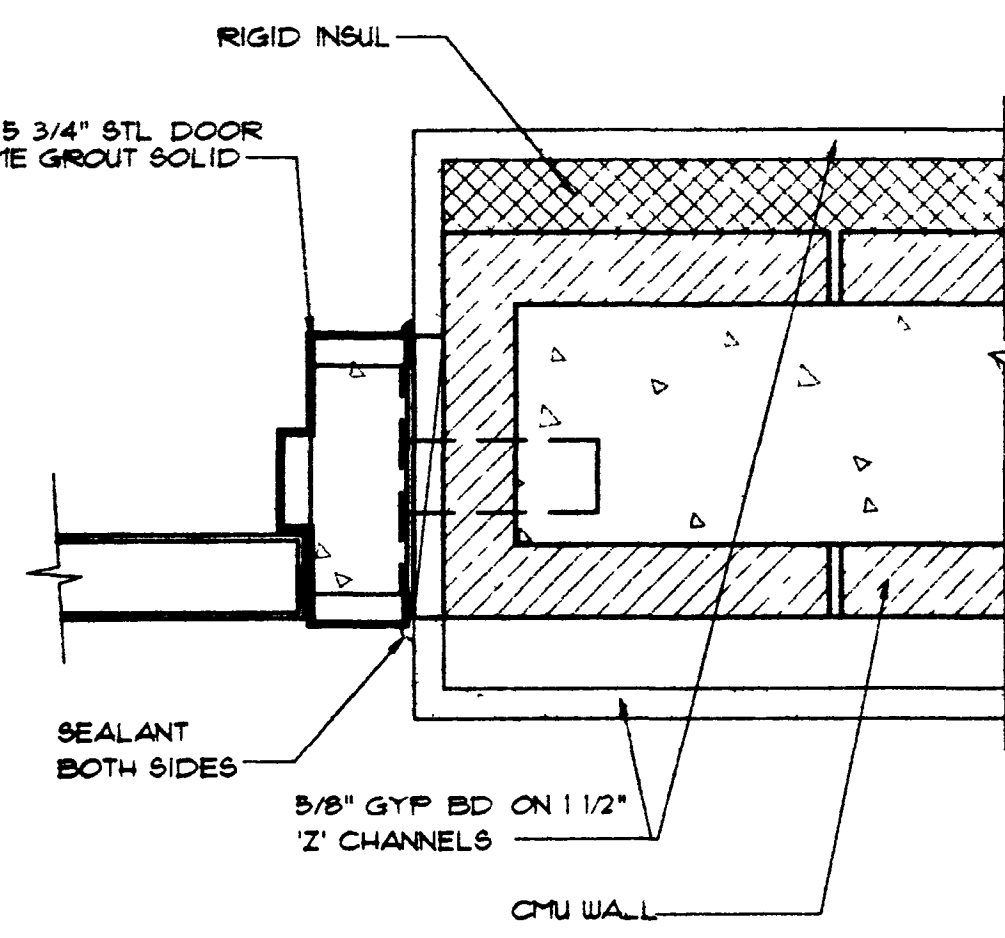


1A JAMB
SCALE: 3" = 1'-0"

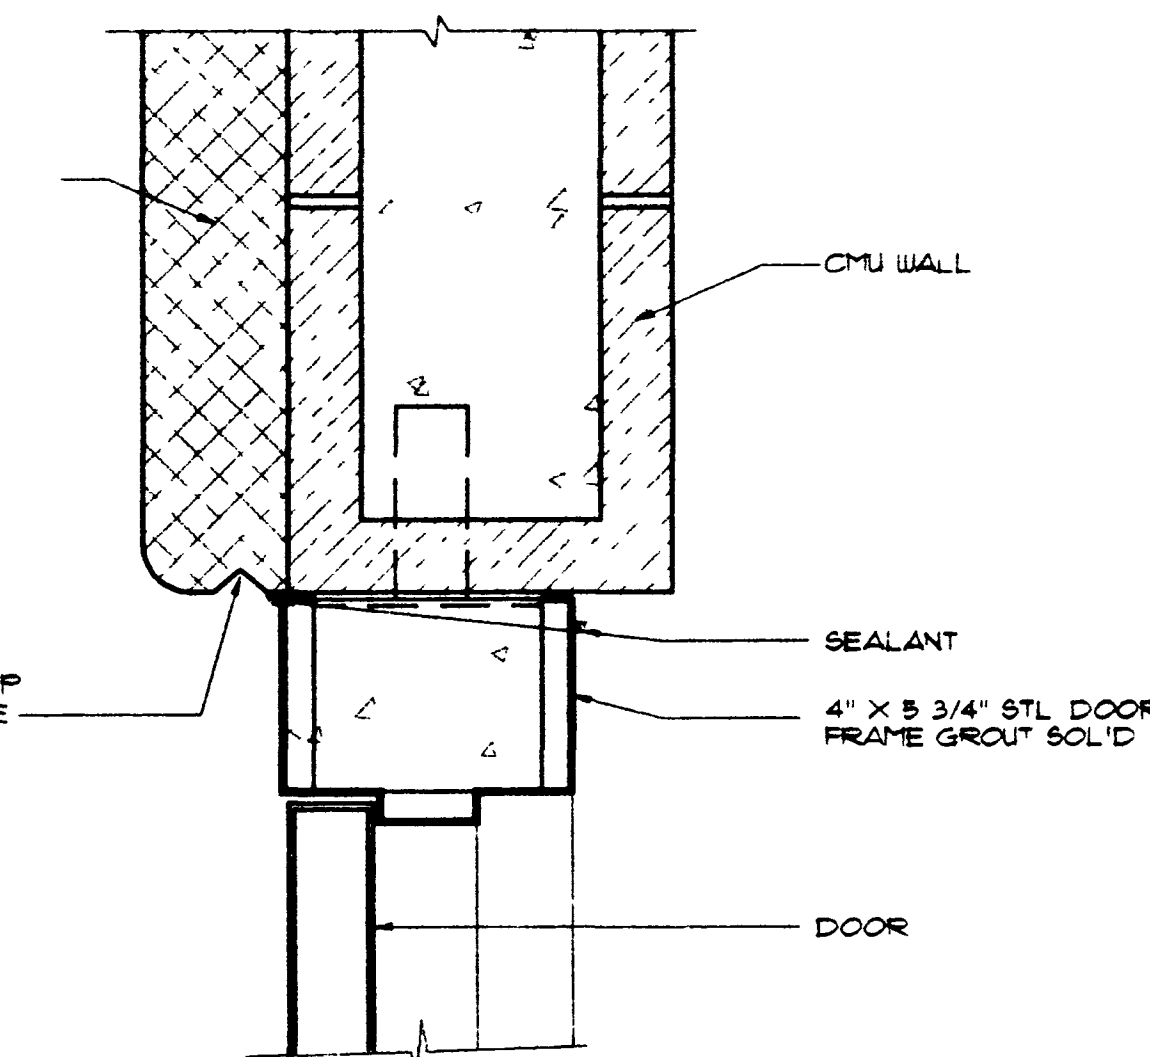


2 HEAD
SCALE: 3" = 1'-0"

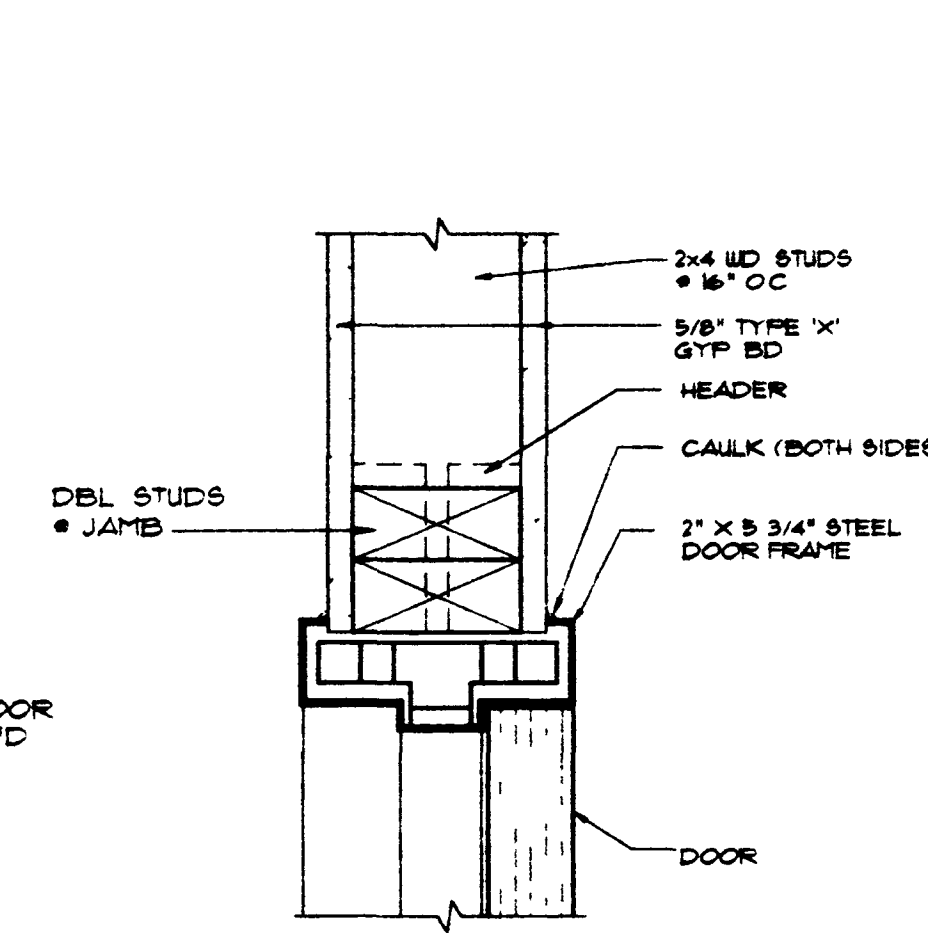


3 HEAD / JAMB
SCALE: 3" = 1'-0"

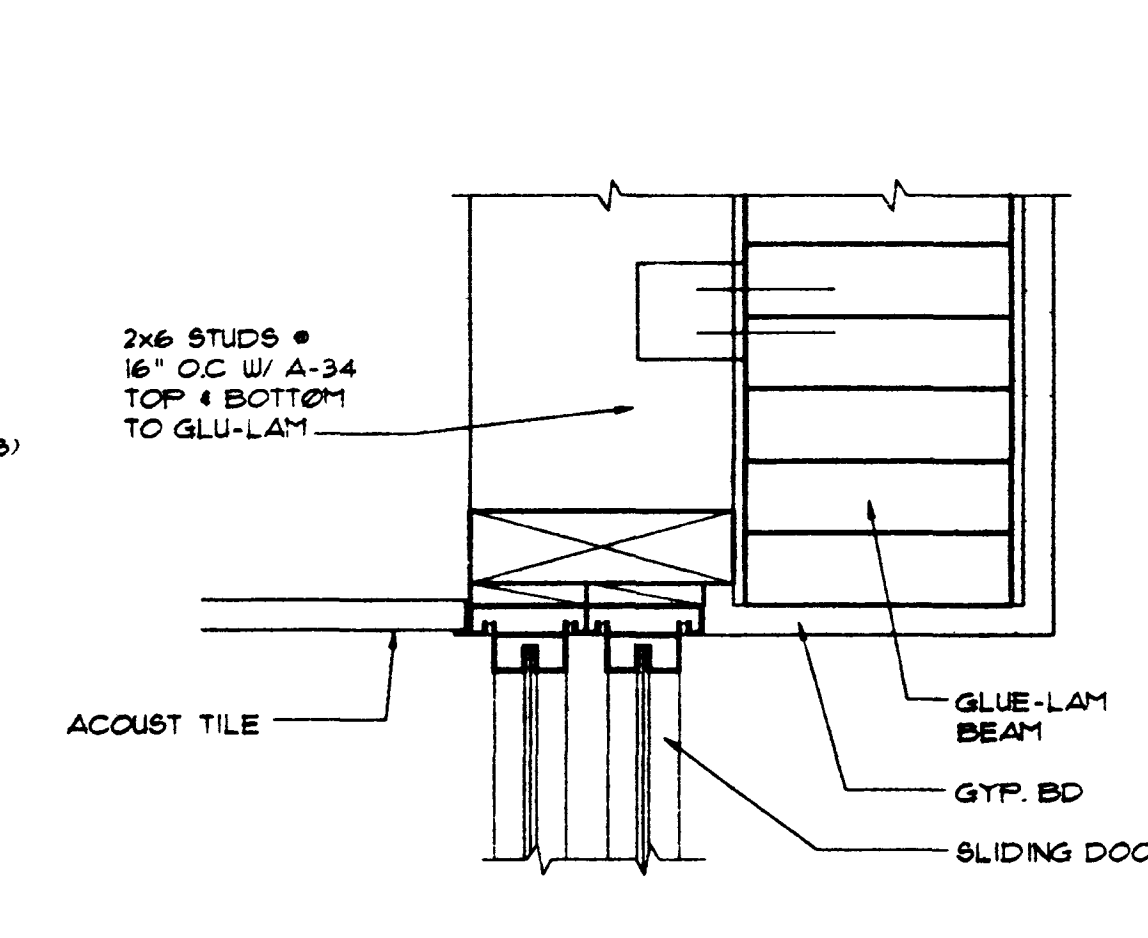


4 HEAD
SCALE: 3" = 1'-0"

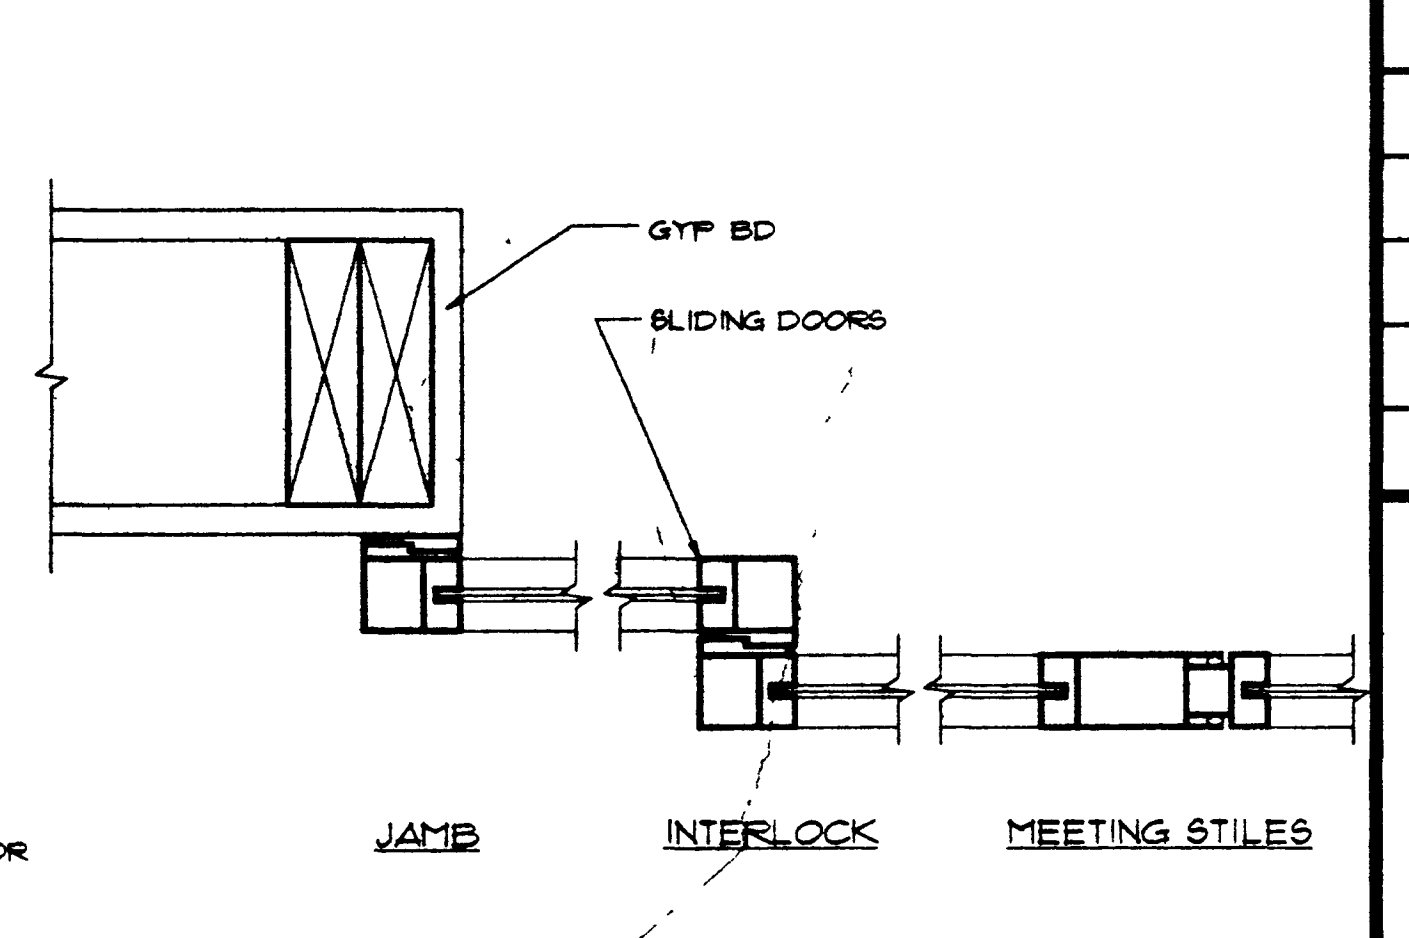


5 JAMB
SCALE: 3" = 1'-0"

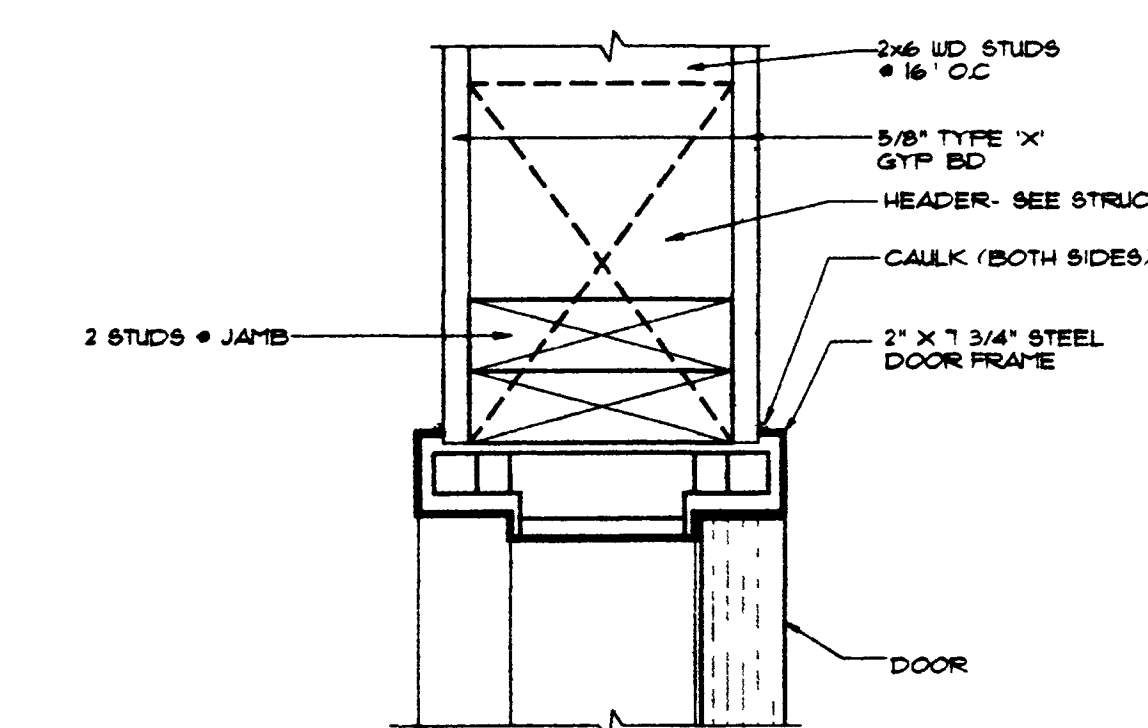


6 HEAD / JAMB
SCALE: 3" = 1'-0"

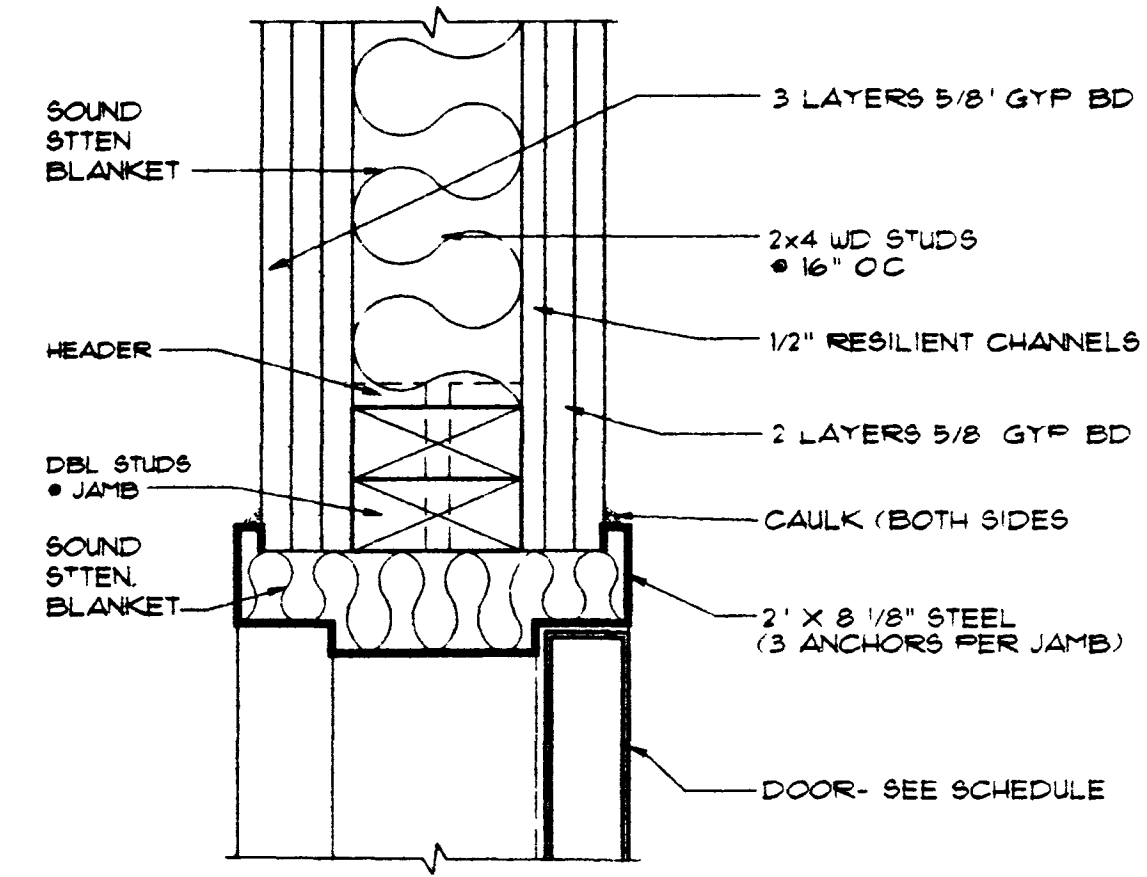


7 HEAD / JAMB
SCALE: 3" = 1'-0"

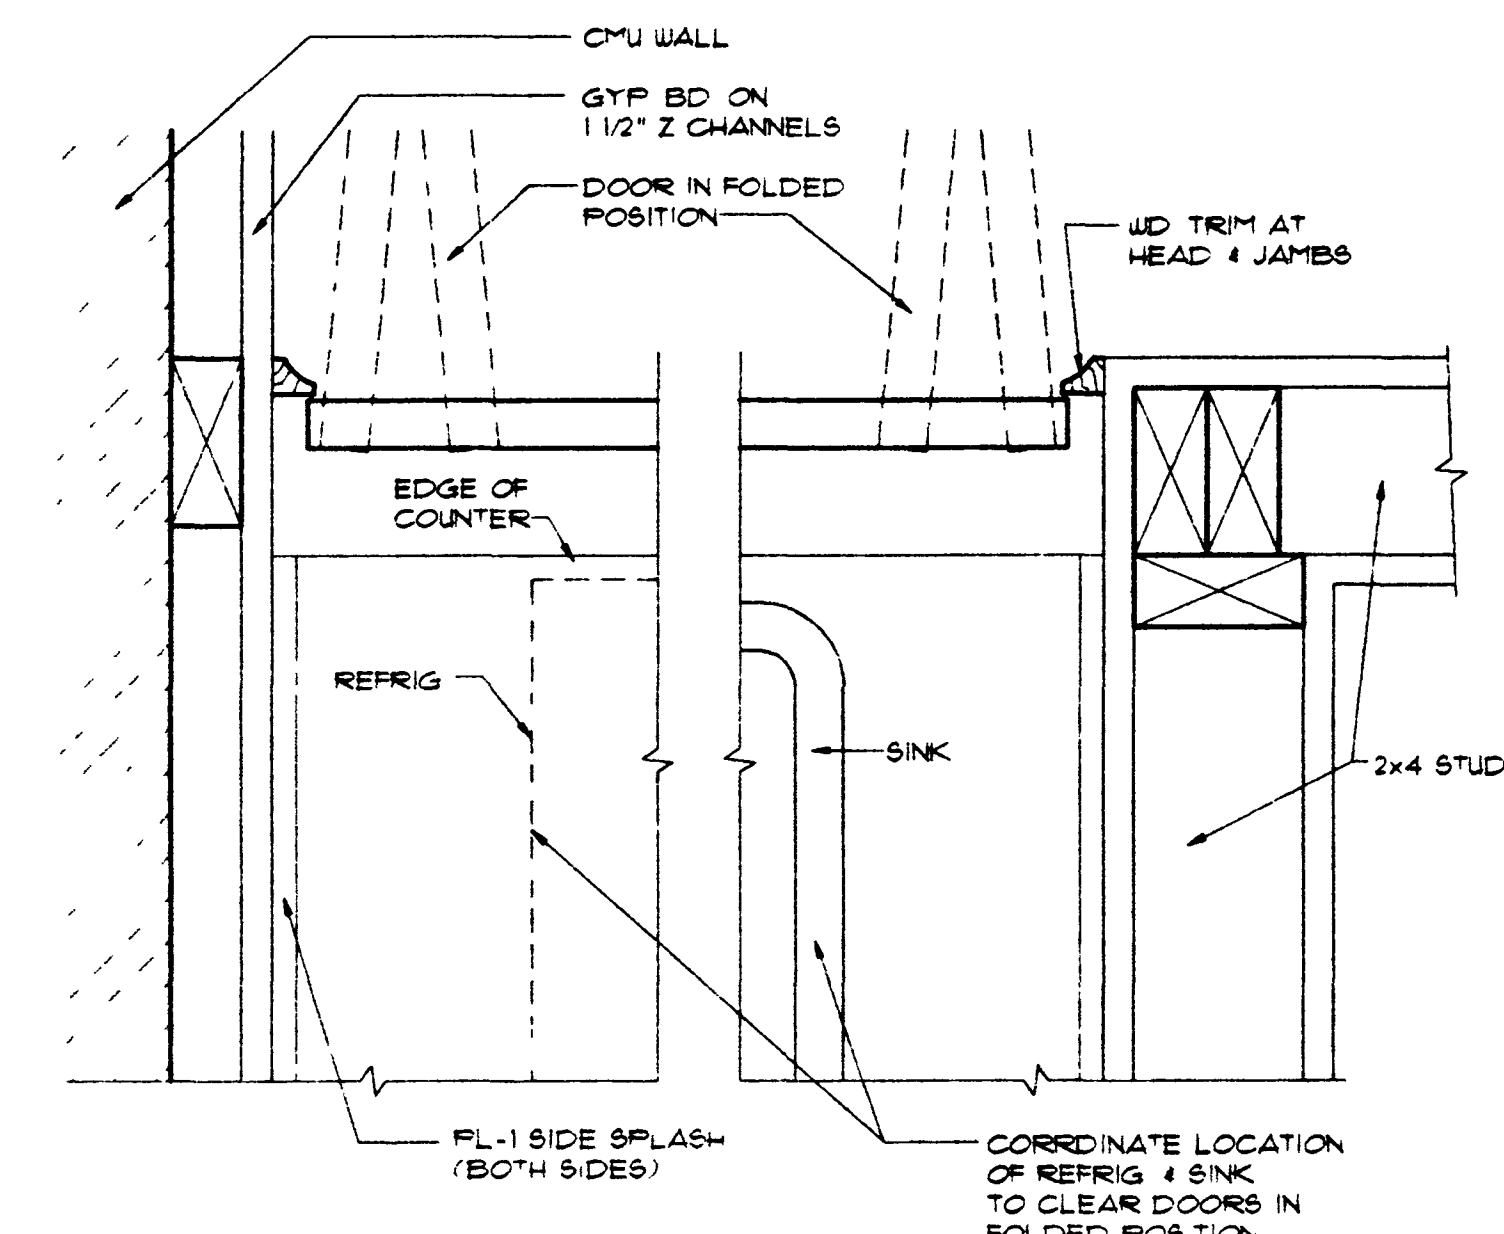


8 JAMB
SCALE: 3" = 1'-0"

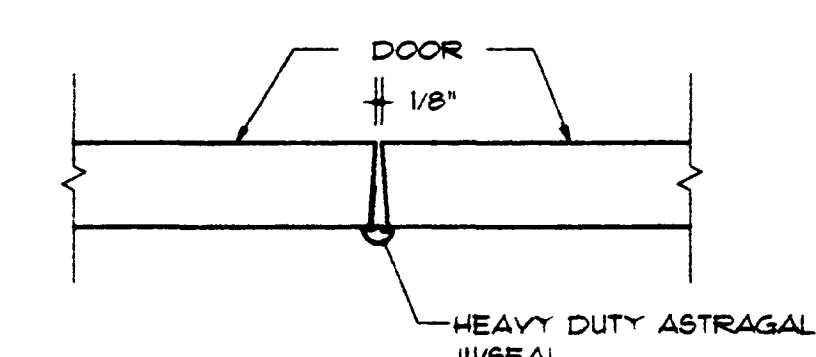


9 ASTRAGAL
SCALE: 3" = 1'-0"

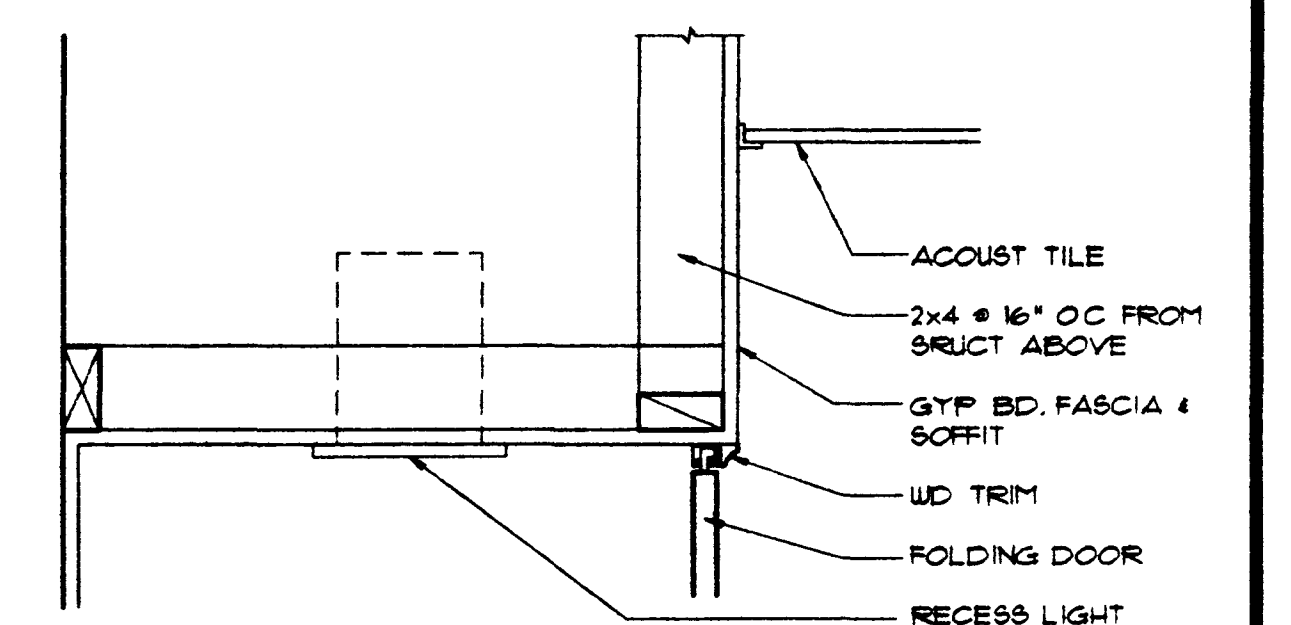


10 HEAD
SCALE: 1 1/2" = 1'-0"

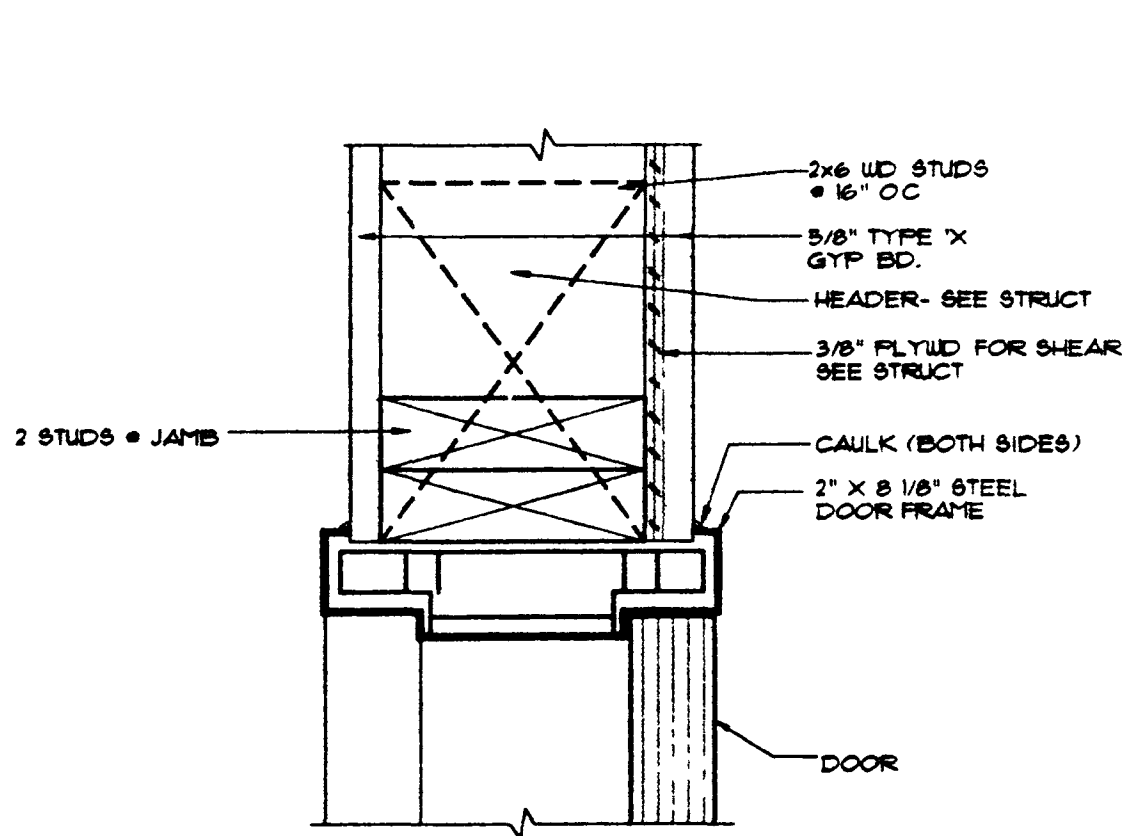


11 HEAD / JAMB
SCALE: 3" = 1'-0"

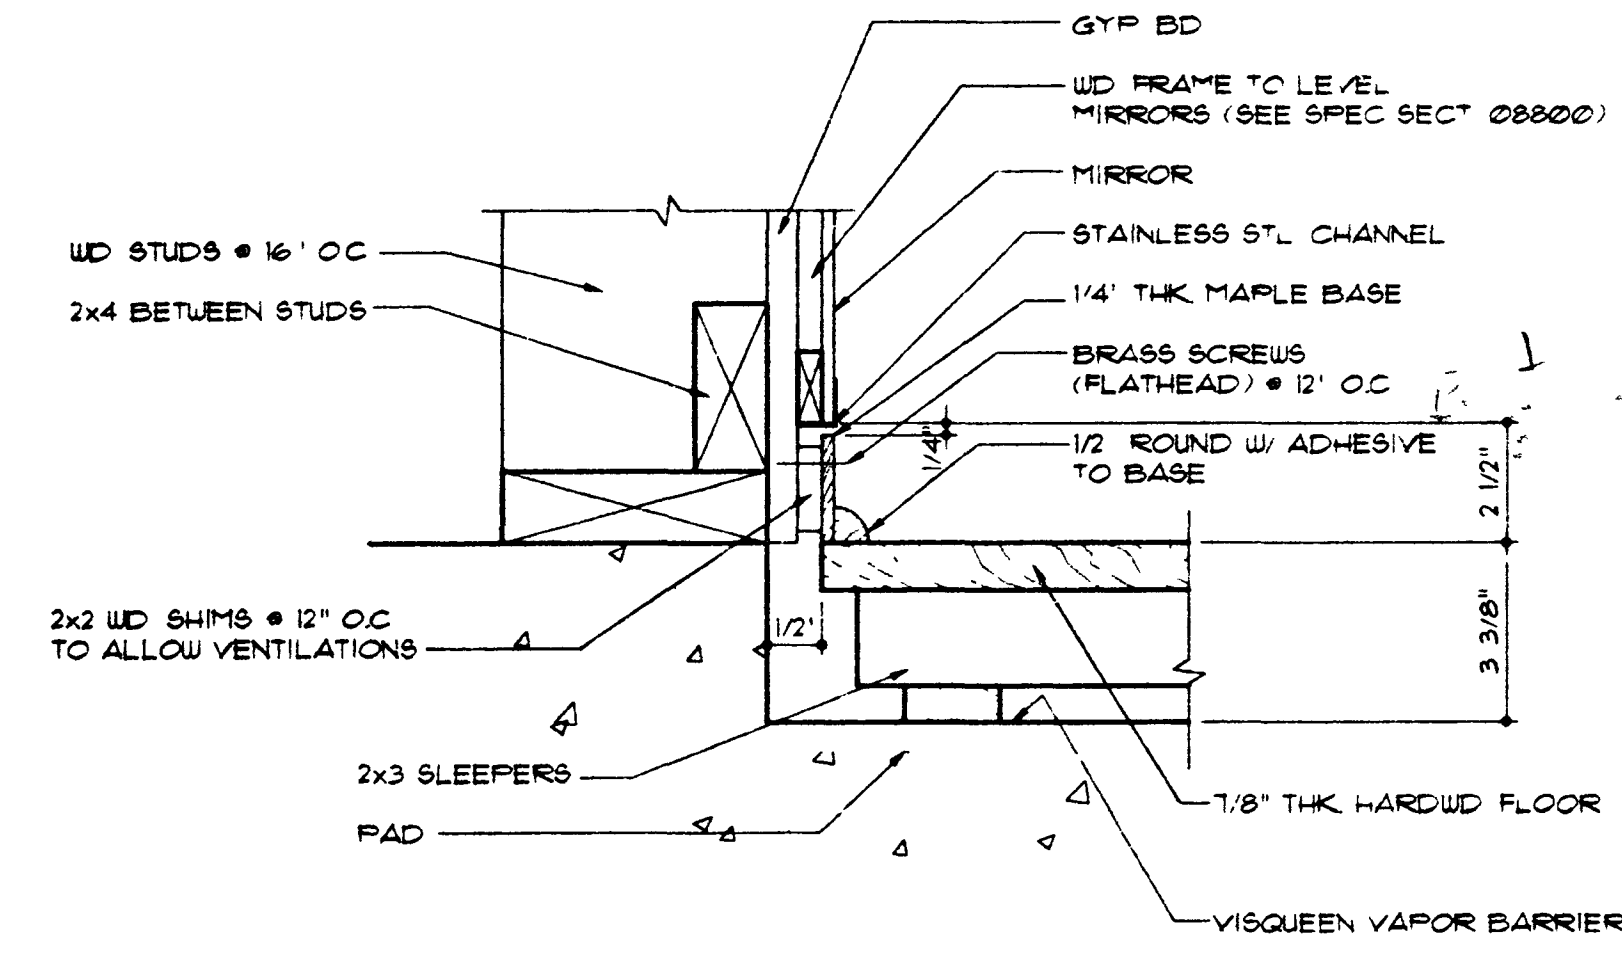


12 WOOD BASE
SCALE: 3" = 1'-0"

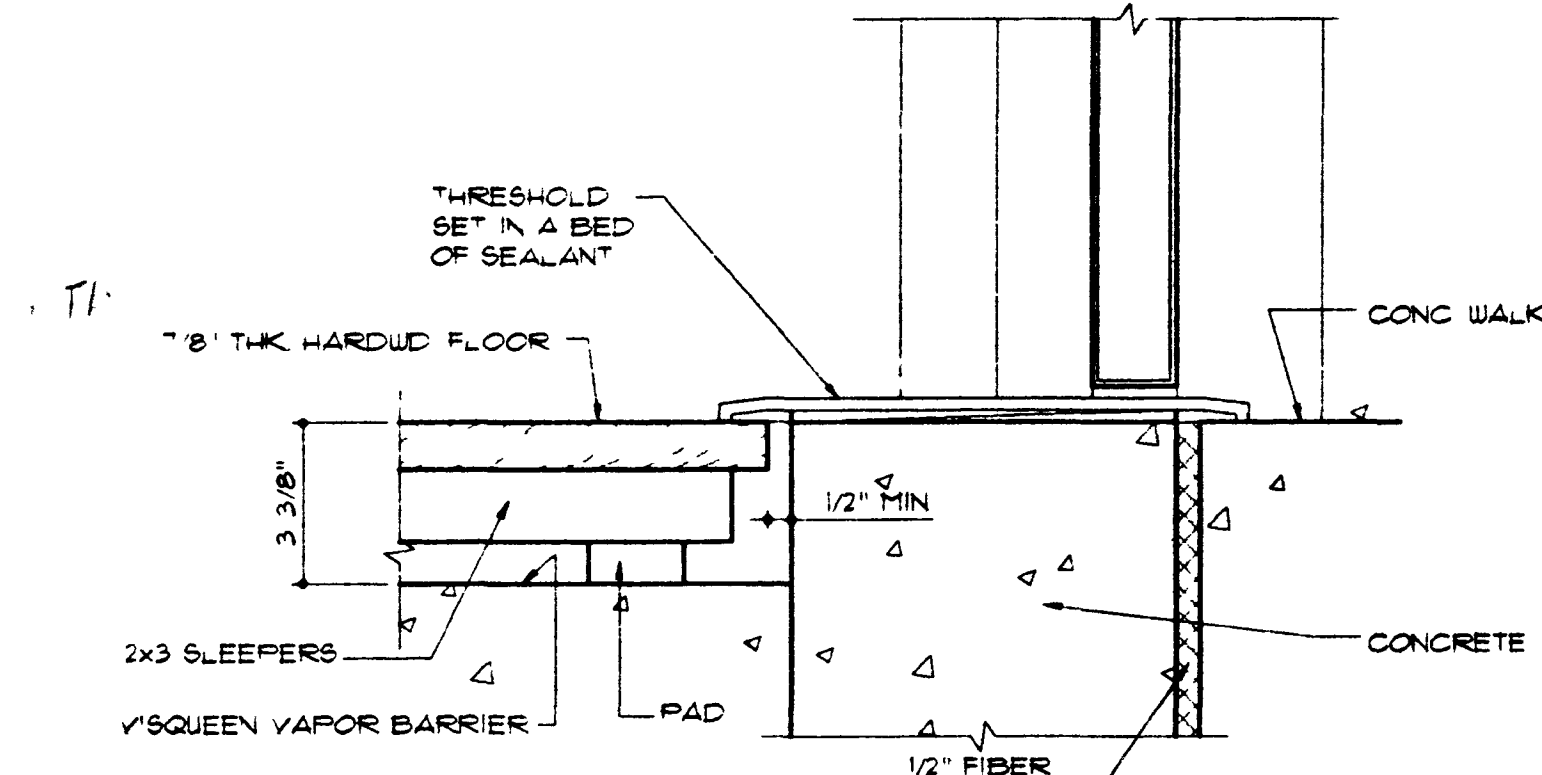


13 THRESHOLD
SCALE: 3" = 1'-0"

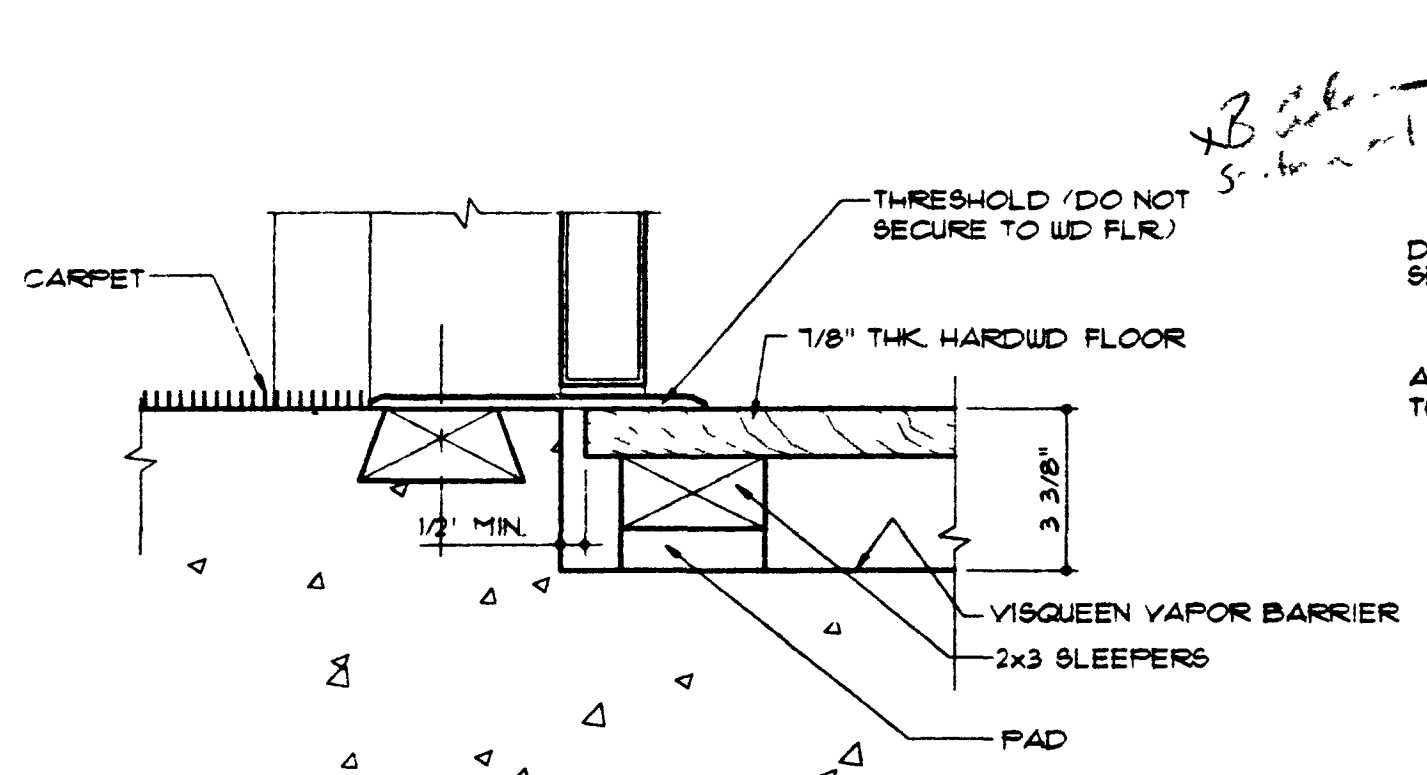


14 THRESHOLD
SCALE: 3" = 1'-0"

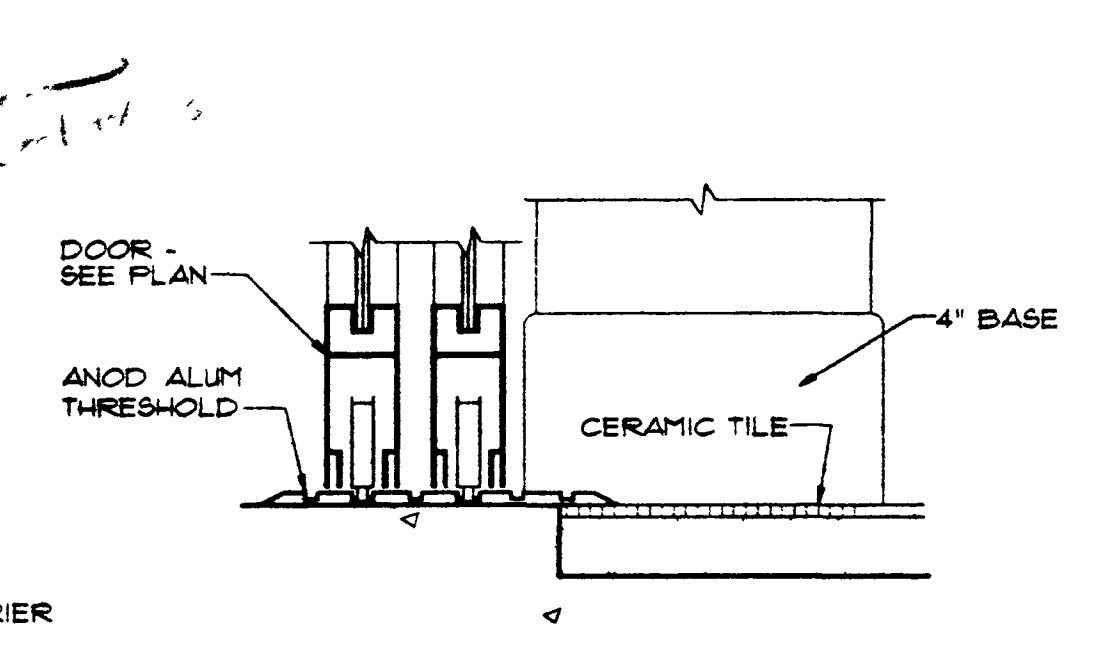


15 THRESHOLD
SCALE: 3" = 1'-0"

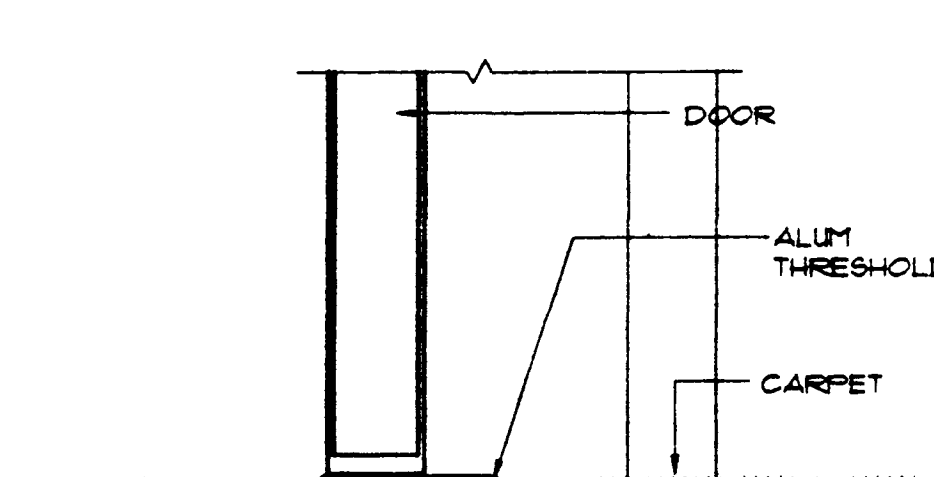


16 THRESHOLD
SCALE: 3" = 1'-0"

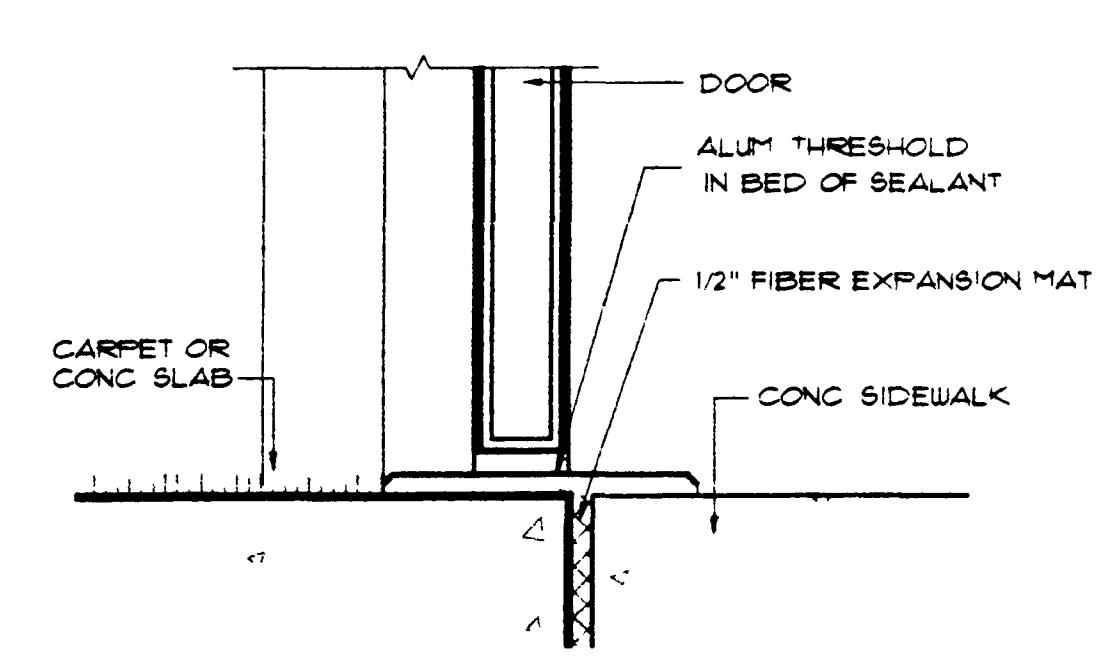


17 THRESHOLD
SCALE: 3" = 1'-0"

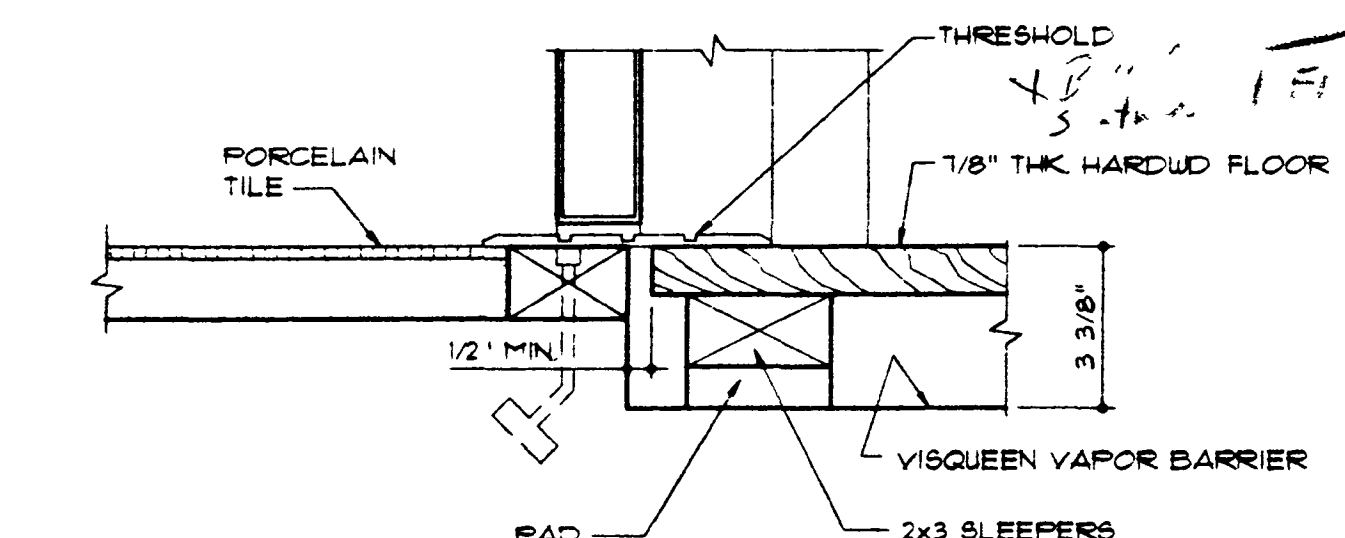

18 THRESHOLD @ TILE
SCALE: 3" = 1'-0"

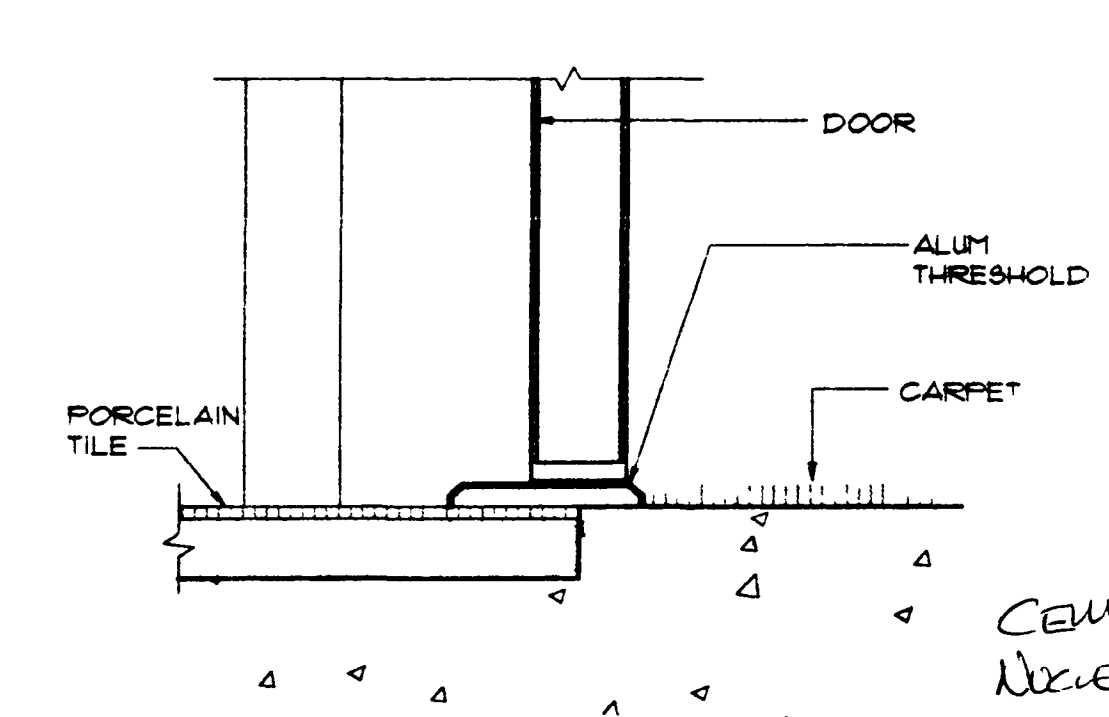

19 THRESHOLD
SCALE: 3" = 1'-0"

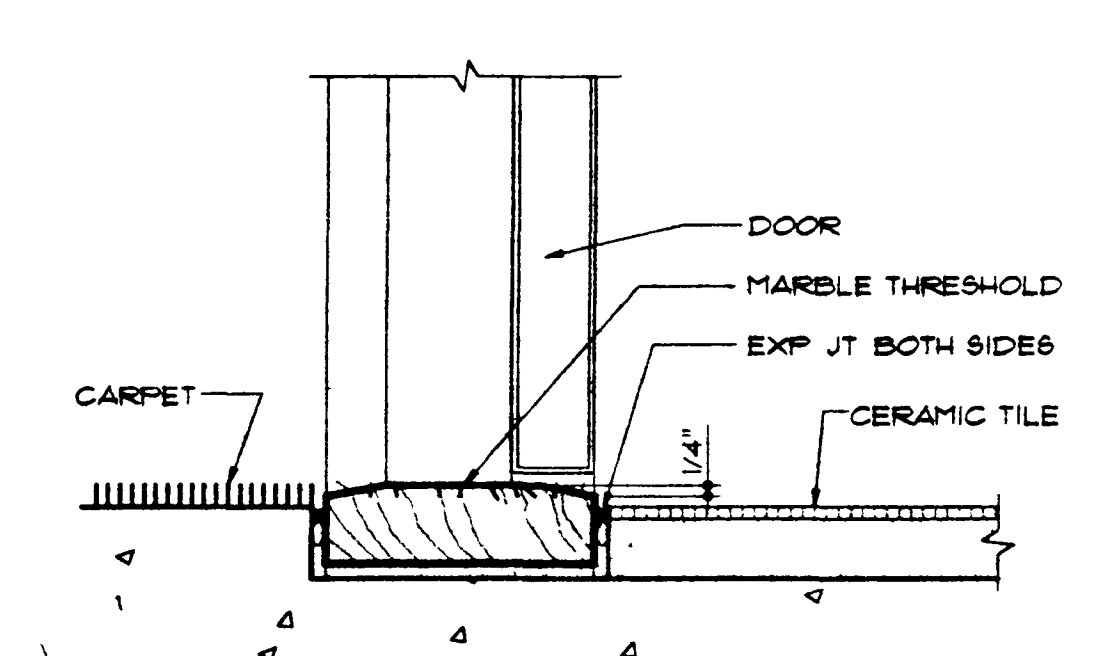


20 THRESHOLD
SCALE: 3" = 1'-0"

Revisions	

Harry Campbell Architects
 1850 First Farmington Road, Suite 120 Las Vegas, NV 89119 (702) 731-0383 Fax (702) 731-9286
 Project: WEST LAS VEGAS ARTS CENTER DOOLITTLE PARK - LAS VEGAS, NEVADA
 Date: 8/12/93
 Drawn By: MHS
 Project No: 92-160
 Scale: 3" = 1'-0"
 Sheet No: A-7.2
 671-46

AS-BUILT
 DOOR & WINDOWS DETAILS

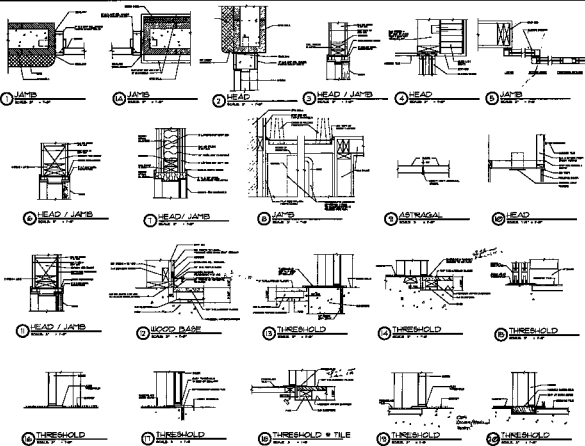

WEST LAS VEGAS ARTS CENTER
DOODLE PARK - LAS VEGAS, NEVADA
DOOR & WINDOW DETAILS

ARCHITECT

DATE: 1/1/78
BY: J. L. B. / J. L. B.

A-12
671-46