




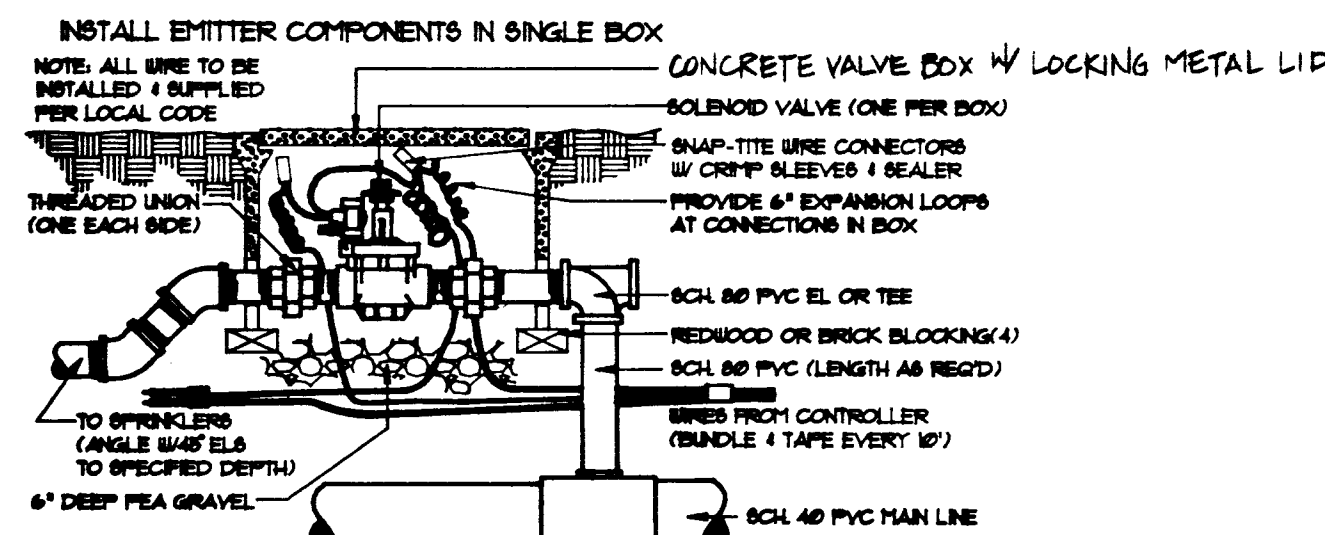


1 REMOTE CONTROL VALVE  
SCALE: NOT TO SCALE

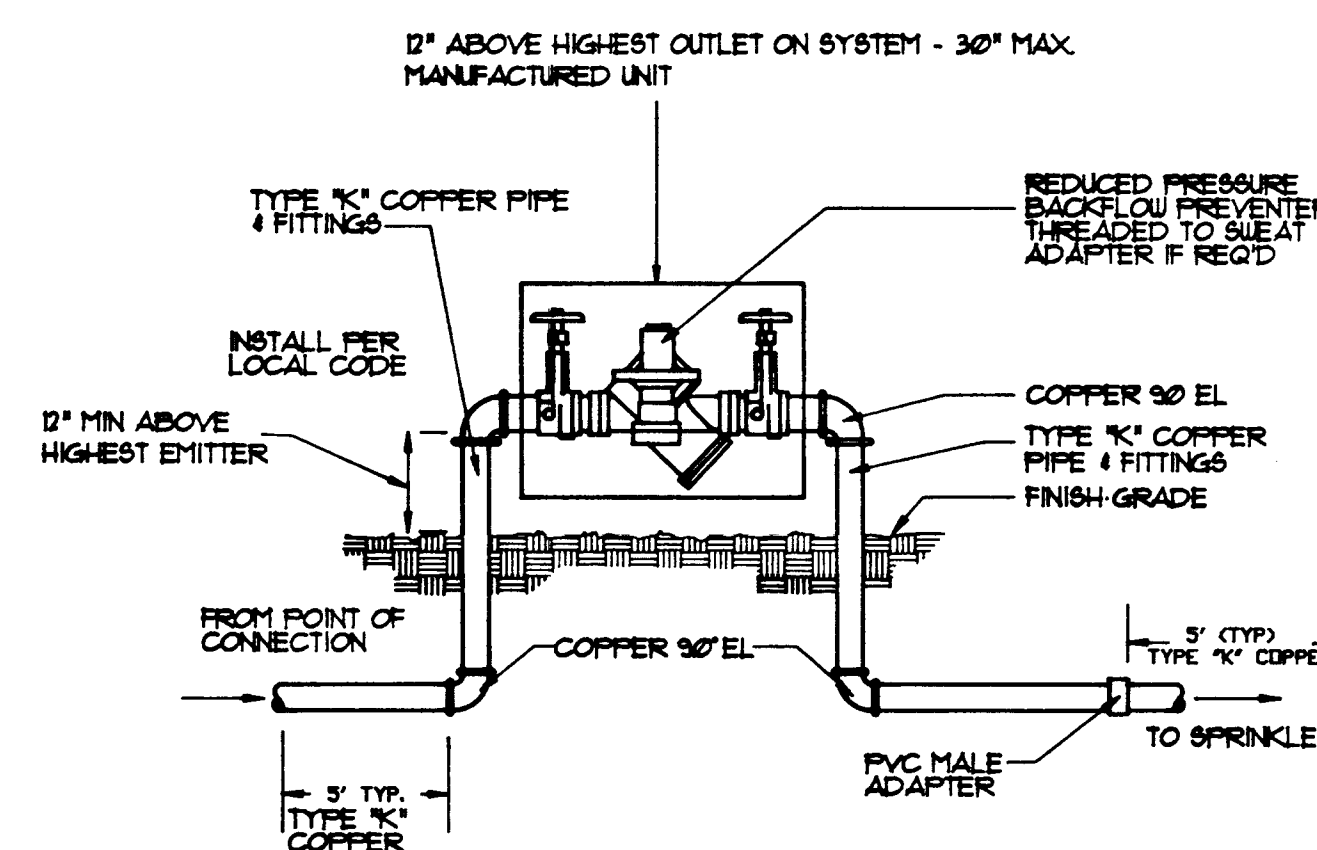


2 BACKFLOW PREVENTER DETAIL  
SCALE: NOT TO SCALE

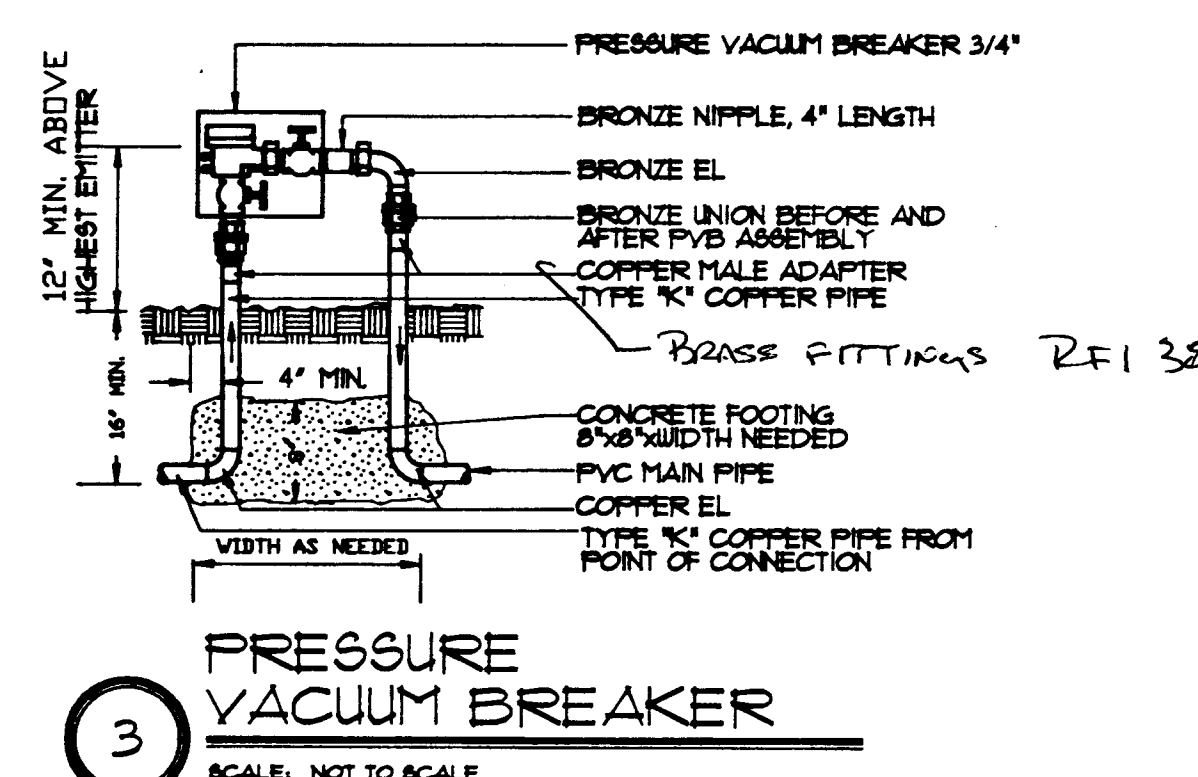


3 PRESSURE VACUUM BREAKER  
SCALE: NOT TO SCALE

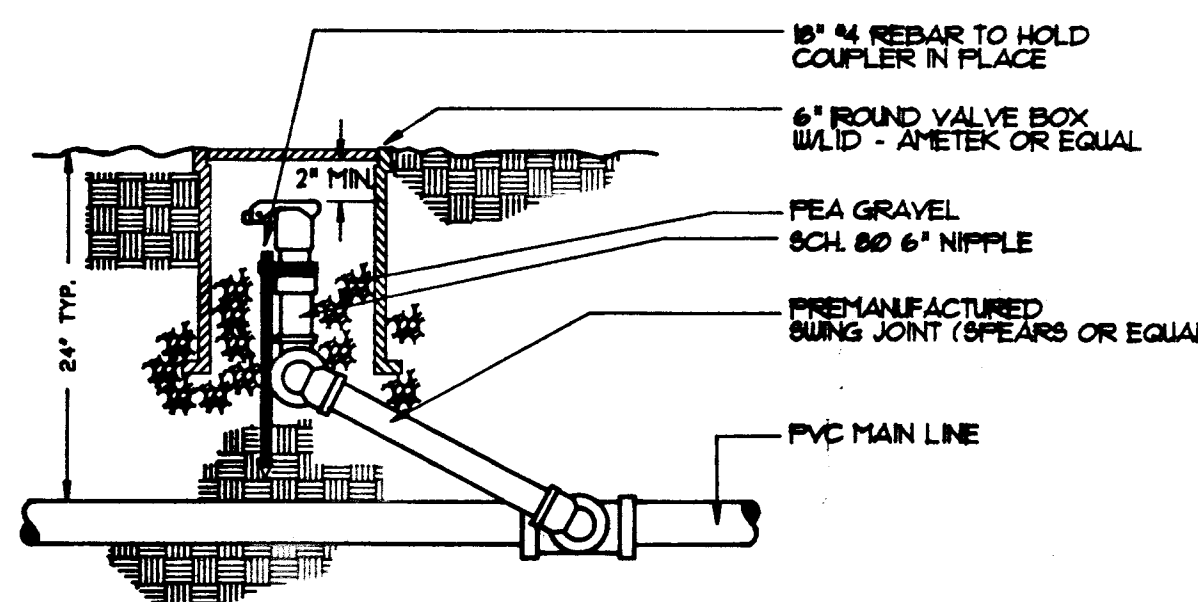


4 QUICK COUPLER DETAIL  
SCALE: NOT TO SCALE

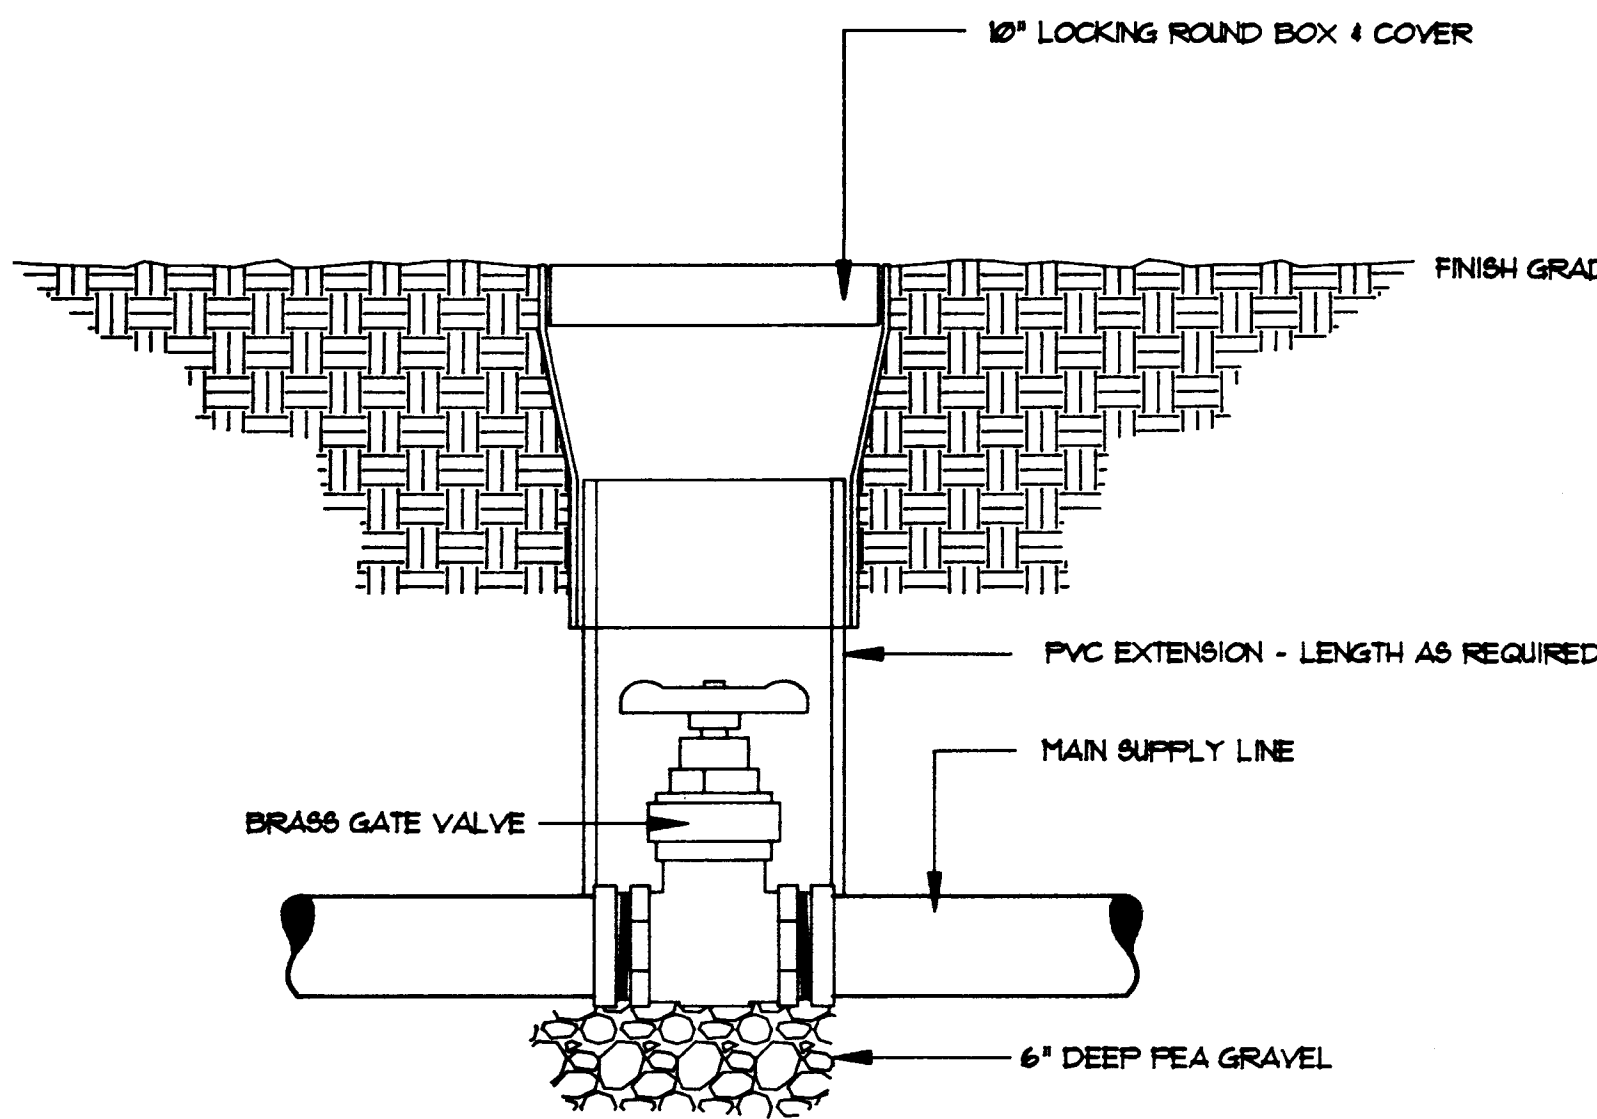


5 GATE VALVE DETAIL  
SCALE: NOT TO SCALE

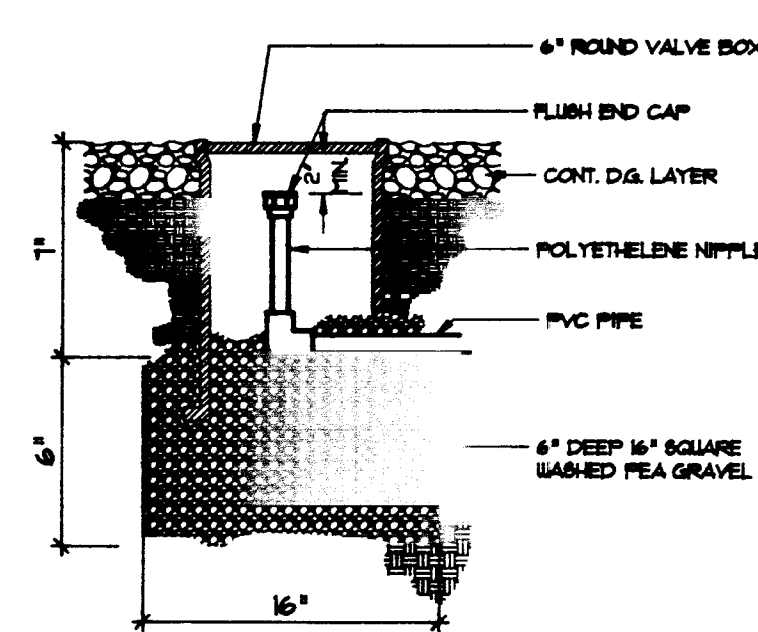


6 FLUSH END/CAP  
SCALE: NOT TO SCALE

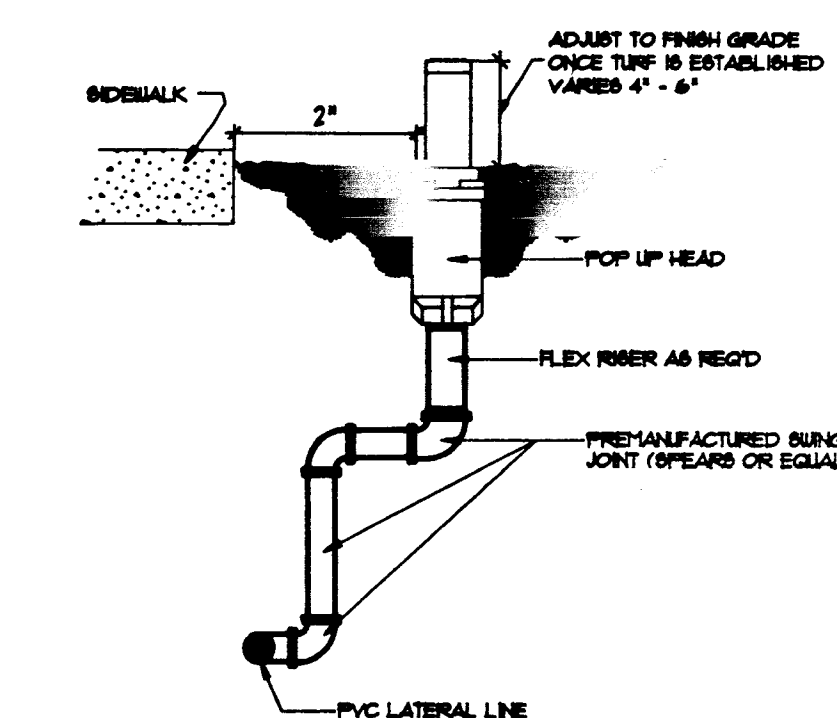


7 LAWN HEAD  
SCALE: NOT TO SCALE

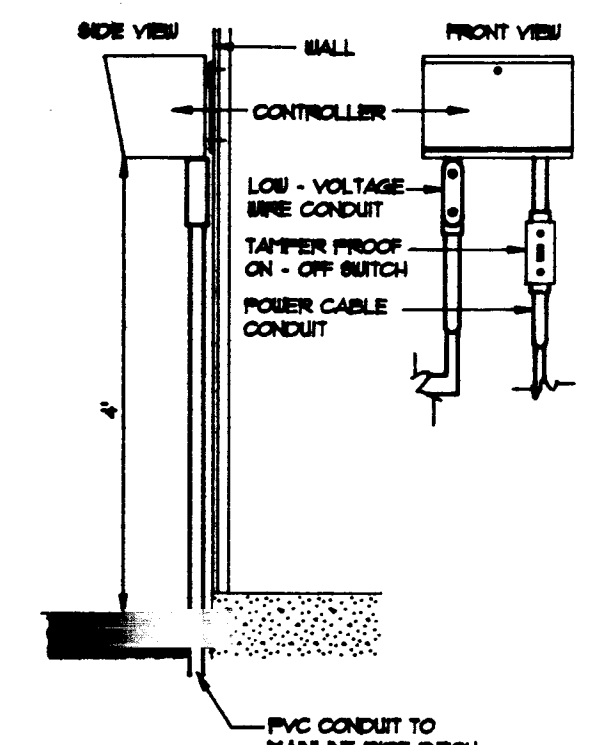


8 WALL MOUNTED IRRIGATION CONTROLLER  
SCALE: NOT TO SCALE

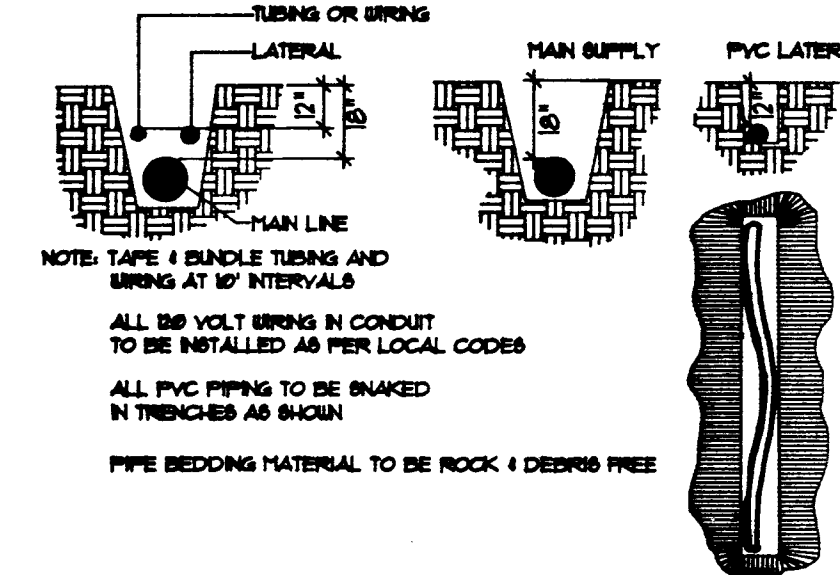


9 TRENCH DETAIL  
SCALE: NOT TO SCALE

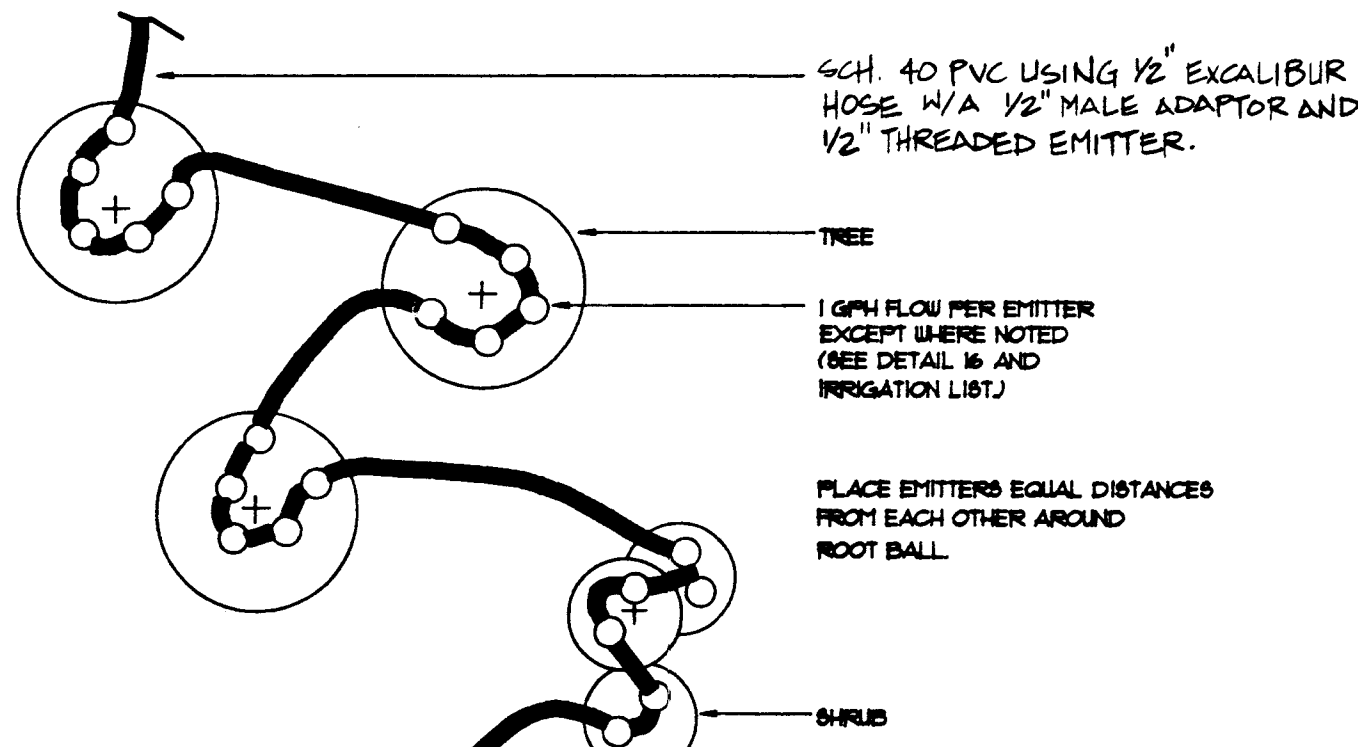


10 DRIP EMITTER LAYOUT (BUTTON TYPE)  
SCALE: NOT TO SCALE

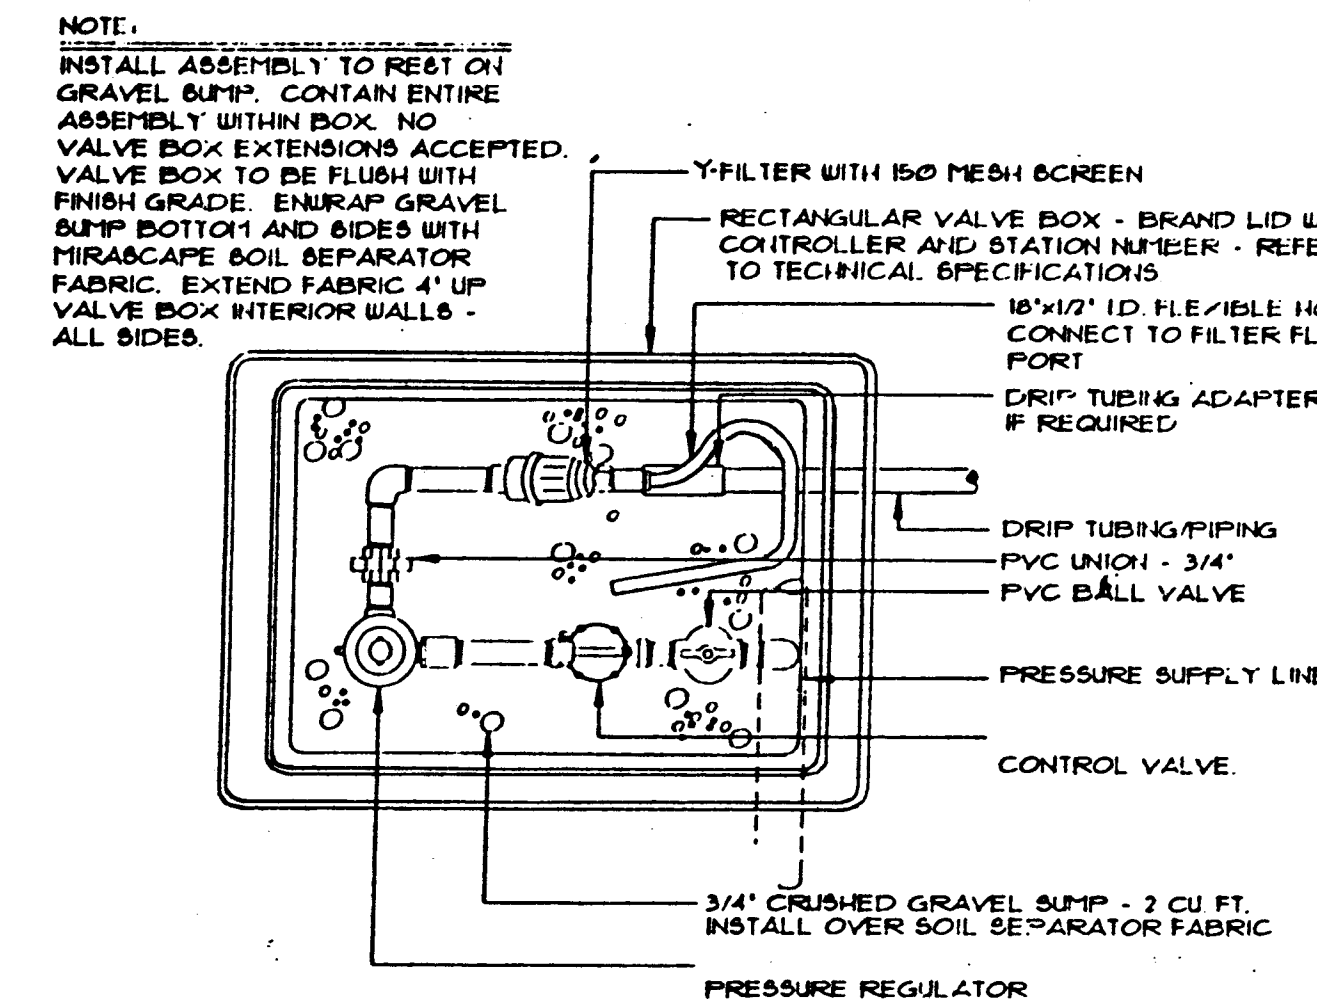


11 DRIP VALVE ASSEMBLY  
SCALE: NOT TO SCALE

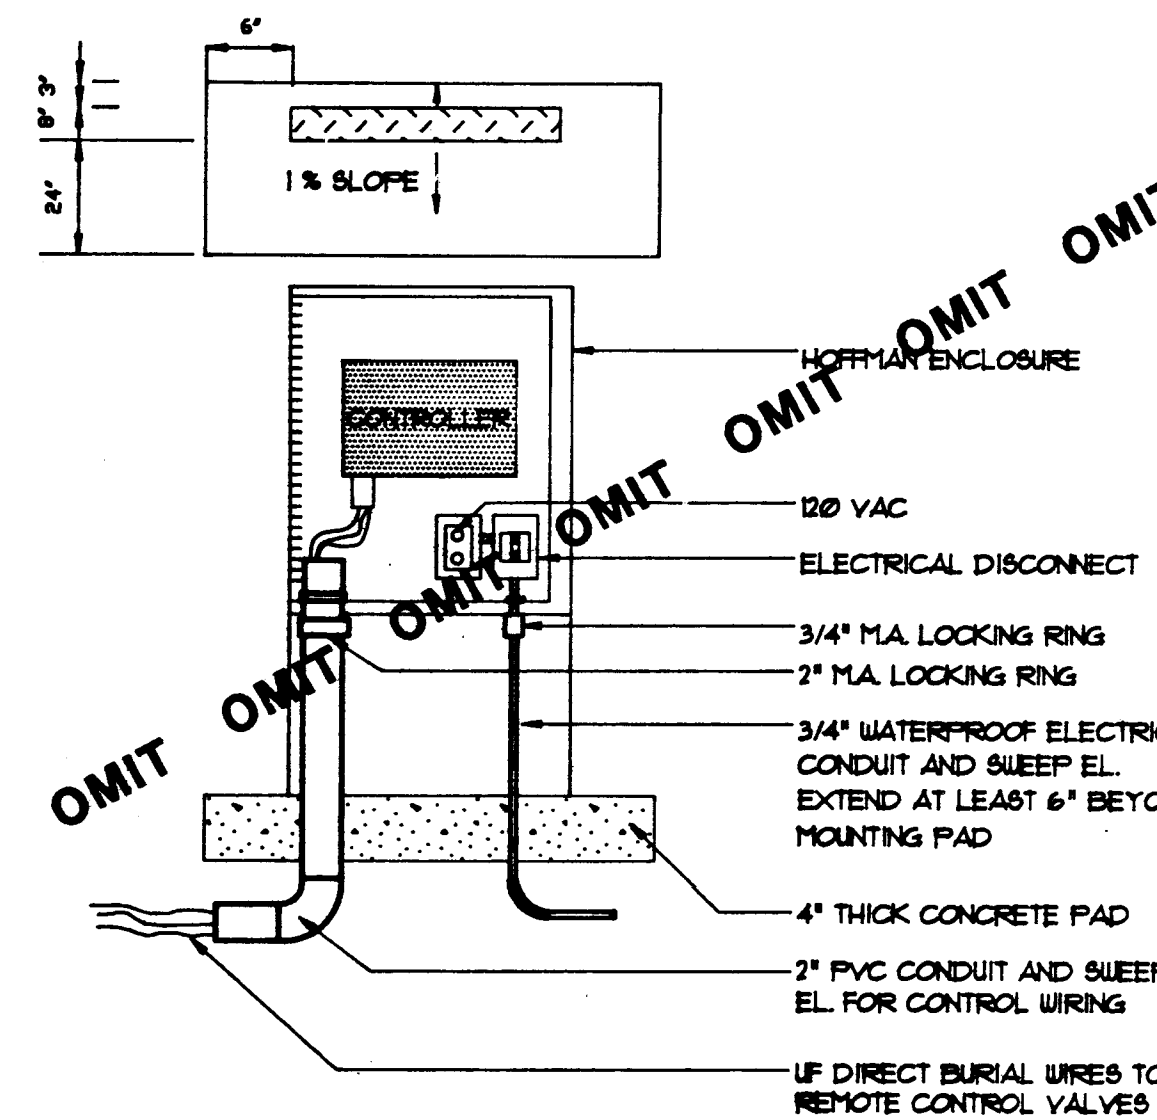


12 IRRIGATION CONTROLLER CABINET  
SCALE: NOT TO SCALE

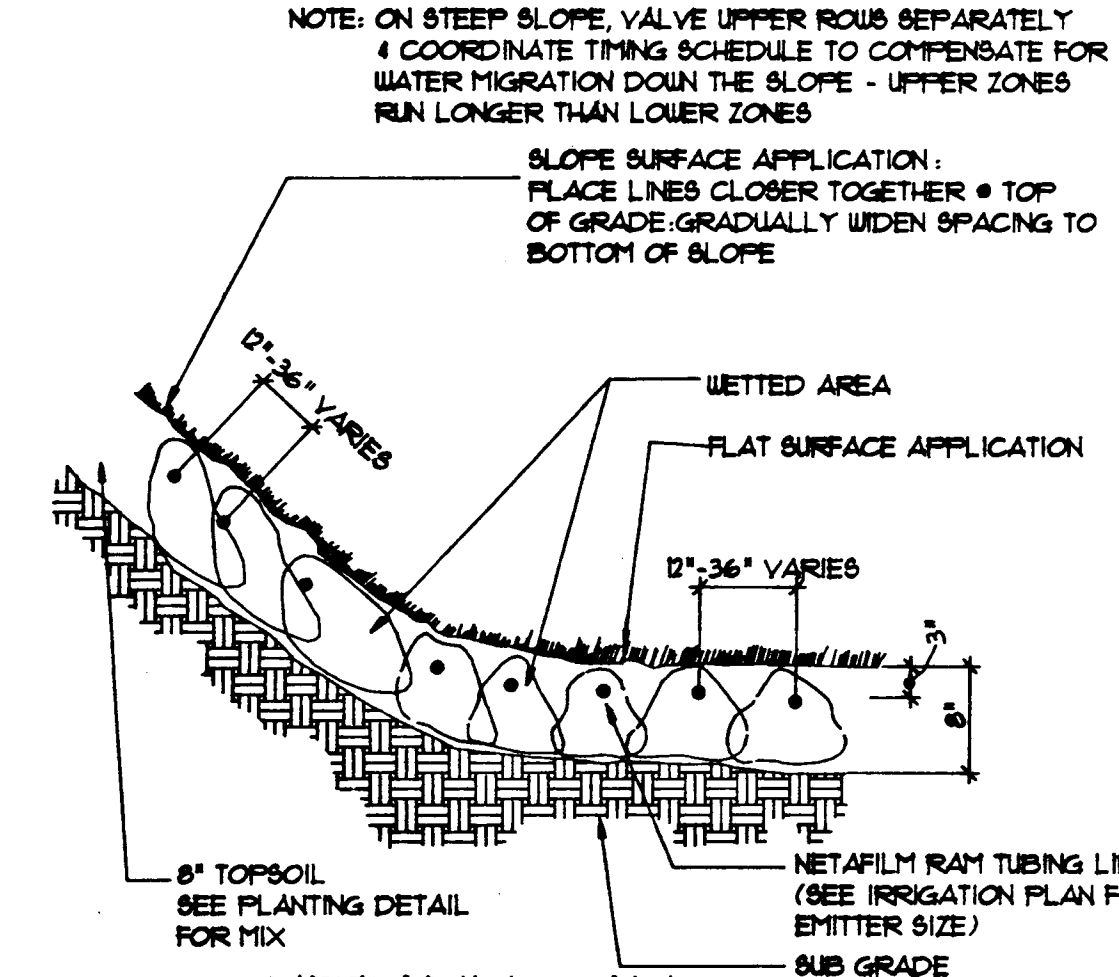

13 NETAFIM RAM TUBING DRIPLINE  
SCALE: NOT TO SCALE

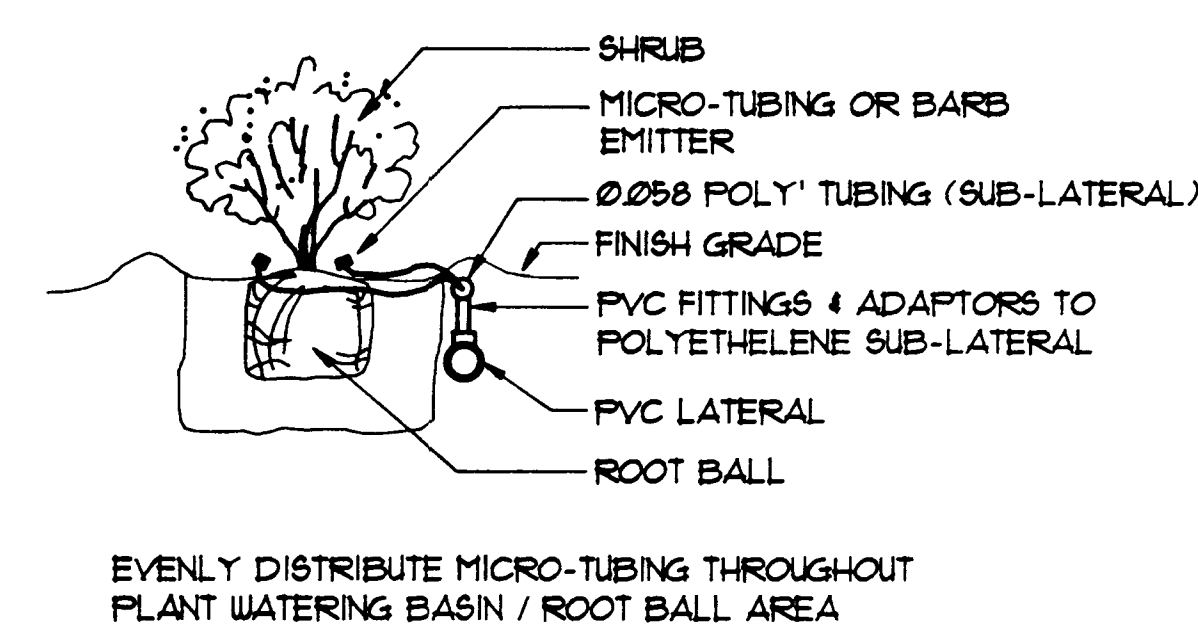

14 SINGLE SHRUB EMITTER DETAIL  
SCALE: NOT TO SCALE

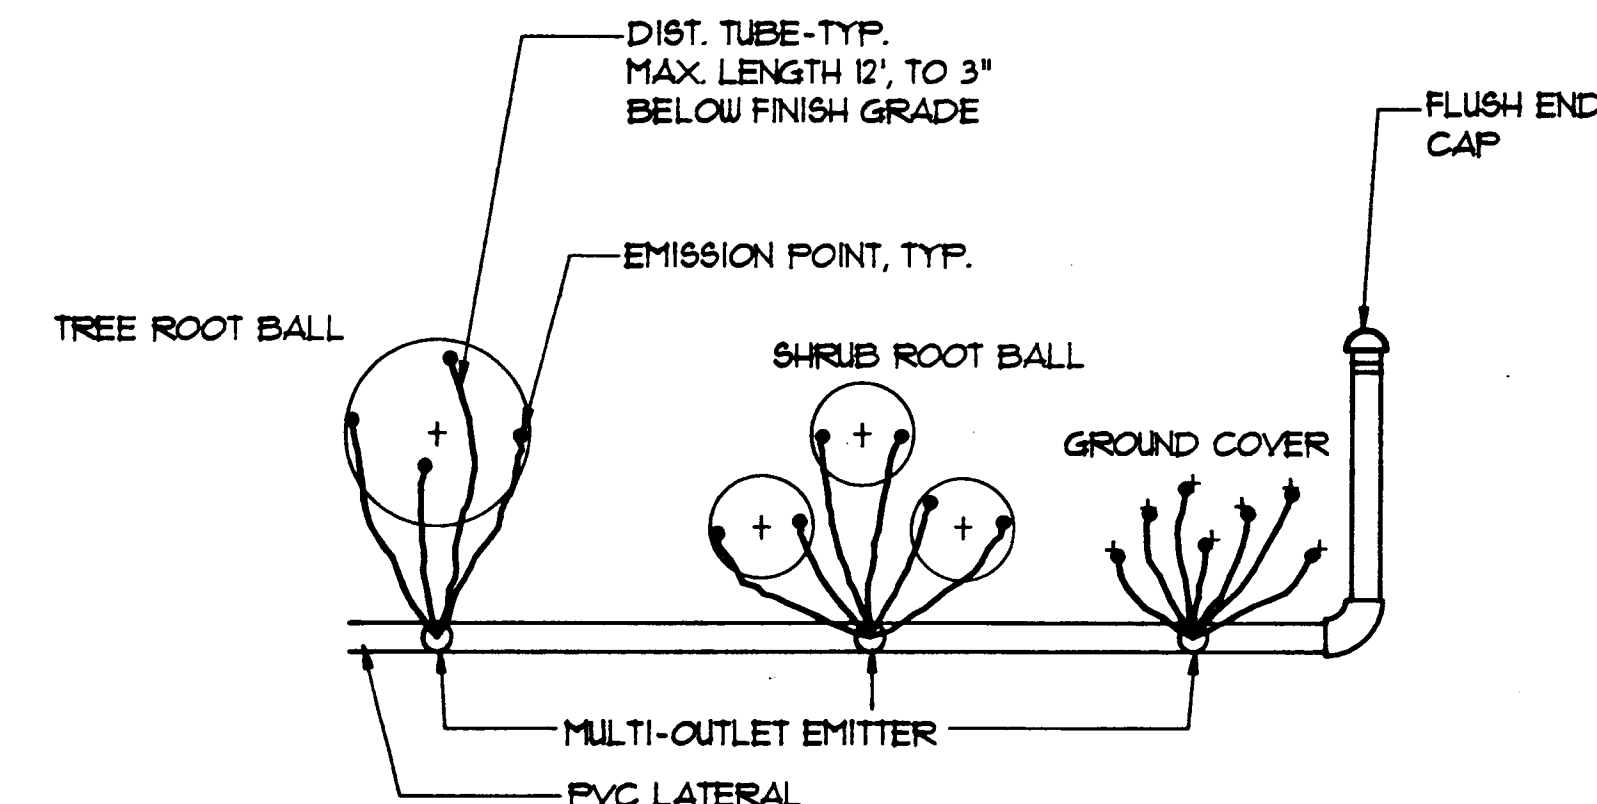


15 EMITTER PLACEMENT DETAIL  
SCALE: NOT TO SCALE

| PLANT SIZE | * OF EMITTERS (1 GAL.) |
|------------|------------------------|
| 1 GAL.     | 1                      |
| 5 GAL.     | 1 - 2 (VARIES)         |
| 15 GAL.    | 2                      |
| 24" BOX    | 4                      |
| 36" BOX    | 6                      |
| 48" BOX    | 8                      |
| 60" BOX    | 10                     |
| 72" BOX    | 12                     |

16 EMITTER SCHEDULE  
SCALE: NOT TO SCALE

Harry Campbell Architects  
1050 East Flamingo Road, Suite 120, Las Vegas, NV 89119 (702) 731-0000 Fax (702) 731-0006  
These drawings, or instruments of service, are and shall remain the property of Harry Campbell Architects, Inc. and shall not be reproduced without the written consent of Harry Campbell Architects, Inc.

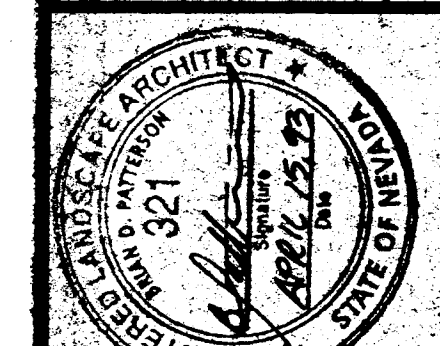

WEST LAS VEGAS ARTS CENTER  
DOOLITTLE PARK - LAS VEGAS, NEVADA  
IRRIGATION DETAILS  
**As-Built**

Drawn By: [Signature]  
Checked By: [Signature]  
Date: 3/29/95

