




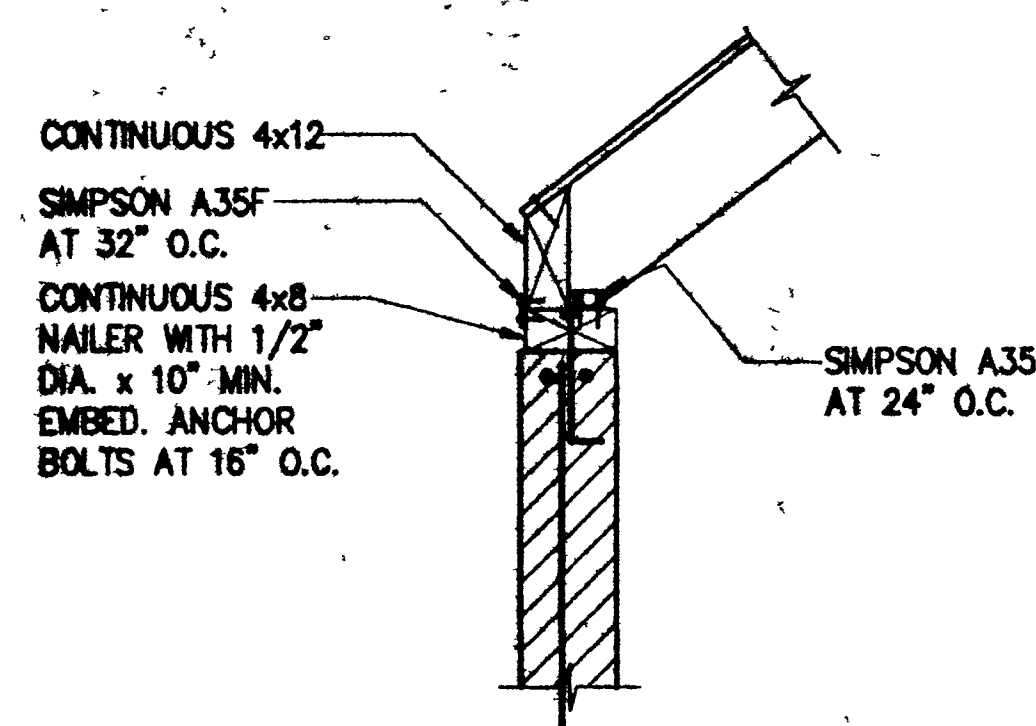


SECTION 1
3/4"=1'-0"

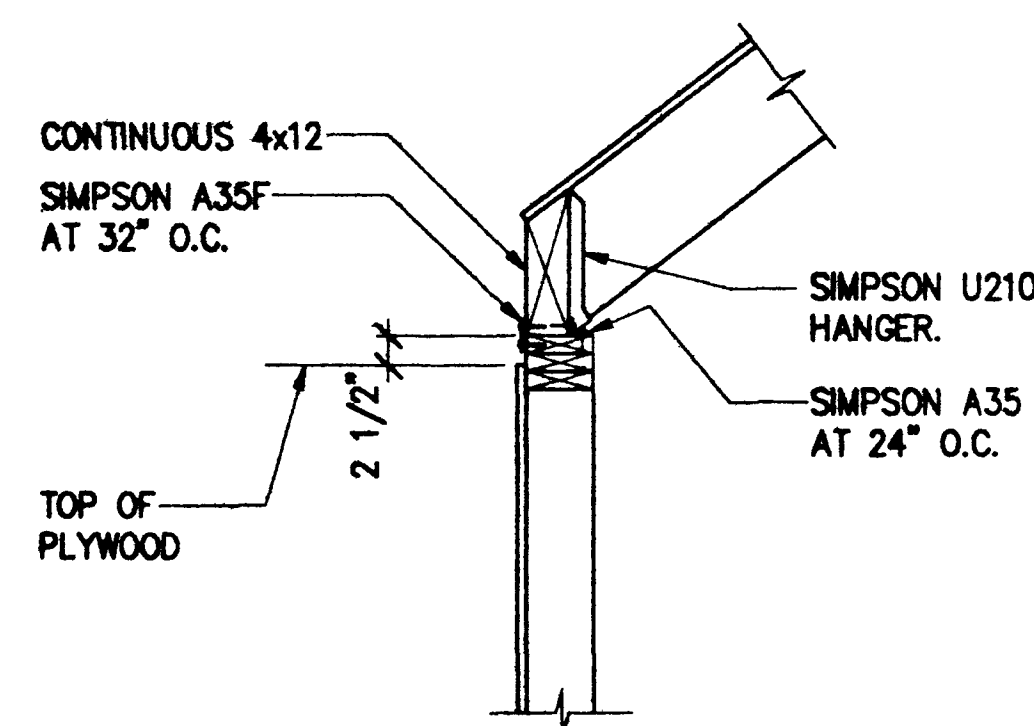


SECTION 2
3/4"=1'-0"

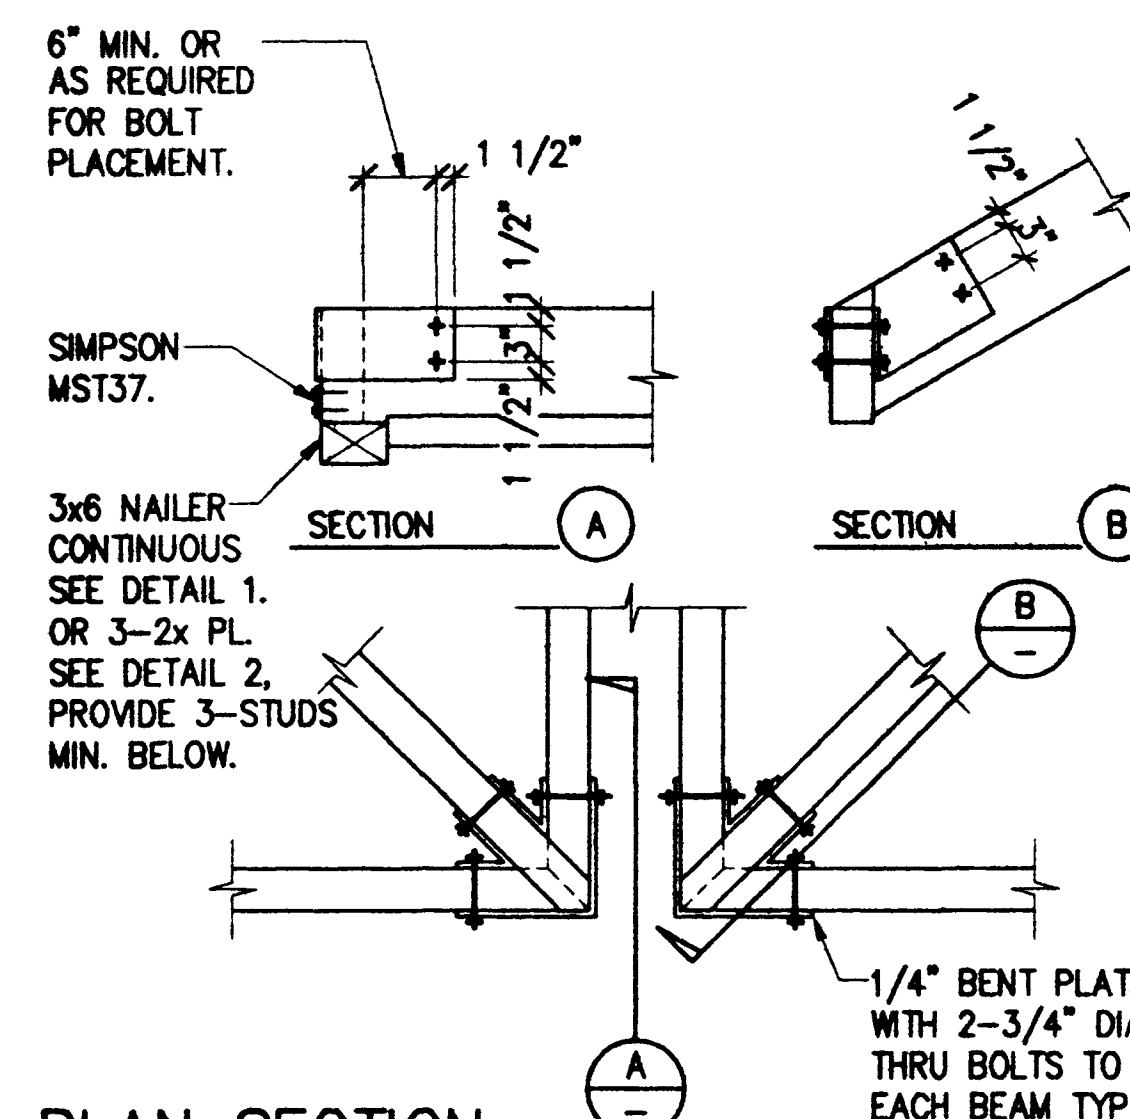


PLAN SECTION 3
3/4"=1'-0"

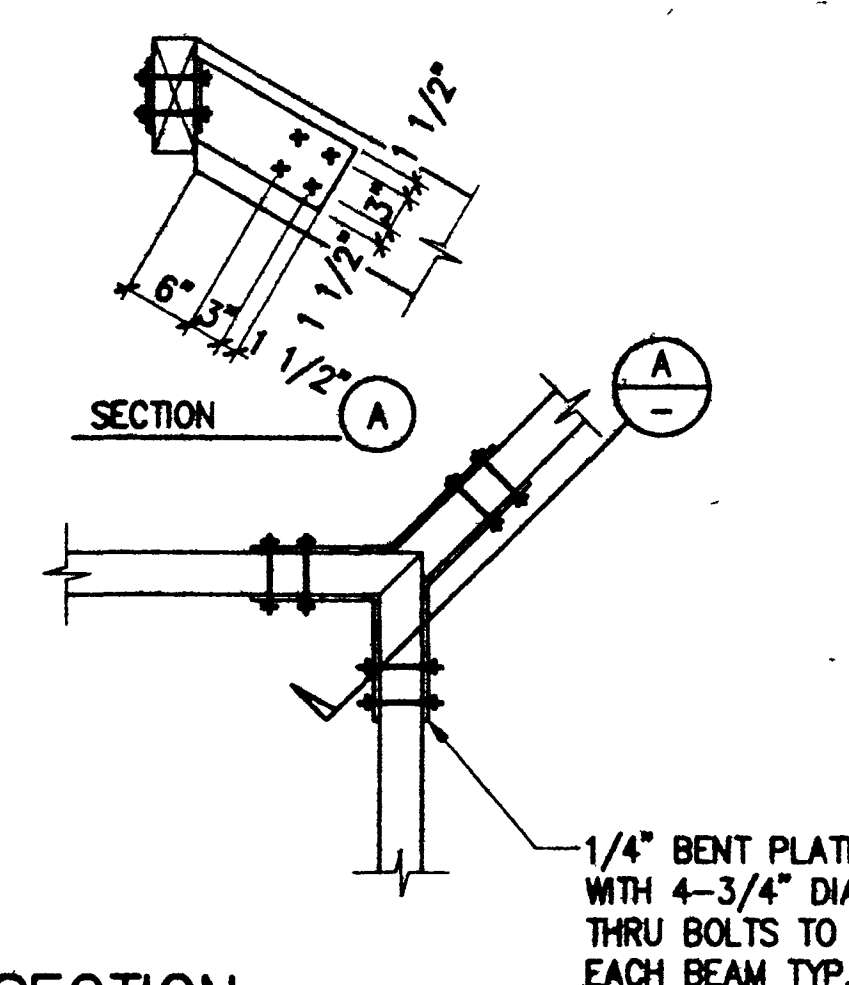


PLAN SECTION 4
3/4"=1'-0"

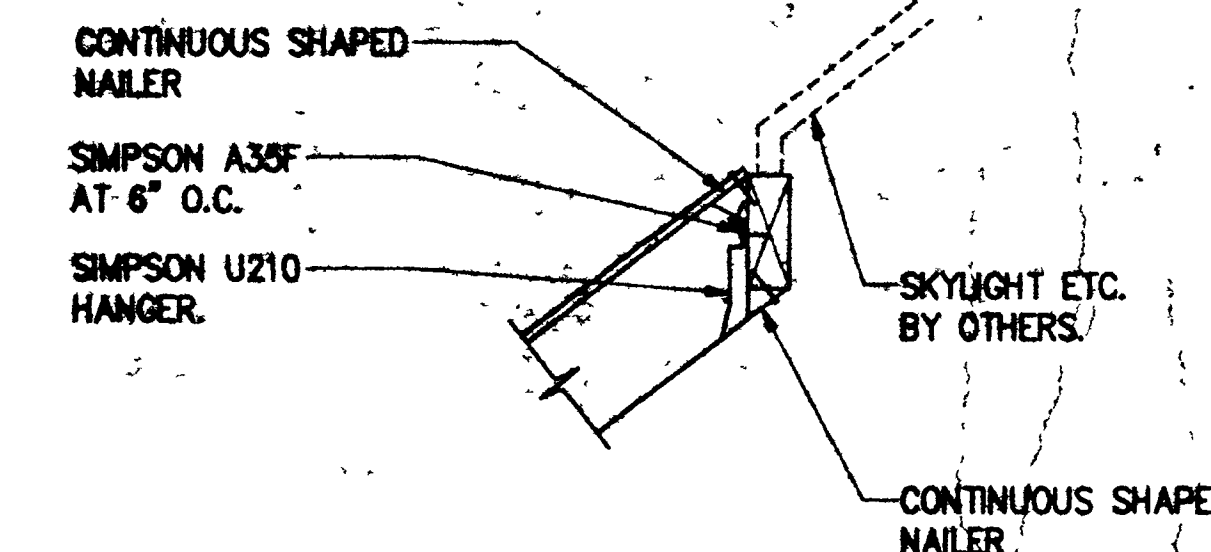


SECTION 5
3/4"=1'-0"

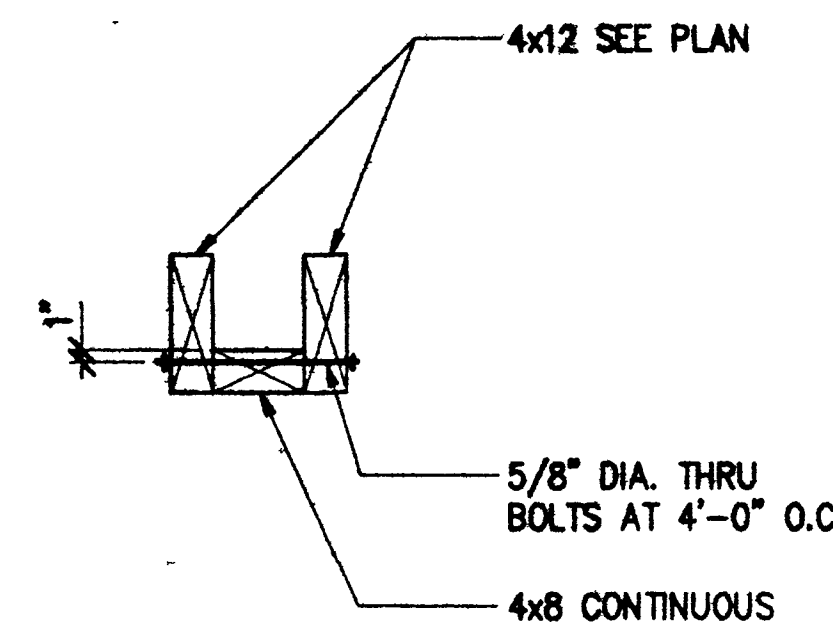


SECTION 6
3/4"=1'-0"

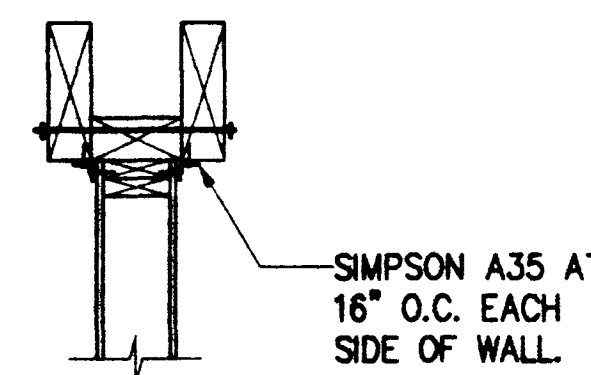


SECTION 7
3/4"=1'-0"

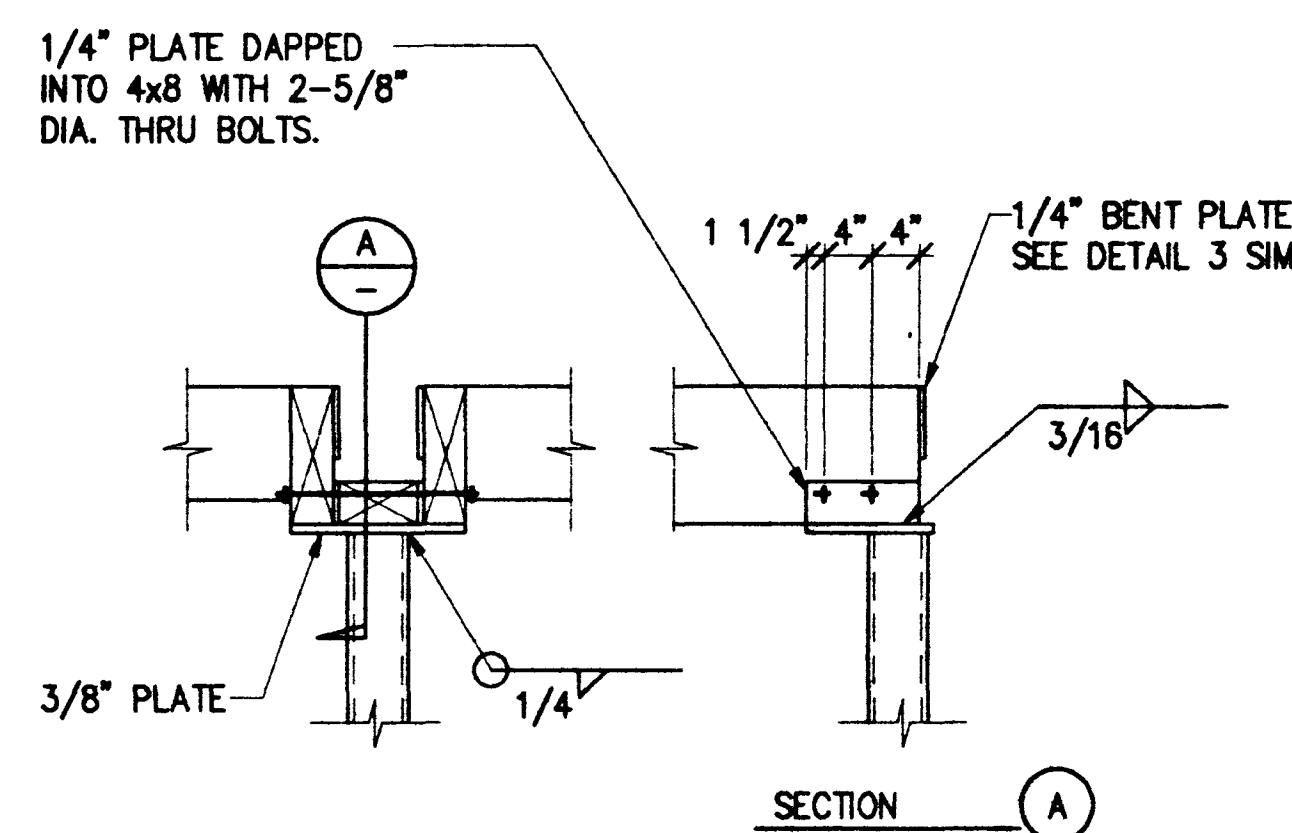


SECTION 8
3/4"=1'-0"

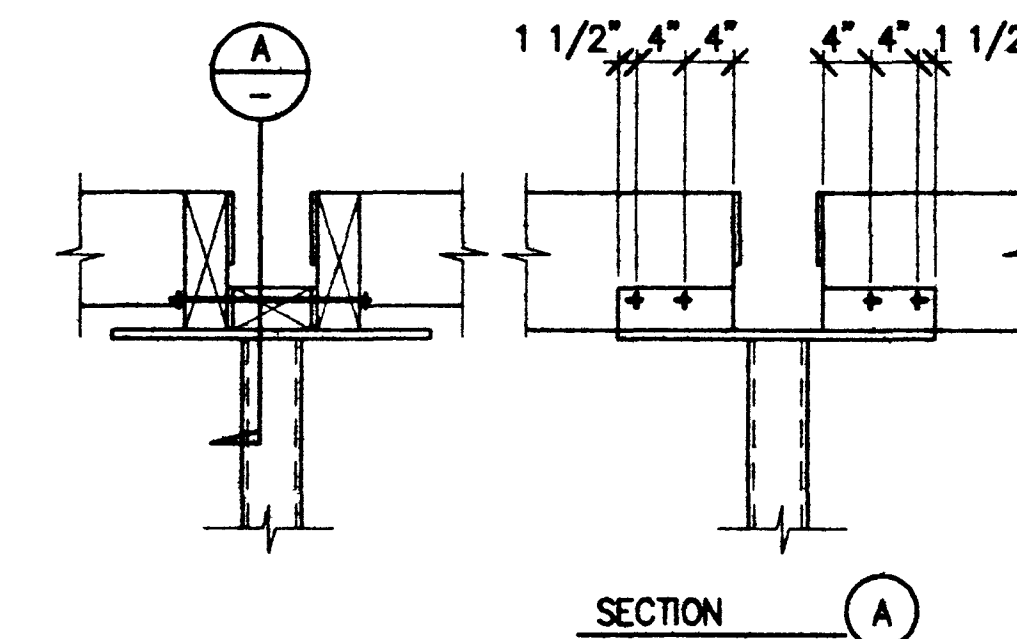


SECTION 9
3/4"=1'-0"

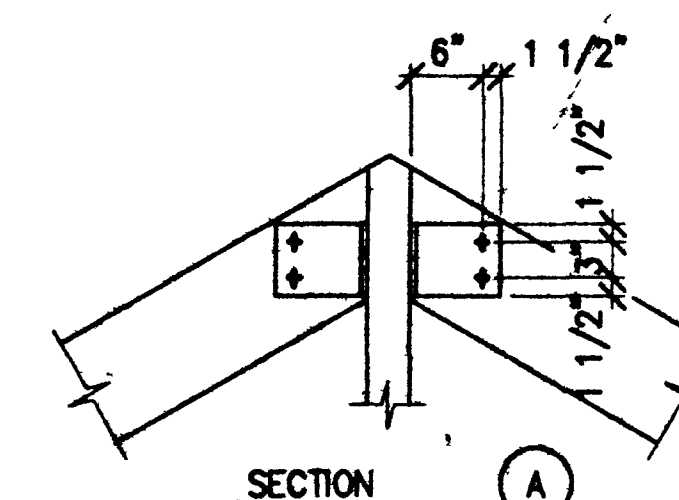


SECTION 10
3/4"=1'-0"

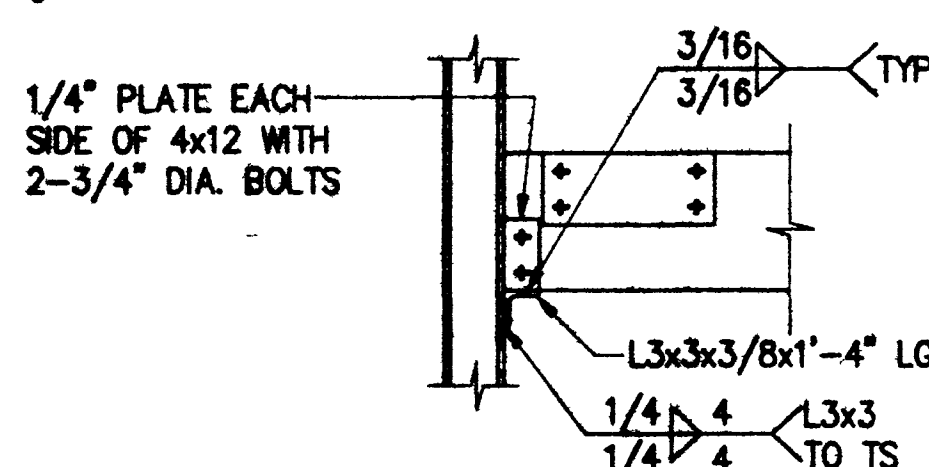


SECTION 11
3/4"=1'-0"

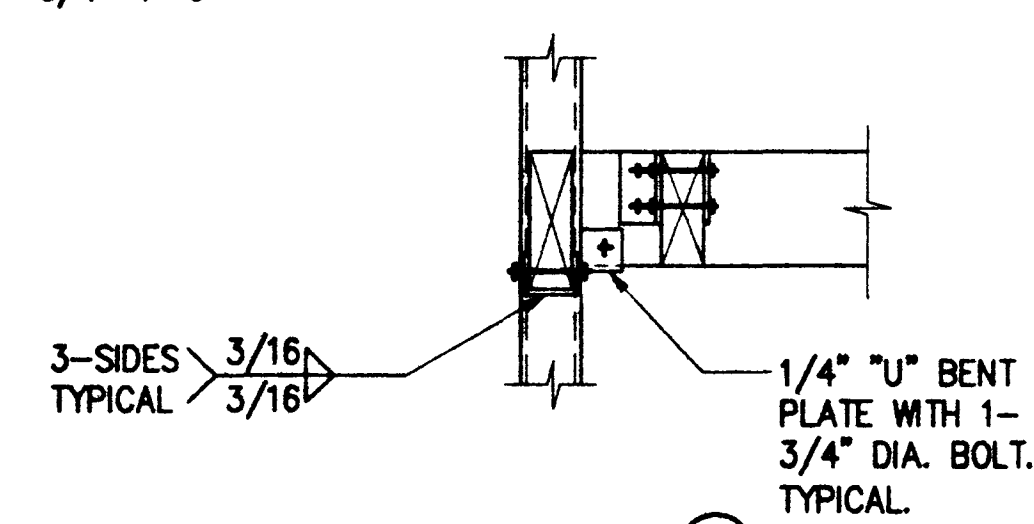


SECTION 12
3/4"=1'-0"

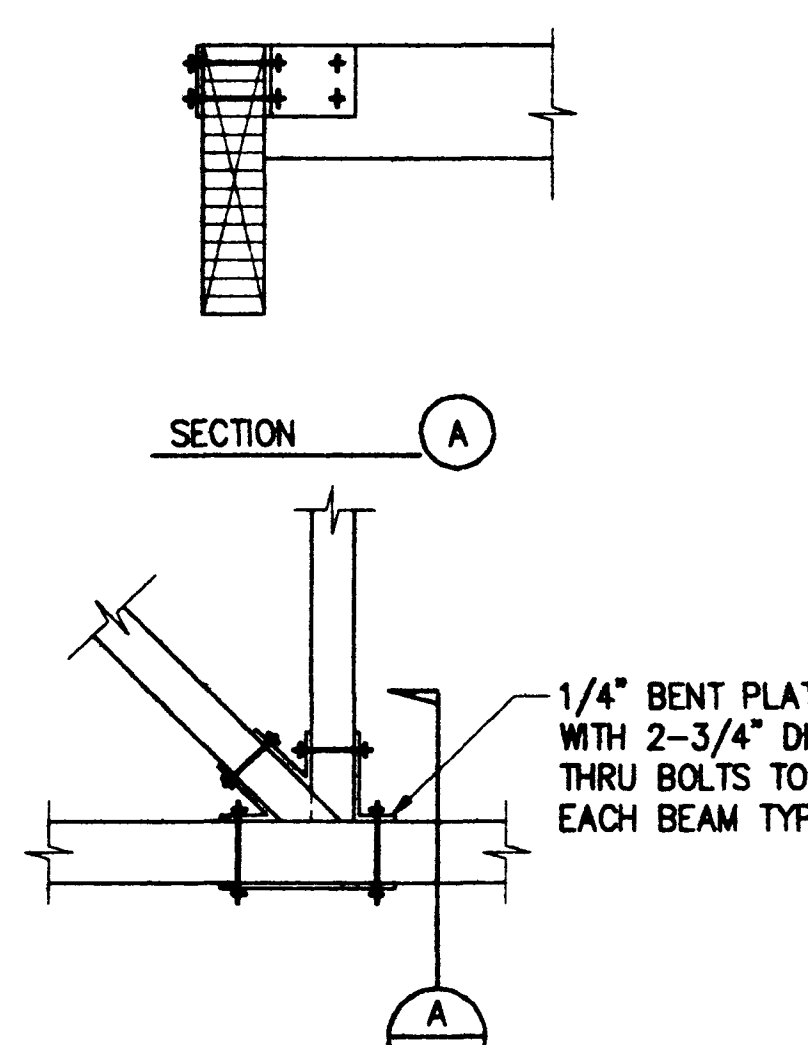


SECTION 13
3/4"=1'-0"

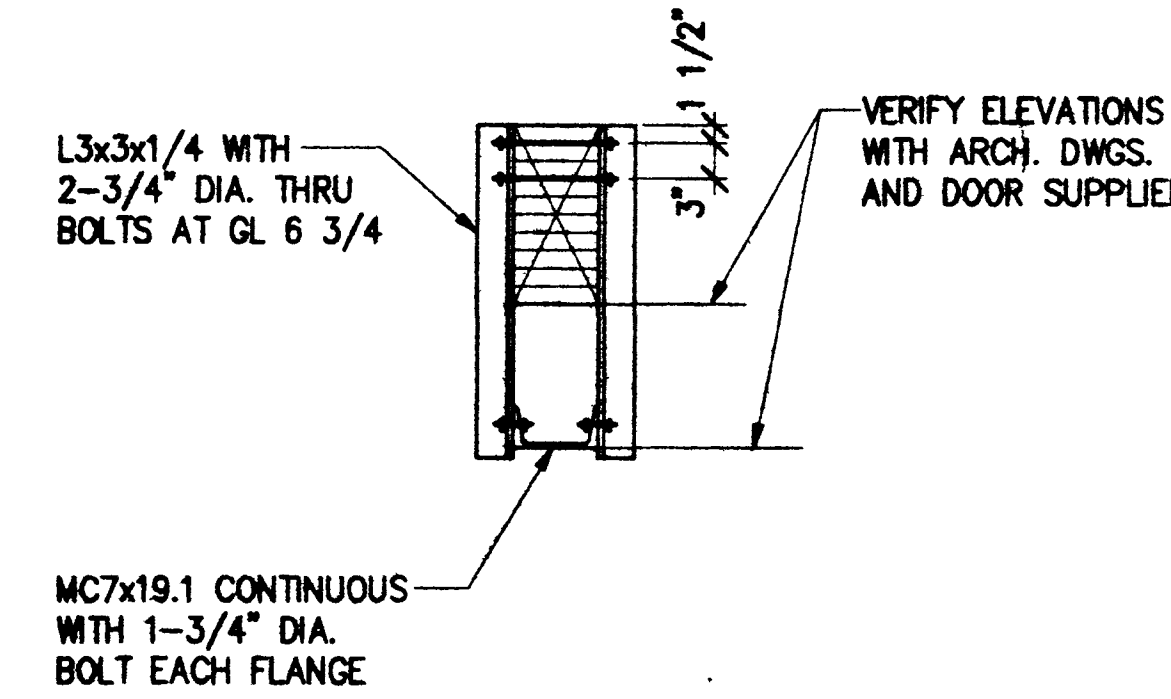


SECTION 14
3/4"=1'-0"

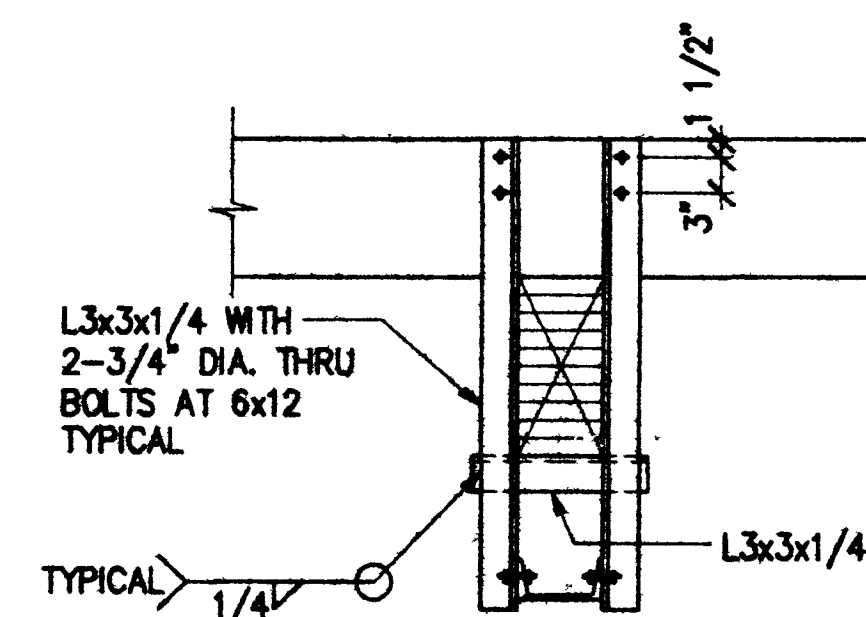


SECTION 15
3/4"=1'-0"

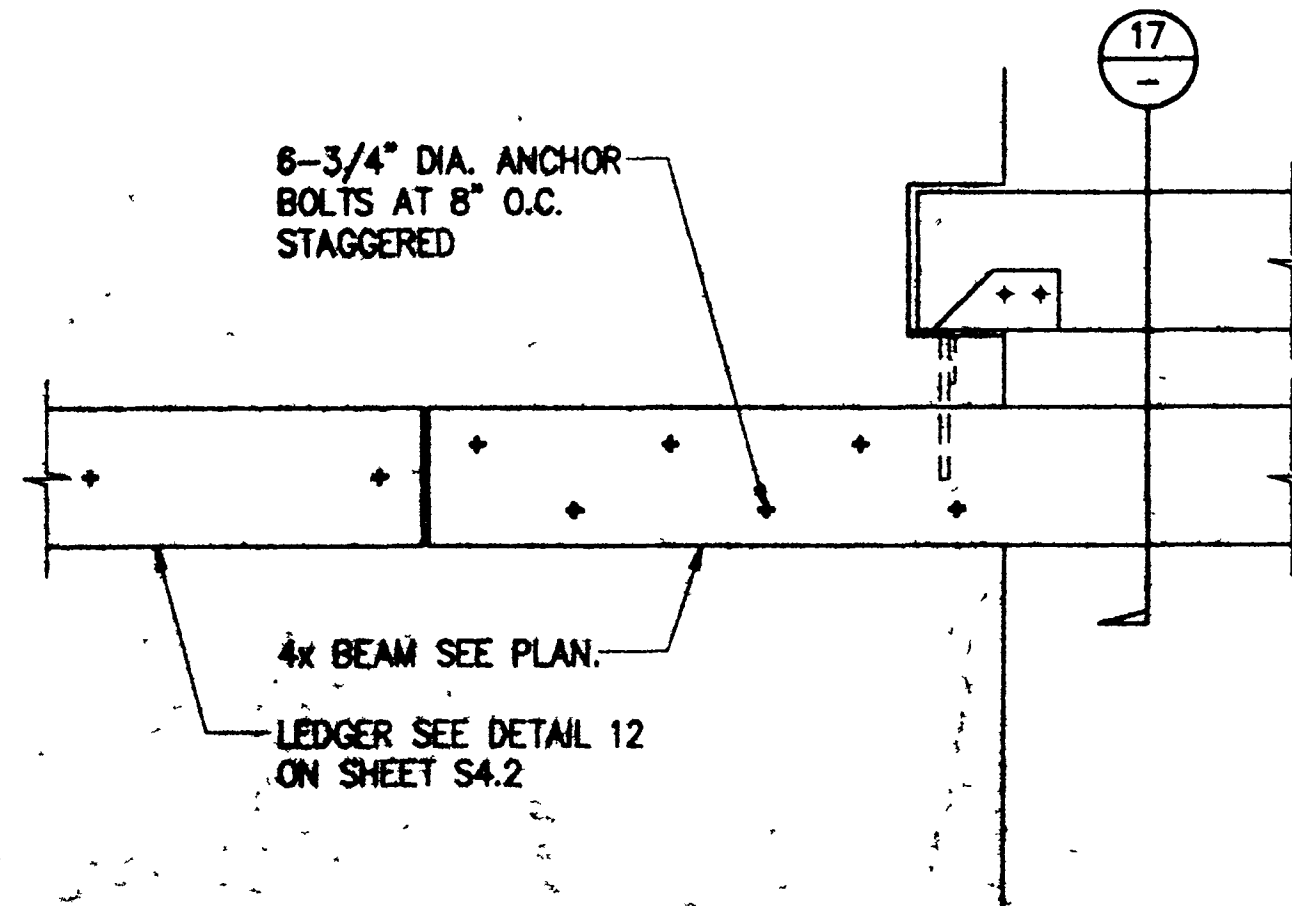


SECTION 16
3/4"=1'-0"

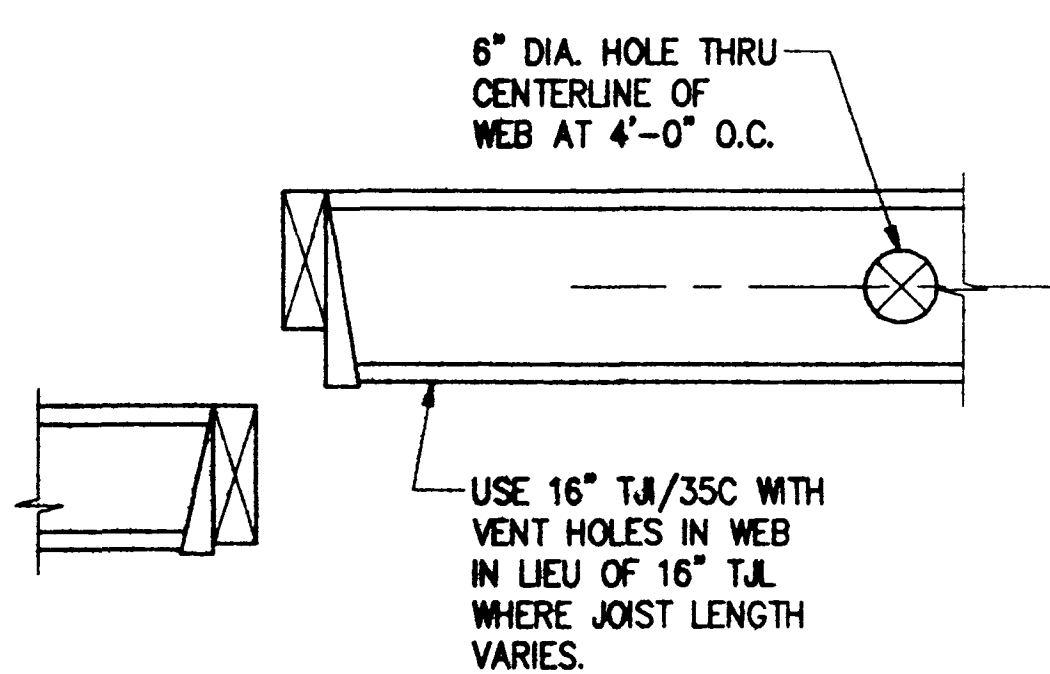


SECTION 17
3/4"=1'-0"

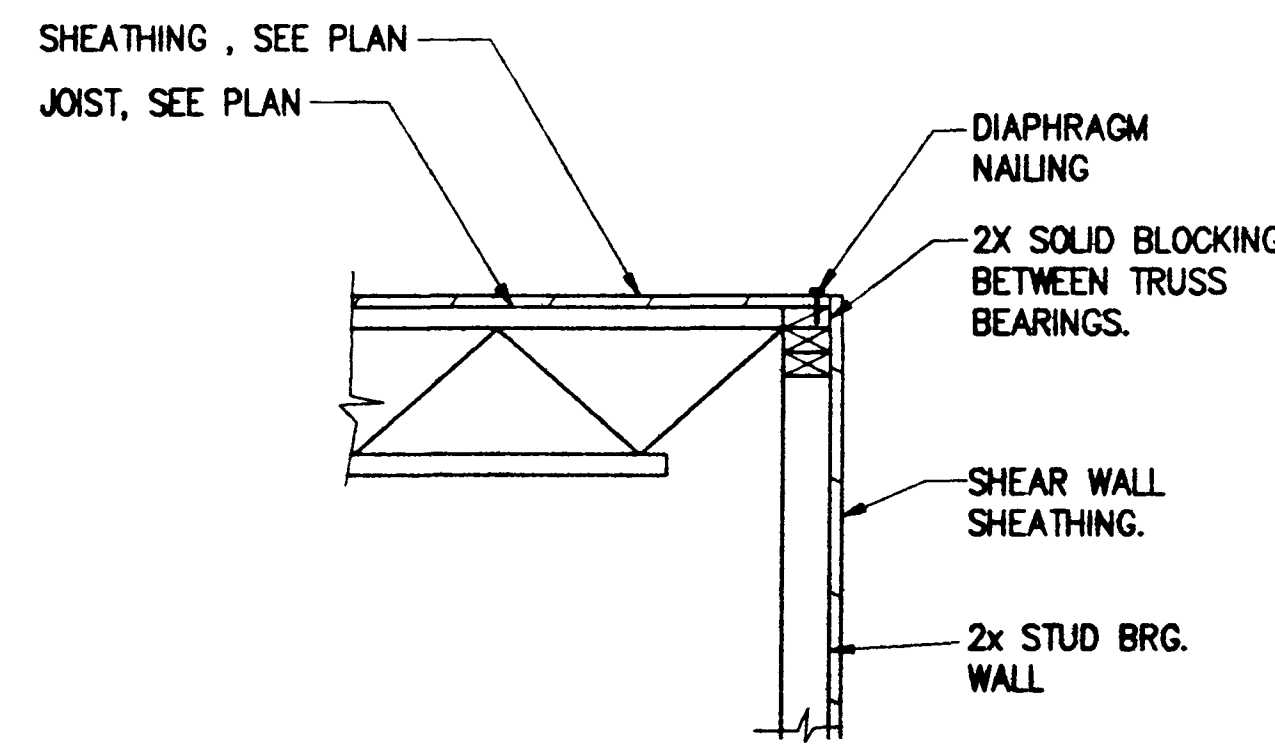

BEARING STUD WALL 18

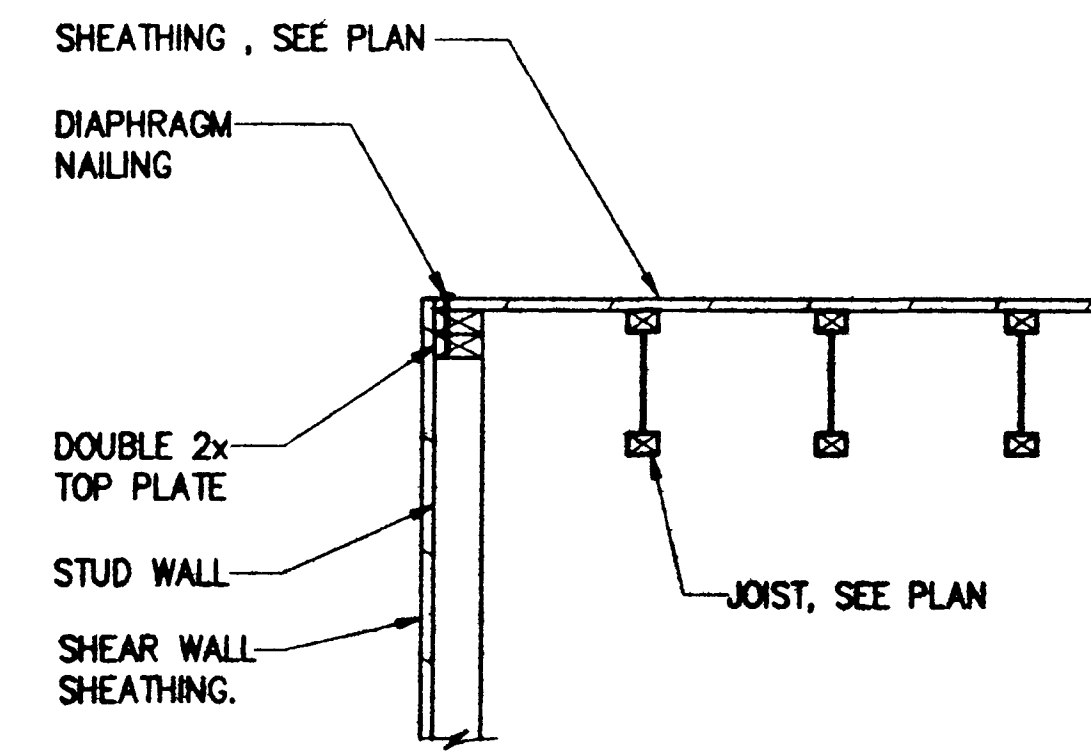

BEARING STUD WALL 19

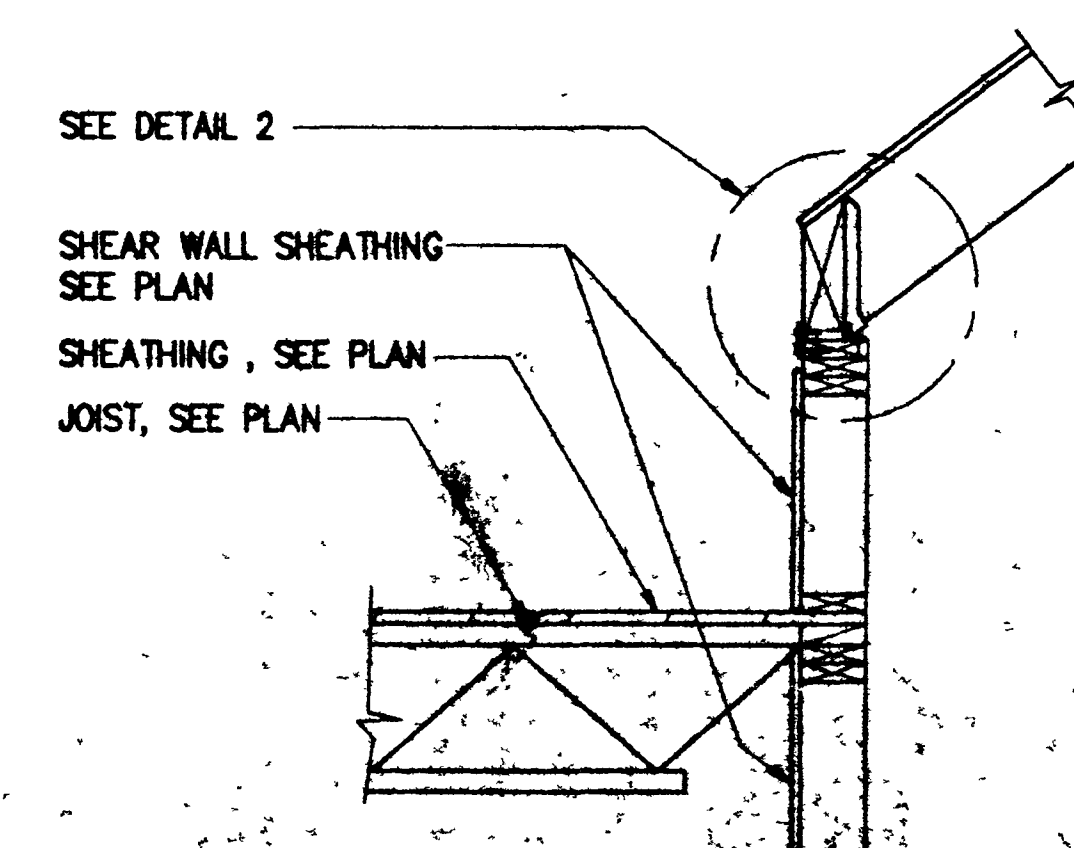

SECTION 20
3/4"=1'-0"

Revisions

1		
2		
MARTIN & PELTY, INC.
STRUCTURAL ENGINEERS
1001 RANCHO DRIVE SOUTH
LAS VEGAS, NEVADA 89109
PHONE (702) 385-5300
FAX (702) 381-9494
JOB NO. 2801

1800 East Flamingo Road, Suite 102
Las Vegas, Nevada 89119
(702) 731-0383
Fax (702) 731-9286

Architects

WEST LAS VEGAS ARTS CENTER
DOOLITTLE PARK - LAS VEGAS, NEVADA

AS-BUILTS

DATE: 8/12/93
Drawn By: SNB
Project No.: 92160
Scale: AS NOTED
Sheet No.: S4.3

671-46

