
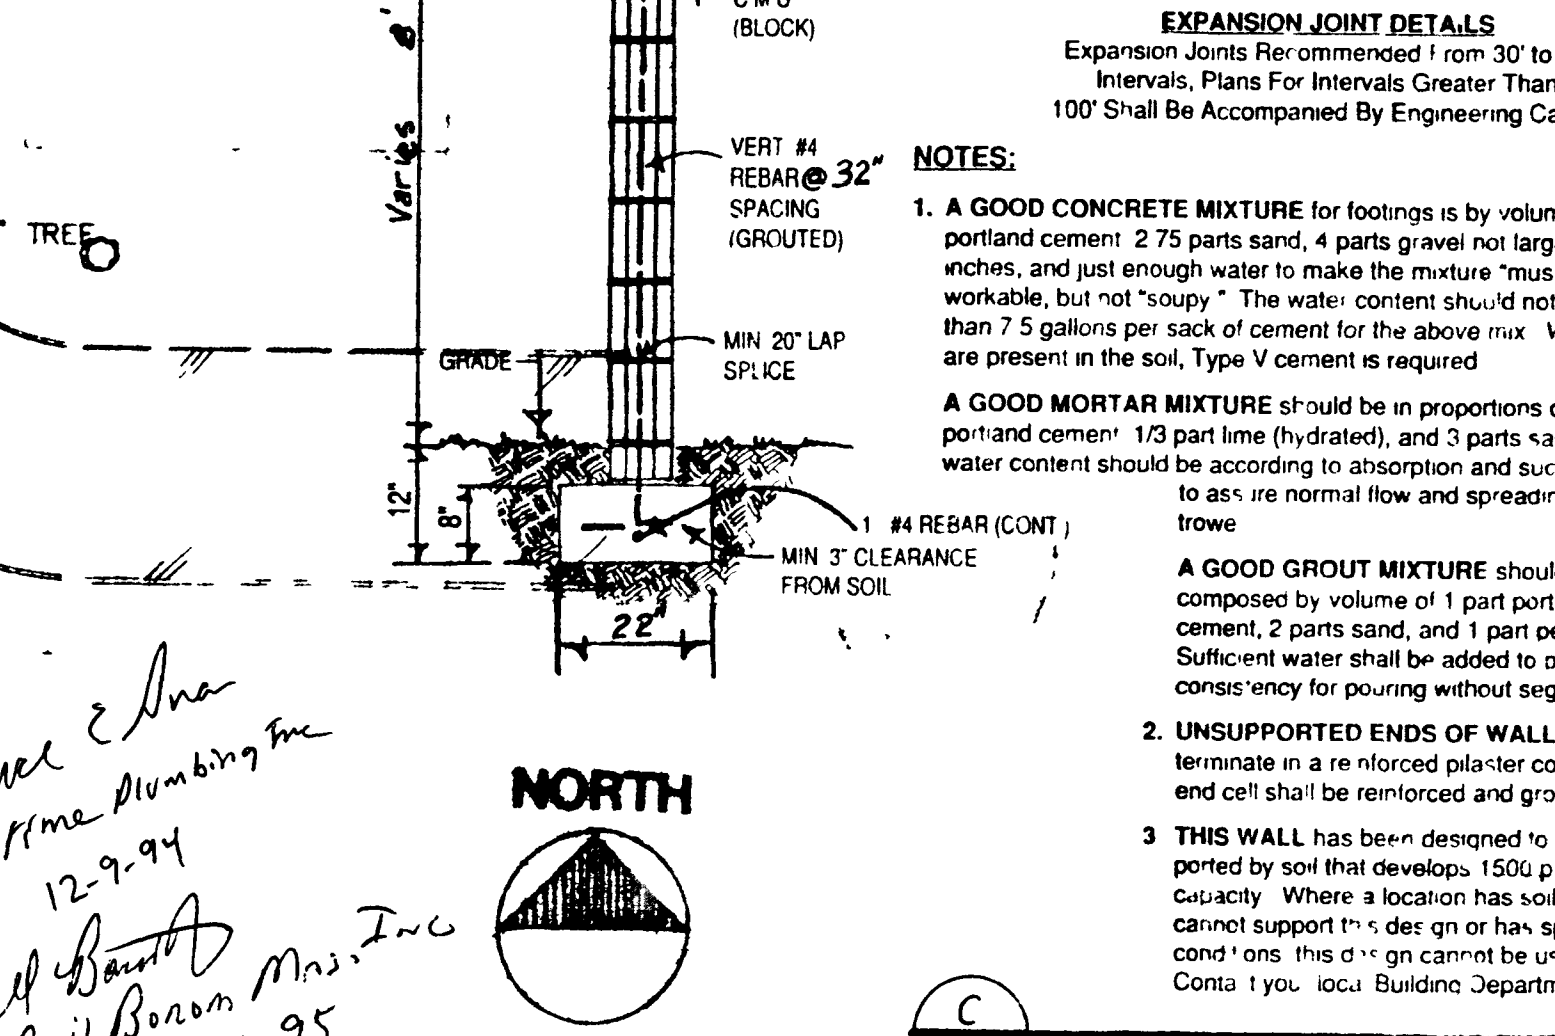
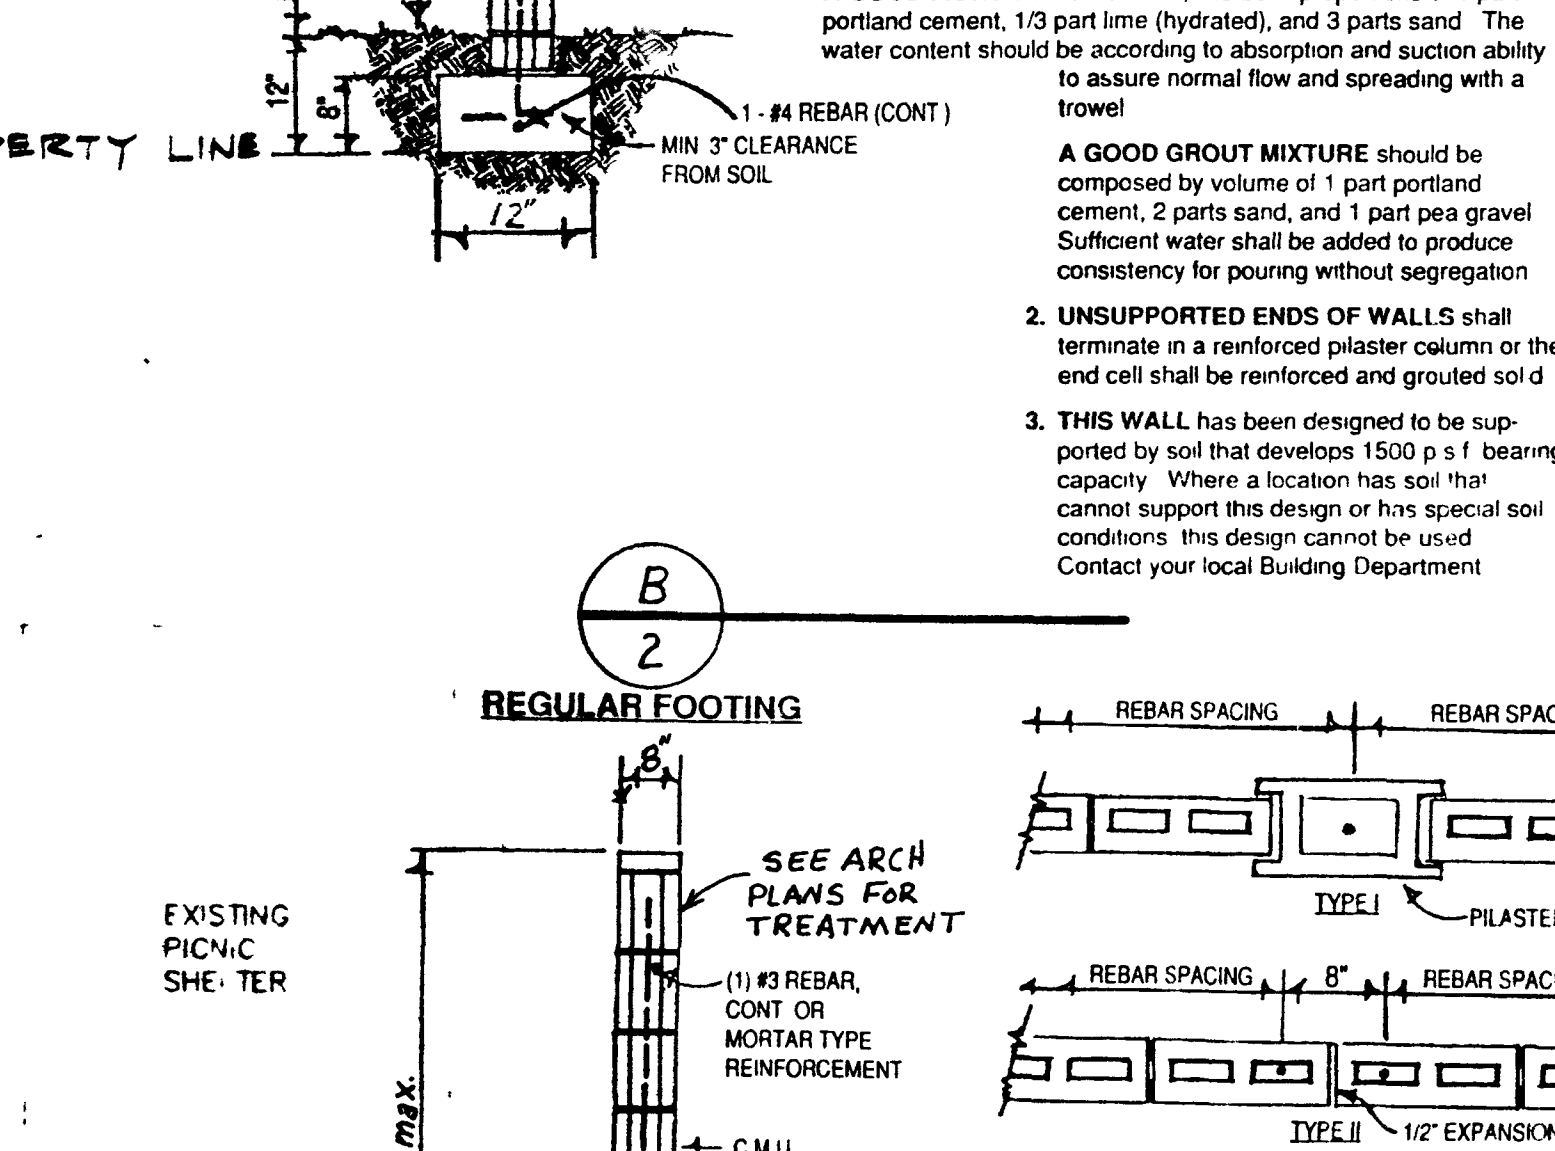
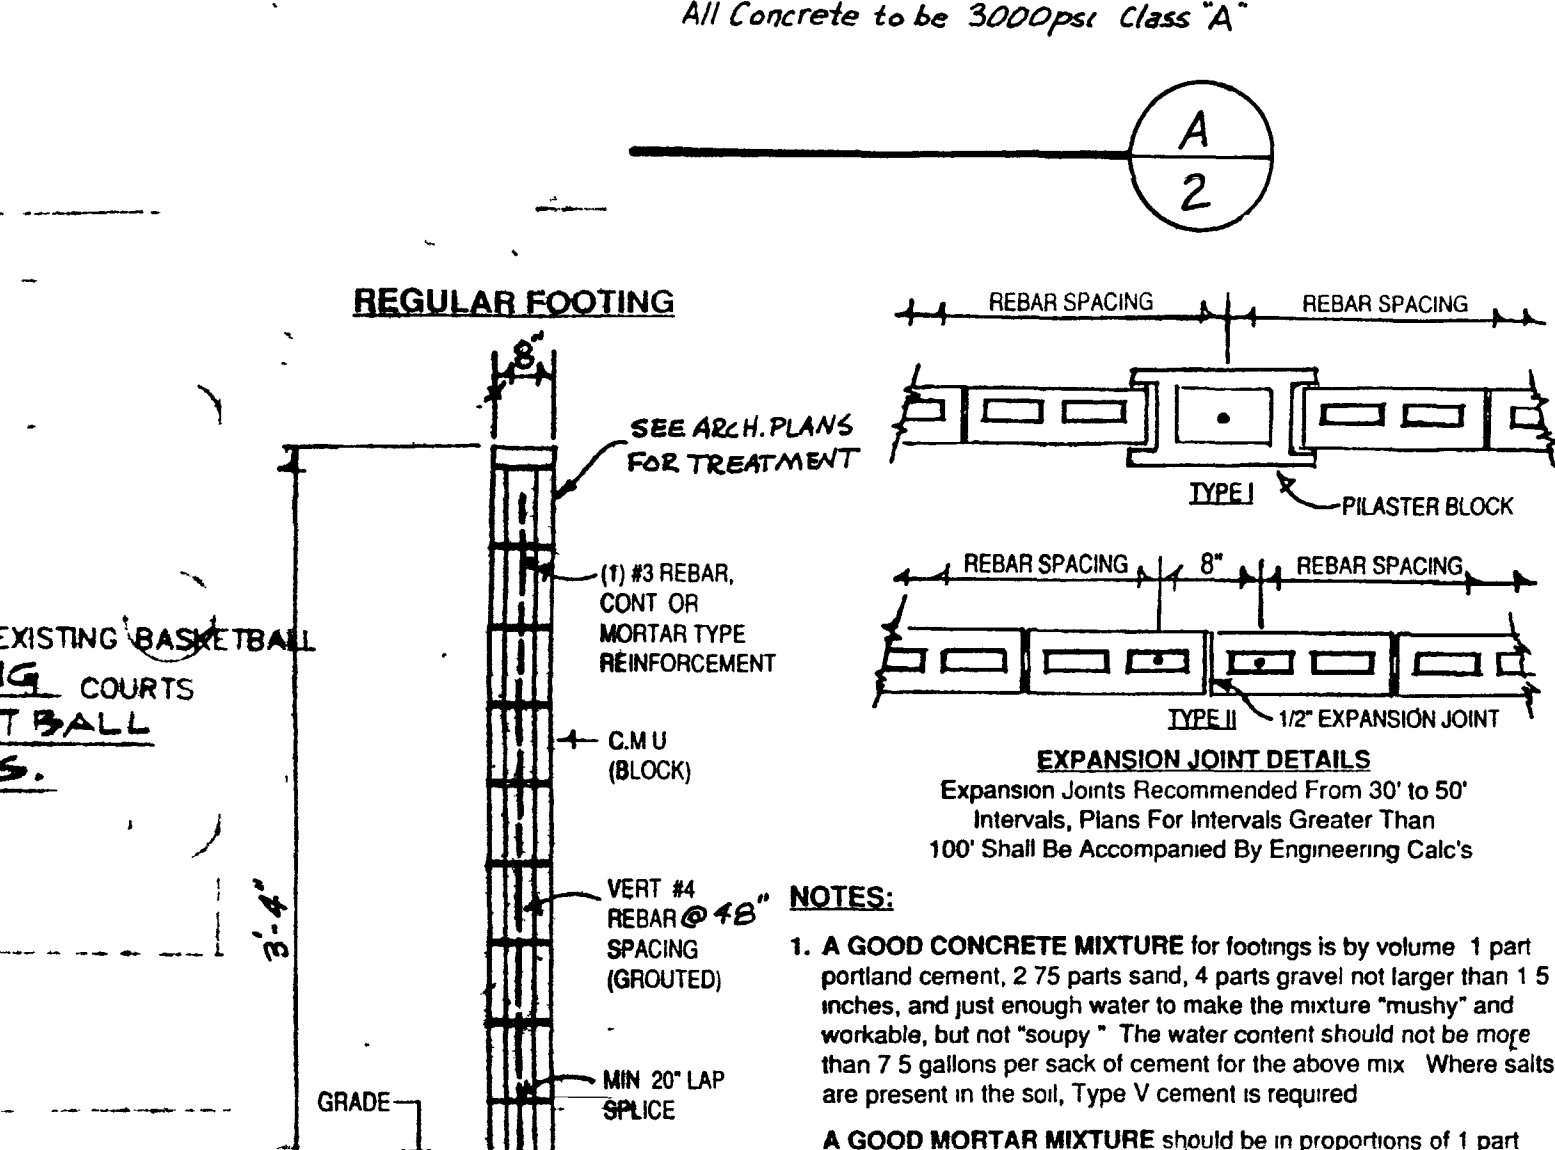
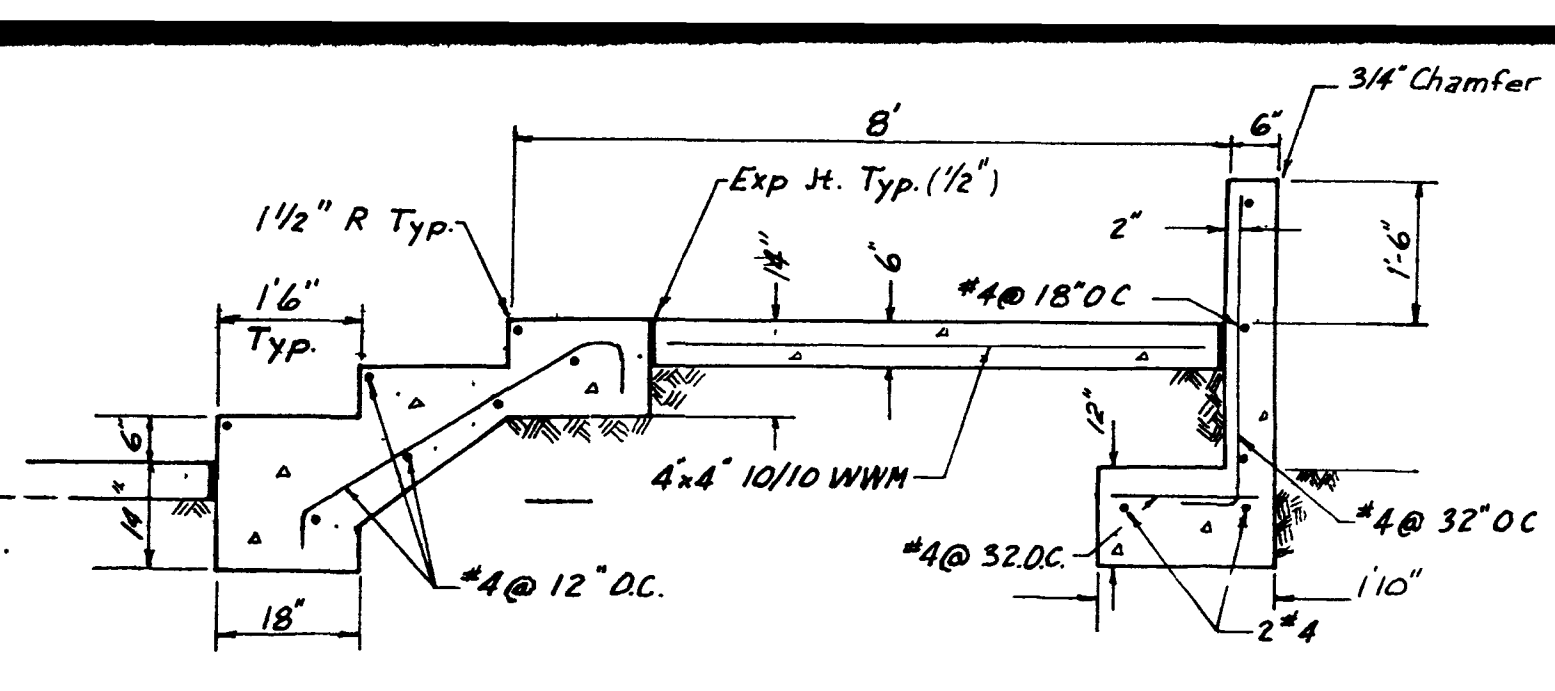


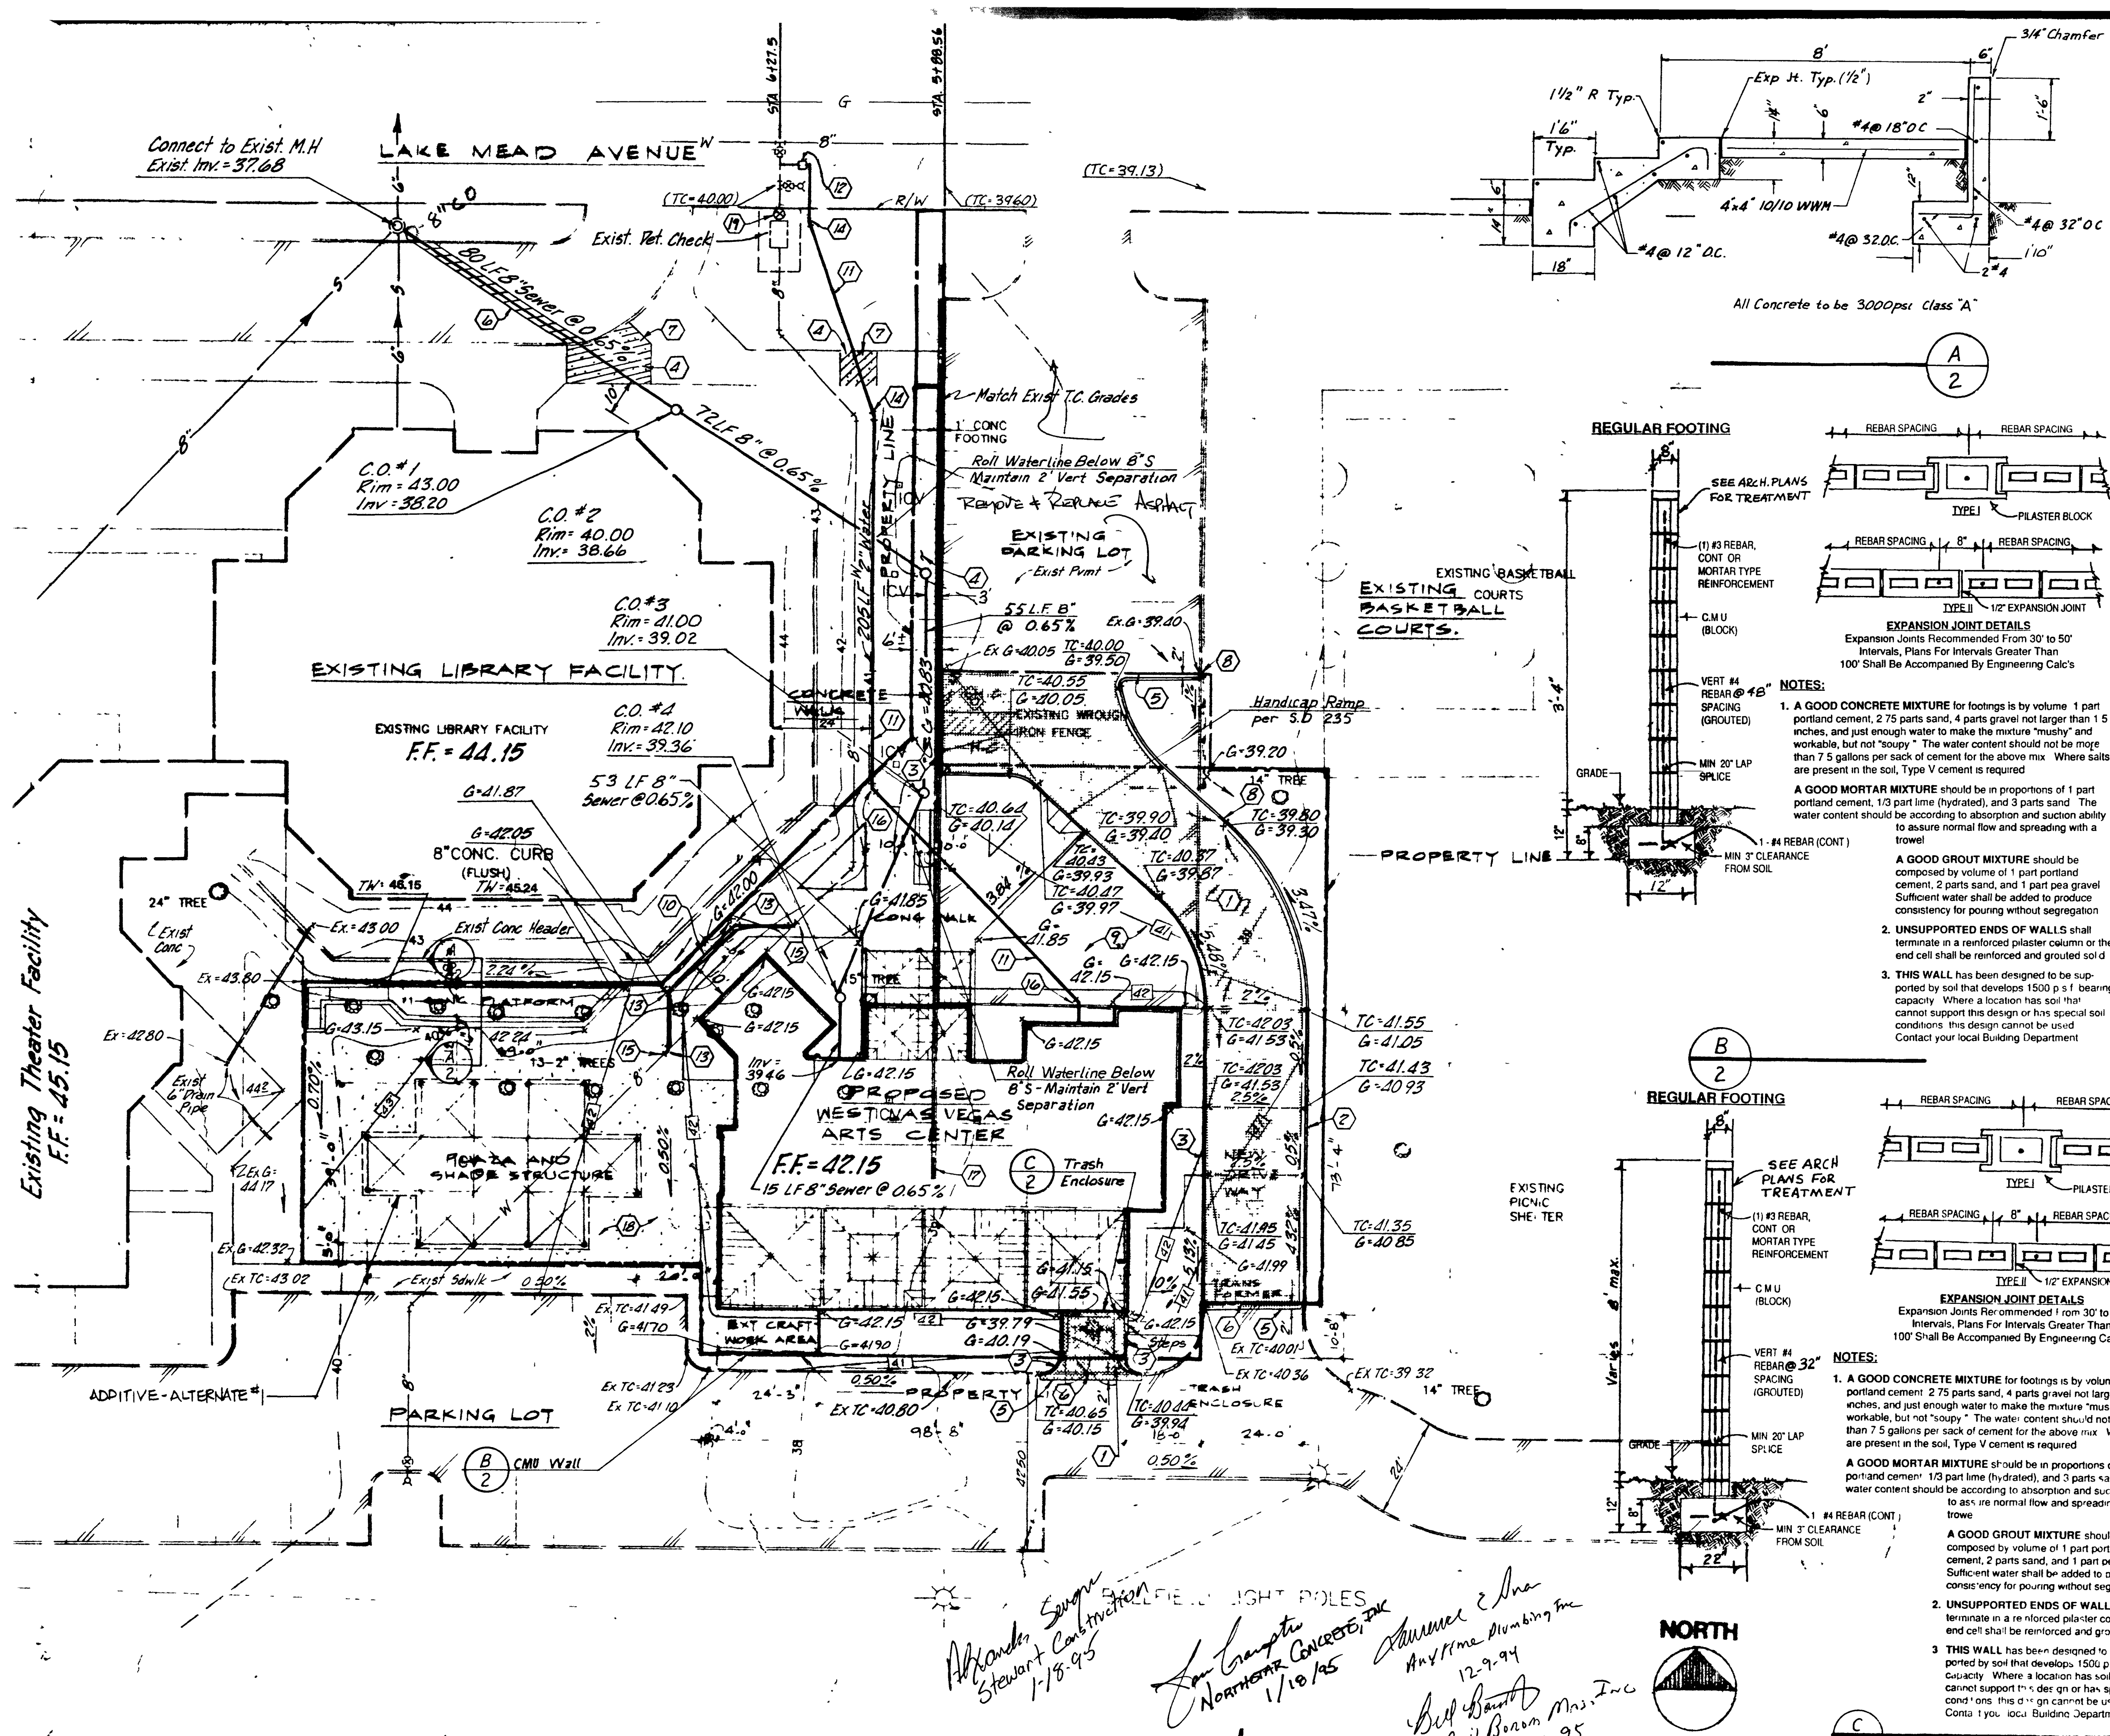

Paving & Water Construction Notes

No.	Item	Quantity	(Private)	(Public)
1	2" A.C. Pavement over 4" Type II Base	560	S.Y.	
2	Type "L" Curb & Gutter Per S.D. 219	178	L.F.	
3	Type "A" Curb Per S.D. 219	207	L.F.	
4	Sidewalk Per S.D. 234 (Adj to curb)	1170	S.F.	
5	Saw-Cut, Tack & Joint, Match Exst. Pmnt.	60	L.F.	
6	Pavement Removal & Replacement Per S.D. 503	15	S.Y.	
7	Sidewalk Removal	30	S.Y.	
8	2" Curb-Cut	2	Ea.	
9	Existing Pavement Removal	550	S.Y.	
10	8" Watermain	50	L.F.	
11	2" Waterline	200	L.F.	10 L.F.
12	2" Copper Service Lateral & 2" Meter (From LVVWD)			1 Ea.
13	8" x 45" Bend	4	Ea.	
14	2" x 11 1/2" Bend	4	Ea.	
15	Connect to Existing Watermain	2	Ea.	
16	2" x 45" Bend	2	Ea.	
17	Fence Removal	193	L.F.	
18	Conc. Patio (See Arch Plan)			
19	6" Gate Valve, B & C	1	Ea.	

Approximate Sewer Quantities

Item	Quantity	(Private)	(Public)
Exst. M.H. Connection	1	Ea.	
Clean-Outs	4	Ea.	
8" Sewer	258	L.F.	

FIRE FLOW REQUIREMENTS

BUILDING SQUARE FOOTAGE	7660 S.F.
CONSTRUCTION TYPE	V-N
NON-SPRINKLED	
FIRE FLOW REQUIRED -	2250 GPM

CBM
NUEVO AMERCAON
3 FEB 93



Engineering • Planning • Surveying
Landscape Architecture • Urban Design
Offices located in Tucson, Phoenix,
Las Vegas and Victor Valley, CA

West Las Vegas Arts Center
Civil Improvements

Grading & Utility Plan


Scale: 1" = 20'

Job No: 492012-B-1
Date: 12/92
Drawn By: RKH
Checked By: ROB

671-46

C-1.2

AS-BUILT

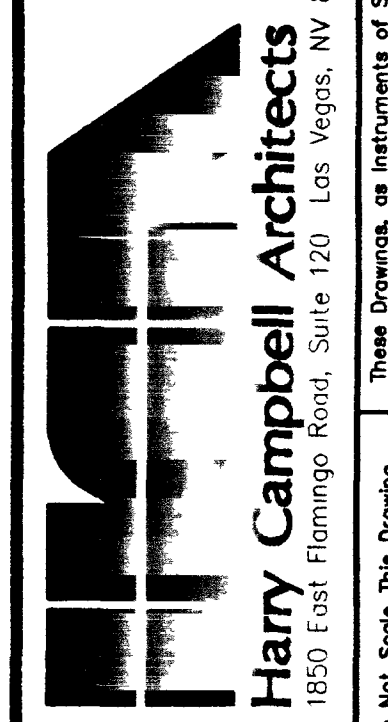

WEST LAS VEGAS ARTS CENTER
DOOLITTLE PARK - LAS VEGAS, NEVADA
GRADING & UTILITY PLAN

Project No: 92-160
Sheet No: C-1.2

