

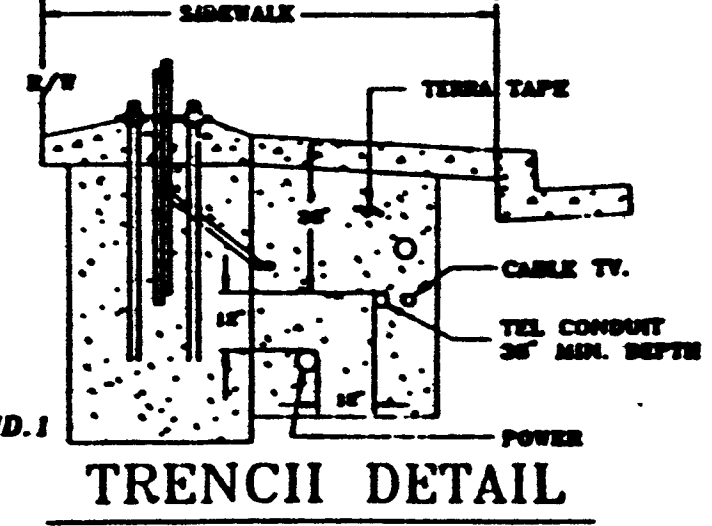
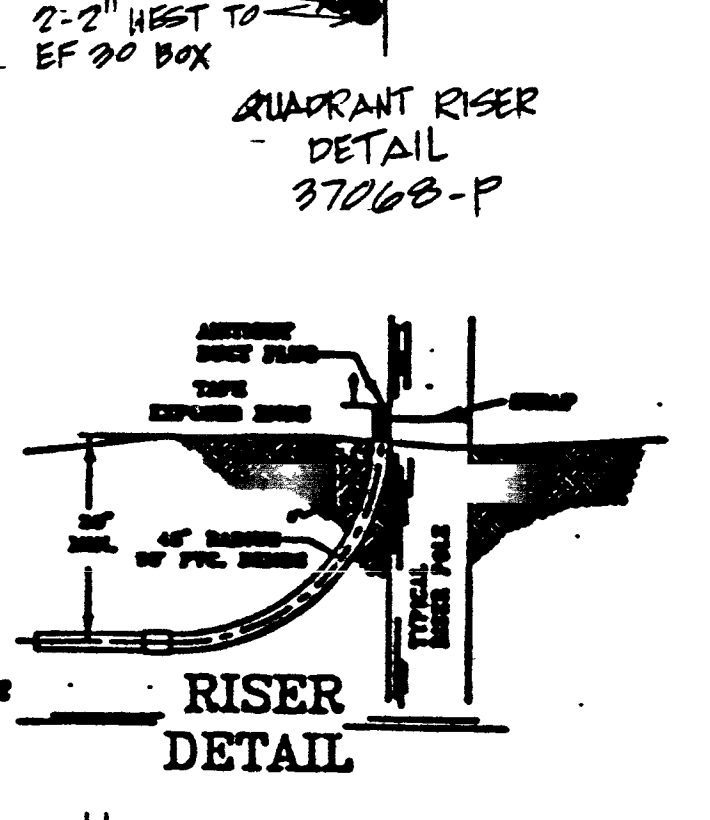
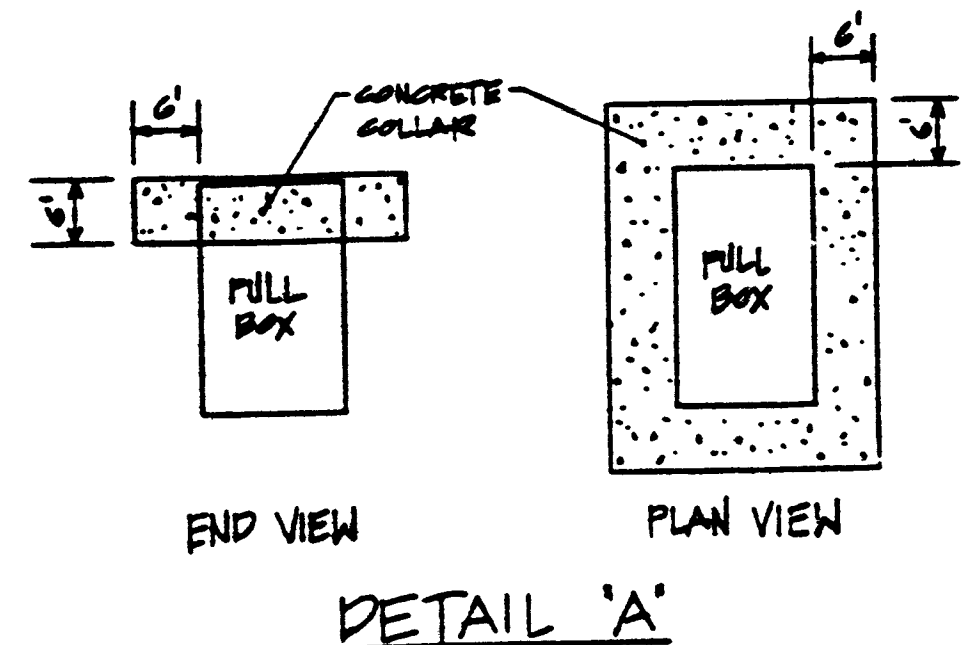


AS-BUILT 27-3

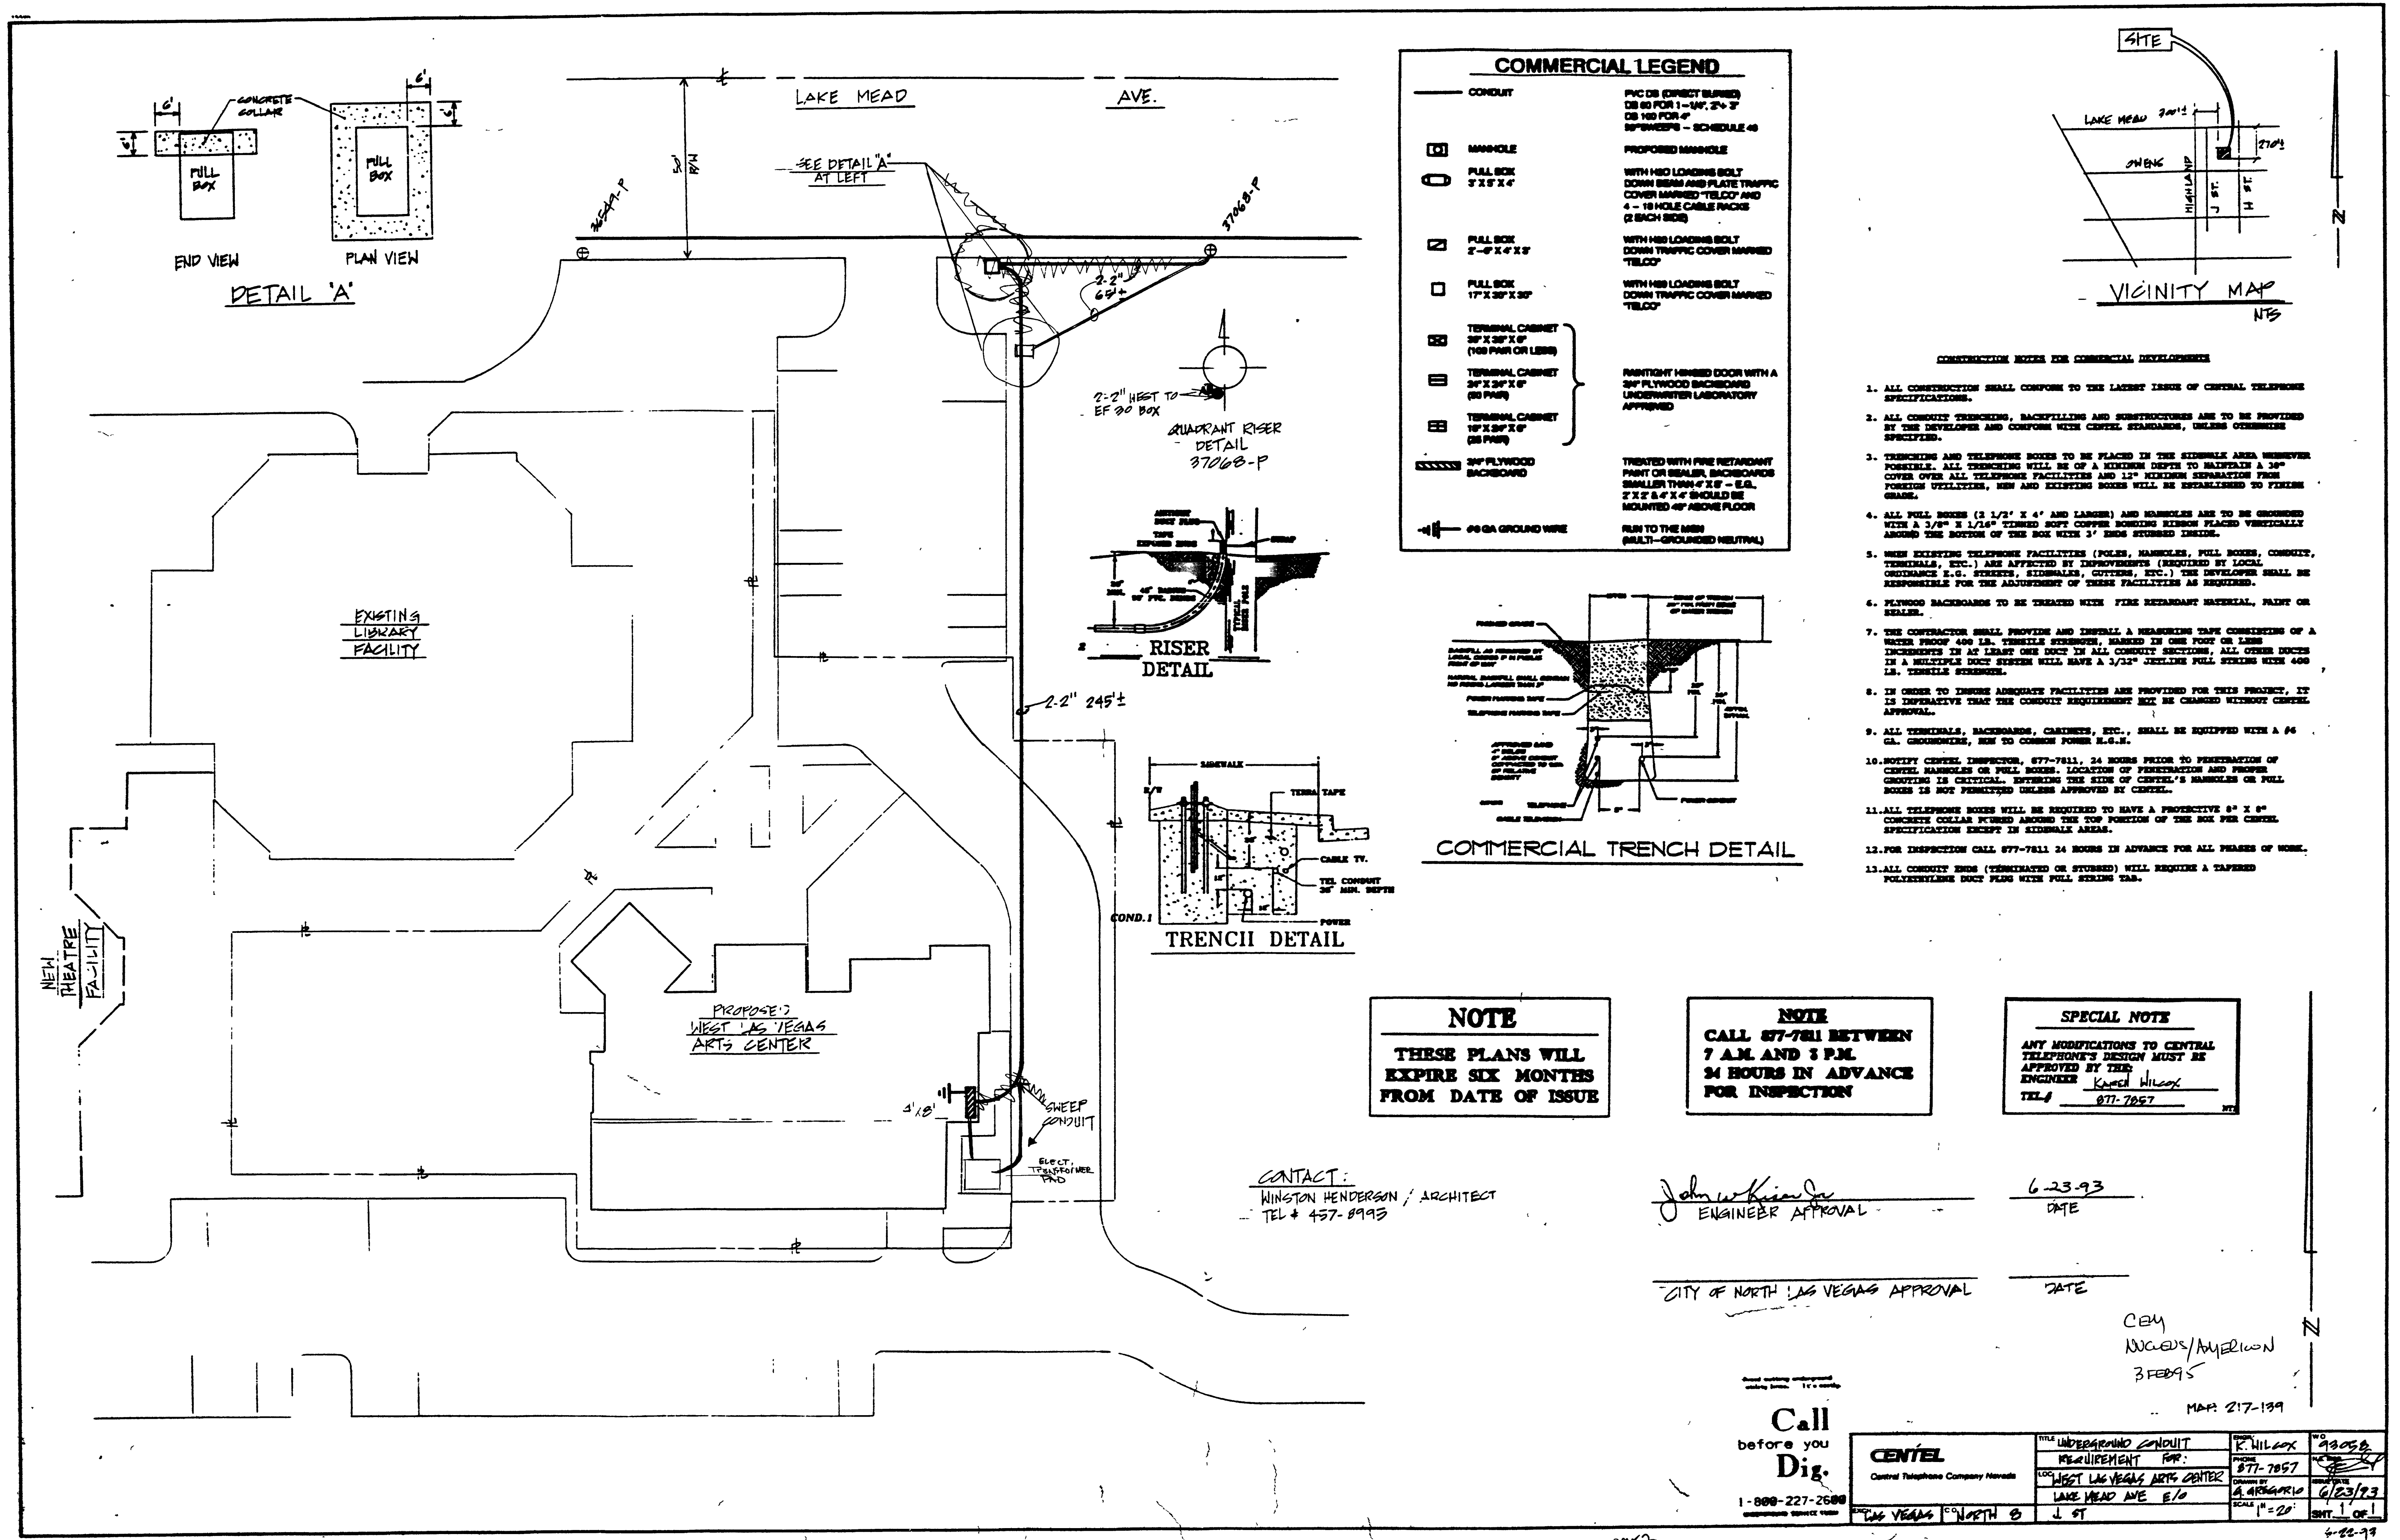

COMMERCIAL LEGEND	
CONDUIT	PVC OR CORROSION RESISTANT OR 60 FOR 1-1/2", 2-1/2", 3" OR 100 FOR 4" SCHEDULE 40
MANHOLE	PROPOSED MANHOLE WITH 1/2" LOADING BOLT DOWN 25MM AND PLATE TRAFFIC COVER MARKED "TELO" AND 4 - 1/2" HOLE CABLE RACKS (2 EACH SIDE)
PULL BOX 2' X 2' X 4'	WITH 1/2" LOADING BOLT DOWN TRAFFIC COVER MARKED "TELO"
PULL BOX 2' X 4' X 8'	WITH 1/2" LOADING BOLT DOWN TRAFFIC COVER MARKED "TELO"
PULL BOX 17' X 20' X 30'	WITH 1/2" LOADING BOLT DOWN TRAFFIC COVER MARKED "TELO"
TERMINAL CABINET 30" X 30" X 6"	PAINTED WOODEN DOOR WITH A 3/4" PLYWOOD BACKING (1/2" PLY OR LESS) (60 PLY) TREATED WITH FIRE RETARDANT PAINT OR SEALER, BACKING SMALLER THAN 4' X 8' - E.G. 2' X 8' X 4' SHOULD BE MOUNTED 4" ABOVE FLOOR
TERMINAL CABINET 30" X 30" X 6"	
TERMINAL CABINET 18" X 30" X 6"	
3/4" PLYWOOD BACKBOARD	
60 GA GROUND WIRE	PLANT TO THE MEN (MULTI-GROUNDED NEUTRAL)

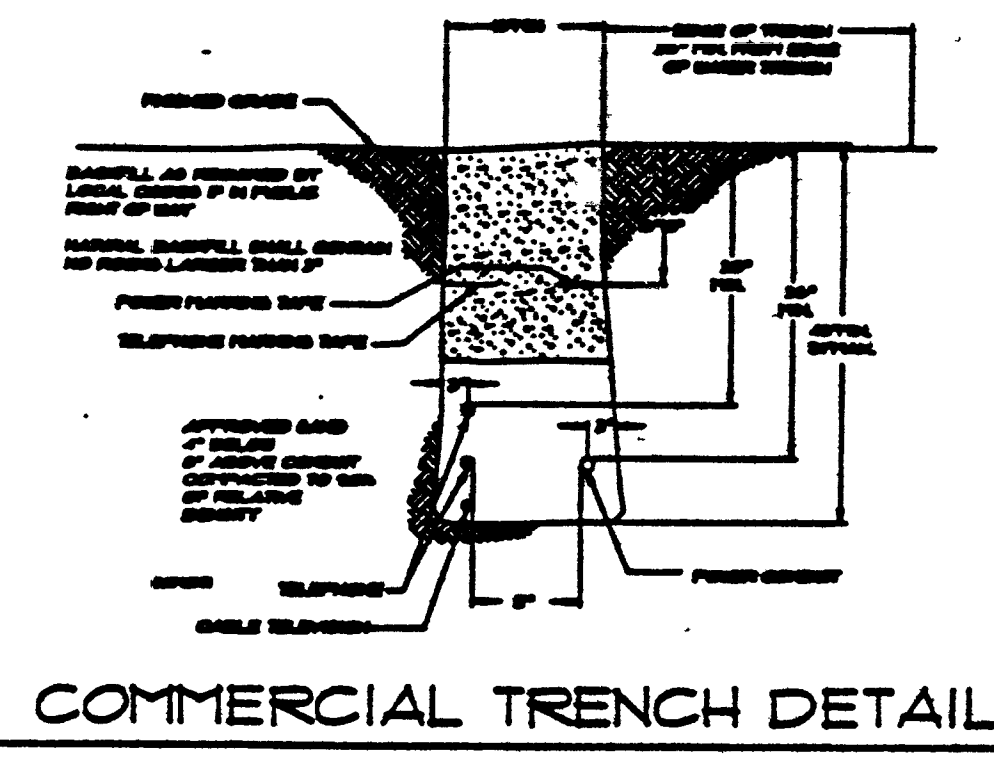

NOTE
THESE PLANS WILL
EXPIRE SIX MONTHS
FROM DATE OF ISSUE

NOTE
CALL 877-7811 BETWEEN
7 A.M. AND 3 P.M.
24 HOURS IN ADVANCE
FOR INSPECTION

SPECIAL NOTE
ANY MODIFICATIONS TO CENTRAL
TELEPHONE'S DESIGN MUST BE
APPROVED BY THE
ENGINEER *Kenneth Wilcox*
TEL # 877-7857

CONTACT:
WINSTON HENDERSON / ARCHITECT
TEL # 457-8993

John Wilcox
ENGINEER APPROVAL

6-23-93
DATE

CITY OF NORTH LAS VEGAS APPROVAL

DATE

CEM
NICHOLS/AMERICAN
3 FEB 95

MAP 217-139

Call
before you
Dig.

1-800-227-2500
COMMERCIAL SERVICE CENTER

CENTEL Central Telephone Company Nevada	UNDERGROUND CONDUIT	K. WILCOX	93058
	REQUIREMENT FOR:	877-7857	93058
LOC: WEST LAS VEGAS ARTS CENTER	DATE: 6/23/93	SCALE: 1" = 20'	BY: 1 OF 1
DATE: 6/23/93	SCALE: 1" = 20'	BY: 1 OF 1	4-82-99

CLV DWS # 671-46

