



PLANT SCHEDULE				
SYMBOL	SIZE	QTY.	NAME	REMARKS
	24' BOX	3	TREE Albizia julibrissa	Silk Tree (Worms)
	24' BOX	3	Chilopsis linearis	Desert Willow
	36' BOX	2	Olea europaea 'Sour Hill'	Fruitless Olive
	24' BOX	5	CERCIDILUM FLORIDUM	BLUE PALM VERDE
	24' BOX	2	Sophora secundiflora	Mescal Bean
	15 gal	2	SHRUB Agave americana	Century Plant
	1 gal	40	Baileya multiradiata	Desert Marigold
	5 gal	6	Caesalpinia gilliesii	Yellow Bird of Paradise
	5 gal	44	Cassia artemisioides	Feathery Cassia
	5 gal	16	Desfontainia viridis	Desert Spoon
	15 gal	8	Fouquieria splendens	Cholla
	5 gal	31	Hesperaloe parviflora	Red Yucca
	5 gal	23	Leucophyllum frutescens 'Green Cloud'	Texas Ranger
	1 gal	34	Liriope muscari	Lilyturf
	1 gal	118	Oenothera biennis	Mexican primrose
	5 gal	3	Opuntia ficus-indica	Mission Cactus
	1 gal	38	GROUND COVER Sarcocolla 'Centennial'	Dwarf Centennial Broom
	1 gal	60	Verbena peruviana	Peruvian Verbena
DG	1/2 MINUS	4670 ±	Decomposed Granite, 2" Deep, 1/2" minus.	
SEE PLAN		0	Boulders, Granite, Color to match D.G.	

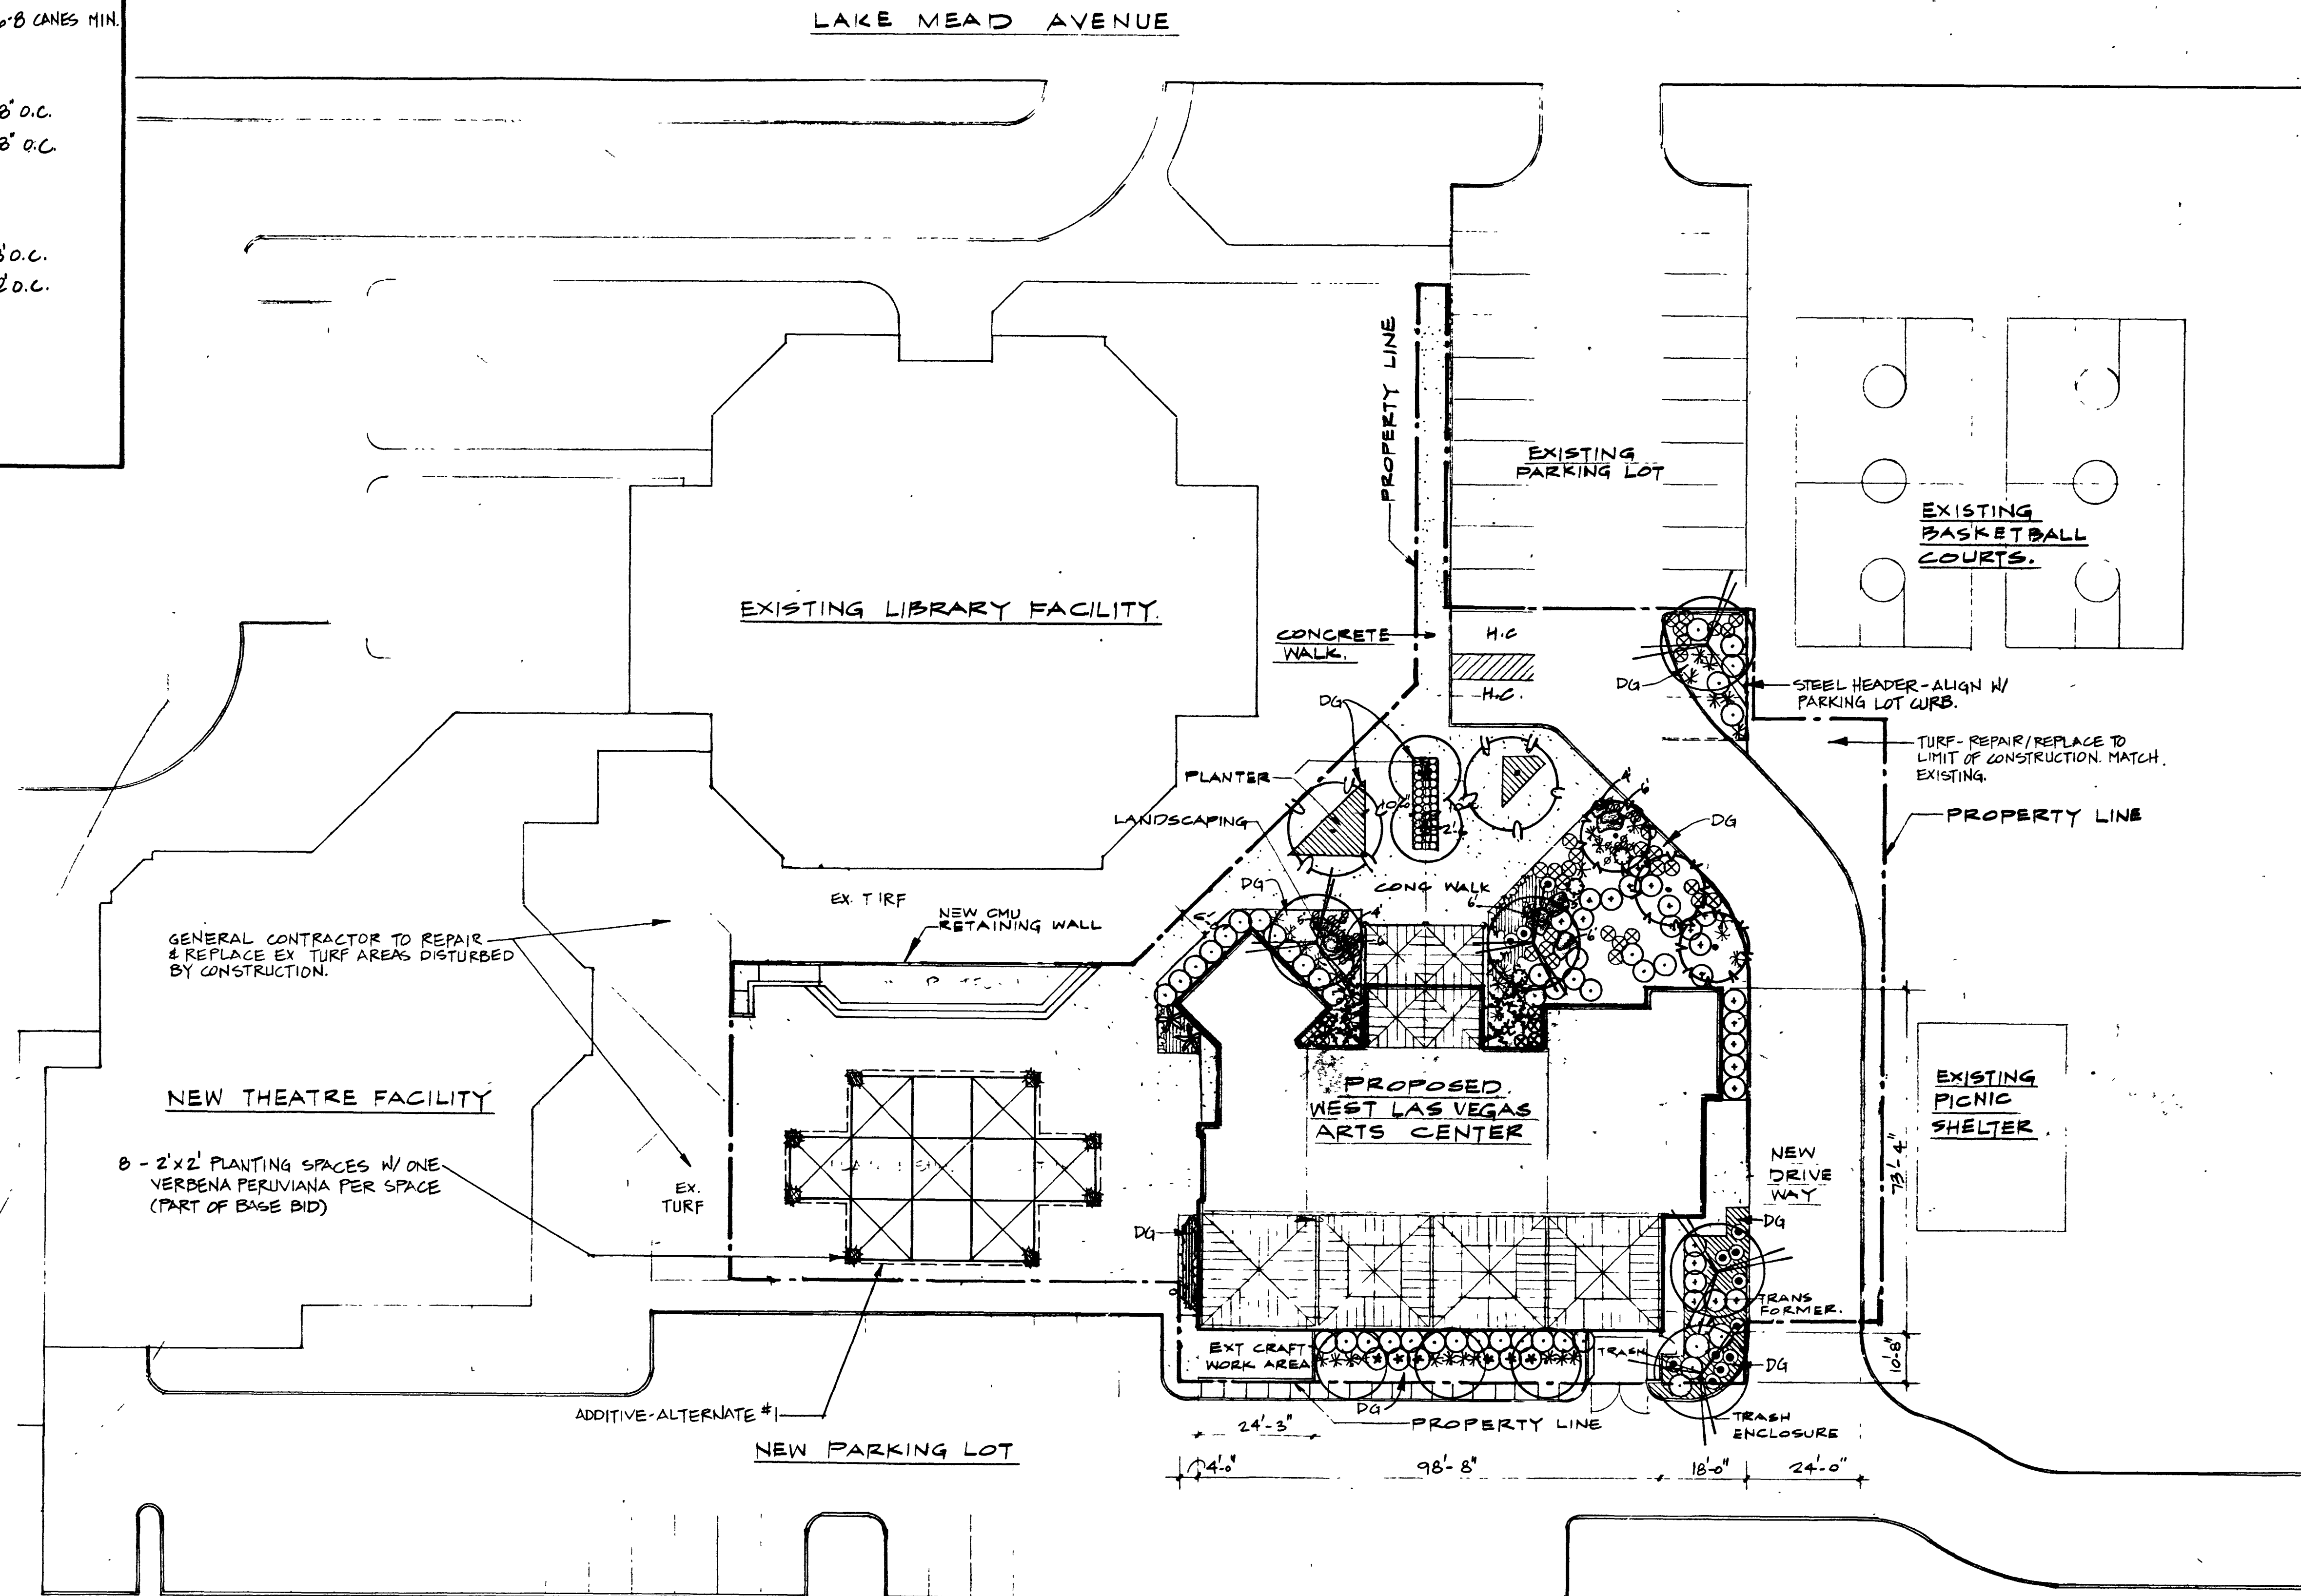

PLANTING PLAN
Scale: 1"=20'-0"

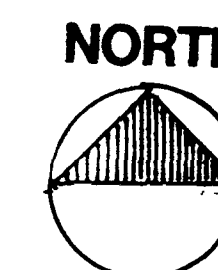

CDM
NUCLON/AMERON
3 FEB 93

Revisions

The WTLB Group Inc.
2551 No. Green Valley Parkway, Suite 4425
Henderson, Nevada 89014 (702) 596-3351

Harry Campbell Architects
1800 East Flamingo Road, Suite 120, Las Vegas, NV 89119 (702) 731-0963 Fax (702) 711-9266

Project: WEST LAS VEGAS ARTS CENTER
DOOLITTLE PARK - LAS VEGAS, NEVADA

Planting Plan **AS-BUILT**

Date: 8/12/93
Drawn By: BP
Project No: 92160
Scale: 1" = 20'-0"
Sheet No: L-2.1

