

VICINITY MAP

A-0.1 COVER SHEET
INDEX, GENERAL NOTES, ECT
(ABBREVIATIONS, DESIGN ANALYSIS, SYMBOL LEGEND)

CENTEL DRAWING
NEVADA POWER DRAWING

CIVIL

C-1.1 GENERAL NOTES
C-1.2 GRADING & UTILITY PLAN
C-1.3 HORIZONTAL CONTROL PLAN

LANDSCAPING

L-1.1 IRRIGATION PLAN
L-2.1 PLANTING PLAN
L-3.1 PLANTING DETAILS
L-3.2 IRRIGATION DETAILS

ARCHITECTURAL

A5-1.1 SITE PLAN & DETAILS

A-1.1 FLOOR PLAN

A-2.1 SIGNAGE PLAN & DETAILS

A-3.1 EXTERIOR ELEVATIONS & DETAILS


A-4.1 BUILDING SECTIONS
A-4.2 WALL SECTIONS

A-5.1 ROOF PLAN & DETAILS
A-5.2 DETAILS

A-6.1 REFLECTED CEILING PLAN & DETAILS

A-7.1 ROOM, DOOR & WINDOW SCHEDULES
A-7.2 DOOR AND WINDOW DETAILS
A-7.3 WINDOW & PLAN DETAILS

A-8.1 INTERIOR ELEVATIONS & DETAILS

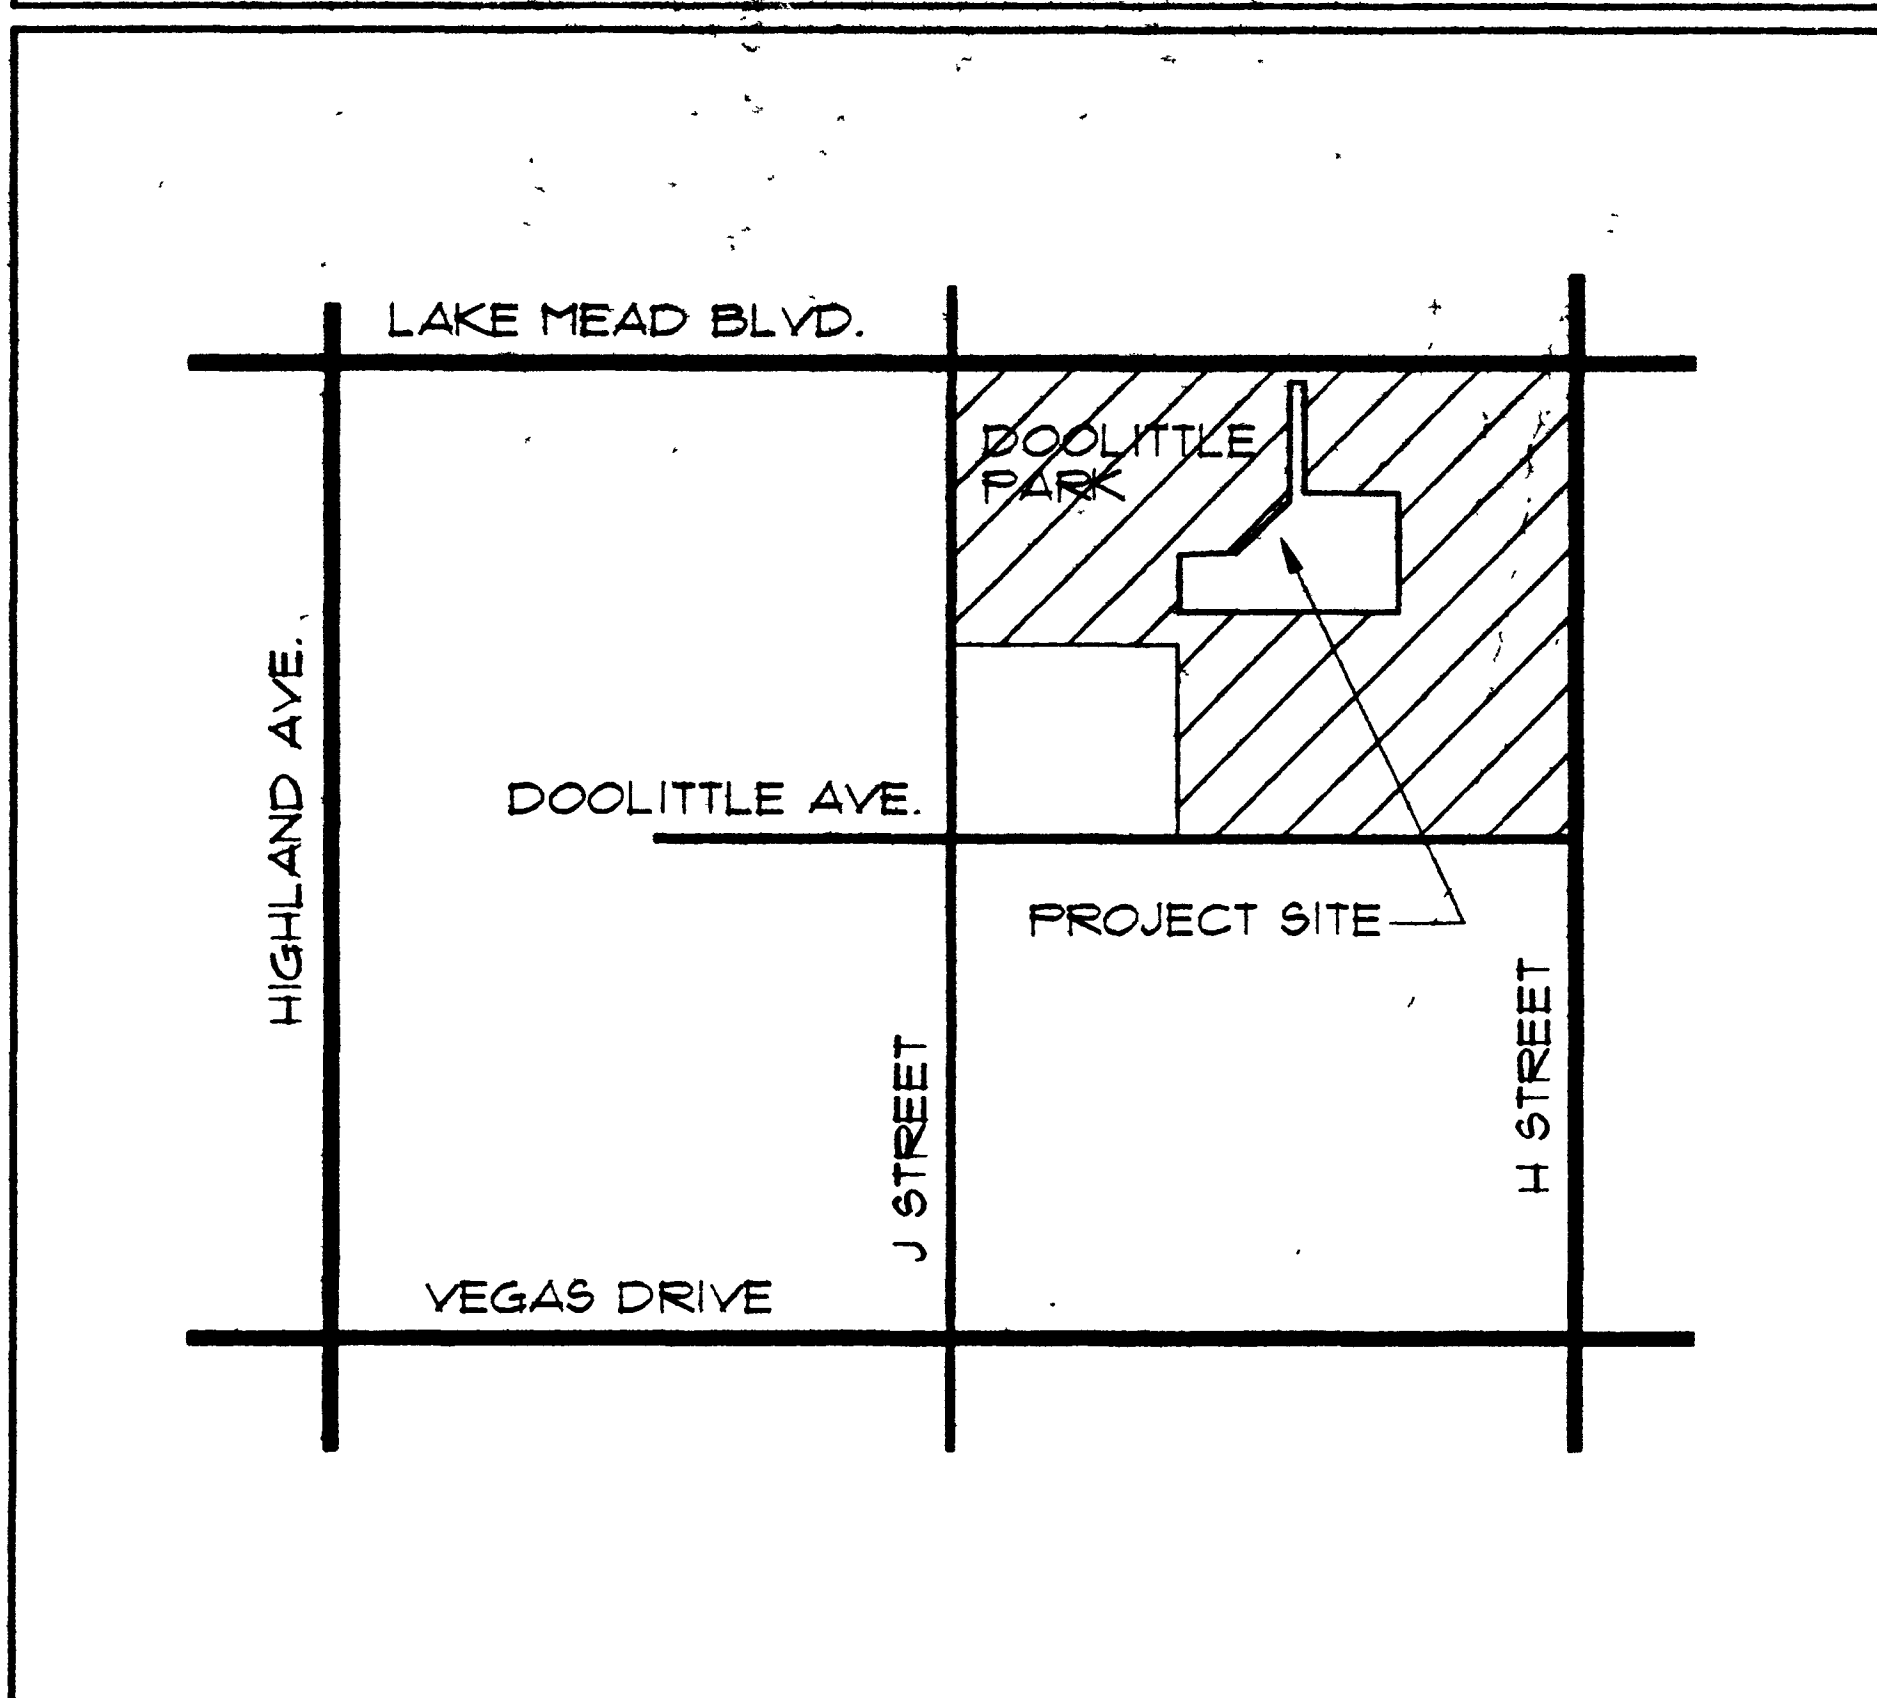

SYMBOL LEGEND

	BUILDING SECTION
	PARTIAL BUILDING SECTION
	DETAIL / WALL SECTION
	WALL TYPE
	DOOR NUMBER
	WINDOW NUMBER
	KEY NOTE
	EQUIPMENT NUMBER
	REVISION NUMBER
	DATUM REFERENCE
	ELEVATION REFERENCE
	GRID LINE
	ROOM NUMBER

STRUCTURAL

S-11 GENERAL NOTES
S-21 FOUNDATION AND FLOOR SLAB PLAN
S-22 ROOF FRAMING PLAN
S-41 DETAILS
S-42 DETAILS
S-43 DETAILS

PLUMBING / MECHANICAL

M-1 LEGEND SCHEDULES GENERAL NOTES
M-2 PLUMBING FLOOR PLAN & PART PLAN
M-3 AIR CONDITIONING PLAN
M-4 ROOF PLAN

ELECTRICAL

E10 SYMBOL LIST, SPECIFICATIONS AND FIXTURE SCHEDULE
E10 SITE PLAN
E10 ELECTRICAL FLOOR PLAN
E20 ELECTRICAL FLOOR PLAN
E30 ROOF PLAN
E40 SINGLE LINE DIAGRAM

WEST LAS VEGAS ARTS CENTER
UNIFORM BUILDING CODE, 1991

DESCRIPTION:

AREA:	7631
HEIGHT:	* 1 STORY
SEISMIC ZONE:	2
TYPE OF CONSTRUCTION:	V-N
SPRINKLER SYSTEM:	NO

OCCUPANCY CLASSIFICATION:

LOBBY/DISPLAY EXHIBIT RM. & DANCE STUDIOS	GROUP A, DIVISION 3
REMAINDER OF BUILDING:	GROUP B, DIVISION 2

OCCUPANCY SEPARATION: (TABLE 5-B)

A3 VS B2:	NONE REQUIRED
-----------	---------------

AREA SEPARATION:

NONE REQUIRED

ALLOWABLE AREA: (TABLE 5-C)

A-3:	V-N = 6,000 SF.
B-2:	V-N = 8,000 SF.

ALLOWABLE AREA INCREASES: (SECTION 506)

SEPARATION 2 SIDES, ALLOWABLE IS $125\% \times 30 = 47.5\%$

TOTAL ALLOWABLE AREAS

1. ALL DIMENSIONS TO FACE OF CMU (8" NOM) OR FACE OF STUD
UNLESS NOTED OTHERWISE
2. SEAL ALL PENETRATIONS IN FACE RATED PARTITIONS AND CEILINGS W/ FIRESTOPPING MATERIAL.
3. SEE 1/8" PLANS FOR DOOR NUMBER
4. REFERENCE STRUCTURAL, LARGE SCALE PLANS AND ROOM FINISH SCHEDULE FOR
AREAS OF FLOOR SLAB TO BE RECESSED TO ACCOMMODATE FLOOR TILE AND WD. FLOORING

Harry Campbell Architects
11850 East Flamingo Road, Suite 120 Las Vegas, NV

ST LAS VEGAS ARTS CENTER
TLE PARK - LAS VEGAS, NEVADA
INDEX, GENERAL NOTES, ECT.

Date 8/12/93	
Drawn By MHS	Checked By M.Y.
Project No 92-160	
Scale NONE	
Sheet No A	

As-Built

Revisions		

Harry Campbell Architects
1950 East Hanning Road, Suite 120 Las Vegas, NV 89119 (702) 731-0363 Fax: (702) 731-9266
We Sell, Lease, Finance, and Manage Real Estate. We Buy, Sell, Lease, Finance, and Manage the Property of Our Clients.

WEST LAS VEGAS ARTS CENTER
LITTLE PARK - LAS VEGAS, NEVADA

INDEX, GENERAL NOTES, ECT.

Project:	DC	
Date	8/12/93	
Drawn By	MHS	Checked By M.Y.
Project No	92-160	
Scale	NONE	
Sheet No	A-0.i	

A-0.1

CEM
NUGGETS/ AMERICAN
3 FEB 95

CLV DWG # 671-46

FILE: 160A01

VICINITY MAP

SYMBOL LEGEND

[illegible]

DESIGN ANALYSIS

3827 LAM VILLAS APPTS CENTER
 10000 2ND AVE, DAVIS, CALIF. 95618

DESCRIPTION
 100%
 100%
 100%
 100%

OCCUPANCY CLASSIFICATION
 100%
 100%
 100%
 100%

OCCUPANCY SEPARATION (TABLE 9-B)(I)
 100%
 100%
 100%
 100%

AREA SEPARATION
 100%
 100%
 100%
 100%

ALLOWABLE AREA (TABLE 9-C)(I)
 100%
 100%
 100%
 100%

ALLOWABLE AREA INCREASES (SECTION 9-2)
 100%
 100%
 100%
 100%

400 000000 = 100 = 0000 00
 00000000 = 0000 = 1 0000 00
 PERIOD OCCUPANCY ALLOWABLE
 AREA CALCULATION

$$\frac{100}{100} \times \frac{100}{100} = 100\% \times 100\% = 100\%$$
 DISTANCE TO EXIT:
 10000 000000

ST LAS VEGAS ARTS CENTER
TILE PARK - LAS VEGAS, NEVADA
INDEX, GENERAL NOTES, ECT.