




1 PALM TREE PLANTING DETAIL  
SCALE: NOT TO SCALE

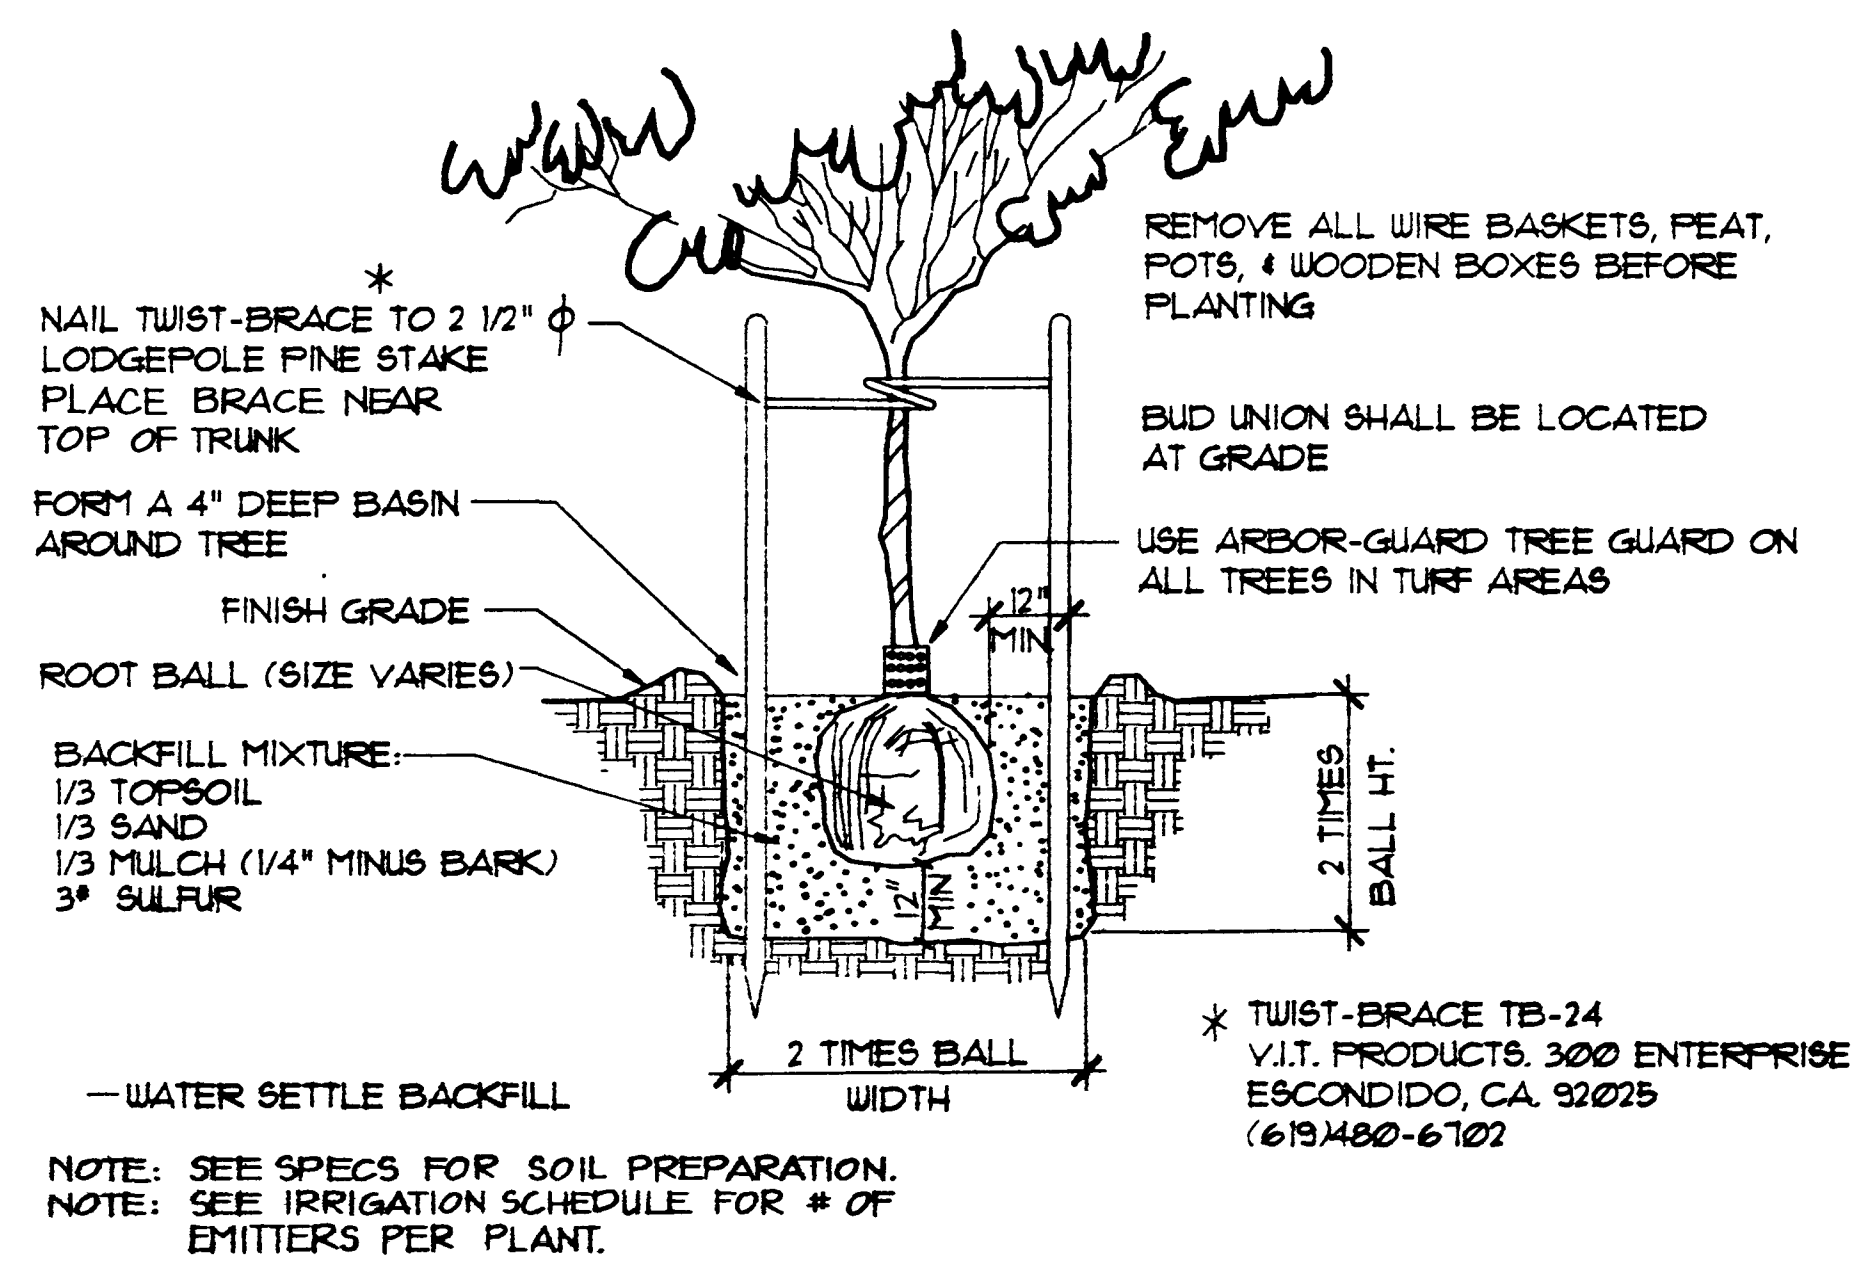


2 TREE PLANTING DETAIL  
SCALE: NOT TO SCALE

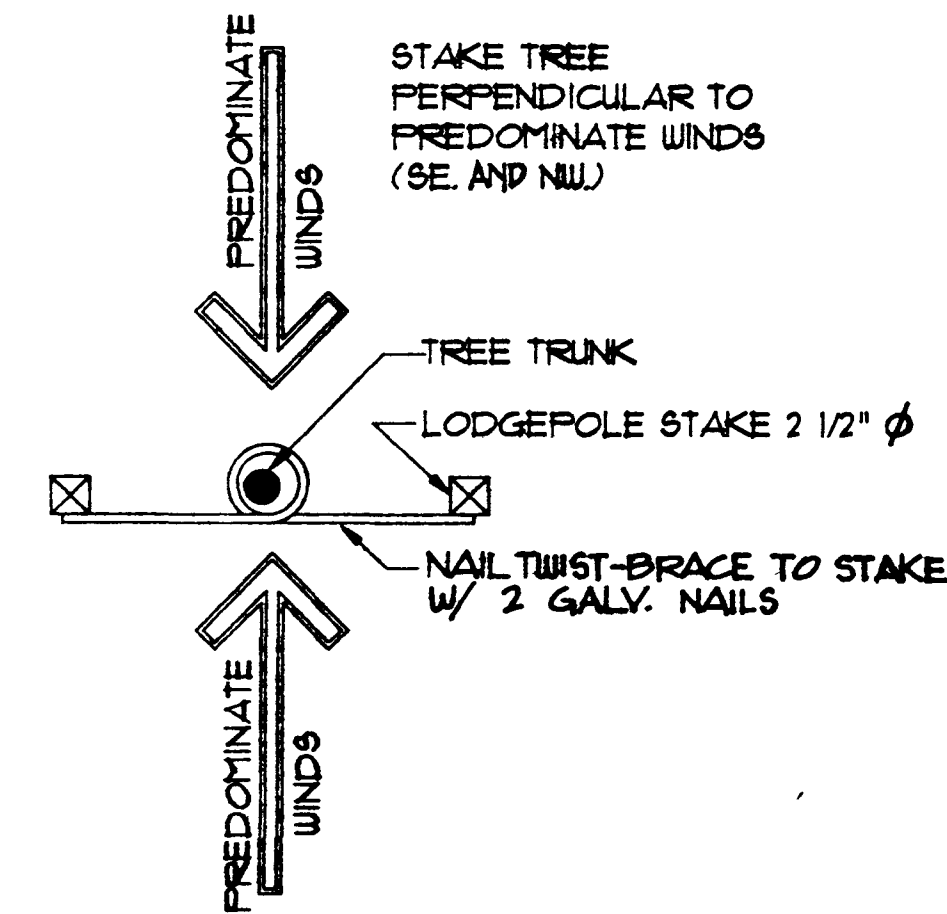


3 TREE STAKING DETAIL  
SCALE: NOT TO SCALE

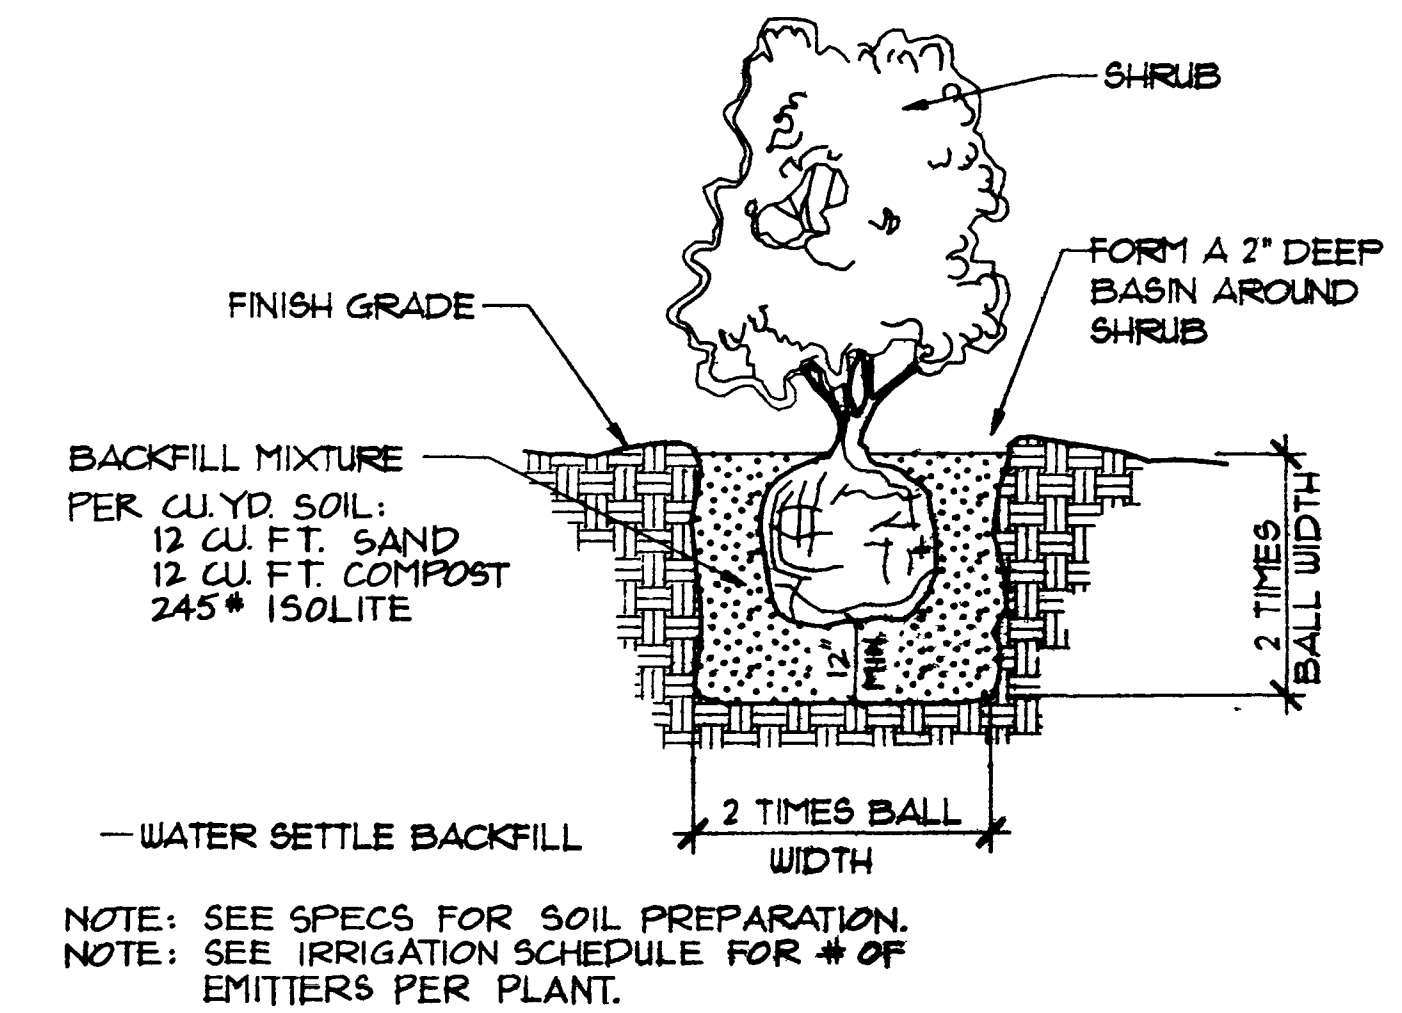


4 SHRUB PLANTING DETAIL  
SCALE: NOT TO SCALE

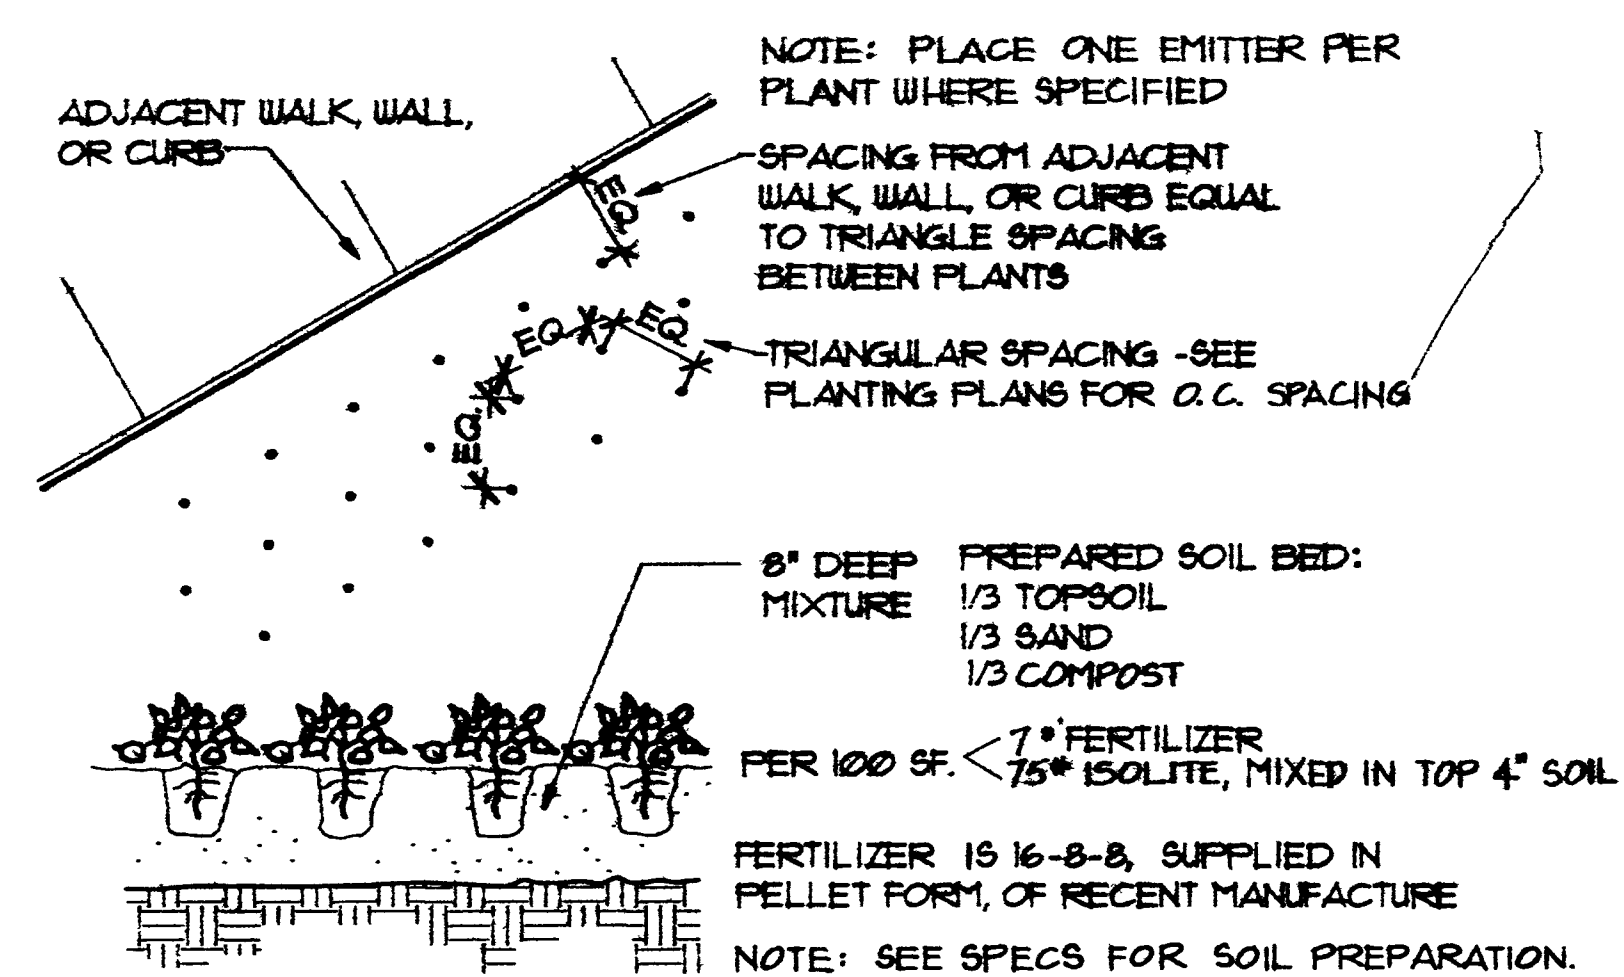


5 ANNUAL/GROUNDCOVER PLANTING DETAIL  
SCALE: NOT TO SCALE

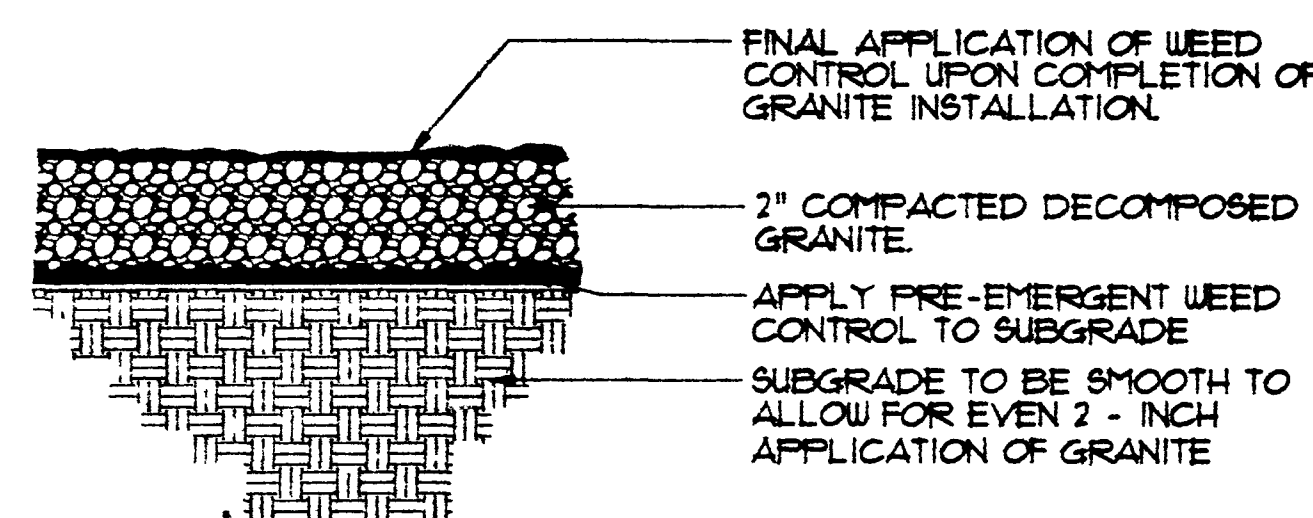


6 DECOMPOSED GRANITE  
SCALE: NOT TO SCALE

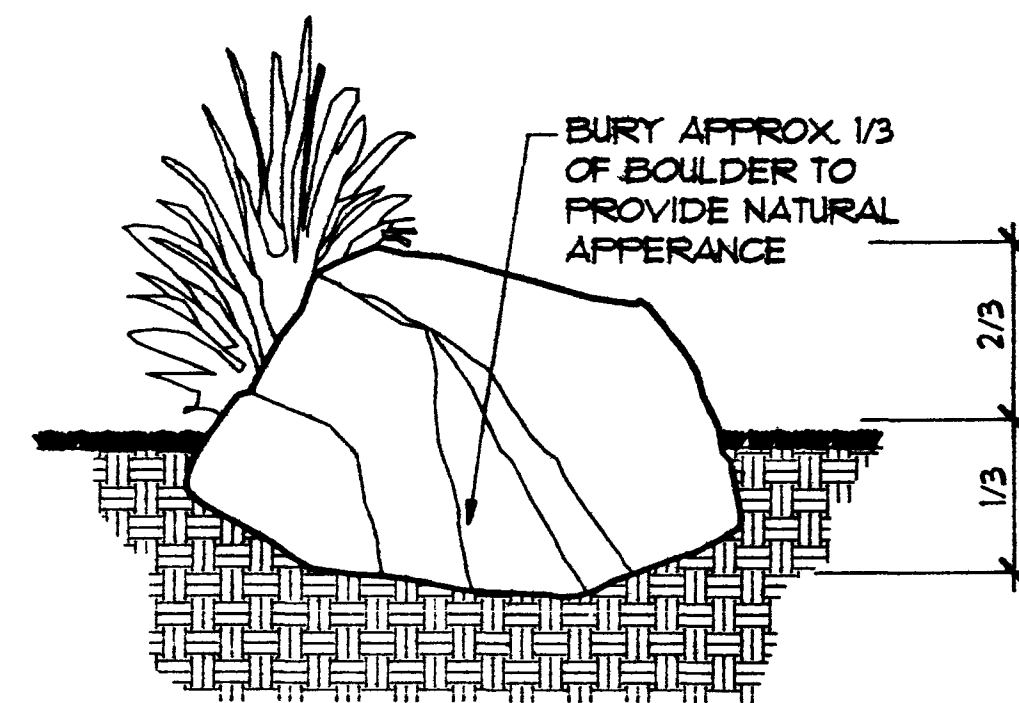

7 BOULDER SETTING DETAIL  
SCALE: NOT TO SCALE

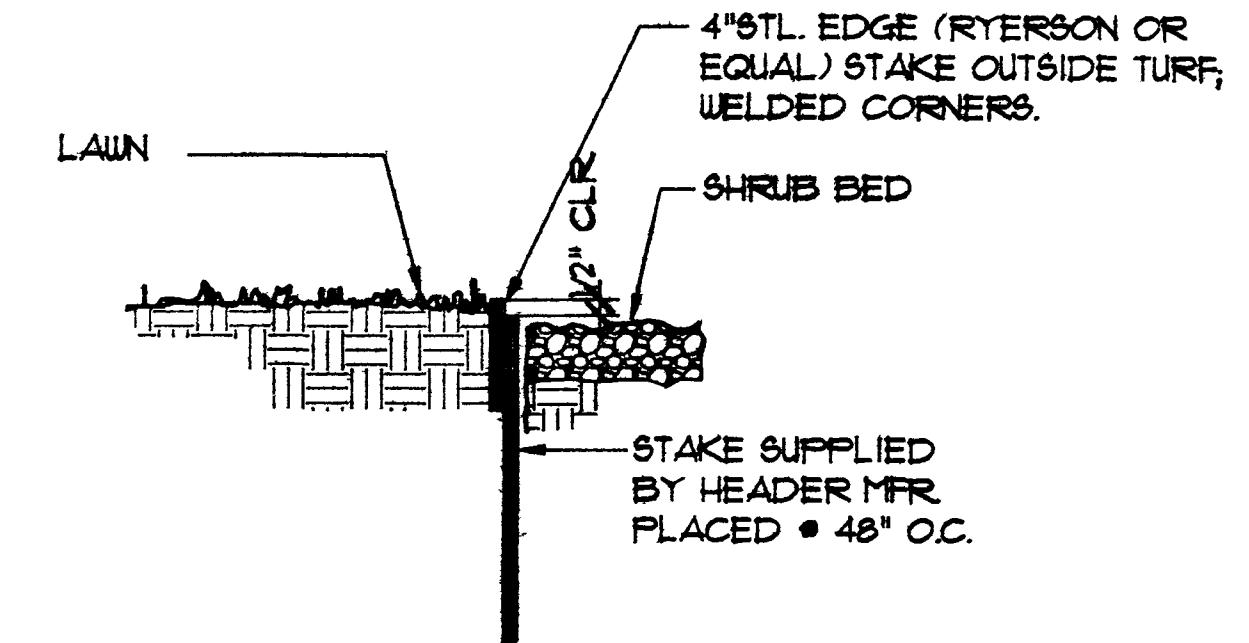


8 STEEL HEADER DETAIL  
SCALE: NOT TO SCALE

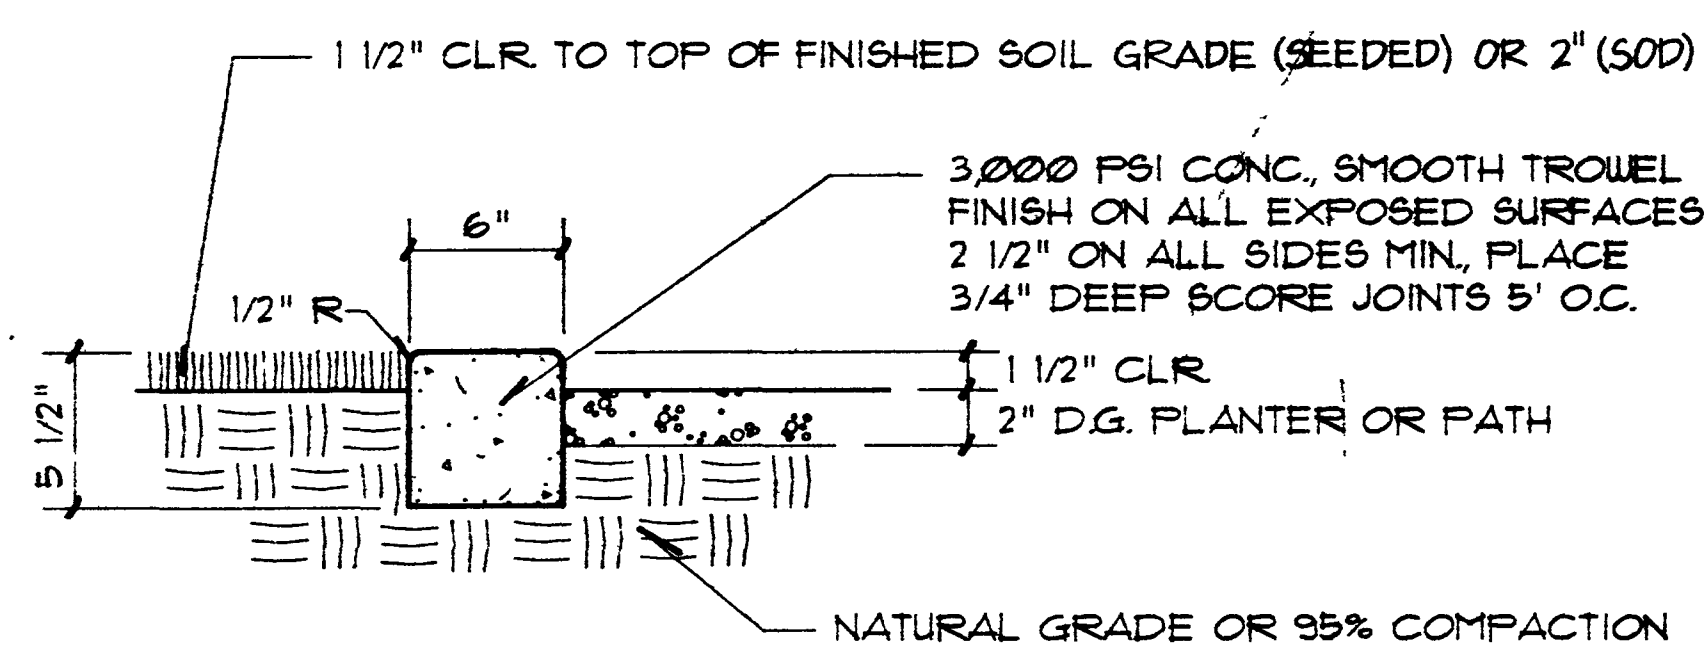

9 CONCRETE CURB DETAIL  
SCALE: NOT TO SCALE


**Harry Campbell Architects**  
1800 East Flamingo Road, Suite 120 Las Vegas, NV 89119 (702) 731-0363 Fax (702) 731-9286  
Do Not Tear This Drawing  
These drawings are instruments of service, and shall remain the property of the Design Professional.

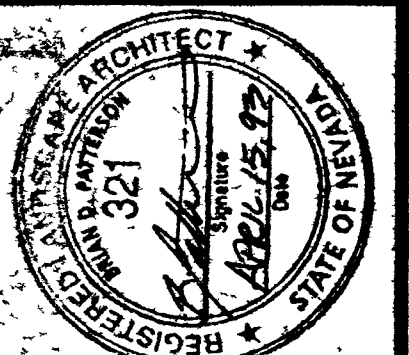


WEST LAS VEGAS ARTS CENTER  
DOOLITTLE PARK - LAS VEGAS, NEVADA  
PLANTING DETAILS  
**AS-BUILT**

|             |         |
|-------------|---------|
| Date        | 8/12/93 |
| Drawn By    |         |
| Checked By  |         |
| Project No. | 4800    |
| Sheet No.   |         |
| Scale       |         |

CEM  
NICKOLAS AMERICAN  
3/28/93

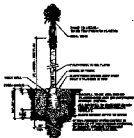

**1 PALM TREE PLANTING DETAIL**  
SEE SEE SHEETS

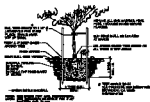

**2 TREE PLANTING DETAIL**  
SEE SEE SHEETS



**3 TREE STAKING DETAIL**  
SEE SEE SHEETS



**4 SHRUB PLANTING DETAIL**  
SEE SEE SHEETS



**5 ANNUAL GROUNDCOVER PLANTING DETAIL**  
SEE SEE SHEETS



**6 DECOMPOSED GRANITE DETAIL**  
SEE SEE SHEETS



**7 BOULDER SETTING DETAIL**  
SEE SEE SHEETS



**8 STONE HEADER DETAIL**  
SEE SEE SHEETS



**9 CONCRETE CURB DETAIL**  
SEE SEE SHEETS

1  
 2  
 3  
 1