



ORIGINAL BLDG BUILDING ADDITION

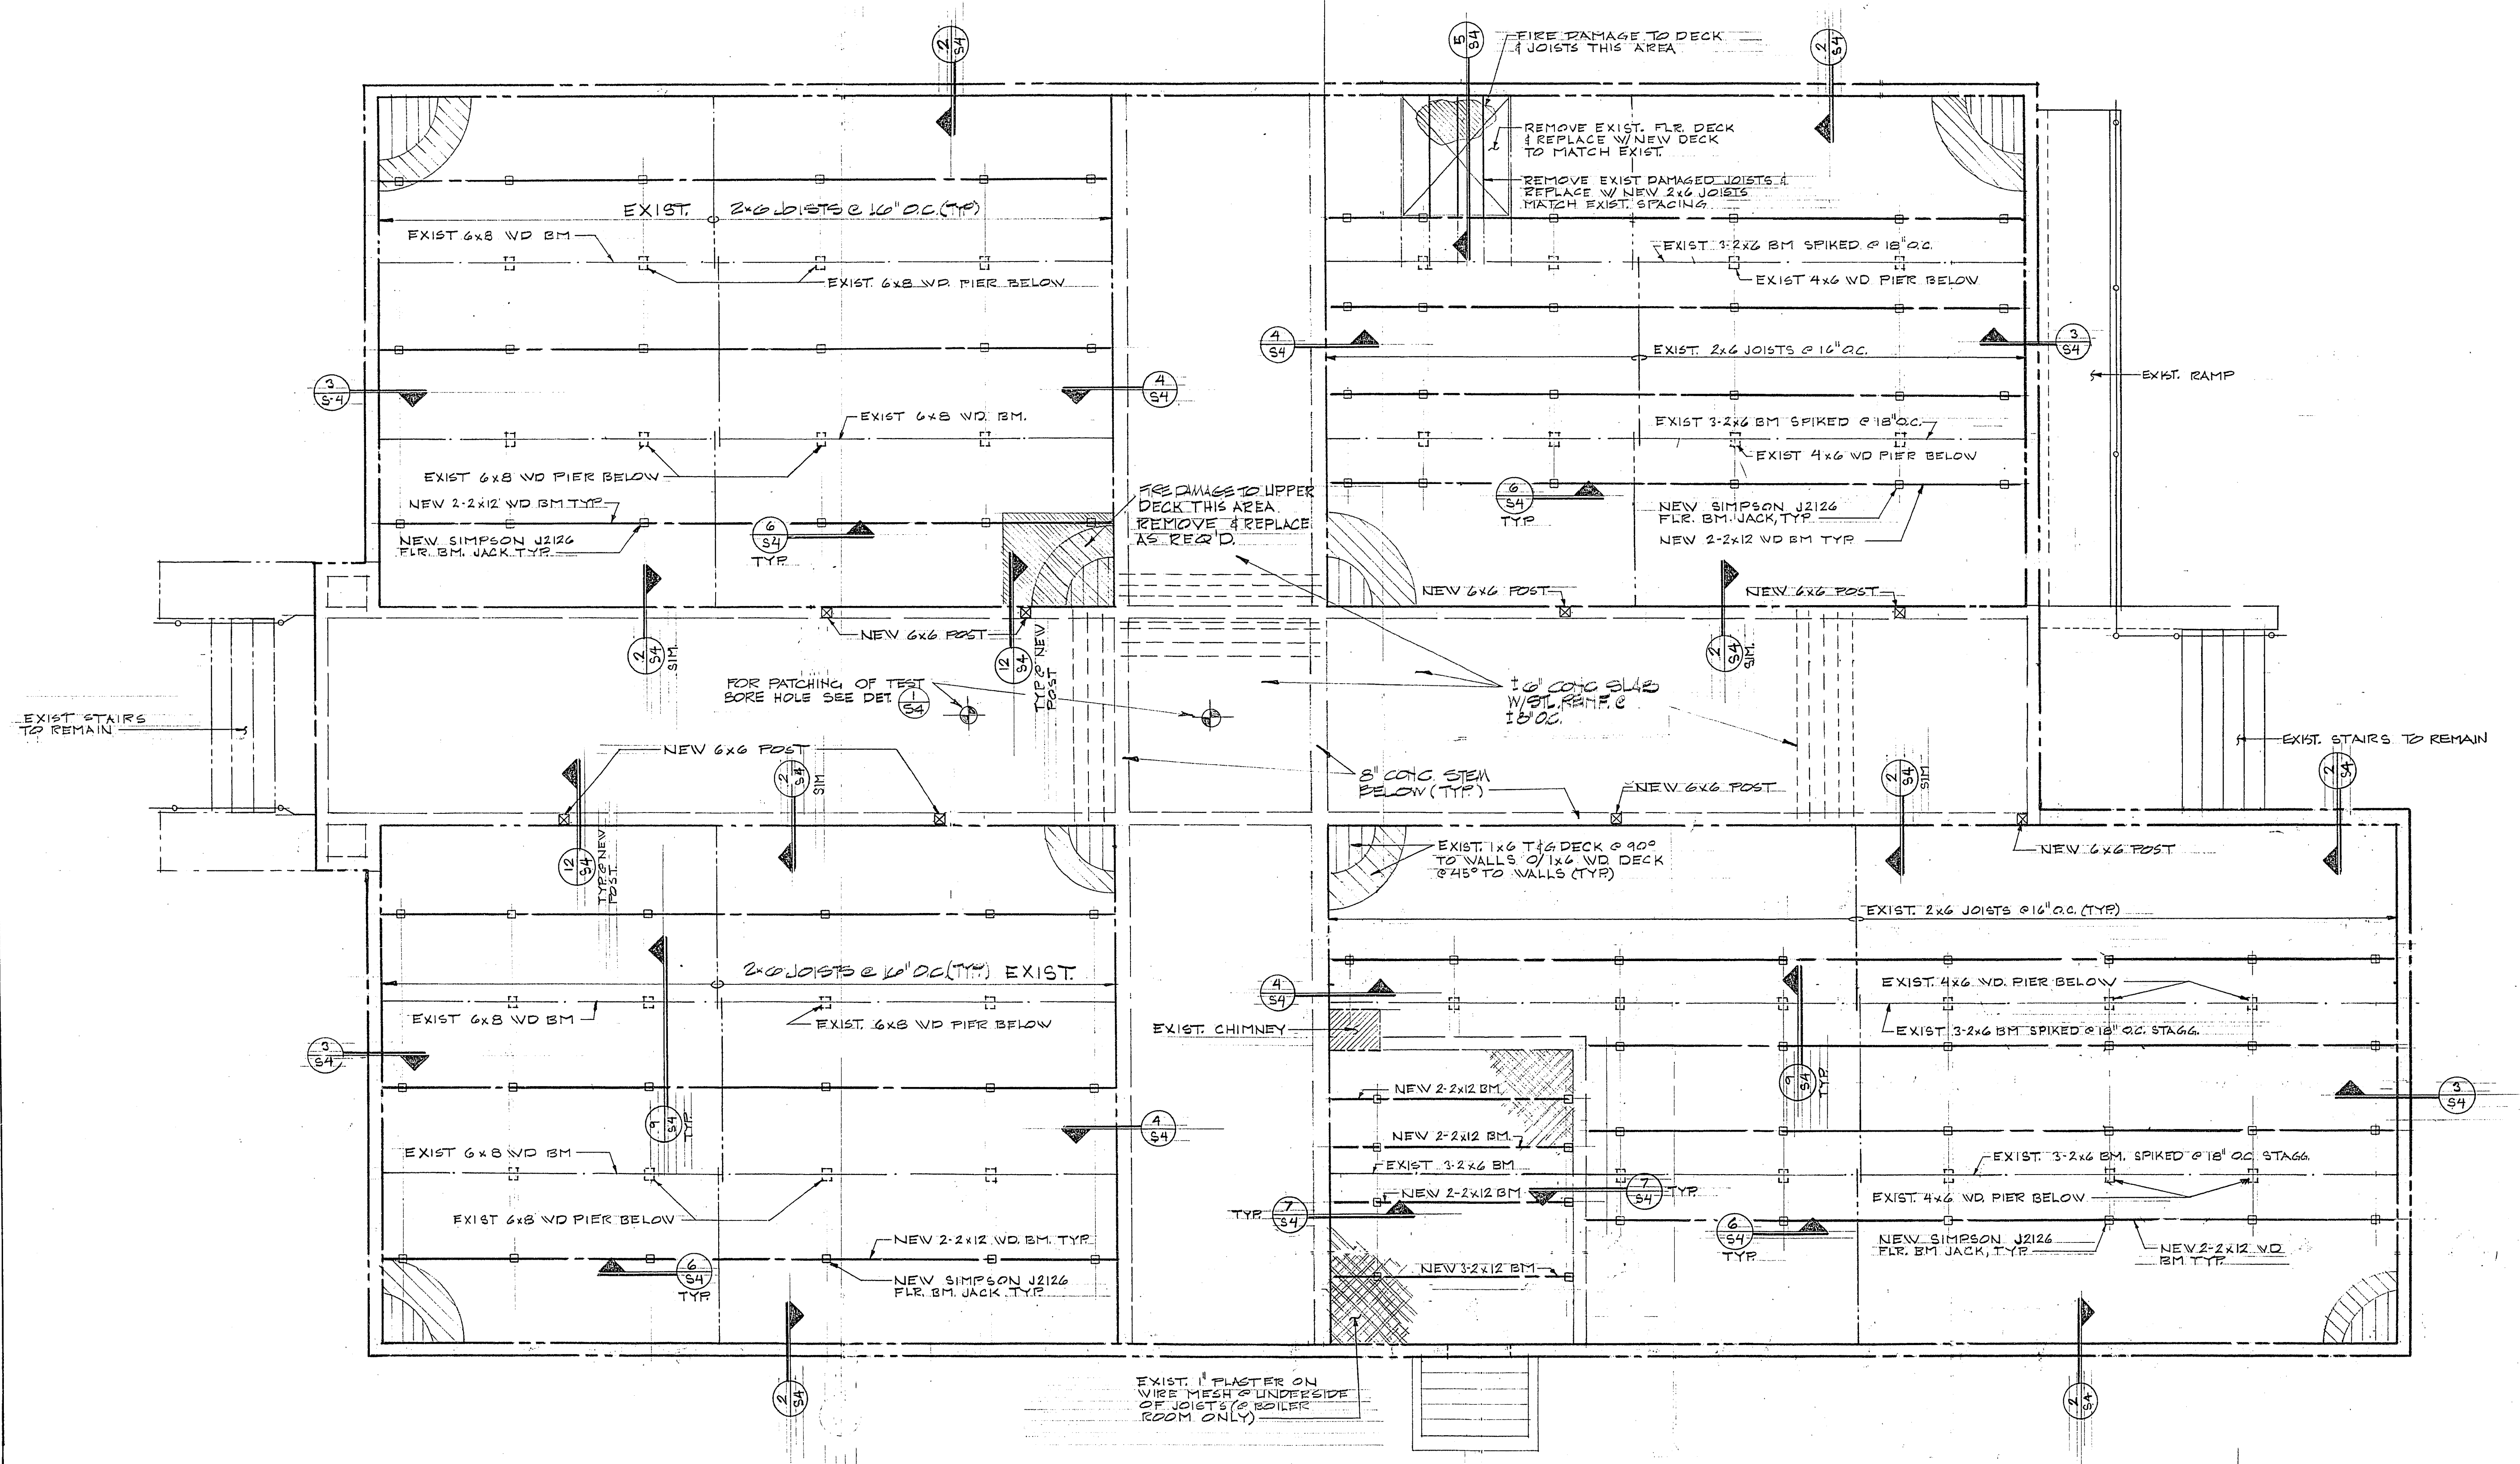


FLOOR FRAMING PLAN
1/4" = 1'-0"

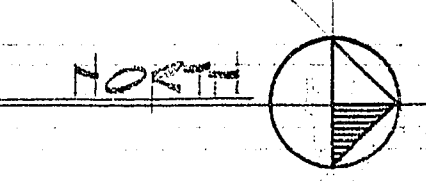

9-23-80	RELEASED FOR BUILDING DEPT. PLAN CHECK
9-16-80	PHASE III REVISIONS
9-3-80	RELEASED FOR PHASE III
NO DATE	REVISION
WEST SIDE SCHOOL	80001
OLD SCHOOL RENOVATION	J.D.B.A.
FOR	F.C.C.
THE CITY OF LAS VEGAS, NEV.	G.A.B.
	SEPT 23, 80

CONTRACT
DRAWING
NOV 30 1982

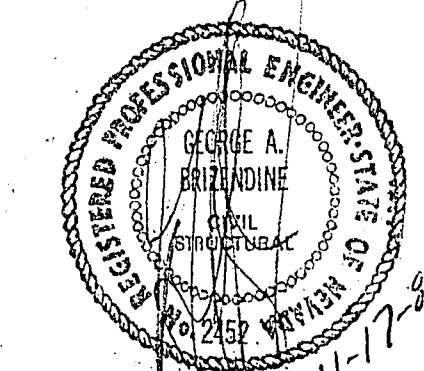

AS BUILT

52