



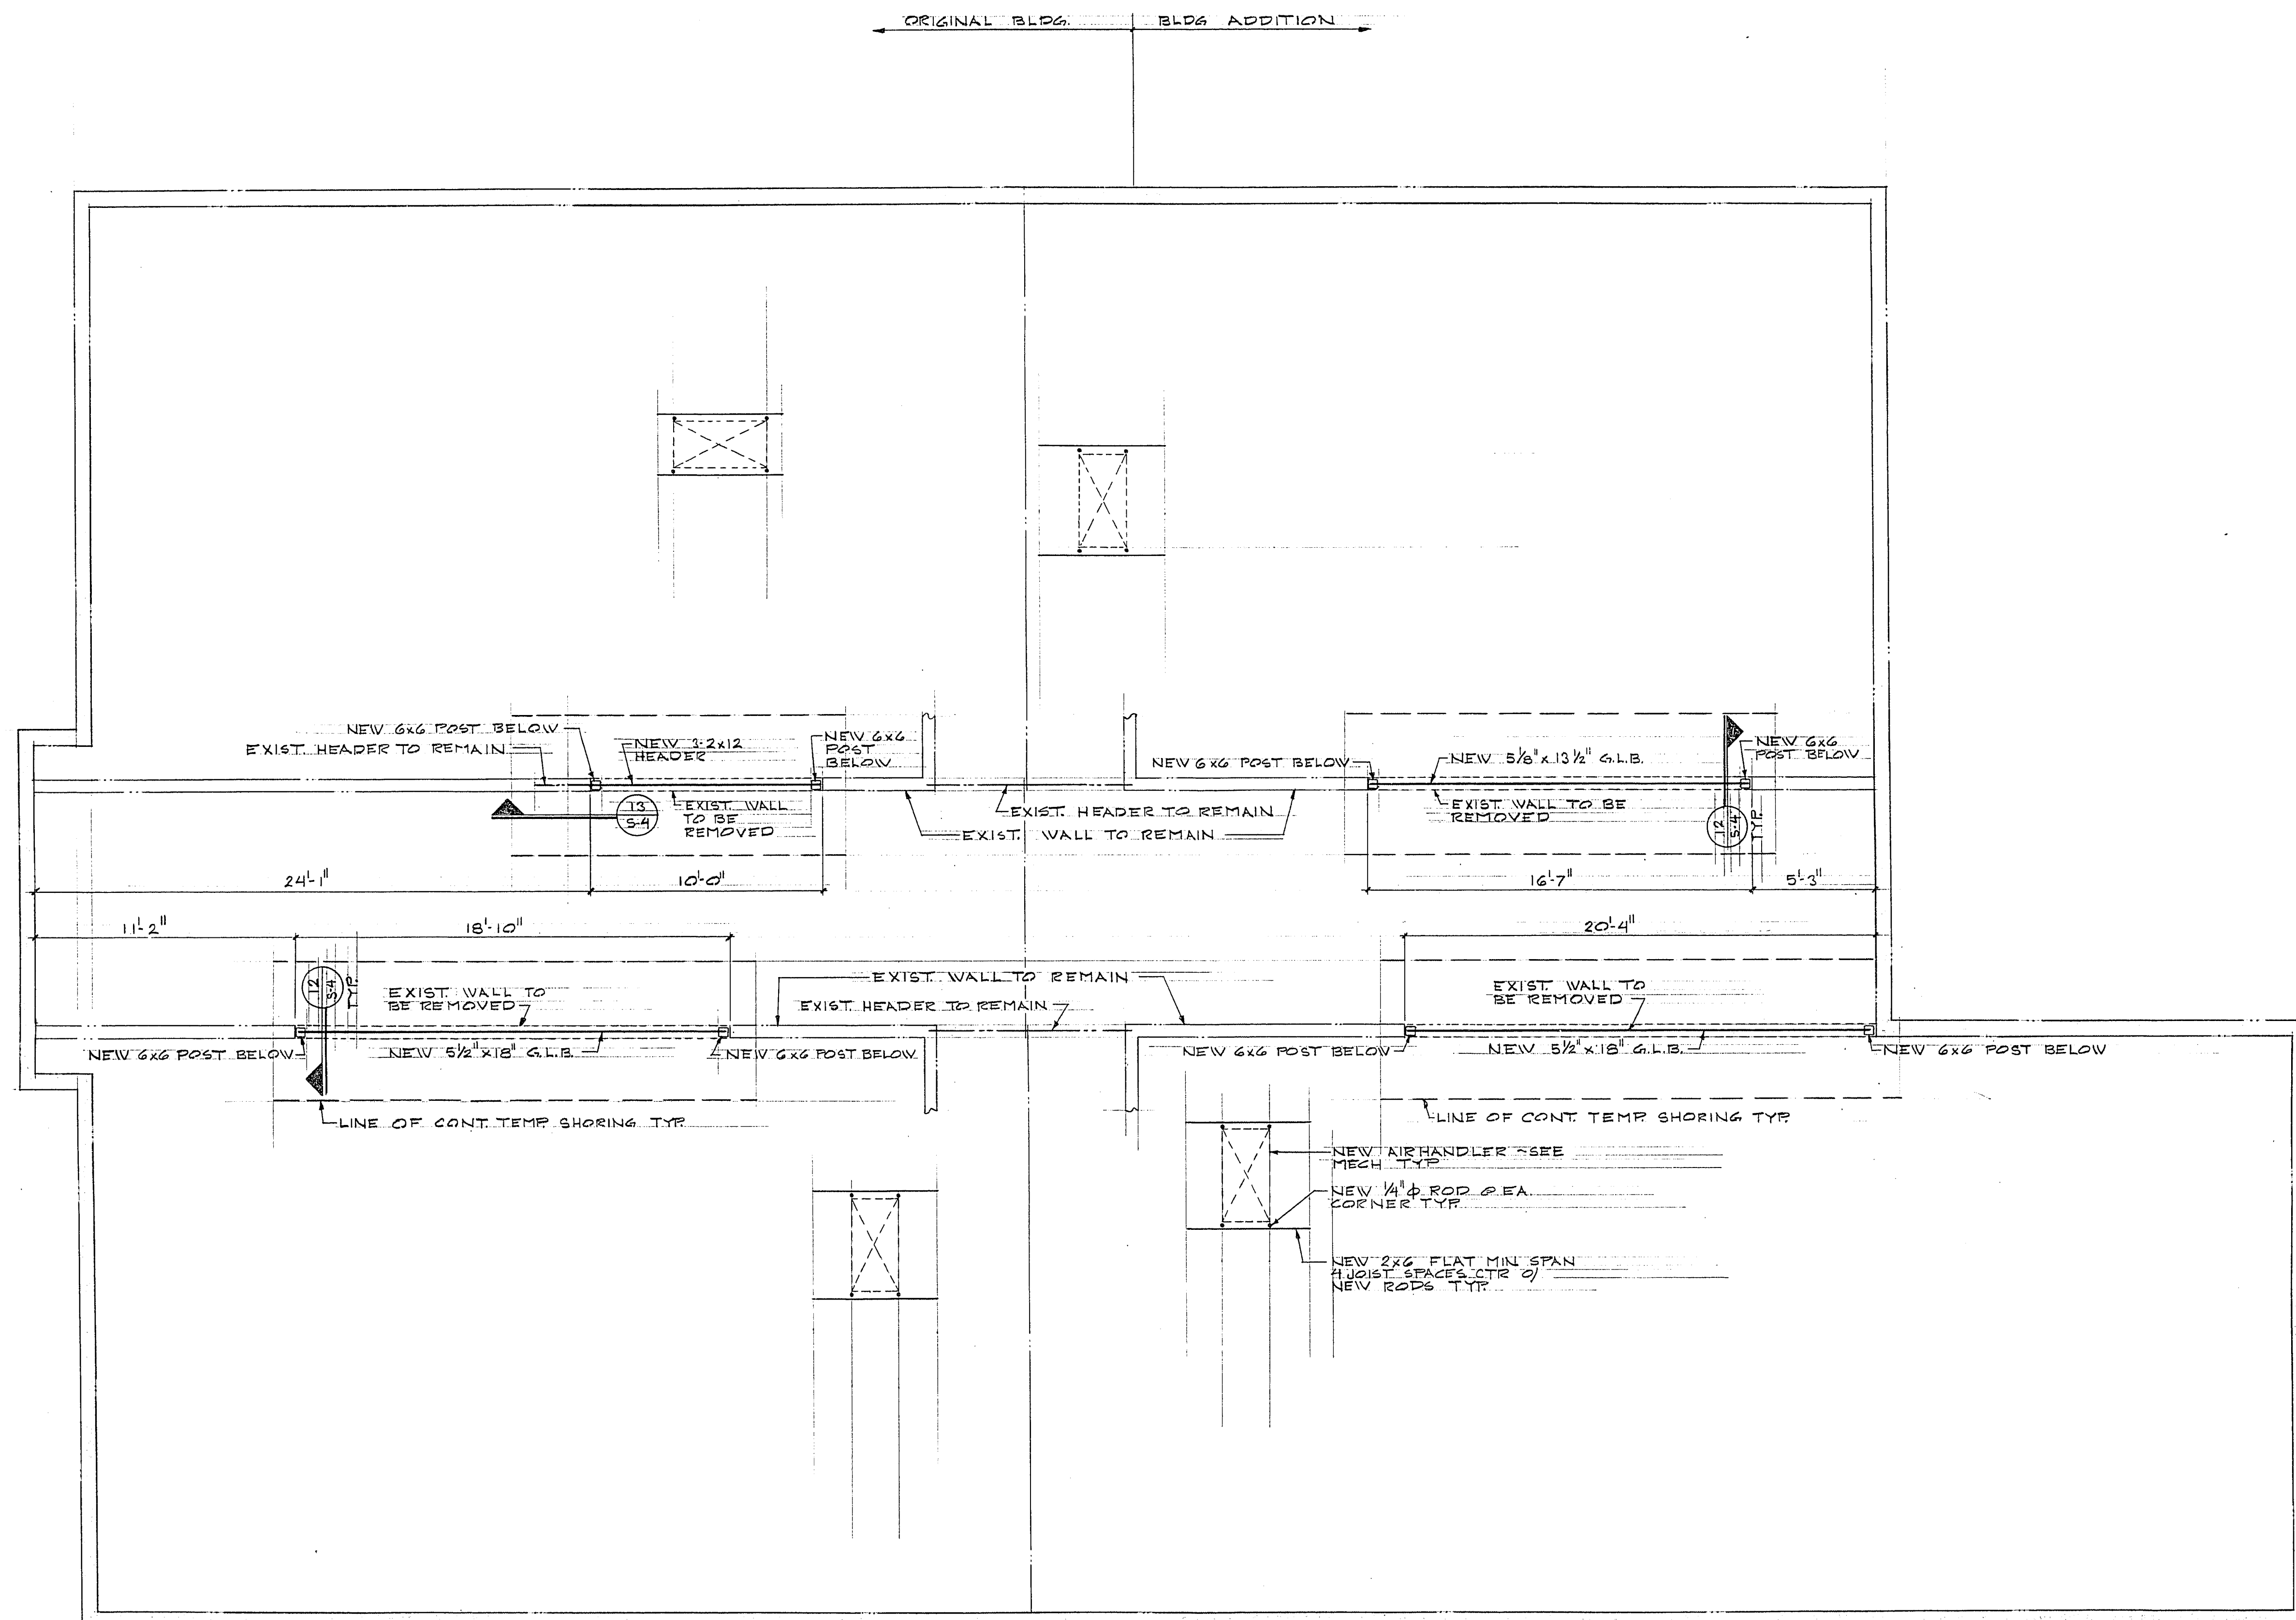

NEW HEADER LOCATION PLAN
1/4" = 1'-0"

CONTRACT
DRAWING
NOV 30 1982

EXIST. CONC. WALL
TO REMAIN

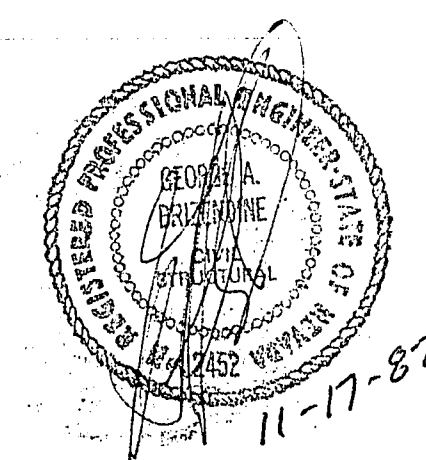

WEST SIDE SCHOOL
OLD SCHOOL-RENOVATION
FOR
THE CITY OF LAS VEGAS, NEV.

800007
J.D.B.A.
FCC
G.A.B.

AS BUILT

53