



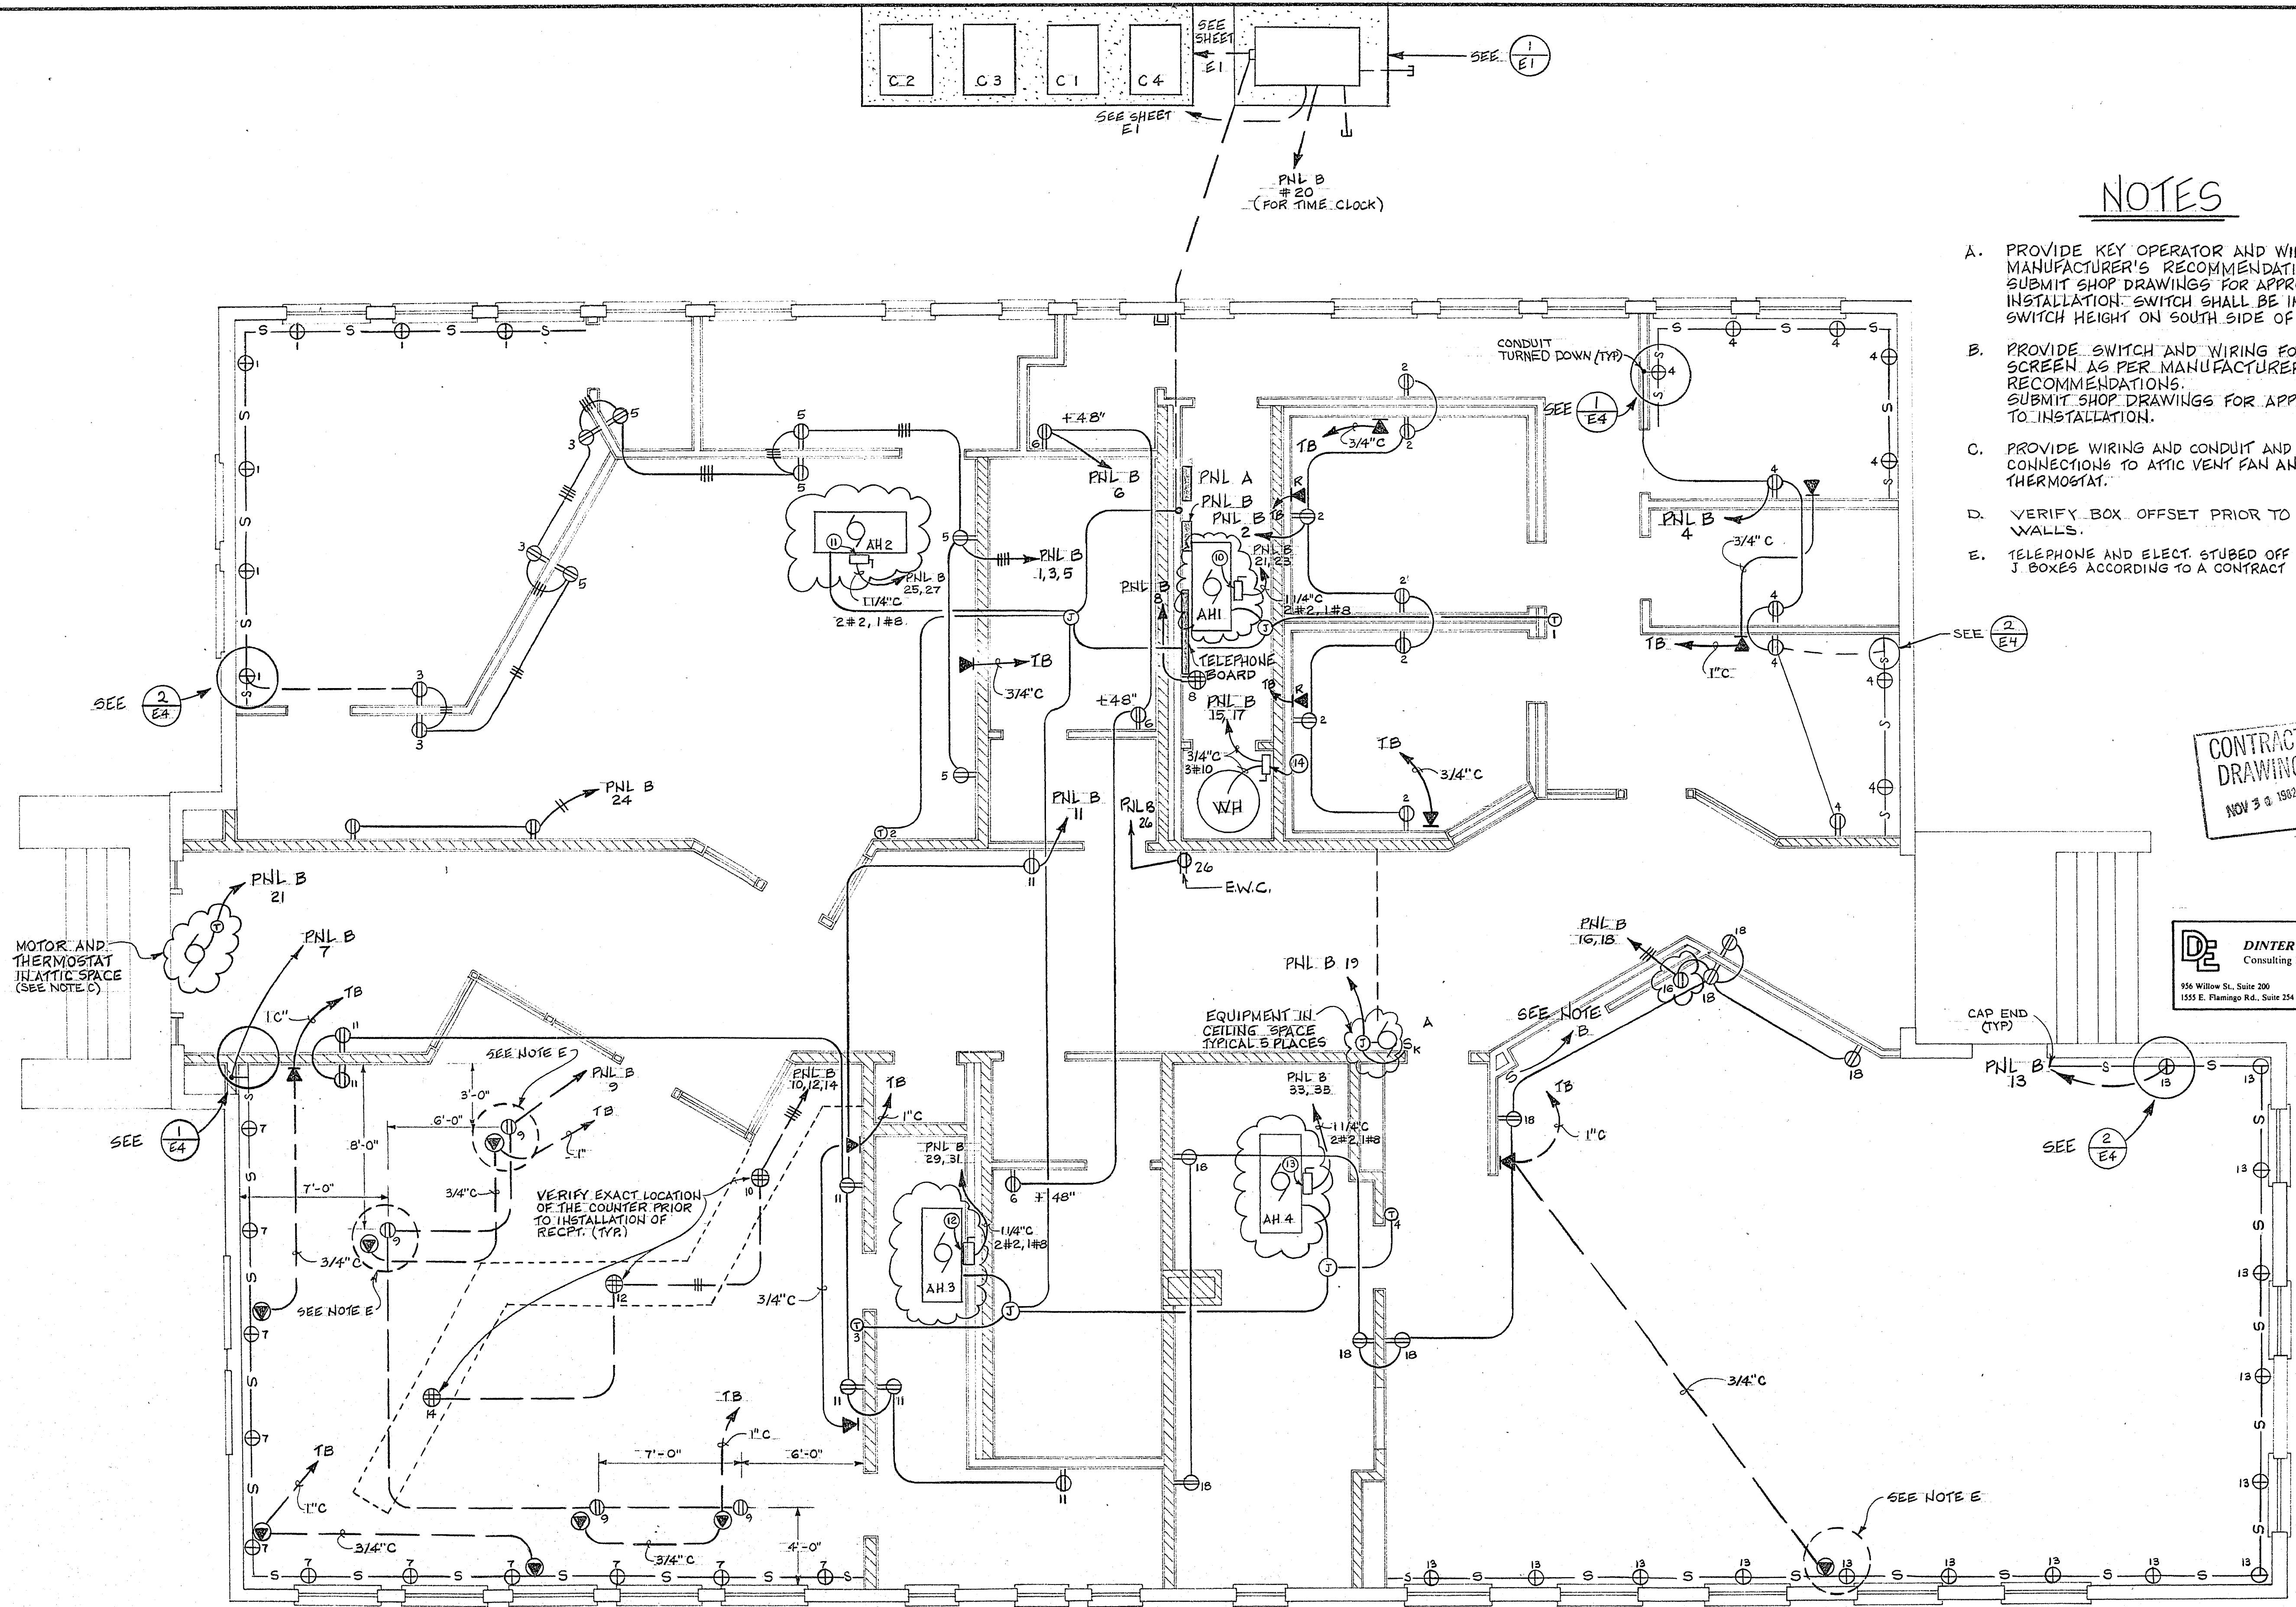


NOTES

- A. PROVIDE KEY OPERATOR AND WIRING AS PER MANUFACTURER'S RECOMMENDATIONS. SUBMIT SHOP DRAWINGS FOR APPROVAL PRIOR TO INSTALLATION. SWITCH SHALL BE INSTALLED AT SWITCH HEIGHT ON SOUTH SIDE OF BARRIER.
- B. PROVIDE SWITCH AND WIRING FOR MOTORIZED SCREEN AS PER MANUFACTURER'S RECOMMENDATIONS. SUBMIT SHOP DRAWINGS FOR APPROVAL PRIOR TO INSTALLATION.
- C. PROVIDE WIRING AND CONDUIT AND MAKE NECESSARY CONNECTIONS TO ATTIC VENT FAN AND LINE VOLTAGE THERMOSTAT.
- D. VERIFY BOX OFFSET PRIOR TO MOUNTING IN WALLS.
- E. TELEPHONE AND ELECT. STUBED OFF UNDER FLOOR IN J BOXES ACCORDING TO A CONTRACT MODIFICATION.

CONTRACT
DRAWING
NOV 3 1982

DINTER ENGINEERING CO., Ltd.
Consulting Electrical & Mechanical Engineers
956 Willow St., Suite 200 Reno Nevada 89502 (702) 329-0206
1555 E. Flamingo Rd., Suite 254 Las Vegas Nevada 89109 (702) 369-3139

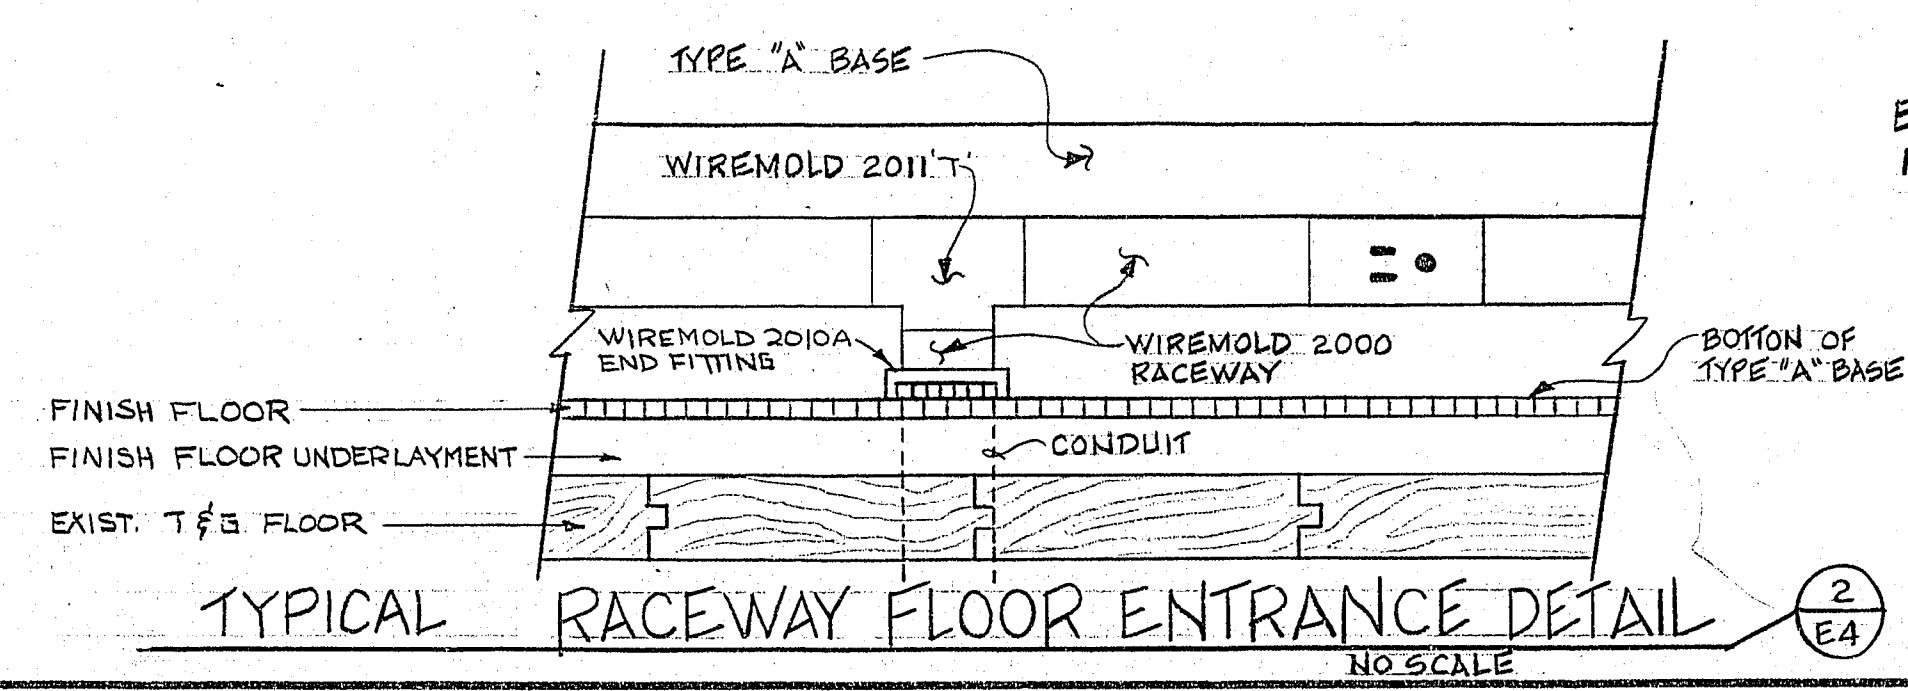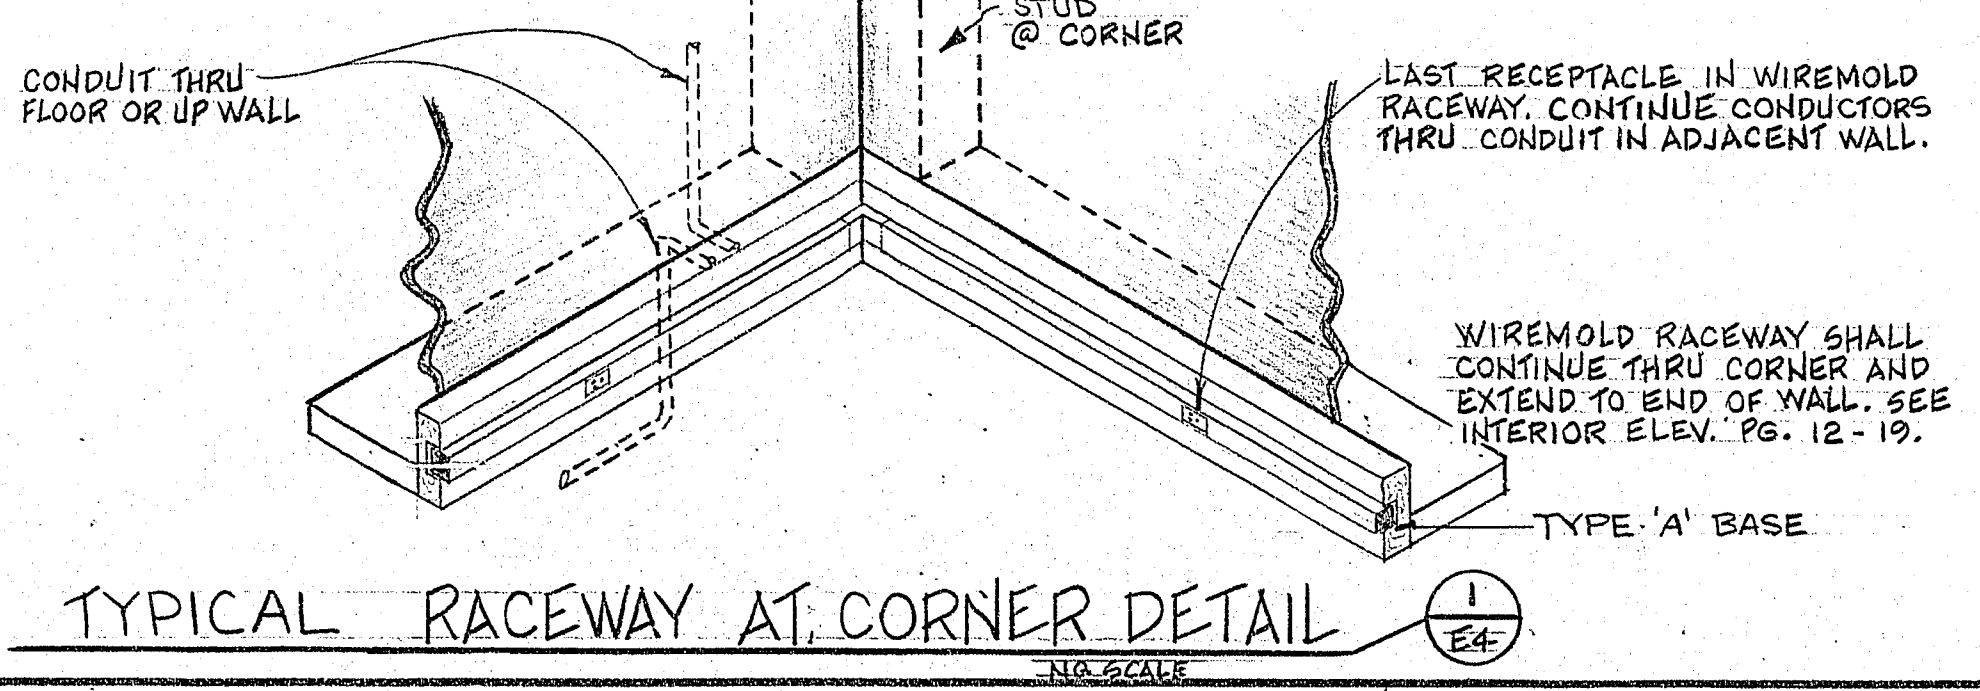

BONGBERG - WHITNEY INC.
1816 INDUSTRIAL RD.
LAS VEGAS - NEVADA
382 - 1371

AS BUILT

Department of Public Services		Engineering Design Division	
WEST SIDE SCHOOL RENOVATION		POWER AND TELEPHONE PLAN	
Scale (h) 1/4" = 1'-0"		Scale (v) W.U. 2 1/2 G2	Revisions
Fid. bk. no.		Date AUG. 1982	Date
Design by M. GOODMAN		Drawn by NORMA GOMEZ	
APPROVED BY CITY ENGINEER			
Professional Engineer State of Nevada No. 5411			
Drawing no. 513 - 53		E4/57	