
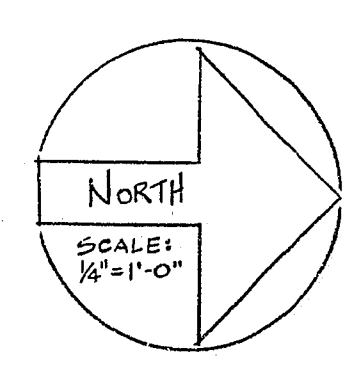


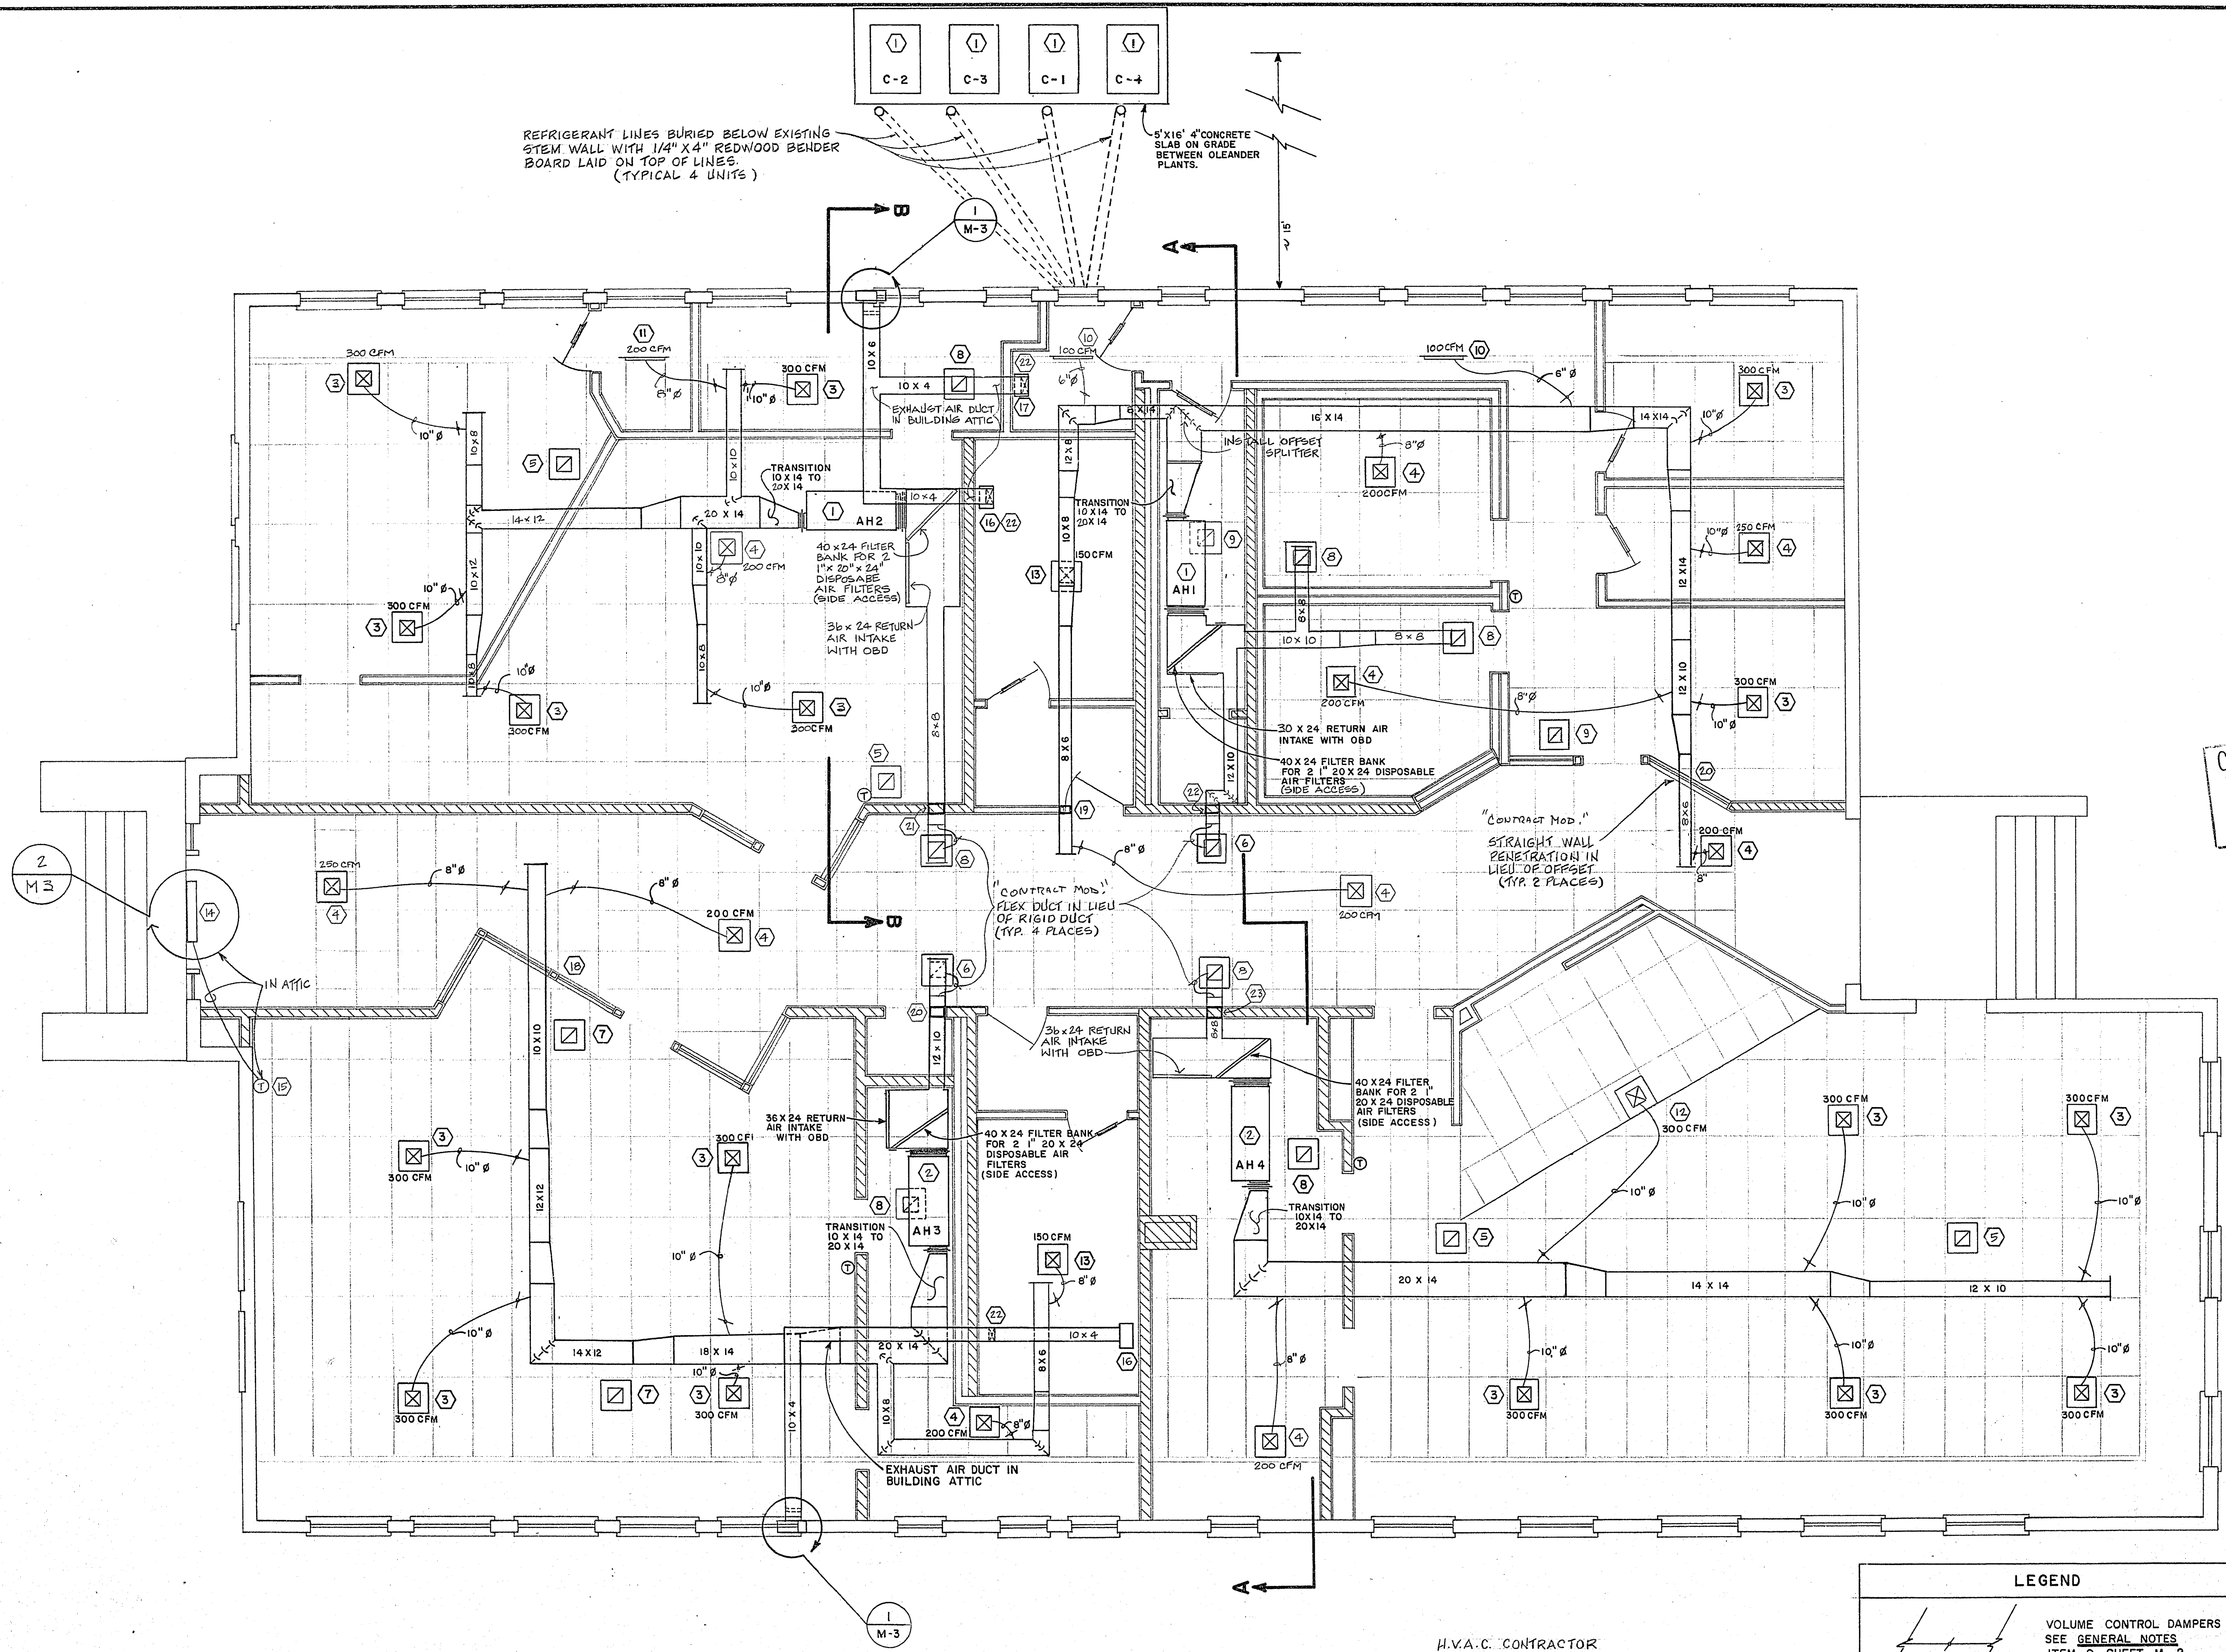

CONTRACT  
DRAWING  
NOV 3 8 1982

H.V.A.C. CONTRACTOR  
ADVANCE MECHANICAL, INC.  
2280 CRESTLINE LR.  
N. LAS VEGAS,  
NEVADA 89030

LEGEND  
VOLUME CONTROL DAMPERS  
SEE GENERAL NOTES  
ITEM 9 SHEET M-2

AS BUILT

|                               |  |                                          |  |
|-------------------------------|--|------------------------------------------|--|
| Department of Public Services |  | Engineering Design Division              |  |
| WEST SIDE SCHOOL RENOVATION   |  | HEATING VENTILATION AND AIR CONDITIONING |  |
| Drawing no. 513-53            |  | M-57                                     |  |
| Scale (h) 1/4" = 1'-0"        |  | Scale (v) W.A. 2041                      |  |
| Fid. bk. no. N/A              |  | Date 9-30-80                             |  |
| Design by BERT ANZAI          |  | Drawn by NORMA GOMEZ                     |  |
| APPROVED BY CHY. ENGINEER     |  | Revisions                                |  |
| Date                          |  | Date                                     |  |