

bid no.
83-3550.4



COMMUNITY DEVELOPMENT
BLOCK GRANT FUNDED PROJECT

City of Las Vegas
Nevada

mayor:
Bill Briare



commissioners:
Ron Lurie
Paul J. Christensen
Al Levy
William U. Pearson

city manager:
Russell W. Dorn

department of public services:
Donald E. Donovan, director


office of architectural services
and project control:
Thomas B. Graham, director

WEST SIDE SCHOOL
RENOVATION

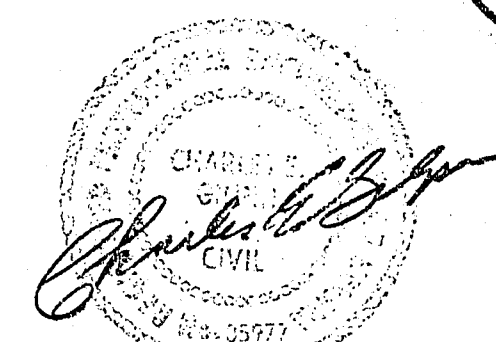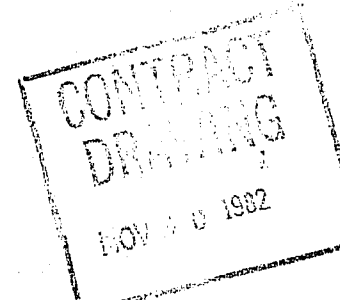

AS BUILT

location map

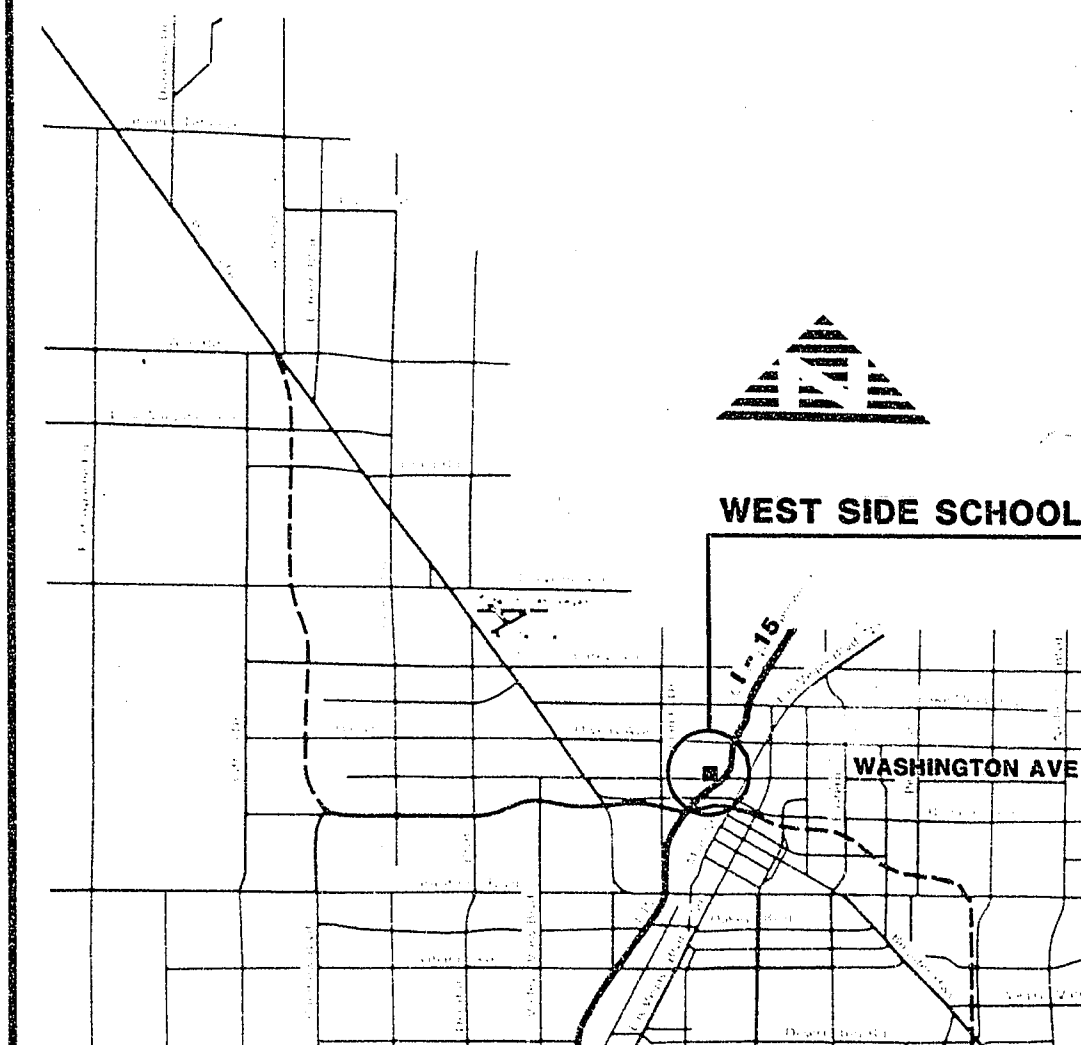

index of sheets

no.	description
1	COVER SHEET
2	SITE PLAN
3	DEMOLITION FLOOR PLAN
4	CORRIDOR DEMOLITION ELEVATIONS
5	CEILING DEMOLITION PLAN
6	CONSTRUCTION FLOOR PLAN
7	CONSTRUCTION CEILING PLAN
8	CONSTRUCTION CEILING DETAILS
9	CROSS SECTIONS A & B
10	CROSS SECTIONS C & D
11	CROSS SECTIONS E & F
12-19	INTERIOR ELEVATIONS
19	FINISH SCHEDULE
20	TYPICAL DETAILS
21	CONSTRUCTION DETAILS & SECTIONS
22	RAISED PLATFORM & VISUAL DISPLAY WALL
23	DISPLAY CASE DETAILS
24	COUNTER PLAN, ELEVATIONS, DETAILS
25	WINDOW ELEVATIONS 1, 2, 3
26	WINDOW ELEVATIONS 4, 5, 10
27	WINDOW ELEVATIONS 11, 12, 13
28	WINDOW ELEVATIONS 14, 18, 19
29	WINDOW ELEVATIONS 20, 21, 22
30	WINDOW ELEVATIONS 27, 28, 29
31	WINDOW ELEVATIONS 30, 31
32	WINDOW ELEVATIONS 6, 7, 8, 9
33	WINDOW ELEVATIONS 23, 24, 25, 26
34	WINDOW ELEVATIONS 15, 16, 17
35	WINDOW TYPE "A" DIMENSIONS & DETAILS
36	WINDOW TYPE "B" DIMENSIONS & DETAILS
37	WINDOW TYPE "C" DIMENSIONS & DETAILS
38	DOOR "A" ELEVATIONS
39	DOOR "C" SECTION & DETAILS
40	DOORS "A" & "C" DETAILS
41	DOOR "B" ELEVATIONS & DETAILS
42	DOOR & INTERIOR WINDOW SCHEDULES
51	FOUNDATION PLAN
52	FLOOR FRAMING PLAN
53	NEW HEADER LOCATION PLAN
54	STRUCTURAL DETAILS
55	GENERAL NOTES
E1-E4	ELECTRICAL
M1-M3	MECHANICAL
P1-P3	PLUMBING

no. description by date app.
revisions

agency	approved date
Director of Comm. Plan. & Dev.	N/A
Director of Rec. & Leisure Activities	N/A
Director of Fire Services	11-4-82
Director of Arch. Serv. & Proj. Control	11-4-82
Director of Building & Safety	11-4-82
Director of Funds Coordination	11-4-82

agency	approved date
Deputy City Manager	11/2/82
Director of Public Services	11/2/82
City Engineer	11/5/82
Field Operations, Engineer	N/A
Chief of Engineering Design	11/3/82
Chief of Traffic	N/A
Chief of Quality Control	11/4/82
Chief of Electrical Services	N/A
Chief of Sanitation	N/A

agency	approved date
Regional Transportation Commission	N/A
Nevada State Dept. of Transportation	N/A
Central Telephone Company	N/A
Las Vegas Valley Water District	N/A
Nevada Power Company	N/A
Southwest Gas Corporation	N/A

date
drawing number 513-53
sheet 1 of 57