



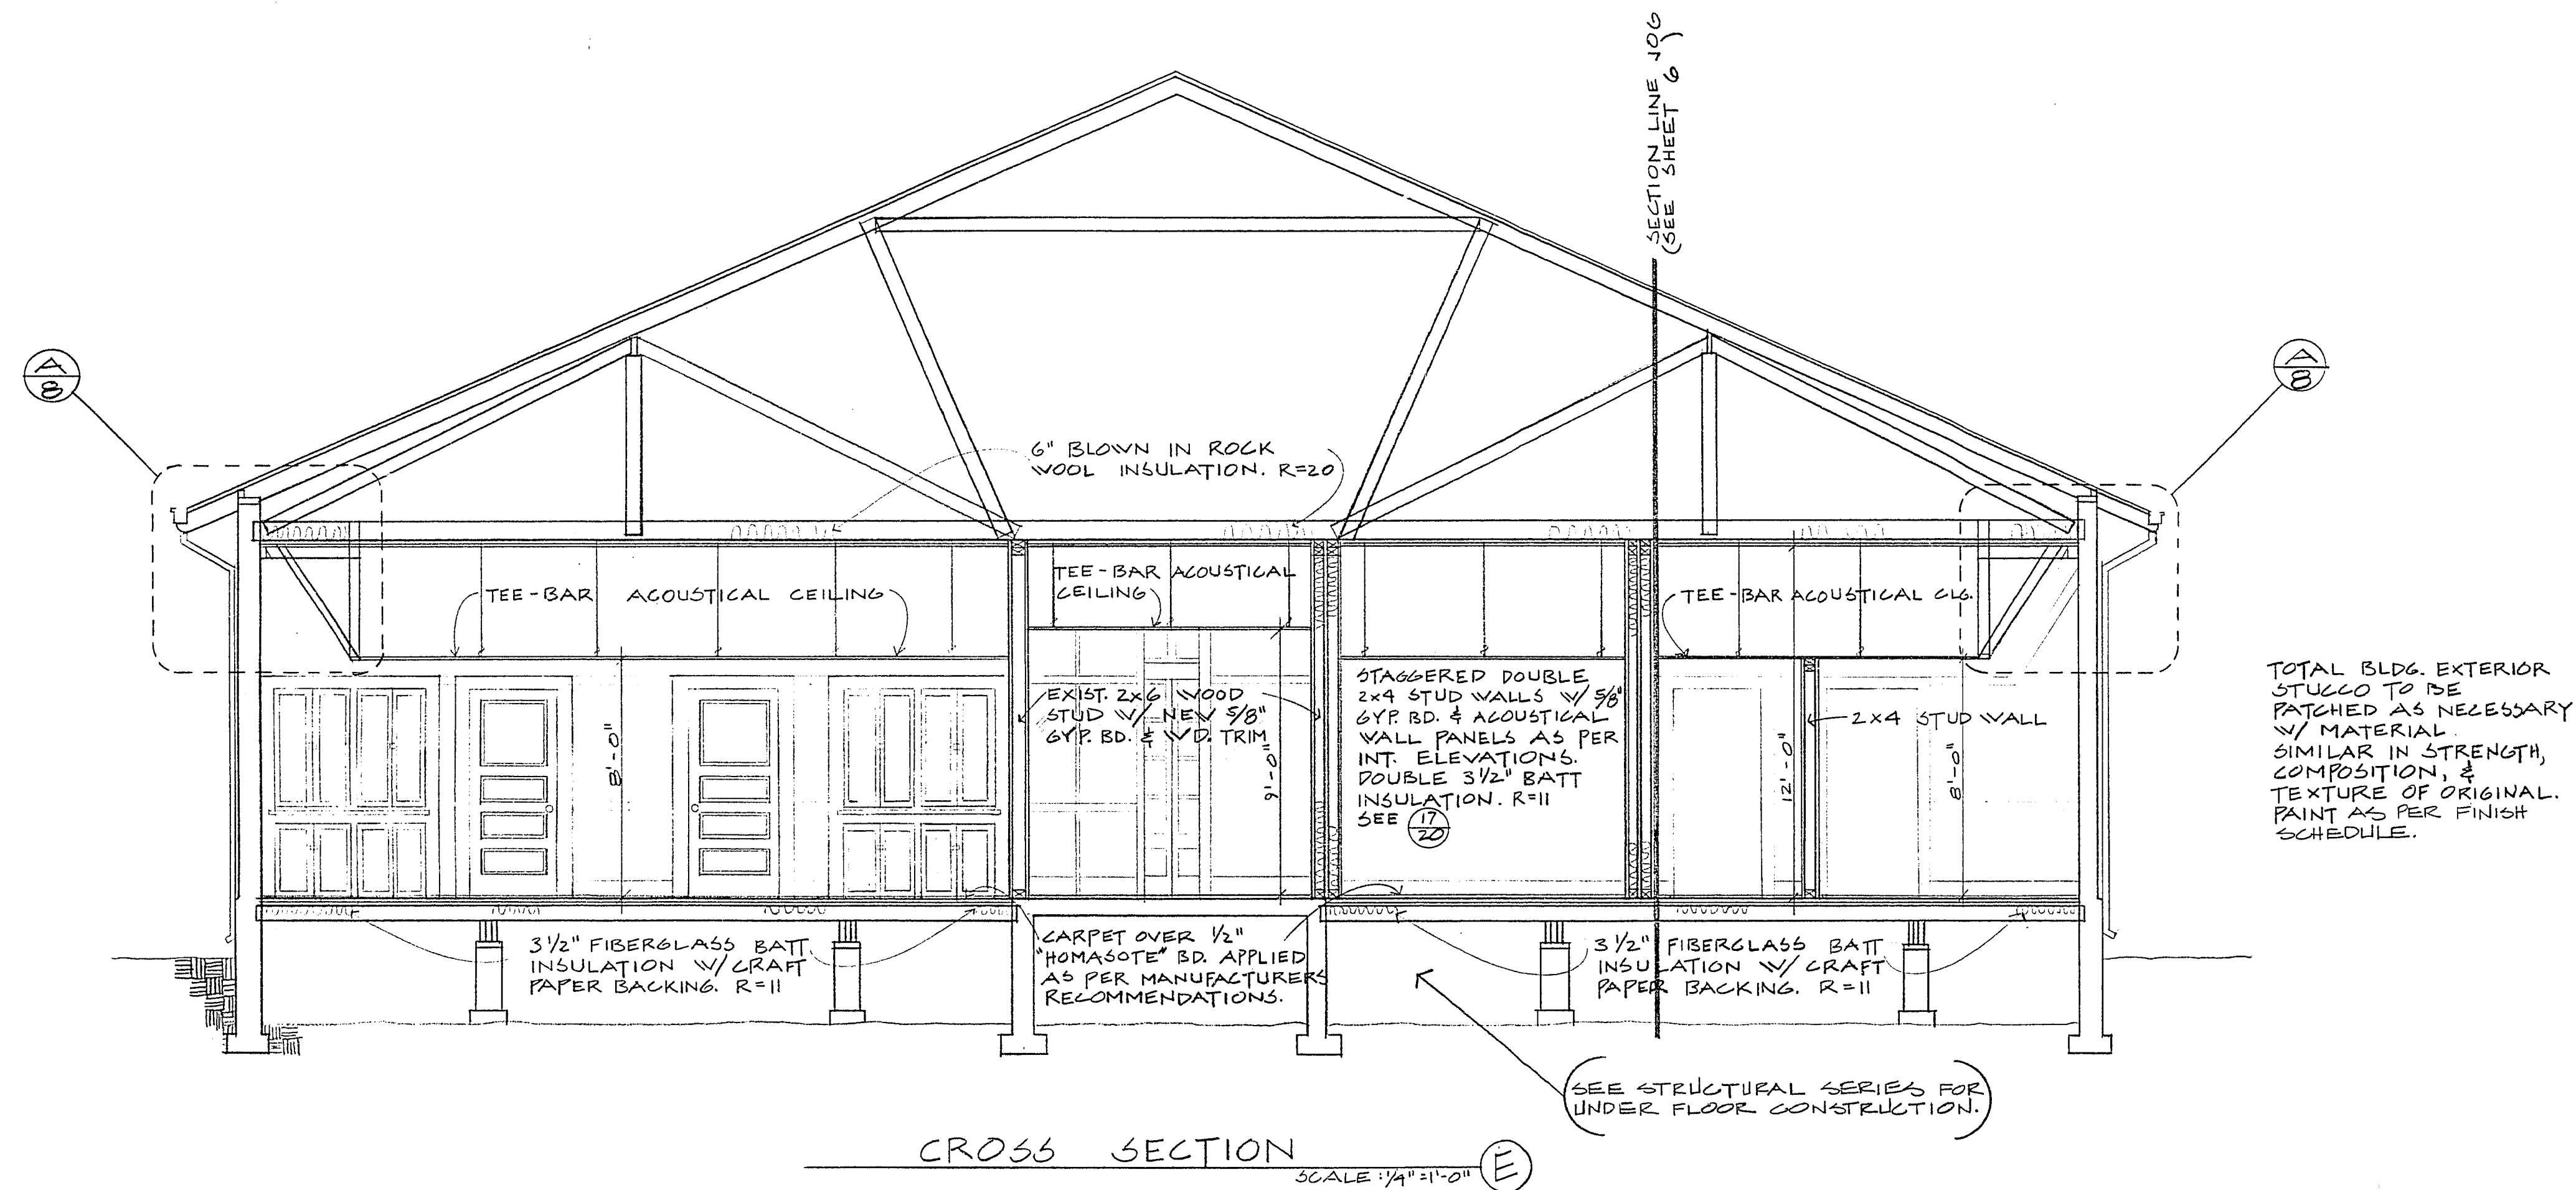

TOTAL BLDG. EXTERIOR STUCCO TO BE PATCHED AS NECESSARY W/ MATERIAL SIMILAR IN STRENGTH, COMPOSITION, & TEXTURE OF ORIGINAL. PAINT AS PER FINISH SCHEDULE.

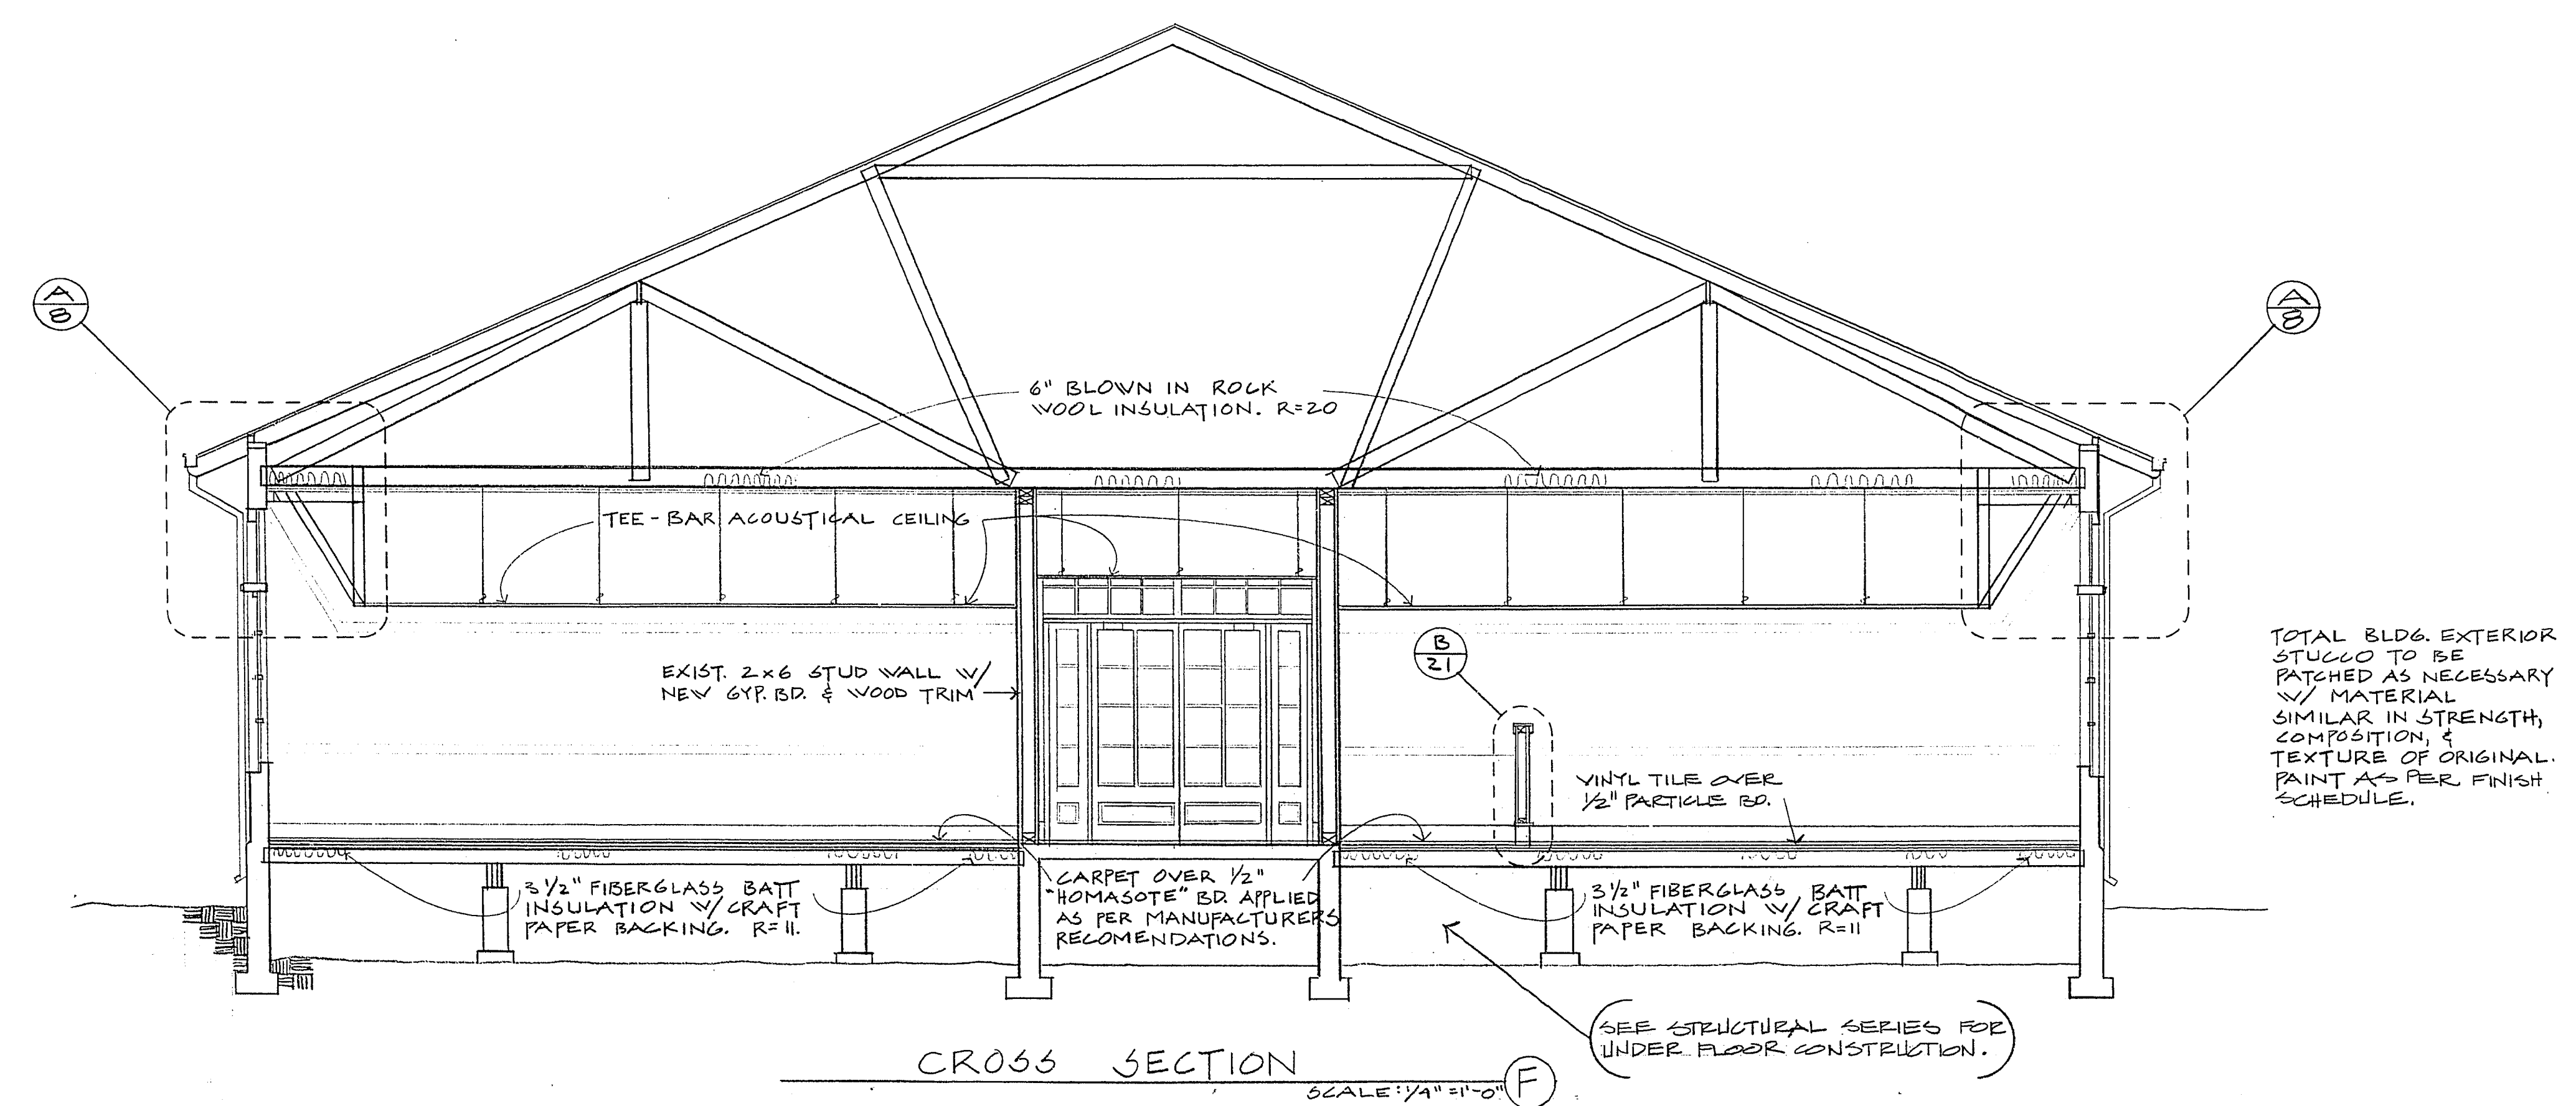


TOTAL BLDG. EXTERIOR STUCCO TO BE PATCHED AS NECESSARY W/ MATERIAL SIMILAR IN STRENGTH, COMPOSITION, & TEXTURE OF ORIGINAL. PAINT AS PER FINISH SCHEDULE.

CONTRACT
DEVELOPED
NOV 3 0 1982

AS BUILT

11-18-82

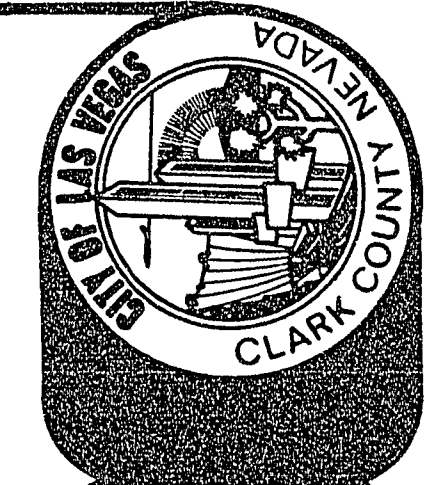

City of Las Vegas, Nevada
Office of Architectural Services and Project Control
 Dan J. Saylor A.I.P. Deputy City Manager

WEST SIDE SCHOOL RENOVATION
 CROSS SECTIONS E & F

Design By: RRIUEG&E	Date: 8-82	Revised By:	Date:
Drawn By: ESTUPIANO	Date: 8-82	Revised By:	Date:
Division: TECHNICAL SERVICES	Scale: 1/4" = 1'-0"		

