

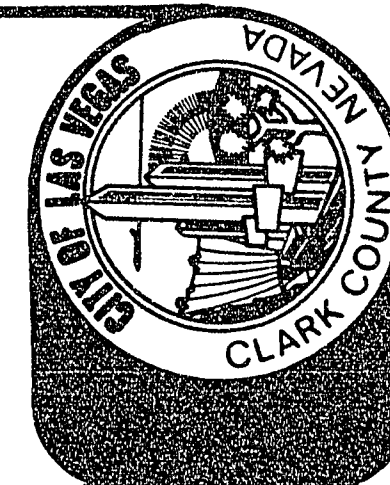
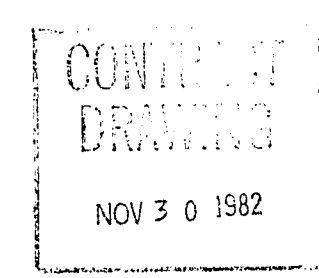
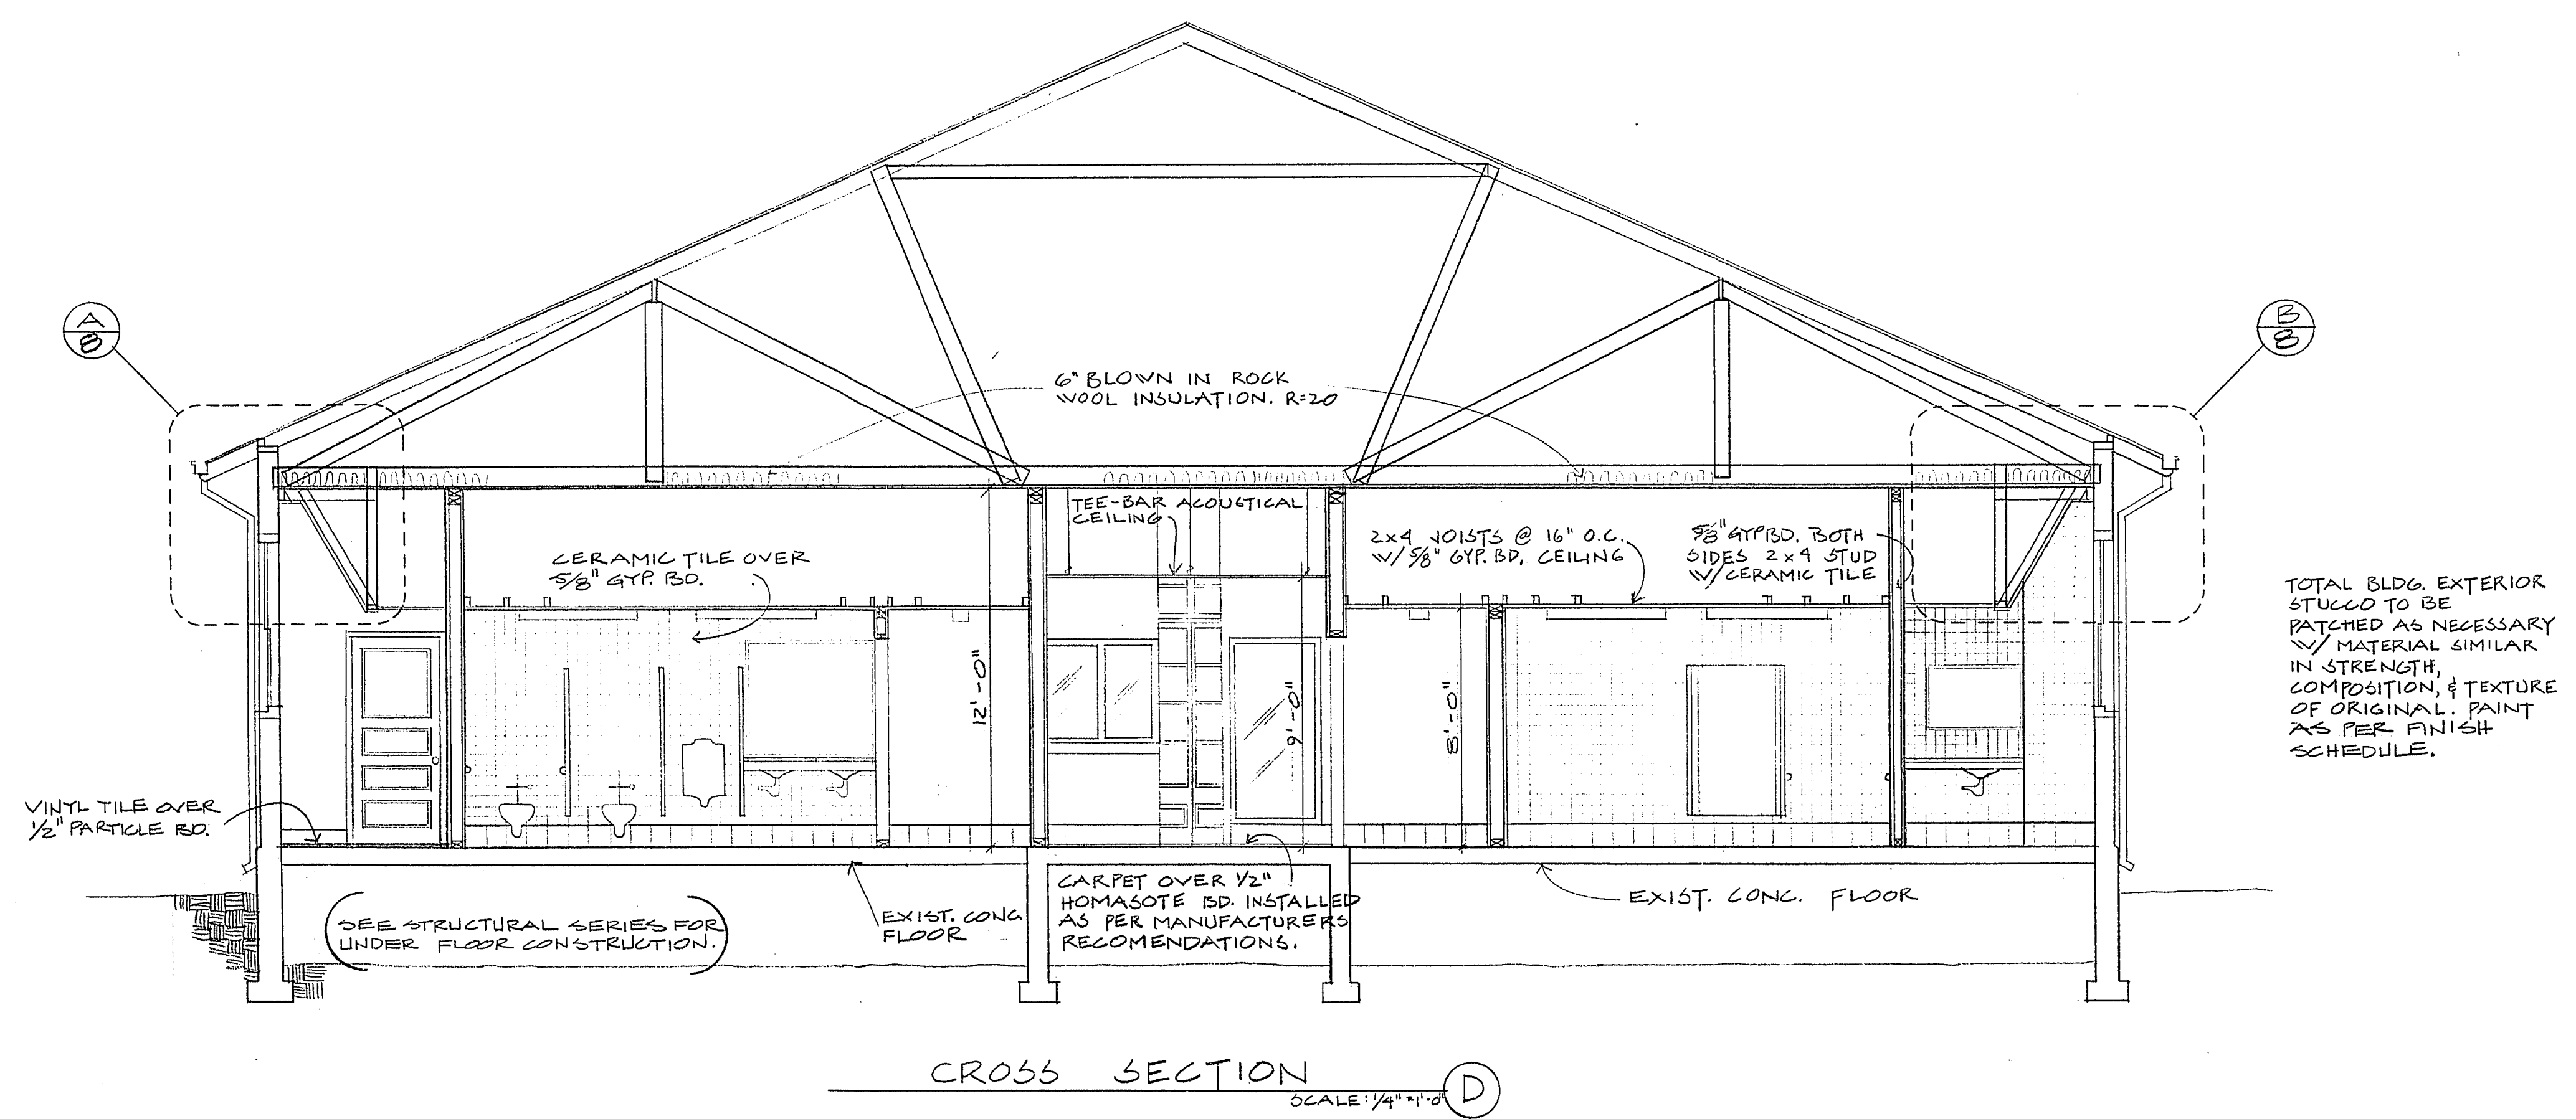


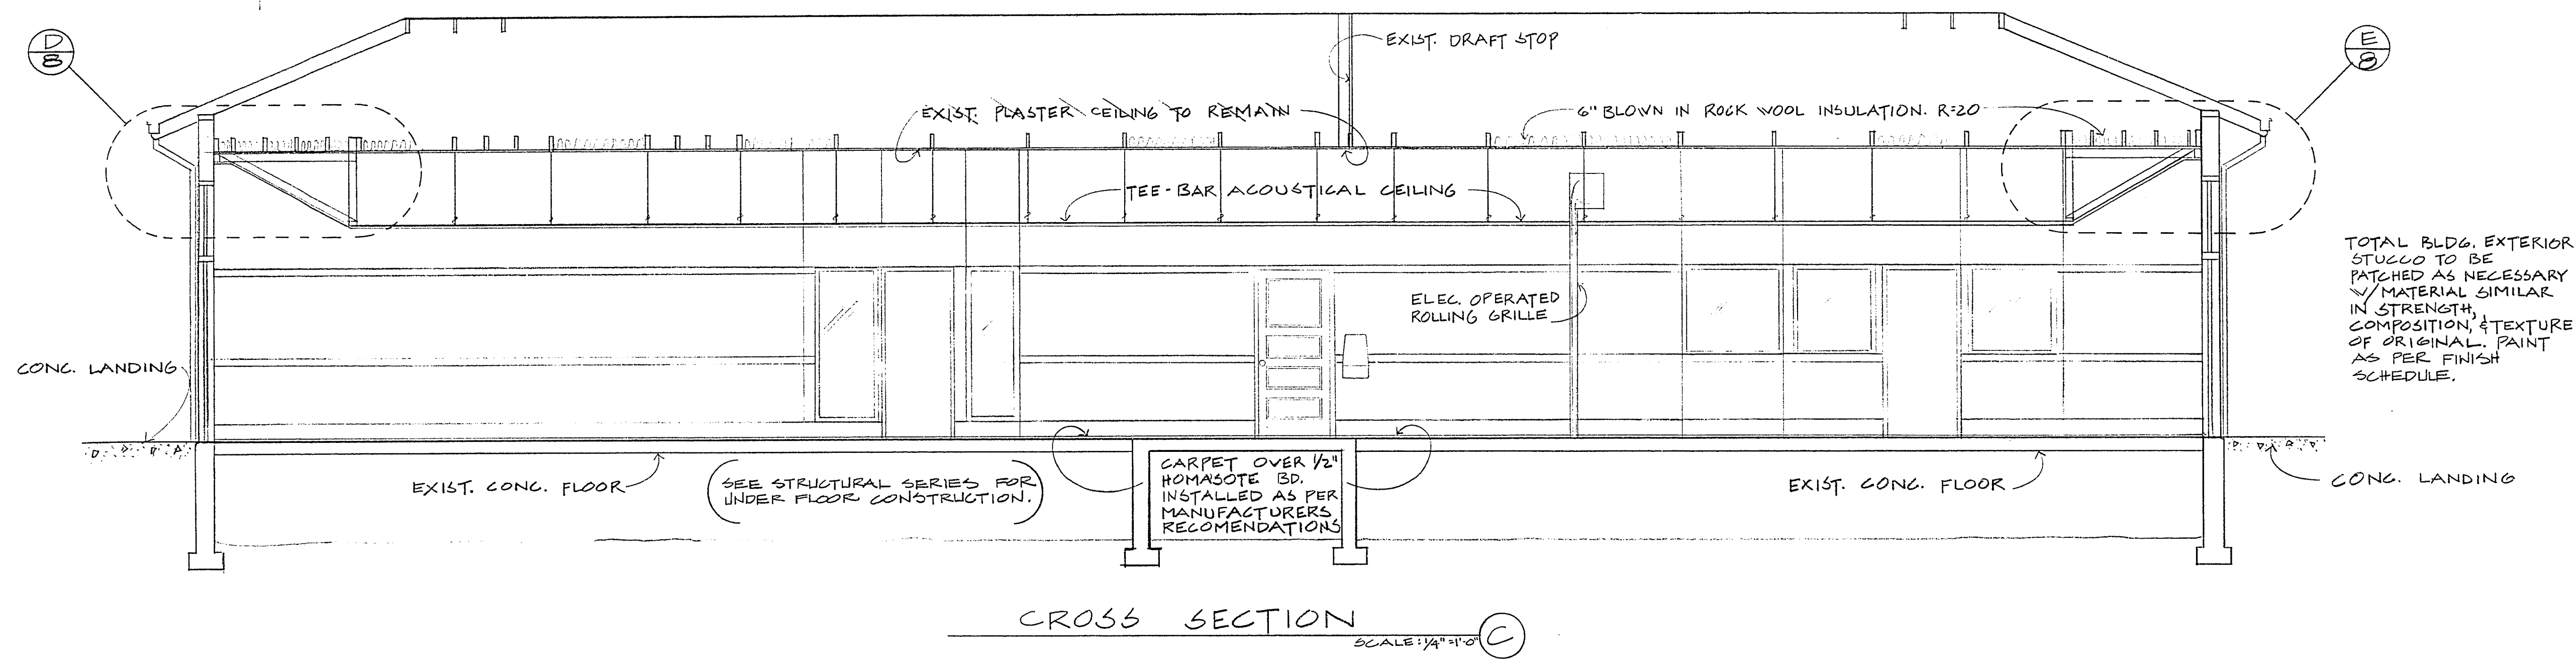

City of Las Vegas, Nevada
Office of Architectural Services and Project Control
Don J. Saylor A.I.P. Deputy City Manager

WEST SIDE SCHOOL RENOVATION
CROSS SECTIONS C & D

Design By: R. RUEGG	Date: 8-82	Revised By:	Date:
Drawn By: ESTUPIANO	Date: 8-82	Revised By:	Date:
Division: TECHNICAL SERVICES	Scale: 1/4" = 1'-0"		

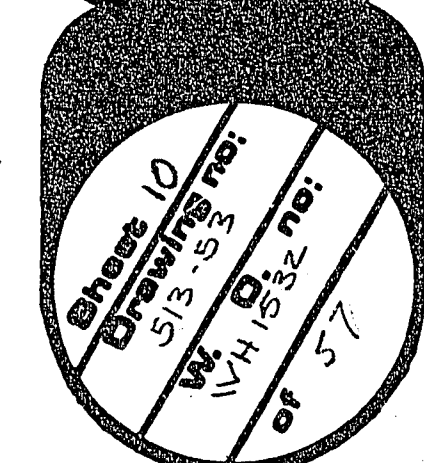

AS BUILT

