

GENERAL NOTES

EXISTING WALLS ARE INDICATED BY HATCHING.

ANGLED WALLS - IF A CONFLICT EXISTS BETWEEN A GIVEN DIMENSION AND A GIVEN WALL ANGLE (FOR 12" OR 24"), THE ANGLE SHALL TAKE PRECEDENCE.

DOOR DETAILS - SEE DOOR SCHEDULE ON SHEET 42.

WINDOW DETAILS - FOR RECONSTRUCTION & PRESERVATION DETAILS OF EXISTING WINDOWS, SEE INDIVIDUAL ELEVATIONS ON SHEETS 25 THRU 34. FOR INTERIOR WINDOW CONSTRUCTION DETAILS, SEE INTERIOR ELEVATIONS (SHEETS 25 THRU 34) AND SHEETS 35, 36, 37.

* THIS SYMBOL FOLLOWING A GIVEN DIMENSION INDICATES THAT THE DIMENSION IS APPROXIMATE AND THAT THE NEW WALL BEING DIMENSIONED SHALL BE CENTERED BETWEEN THE EXISTING WINDOWS ON EITHER SIDE OF IT.

FINISHES FOR WALL FINISHES, SEE INTERIOR ELEVATIONS AND FINISH SCHEDULE ON SHEET 17.

LEGEND


- DOOR LETTER (SEE DOOR SCHEDULE, SHT. 42)
- WINDOW NUMBER (SEE SHEETS 25 THRU 37)
- ROOM NUMBER (SEE FINISH SCHEDULE SHT. 17)
- WINDOW NUMBER (SEE WINDOW SCHEDULE SHT. 42)

CONSTRUCTION PLAN
SCALE: 1/4" = 1'-0"

CONTRACT DRAWING
NOV 30 1982

AS BUILT

PROFESSIONAL ENGINEER
CHARLES E. [Signature]
NOV 18 1982

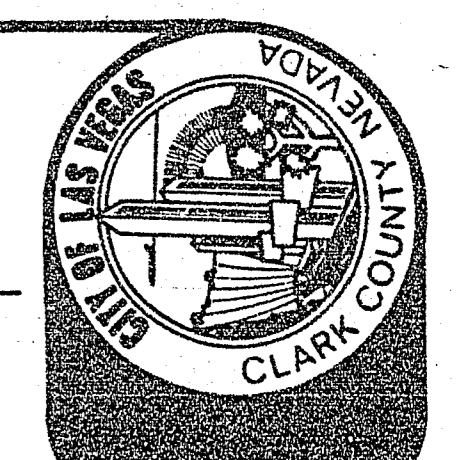

City of Las Vegas, Nevada
Office of Architectural Services and Project Control
Don J. Bayler A.I.P. Deputy City Manager

WEST SIDE SCHOOL RENOVATION
CONSTRUCTION FLOOR PLAN

Design By: R.J.T.	Date: 8-82	Revised By:	Date:
Drawn By: J.T.	Date: 8-82	Revised By:	Date:

Division: TECHNICAL SERVICES
Scale: 1/4" = 1'-0"

Sheet 6
Drawing no. 513-58
W.H.G. no. 141552
of 57