


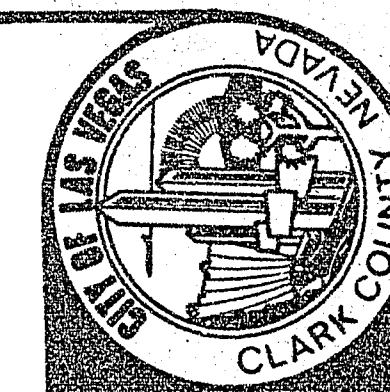


City of Las Vegas, Nevada
Office of Architectural
Services and Project Control

Don J. Saylor A.I.P. Deputy City Manager

WEST SIDE SCHOOL RENOVATION
CEILING DEMOLITION PLAN

Design By: R. RUECKE	Date: 8-82	Revised By:	Date:
Drawn By: J. JACOB	Date: 8-82	Revised By:	Date:
Division: TECHNICAL SERVICES			
Scale: 1/4" = 1'-0"			

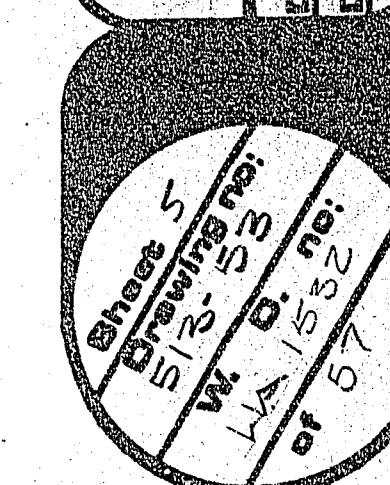

NOTES

REMOVE
REMOVE WOOD LATH AND PLASTER FROM
AREAS INDICATED BY SHADING.
EXISTING WALLS
EXISTING WALLS THAT WILL REMAIN ARE
INDICATED AS DASHED LINES.
EXHAUST DUCT PENETRATIONS
ADJUST LOCATION OF PENETRATION IF CONFLICT
ARISES WITH EXISTING JOIST. DO NOT CUT JOIST

REMOVE WD. TRIM FROM
EXIST. ATTIC ACCESS & PATCH
OPENING W/ 5/8" TYPE 'X' ATYPS.

REMOVE ENTIRE CEILING PLASTER AND LATH
REPLACE W/ TYPE 'X' 5/8 DRYWALL

FIRE DAMAGE IN THIS AREA.
REMOVE CHARRED LATH &
PLASTER TO LIMITS NECESS-
SARY FOR PATCHING W/
NEW MATERIAL SAME AS
EXISTING.

REBUILD EXIST. ATTIC
ACCESS AS PER (H)

REMOVE WD. TRIM FROM
EXIST. ATTIC ACCESS & PATCH
OPENING W/ 5/8" TYPE 'X' ATYPS.

CEILING DEMOLITION PLAN
1/4" = 1'-0"

AS BUILT

