
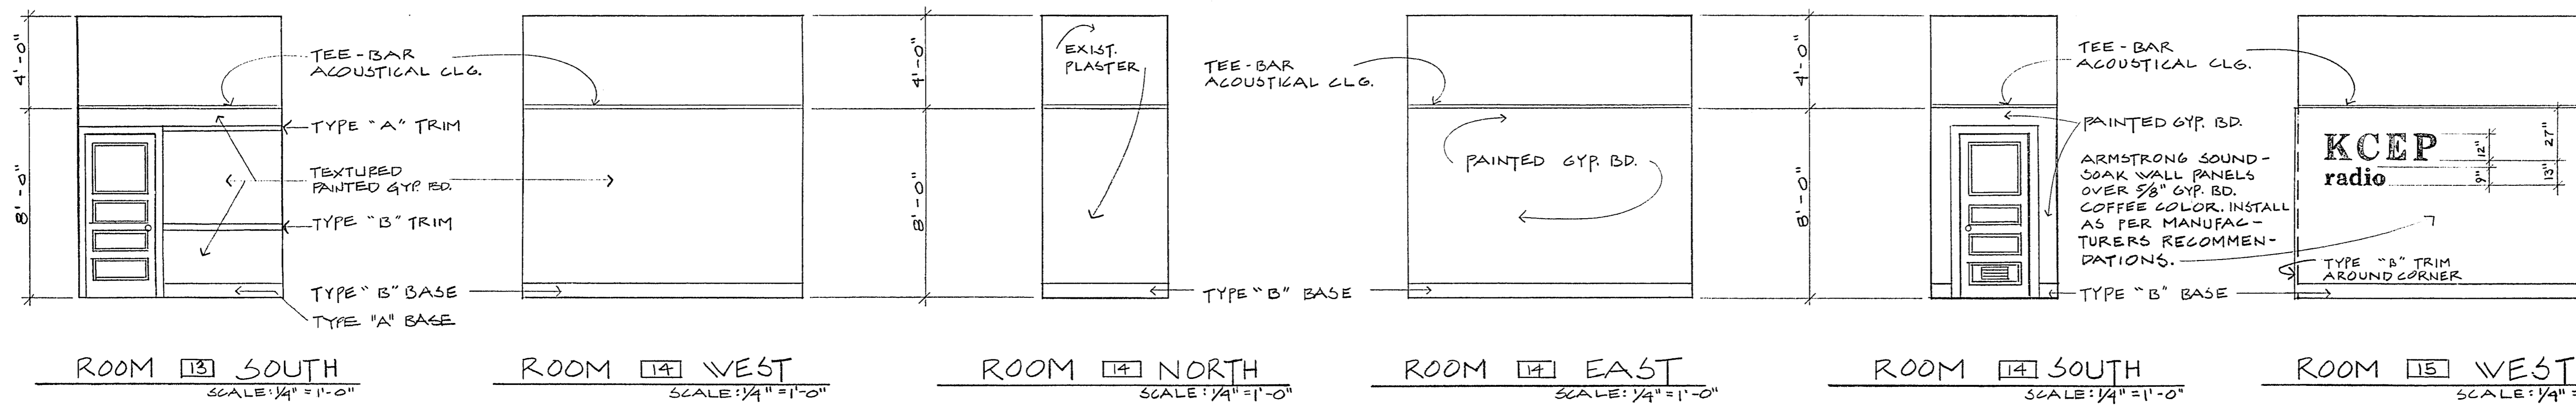



City of Las Vegas, Nevada
 Office of Architectural
 Services and Project Control
 Don J. Bayler A.I.P. Deputy City Manager

WEST SIDE SCHOOL RENOVATION
 INTERIOR ELEVATIONS

Design By: E. RIEBOLD Date: 8-82
 Drawn By: E. RIEBOLD Date: 8-82
 Division: TECHNICAL SERVICES
 Scale: 1/4" = 1'-0"

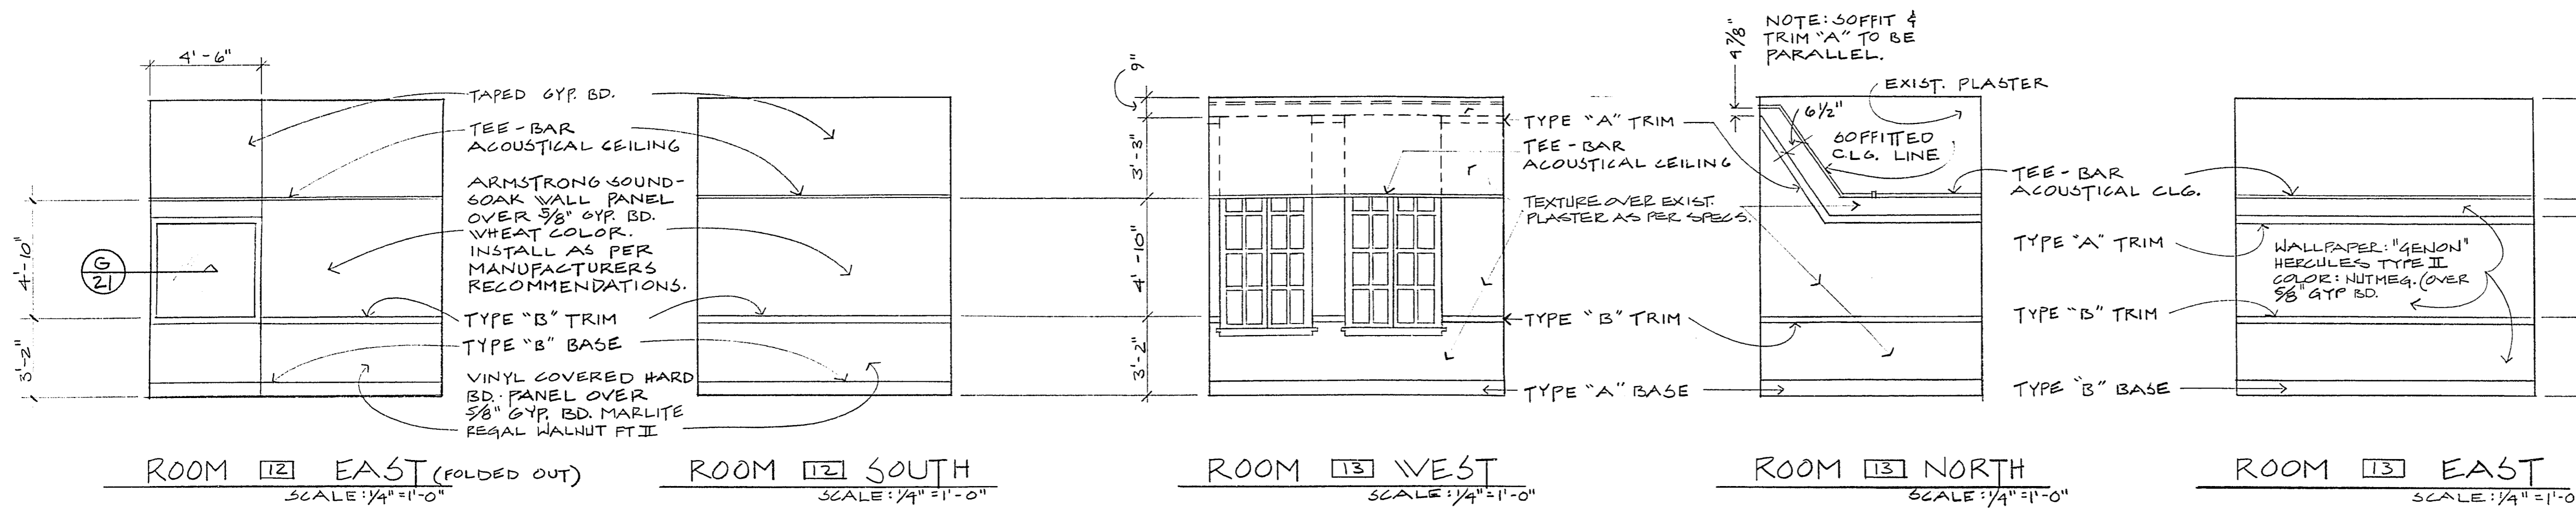

SIGN TO BE 12" H & 9" W LETTERS CUT FROM 1/4" THICK PLEXIGLASS; STYLE: CENTURY SCHOOLBOOK BOLD (LETRASET BRAND); COLOR TO BE APPROVED BY OWNER. SUBMIT SHOP DRAWINGS FOR INSTALLATION METHOD & MATERIALS. SUBMIT ACTUAL LETTER SAMPLE FOR QUALITY REFERENCE.

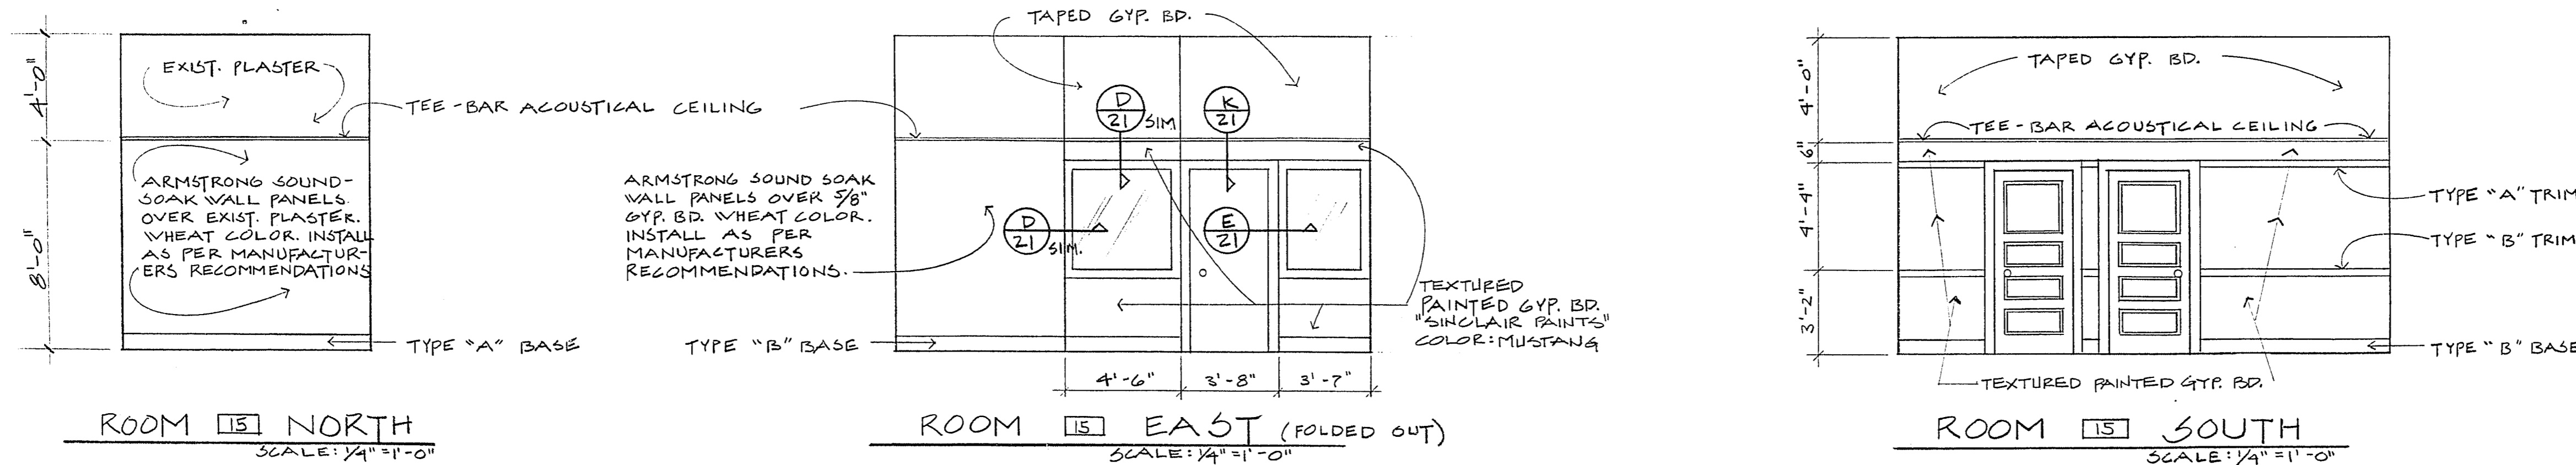

CONTRACT DRAWING
 NOV 3 0 1982

AS BUILT
 11-18-82

CHARLES E. RIEBOLD
 ARCHITECT
 11-18-82

Sheet 15
 of 57
 11-18-82