

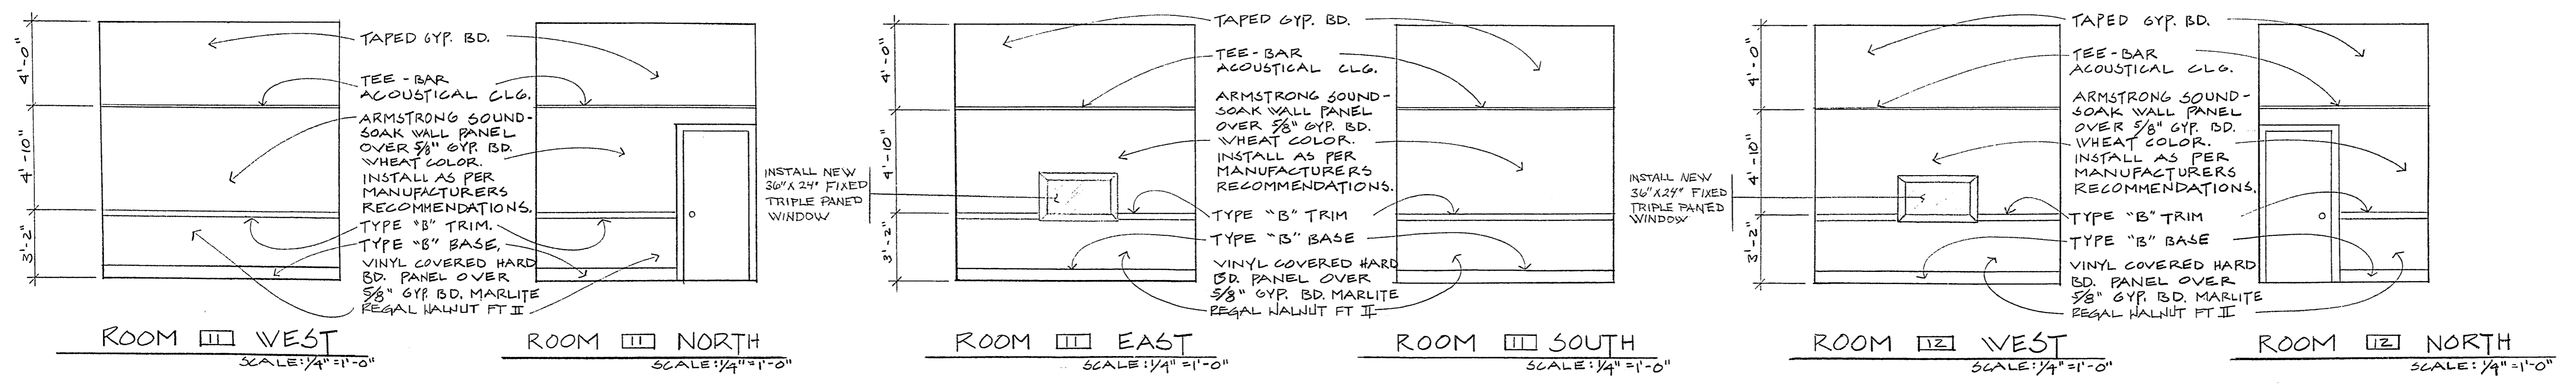
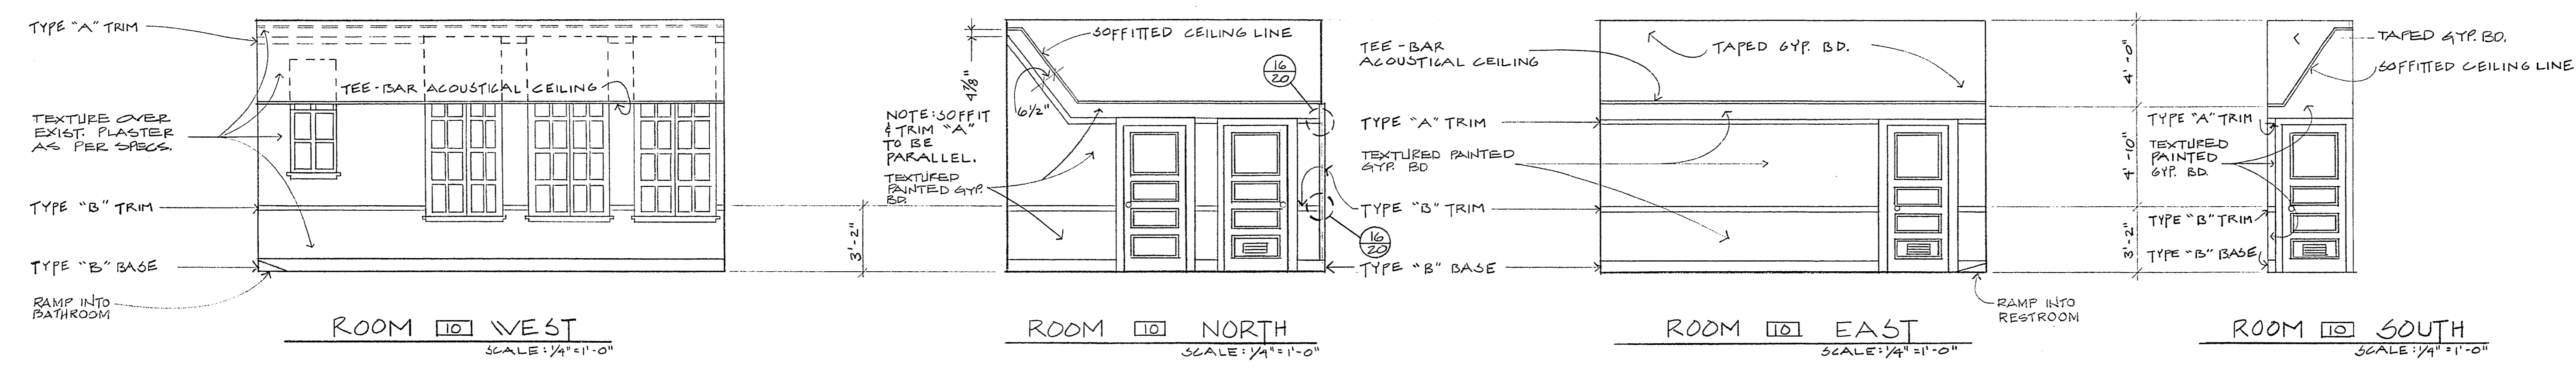


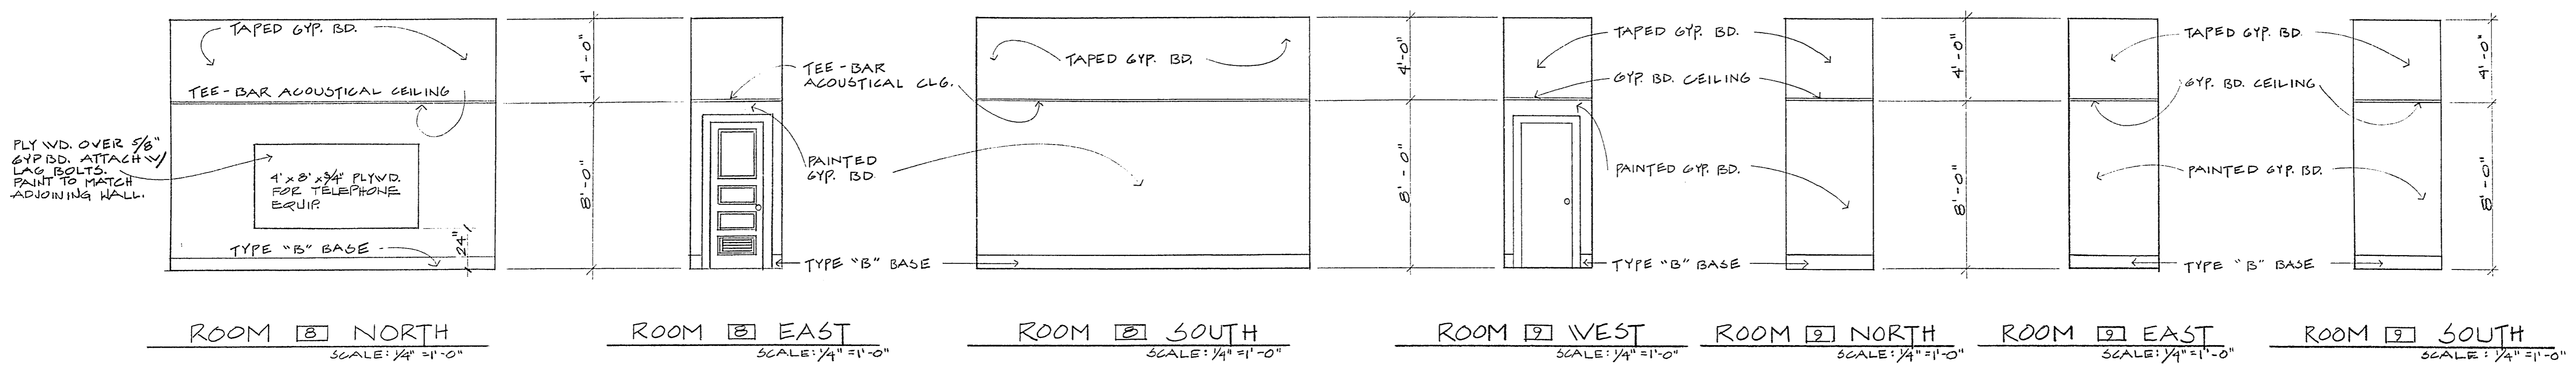

City of Las Vegas, Nevada
Office of Architectural Services and Project Control
 Don J. Saylor A.I.P. Deputy City Manager

WEST SIDE SCHOOL RENOVATION
 INTERIOR ELEVATIONS

Design By: B. ELIASE	Date: 8-82	Revised By:	Date:
Drawn By: F. TILPANO	Date: 8-82	Revised By:	Date:
Division: TECHNICAL SERVICES	Scale: 1/4" = 1'-0"		

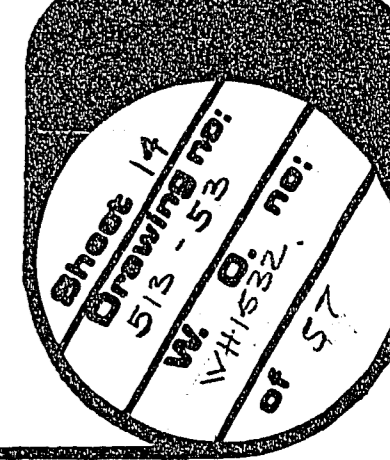

CONTRACT DRAWING
 NOV 3 0 1982

AS BUILT

11-82