


ENGINEER'S CERTIFICATION

I, JAY M. RASSLER, A REGISTERED CIVIL ENGINEER AND LAND SURVEYOR IN THE STATE OF NEVADA, DO HEREBY CERTIFY THAT THIS MAP ACCURATELY DELINEATES A SURVEY PERFORMED UNDER MY SUPERVISION AT THE INSTANCE OF PHILLIP MATTHEWS AND THE MONUMENTS THAT WERE FOUND OR SET ARE CORRECTLY SHOWN HEREON. THIS MAP DOES NOT CONSTITUTE A SUBDIVISION UNDER NEVADA REVISED STATUTES. DATE OF SURVEY MAY 12, 1973.

Jay M. Rassler
JAY M. RASSLER, REGISTERED CIVIL
ENGINEER AND LAND SURVEYOR
NO. 1624

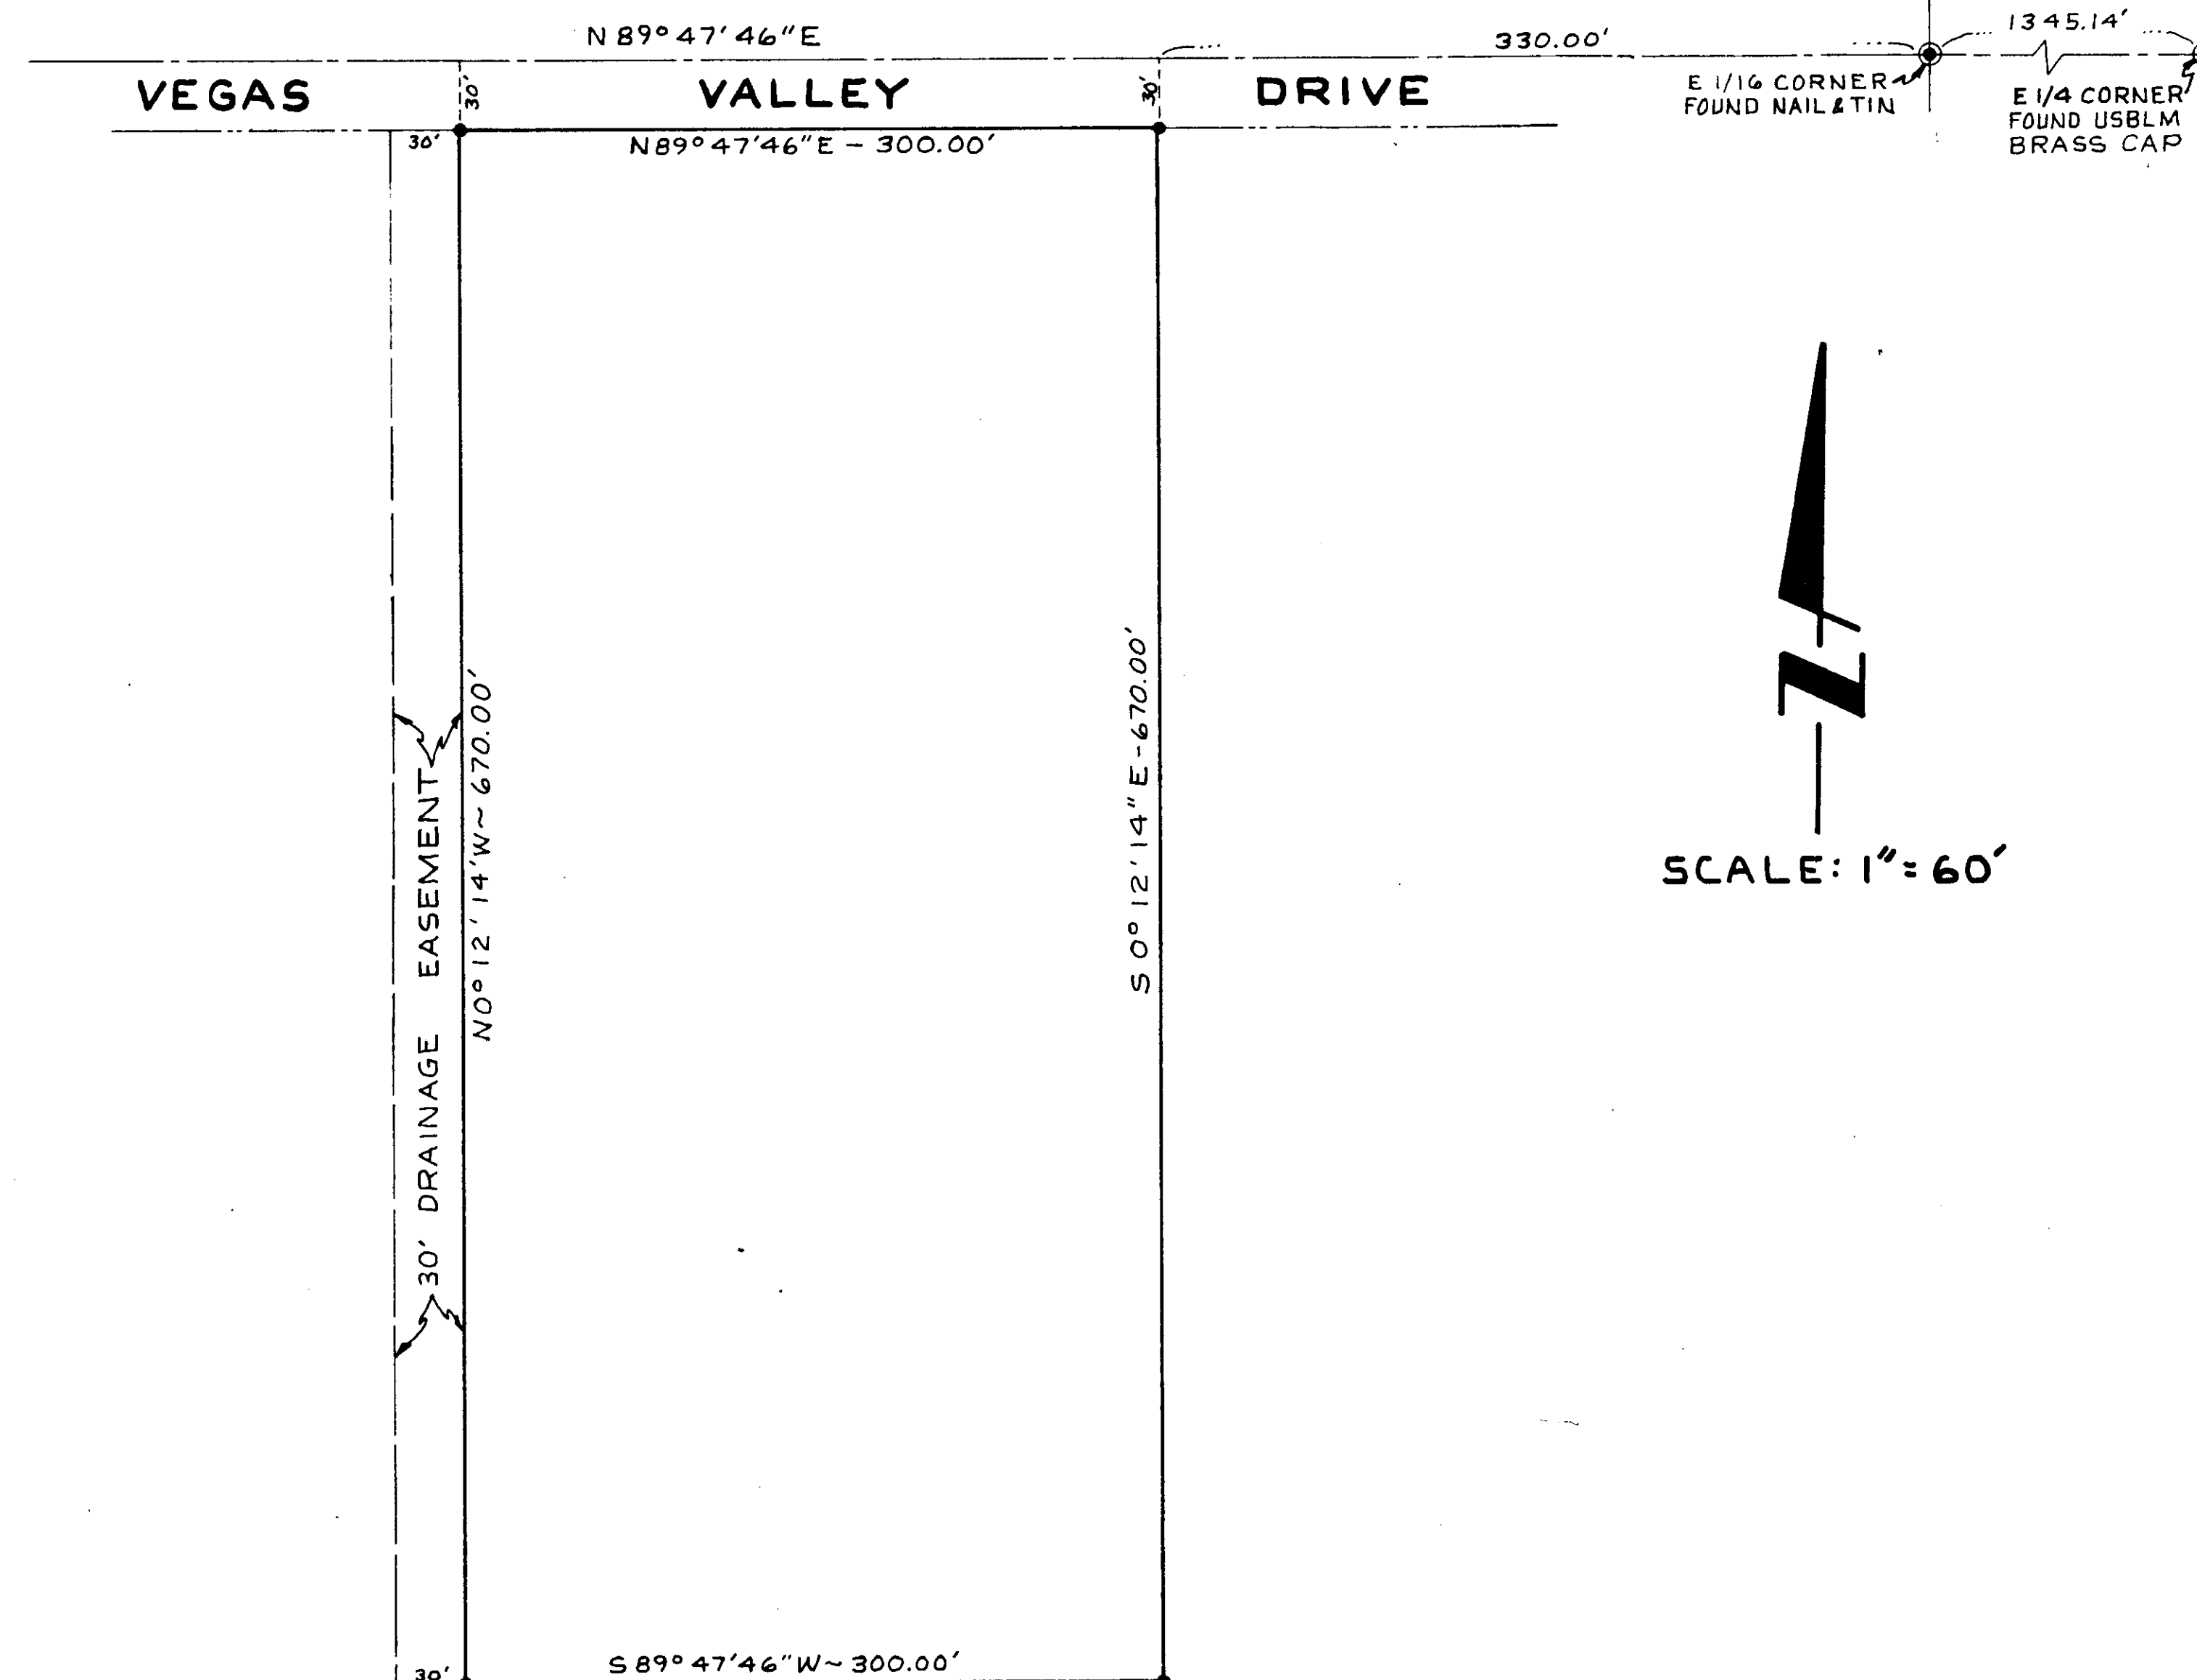

LEGEND

- MONUMENTS FOUND
- MONUMENTS SET - REBAR AND TAG 1624

LEGAL DESCRIPTION

A PART OF THE NE 1/4, NW 1/4, SE 1/4 OF SECTION 10, T.21S, R.62E, M.D.B. & M. CLARK COUNTY, NEVADA.

BASIS OF BEARINGS

THE BEARING (N 89° 47' 46" E) OF THE CENTERLINE OF VEGAS VALLEY DRIVE, SECTION 10, T.21S, R.62E, M.D.B. & M. SHOWN ON FILE 21, PAGE 29 OF RECORDS OF THE CLARK COUNTY RECORDERS OFFICE.

NO. 290329
RECORDED AT THE REQUEST OF
JAY M. RASSLER
DATE ~~5-24-74~~ 12-24-73
FILE ~~25~~ 32
OF SURVEYS
OFFICIAL RECORDS BOOK NO. 331
CLARK COUNTY RECORDS
PAUL E. HORN, RECORDER
FEE \$2.50 - 1/2 DEPUTY

RECORD OF SURVEY

OF A PORTION OF SECTION 10,
T.21S, R.62E, M.D.B. & M.
CLARK COUNTY, NEVADA
FOR:

PHILLIP MATTHEWS