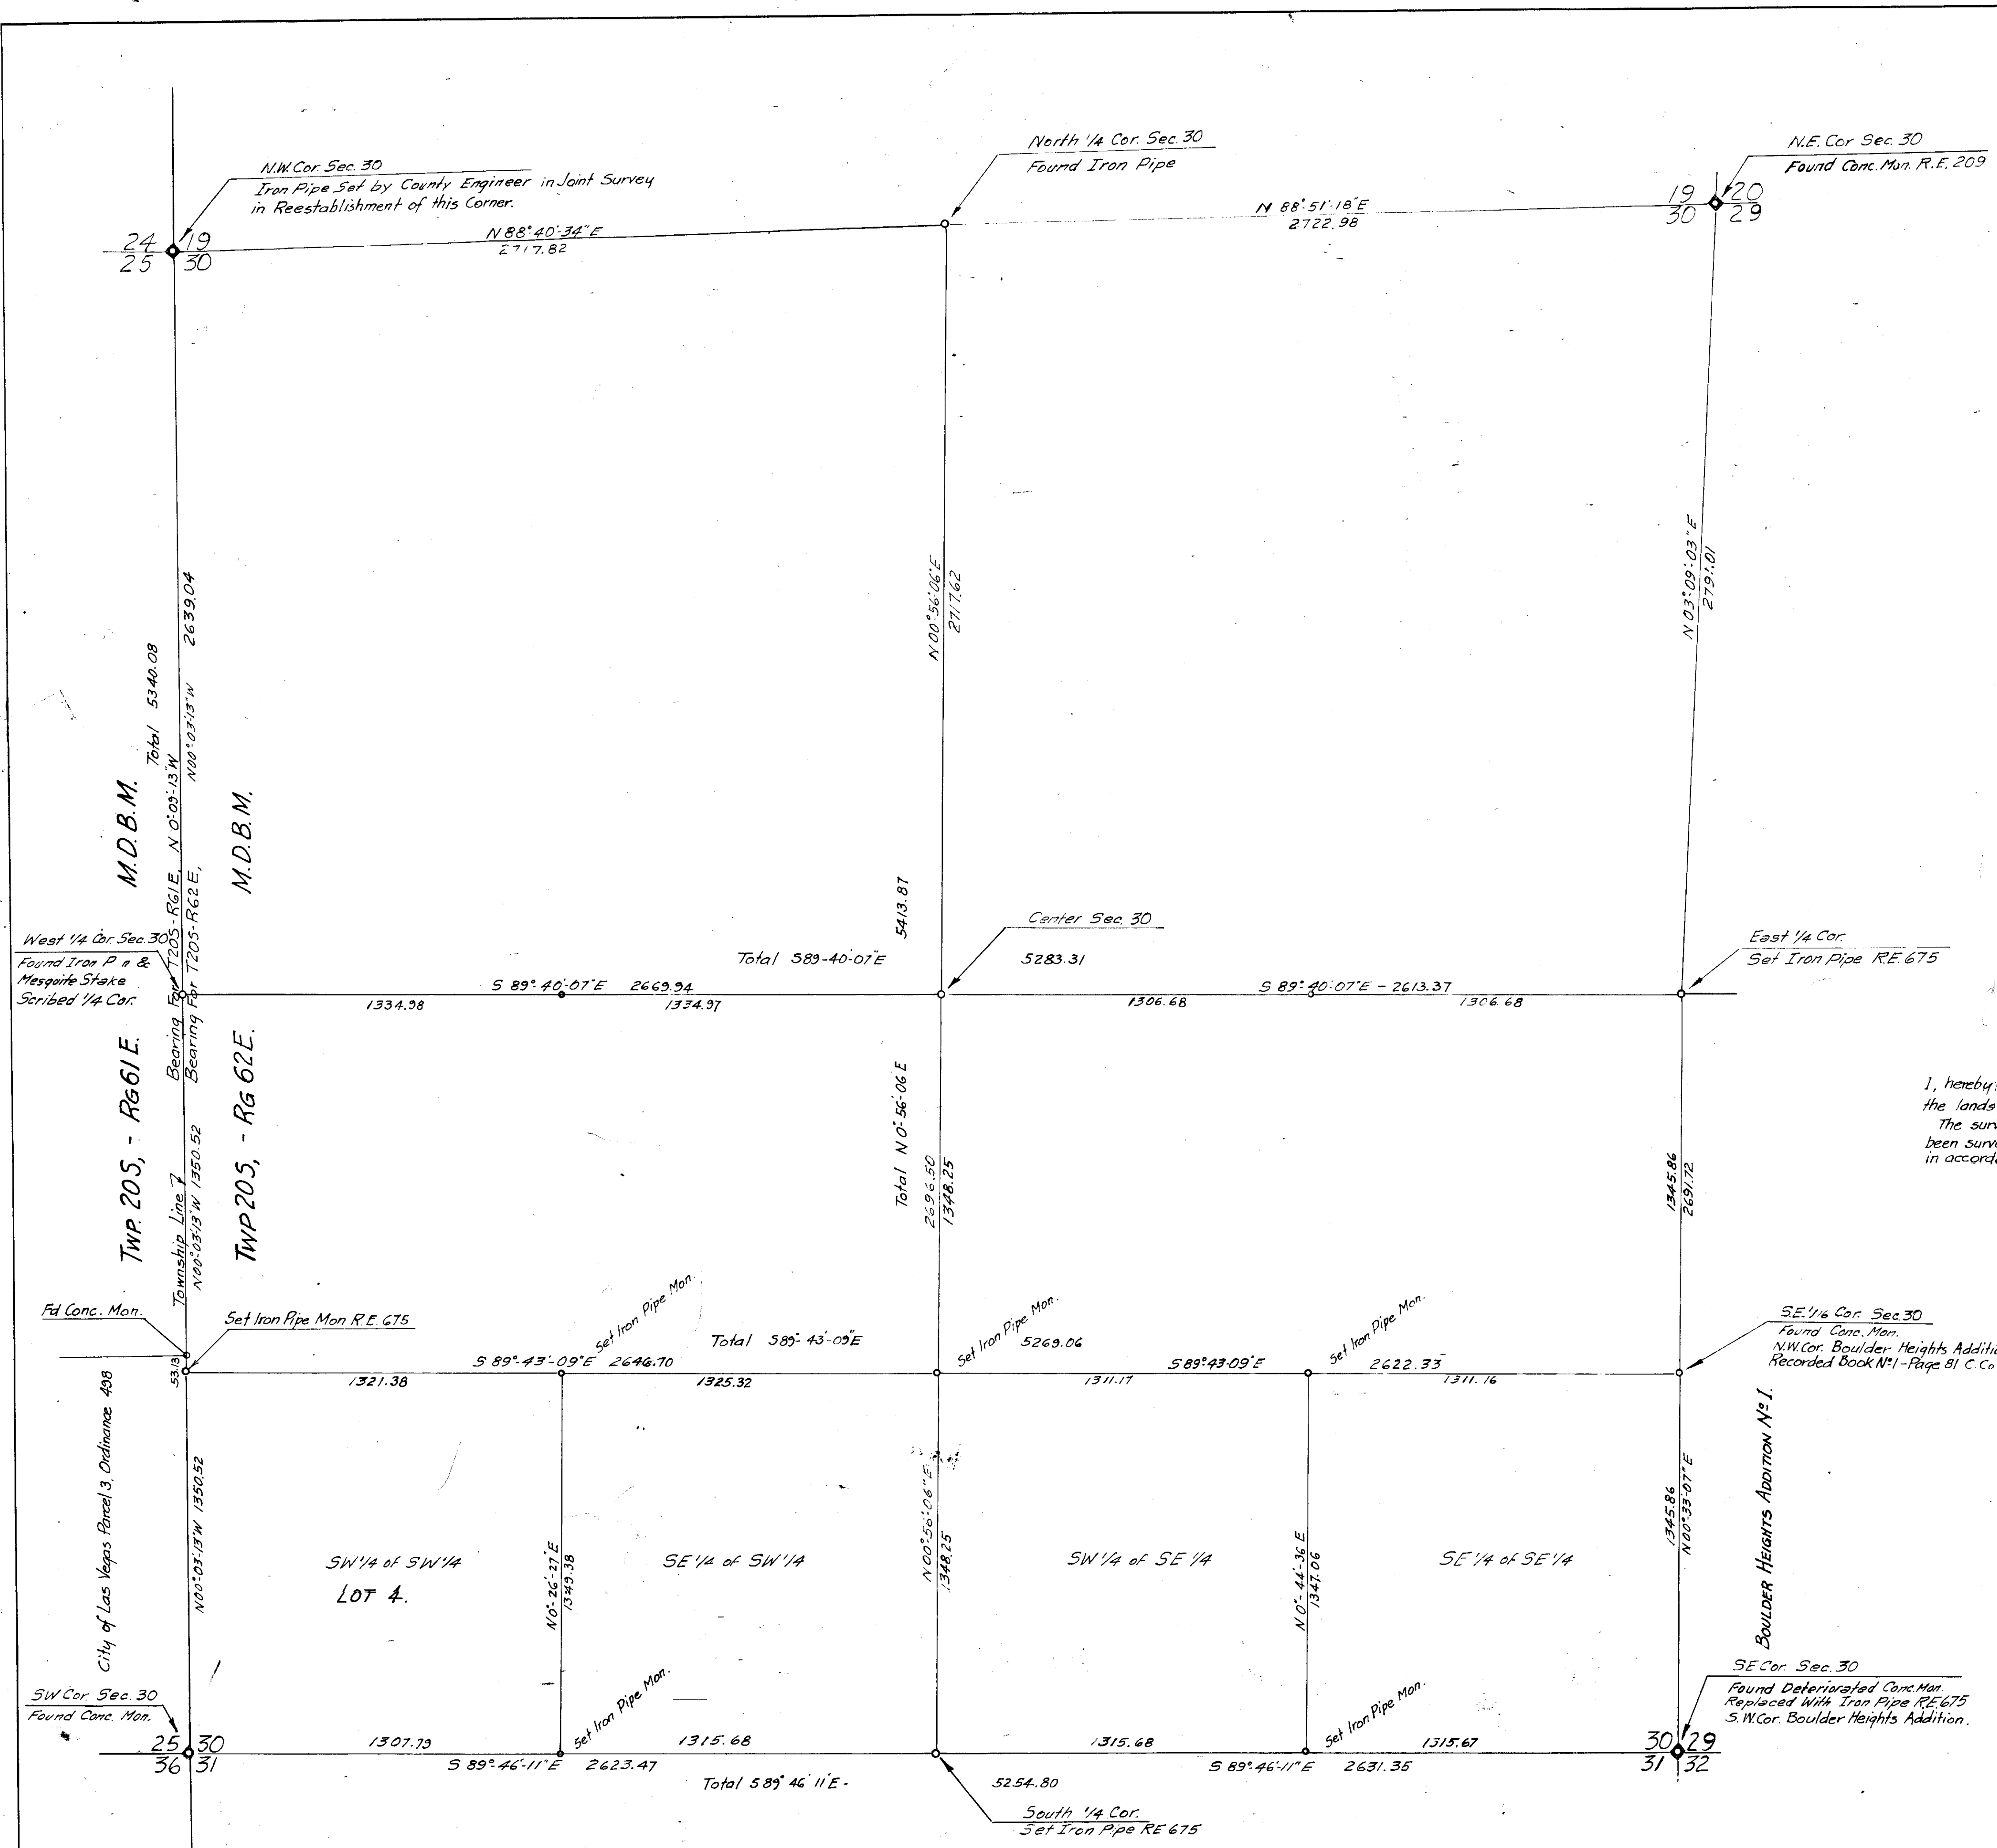


~ NOTE ~
Bearings are true astronomic based on a series of local solar observations and compensated in longitude to the easterly line meridian of T20S-R62E, M.D.B.M. Working tapes checked with U.S. Bureau of Standards certified tape No. 3486. All measurements temperature corrected.
Closure of Survey: Departure: 0.43, Latitude: 0.30.

CERTIFICATE.
I, hereby certify that this plan represents a true and correct survey of the lands here shown; and that the monuments exist as indicated hereon. The survey of the SW 1/4 - SW 1/4, SE 1/4 - SW 1/4 and SE 1/4 - SE 1/4, having been surveyed at the instance of Wm. Meikle, owner. The section is surveyed in accordance with the Bureau of Land Management Rules.

L. M. BOBEAU
L. M. BOBEAU-ENGINEER & SURVEYOR No. 75
212 STEWART ST. LAS VEGAS, NEVADA

NO. 419566
Filed Dec 7 - 1953
L. M. BOBEAU
1:55 P
File 2 - Page 61
Reg. Prof. Eng. Surveys

SURVEY
SECTION 30, T20S, R62E, M.D.B.M.
CLARK COUNTY NEVADA.
Scale 1"=300 FT
Dec. 7th 1953.