


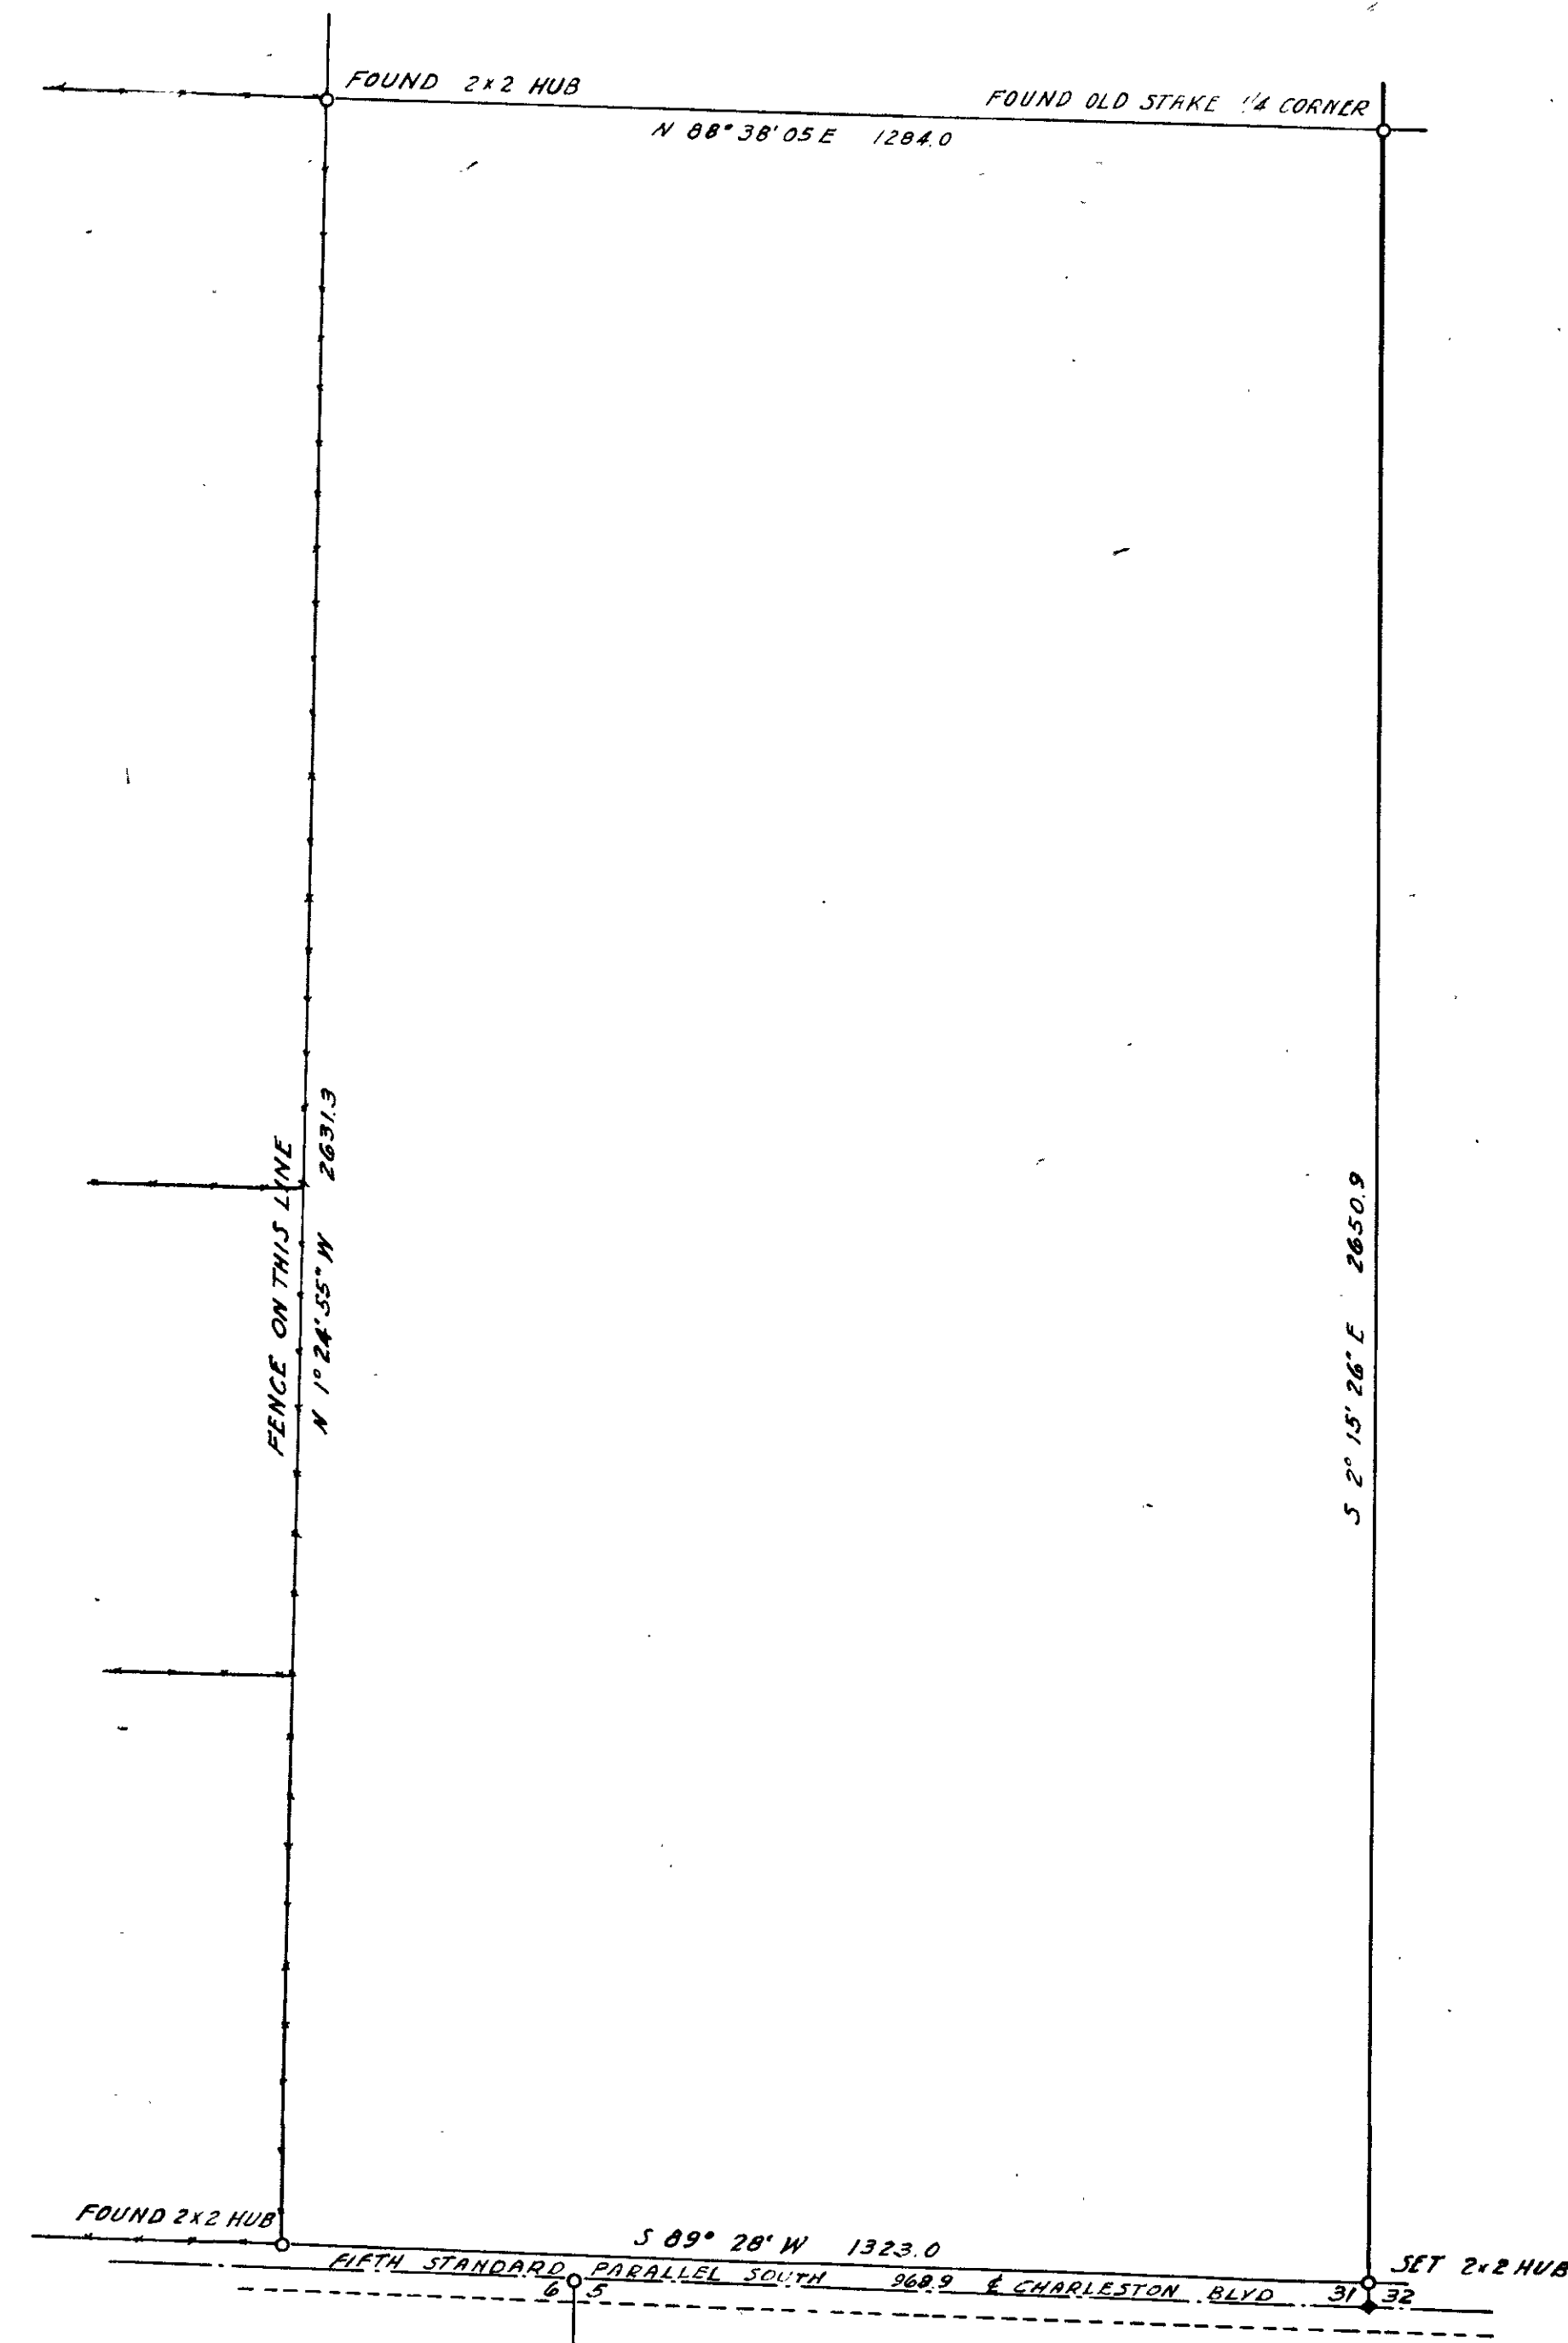

Survey completed and checked July 21, 1953

F. M. Eaton
REG. PROF. ENGR. & LAND SURVEYOR - NEVADA

N^o 409486
FILED AT REQUEST OF
FRED M. EATON
DATE JUL-23-1953 AT 9:05 A.M.
IN FILE 2 PAGE 26
OF REG. PROF. ENG. SURVEYS
CLARK COUNTY, NEVADA
RECORDS
PAUL G. O'MALLEY - RECORDER
DEPUTY
FILE 2.59 INDEXED *SR*

**E² SE⁴ SECTION 31
T 20S. R 62E. MDB & M
CLARK COUNTY, NEVADA**

**CAMPBELL REALTY CO.
LAS VEGAS-NEVADA**