
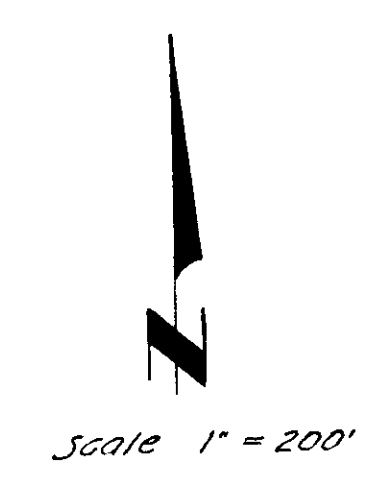


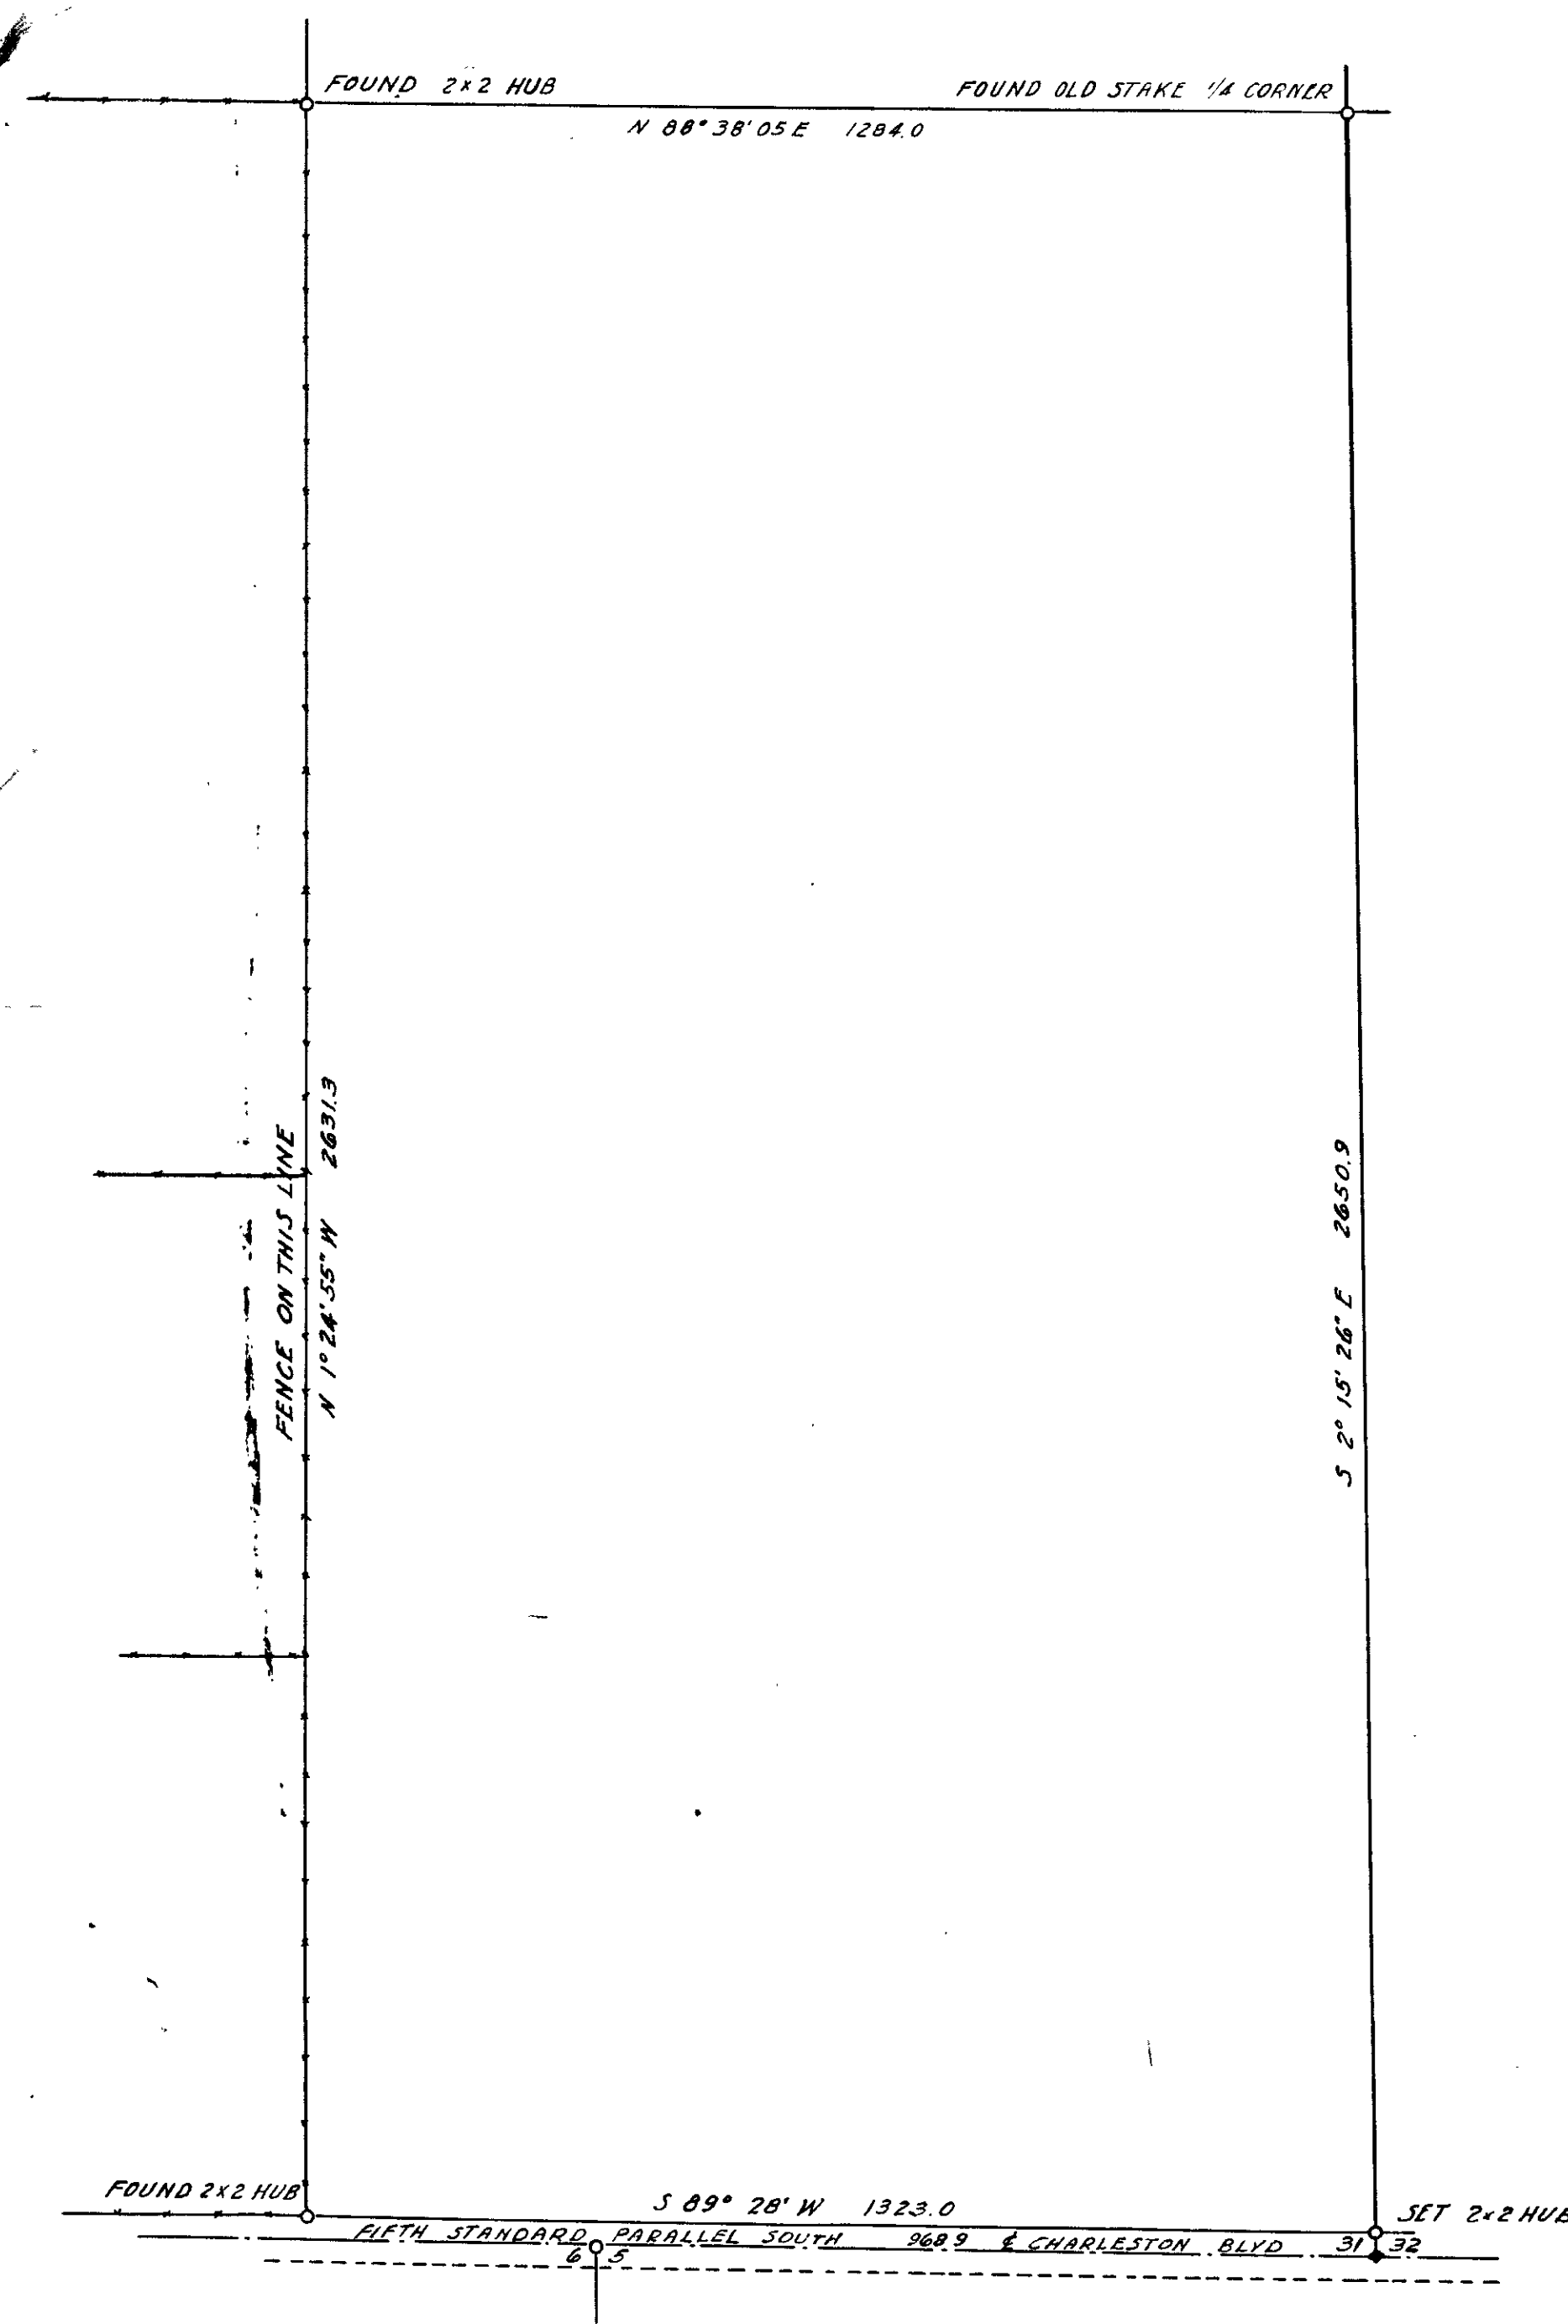

Survey completed and checked July 21, 1953
J. M. Eaton
 REG. PROF. ENGR. & LAND SURVEYOR, NEVADA

N^o 409486
 FILED AT REQUEST OF
 FRED M. EATON
 DATE JUL-23-1953 AT 9:05 A.M.
 IN FILE 2 PAGE 26
 OF REG. PROF. ENG. SURVEYS
 CLARK COUNTY, NEVADA
 RECORDS
 PAUL C. O'MALLEY - RECORDER
 TOL. DEPUTY
 FEE 2.59 INDEXED *RM*

E² SE⁴ SECTION 31
T 20S. R 62E. MDB&M
CLARK COUNTY, NEVADA
CAMPBELL REALTY CO.
LAS VEGAS-NEVADA 065-24