




- ⑥ Indicates point found as shown
- Indicates point set nail and shiner
- Indicates point set aluminum cap on rebar and
RLS tag 807

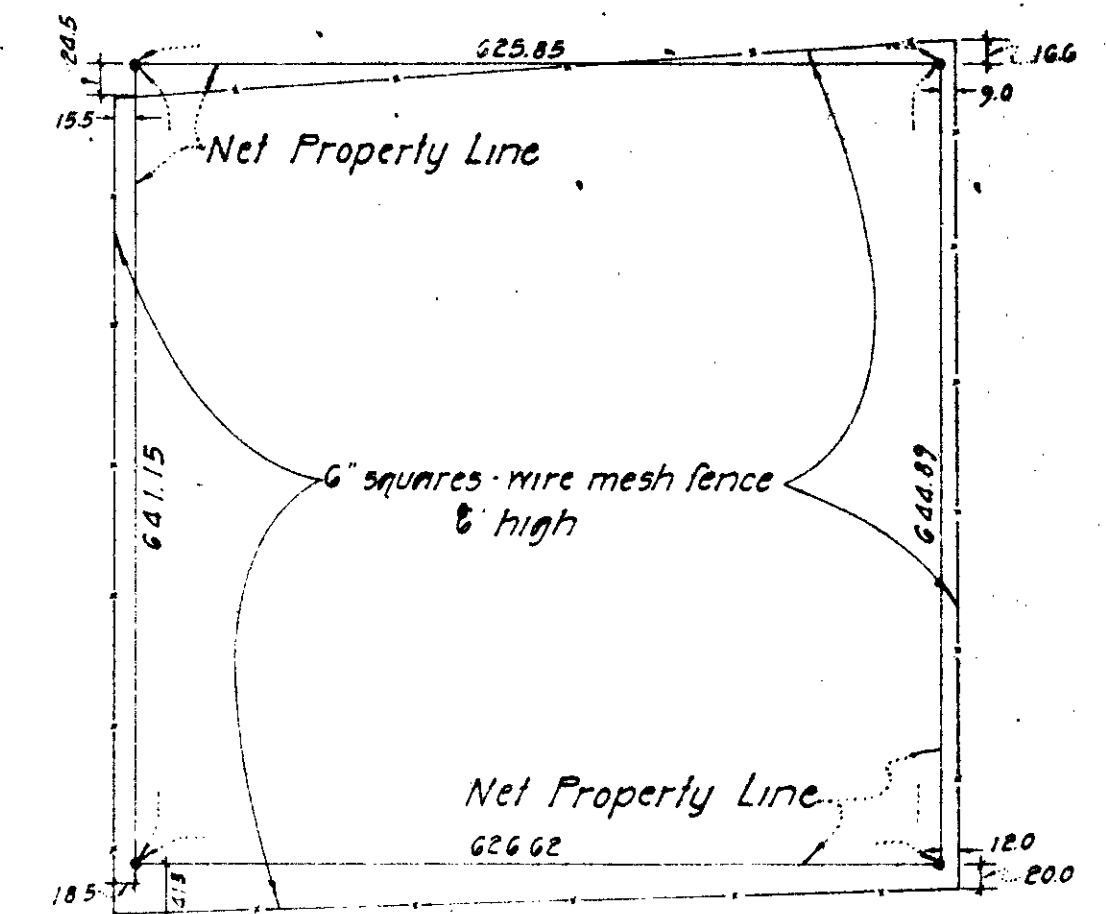

سے امرج / سر / سر / سر

I, Jack K. Leavitt, Registered Professional Engineer-Land Surveyor do hereby certify that this map is a true and accurate representation of the lands shown hereon. All points found or set are correctly designated. This survey was completed on the 26th day of June, 1967 at the instance of Keith Hayes and does not constitute a subdivision as defined by Nevada State Law.

Jack K. Leavitt
Registered Professional Engineer
Land Surveyor RLS 807

OFFICIAL STATE OF NEVADA 805
2ND COUNTY, NEVADA, 1900
PAUL E. HARRIS, REC'D
2.50 OC

RECORD OF SURVEY
The SE 1/4 NE 1/4 NE 1/4 of
Section 32, Township 20 South, Range 62 East, M.D.M.
Clark County, Nevada

LEAVITT & HOLLER
SURVEYORS LIMITED
Professional Engineers and Land Surveyors
536 East Sahara Avenue Las Vegas, Nevada

055-393
FILE 17 PAGE 60 -