
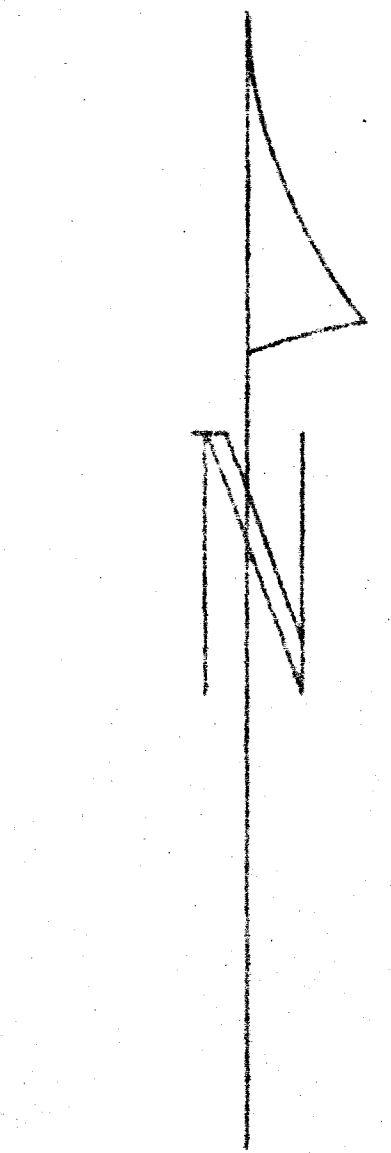


13-62

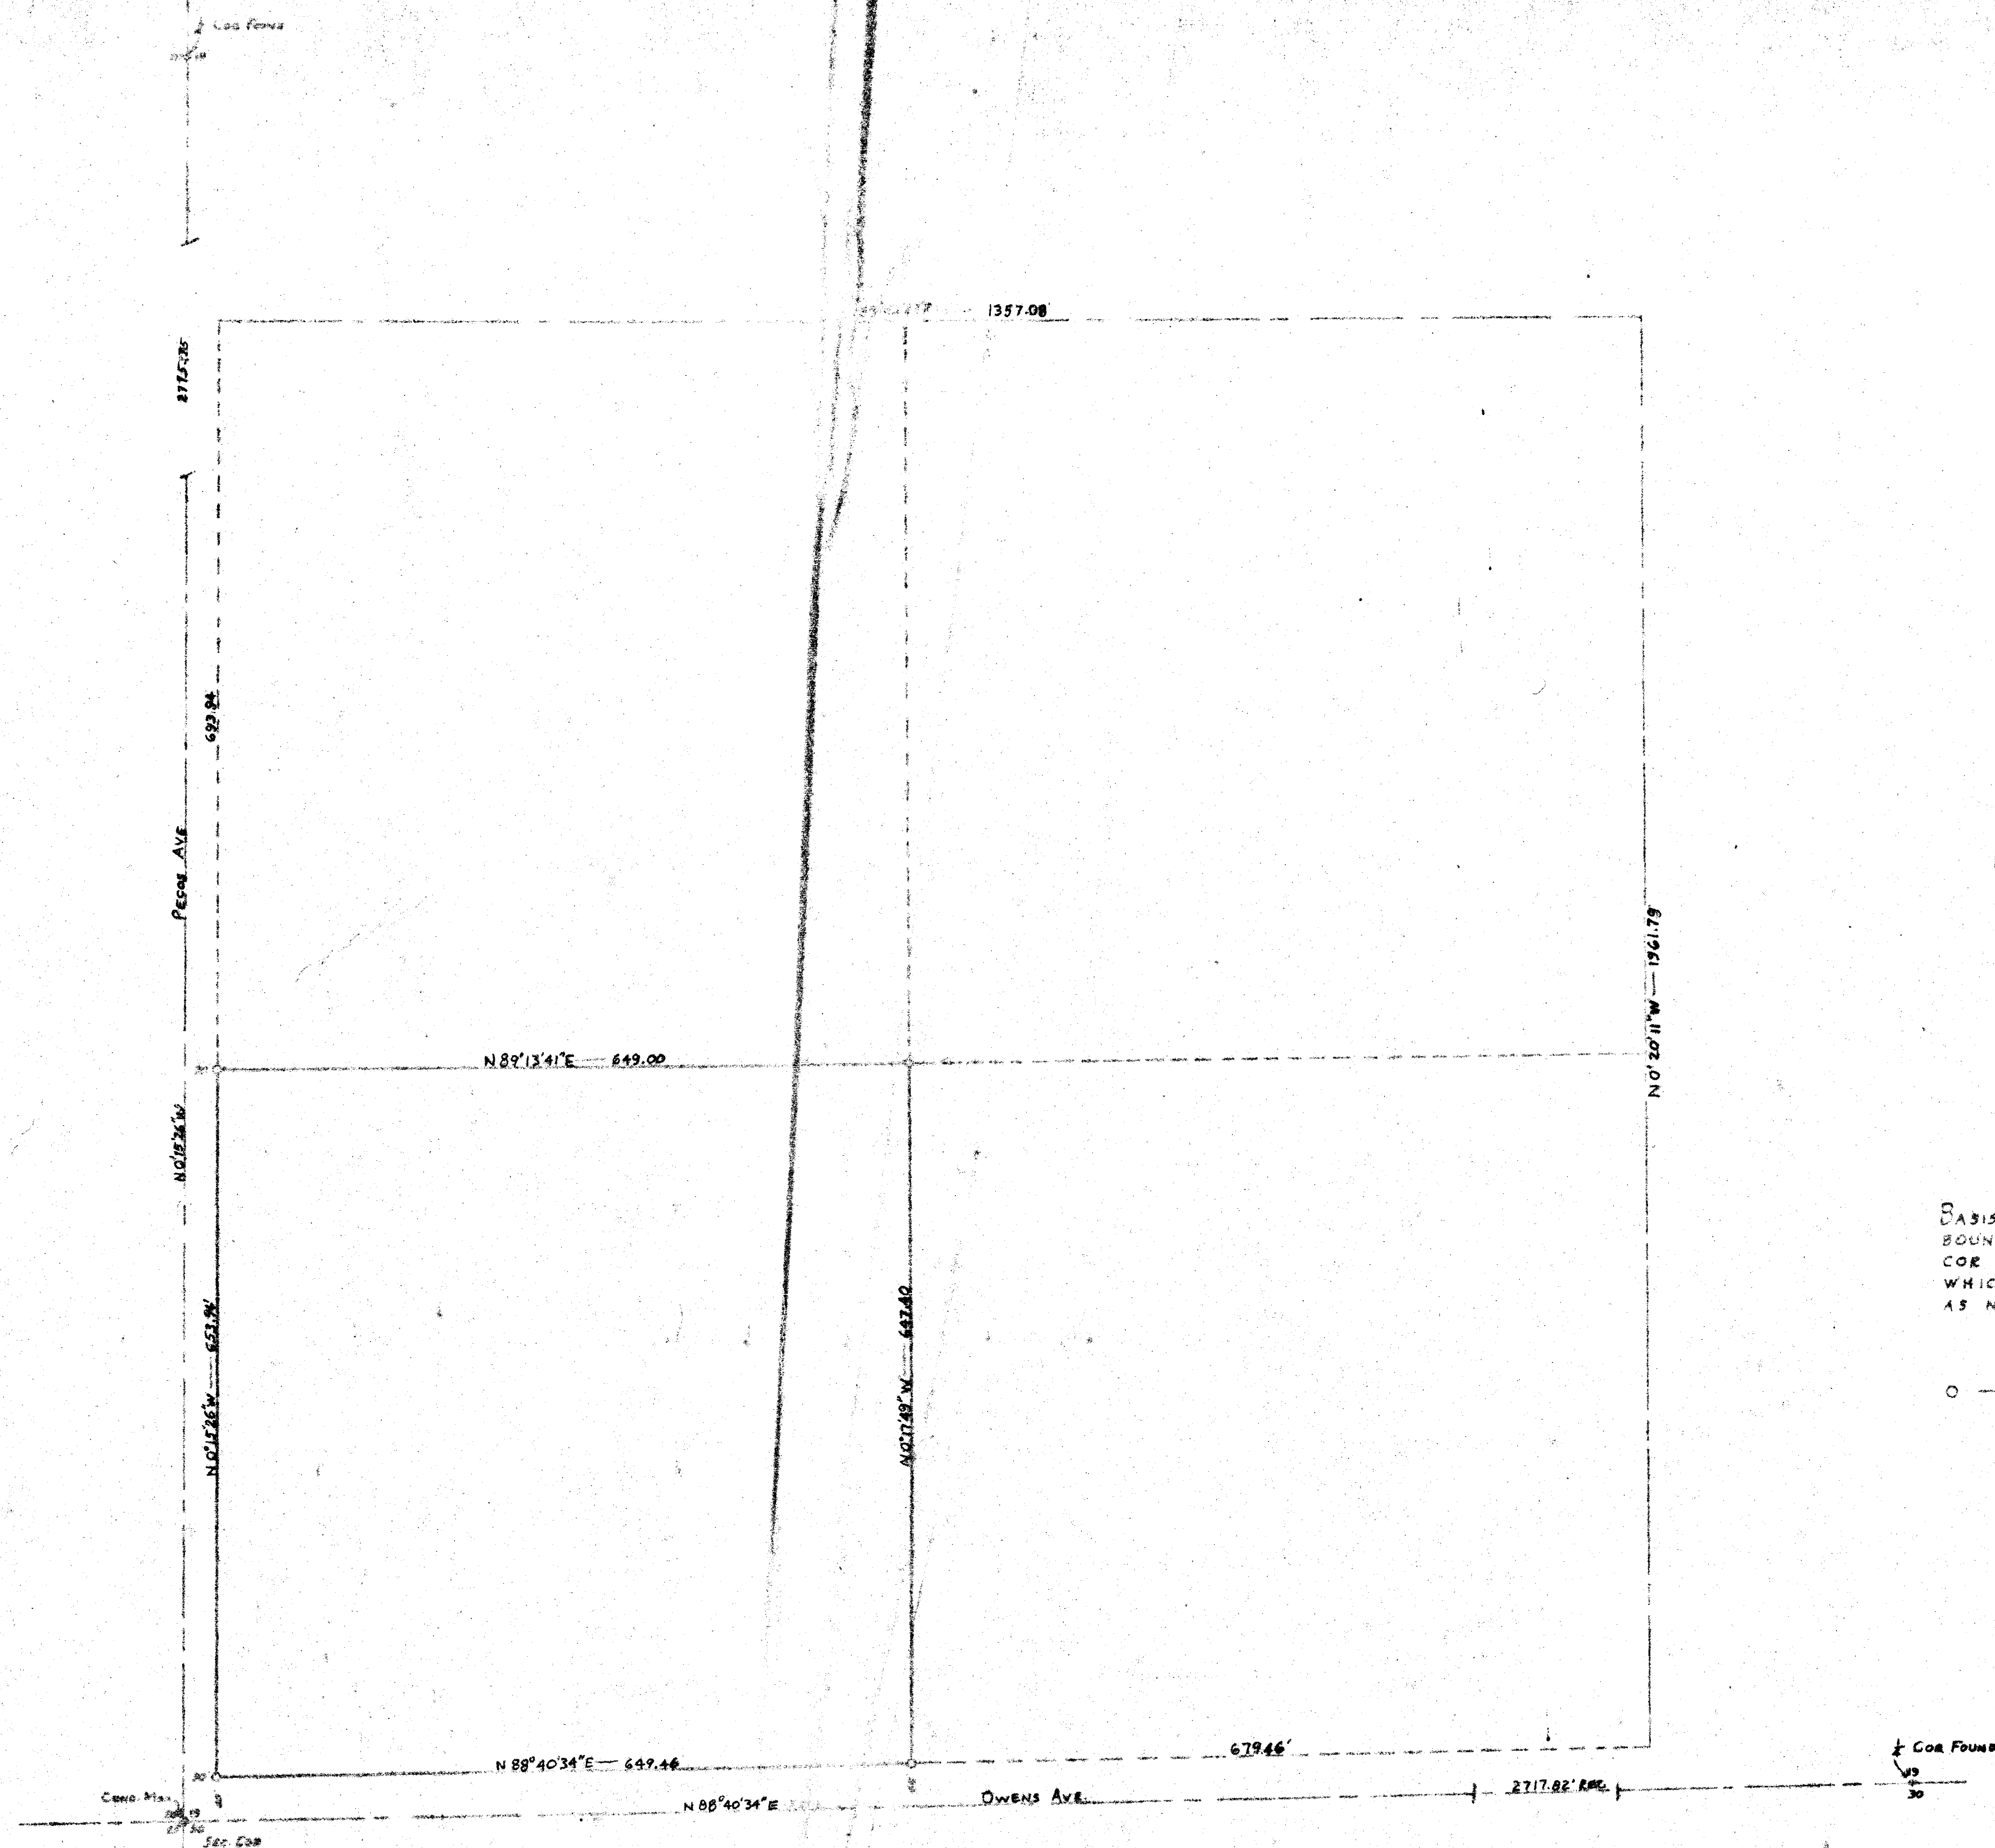

MAP SCALE — 1"=100'

GEN NOTES —

BASIS OF BEARING ADOPTED FROM THE NORTH BOUNDARY OF SEC. 30 BETWEEN THE SW COR SEC 19 TO THE NE COR OF 19 & 30 WHICH IS ON RECORD IN FILE 2, PAGE 61 AS N 88° 40' 34" E

○ — INDICATES SET 2"x2" TAGGED HUBS

ENGINEERS CERTIFICATE

I JACK PARVIN A REGISTERED PROFESSIONAL ENGINEER AND LAND SURVEYOR IN THE STATE OF NEVADA DO HEREBY CERTIFY THIS PLAT TO BE TRUE AND ACCURATE AND CONSTRUCTED FROM FIELD SURVEY UNDER MY DIRECTION AT THE INSTANCE OF ANNE TAYLOR WIFE, AND SAM TAYLOR HUSBAND, THE BOUNDARY OF THE AREA BEING MORE SPECIFICALLY DESCRIBED AS FOLLOWS:

BEGINNING AT THE SW COR SEC 19, T20S, R62E, BEARING N 88° 40' 34" E A DISTANCE OF 4000 TO A POINT, THENCE N 88° 40' 34" E A DISTANCE OF 3000 TO THE TRUE POINT OF BEGINNING, THENCE N 0° 15' 26" W A DISTANCE OF 45394 TO A POINT, THENCE N 88° 40' 34" E A DISTANCE OF 44900 TO A POINT, THENCE S 0° 15' 26" W A DISTANCE OF 44900 TO A POINT, THENCE S 88° 40' 34" W A DISTANCE OF 44900 TO THE TRUE POINT OF BEGINNING. SURVEY COMPLETED 2/10/59

NO 36161
JACK PARVIN
2-21-59 3:13 PM
4 30


JACK PARVIN
REG. PROF. ENGR. & LAND SURVEYOR NO. 296

RECORD OF SURVEY
FOR THE
SW 1/4, SW 1/4, SW 1/4
SEC. 19, T20S, R62E
CLARK CO. NEV.
SAM & ANNE TAYLOR — OWNERS
MAP SCALE — 1"=100'

055-406

3497

13-62

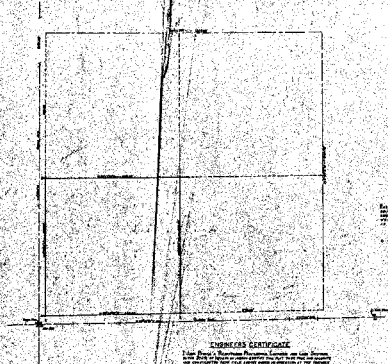

Map Scale - 1 inch = 1 mile

Map Scale - 1 inch = 1 mile

Notes to Engineer, please note the above
boundary on this map is shown for the
purpose of showing the location of the
land on the map and does not constitute
a warranty of the accuracy of the map.

1 inch = 1 mile

ENGINEER'S CERTIFICATE

I, John P. Brown, a Registered Professional Engineer, do hereby certify that the above map is a true and correct representation of the land shown on the map and does not constitute a warranty of the accuracy of the map.

Witness my hand and seal this 1st day of June, 1962, at the City of New York, State of New York.

John P. Brown
Registered Professional Engineer

RECORD OF SURVEY FOR THE

SW 1/4, SW 1/4, SW 1/4

SEC 13, T 203, R 6E

CLARK CO. NEV.

For a true and correct

Map Scale