



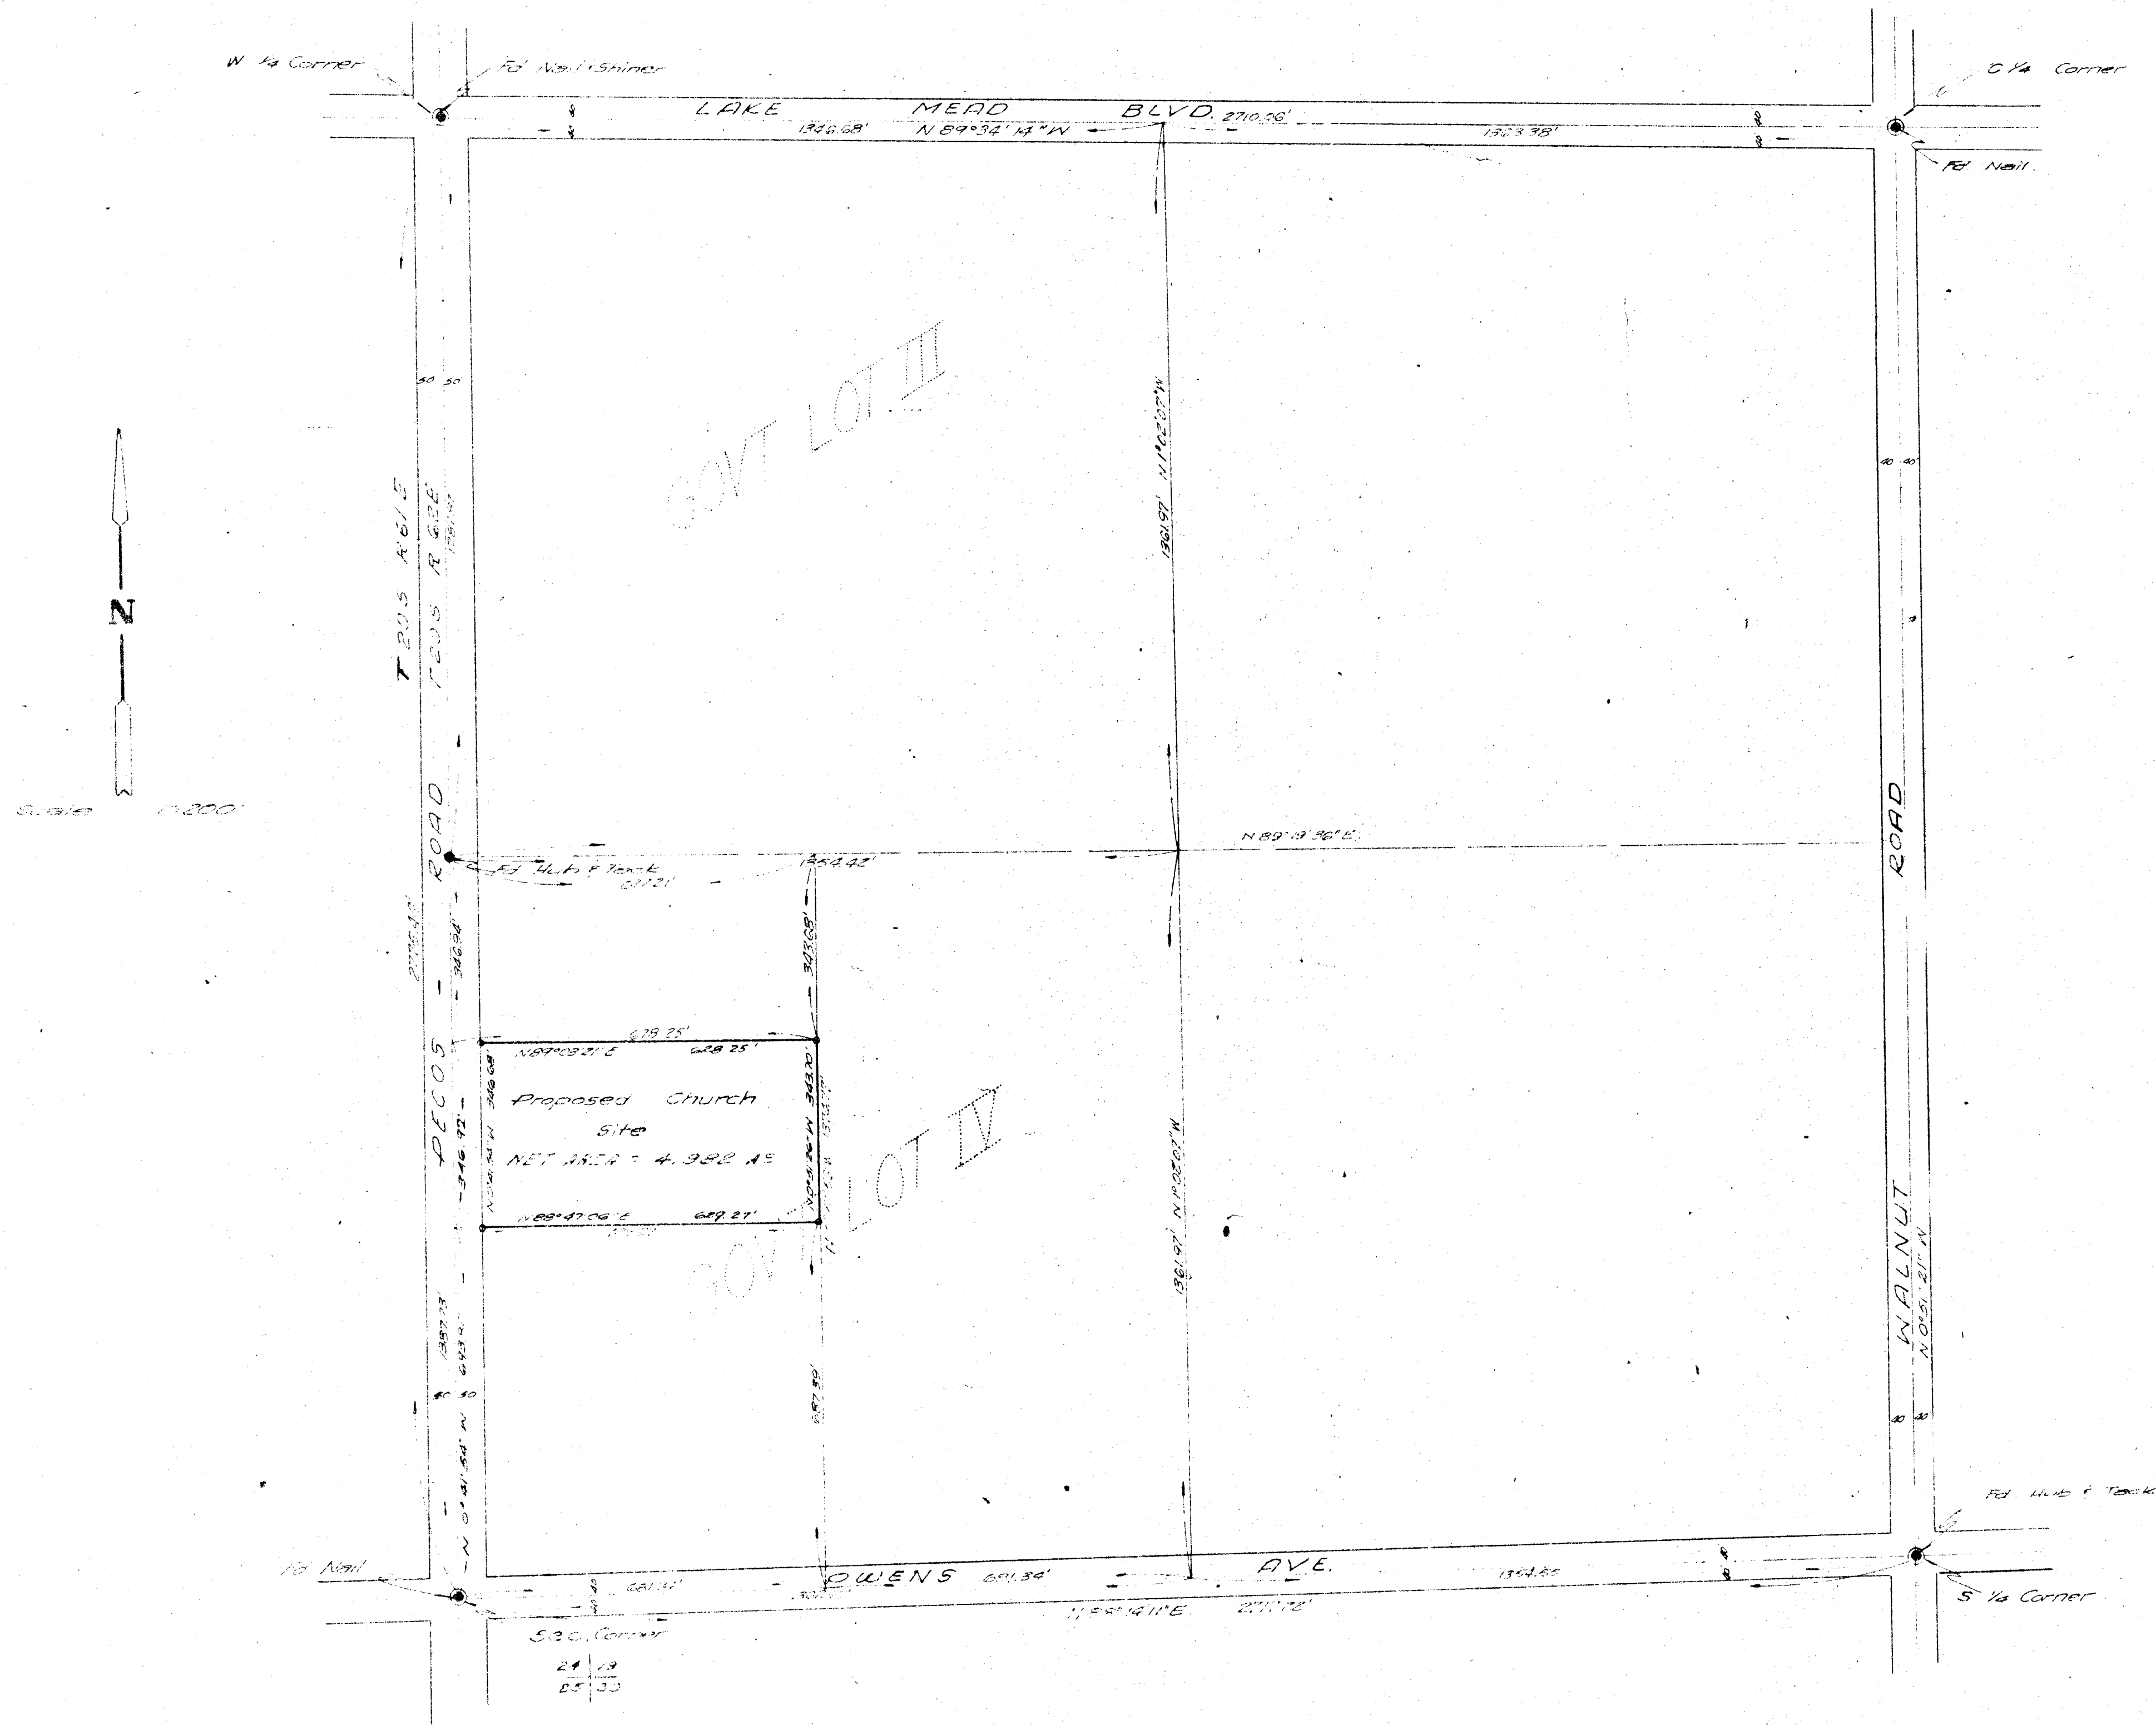

CERTIFICATE

I, Jack K. Leavitt, Registered Professional Engineer and Land Surveyor, do hereby certify that this map is a true and accurate representation of the lands shown hereon. All points found or set are correctly designated. This survey was completed on November 12, 1963, at the instance of the Board of Trustees of the Church of Jesus Christ of Latter-day Saints, and does not constitute a subdivision as defined by Nevada State Law.

JACK K. LEAVITT
 REGISTERED PROFESSIONAL ENGINEER
 LAND SURVEYOR RLS 807

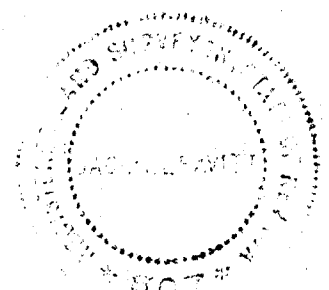

LEGEND

Indicates point found - as shown
 Indicates point set - 3/4" iron pipe RLS 807

BASIS OF BEARING - 2 PEGOS RD. N 0°41'54" W

NO. 4-1185
 RECORDED AT THE REQUEST OF
 JACK K. LEAVITT
 DATE: 12-12-63
 OFFICIAL RECORDS BOOK NO. 67
 CLARK COUNTY, NEVADA
 PAUL E. MOORE, RECORDER
 FEB 5 1964
 DEPUTY

SURVEY MAP
 THE 88, NW 1/4 GOVT LOT 4-SEC.
 19, T20S, R62E, MDB&M
 CLARK COUNTY, NEVADA

SURVEYED BY
JACK K. LEAVITT
 Registered Professional Engineer
 Land Surveyor RLS 807