


13-56

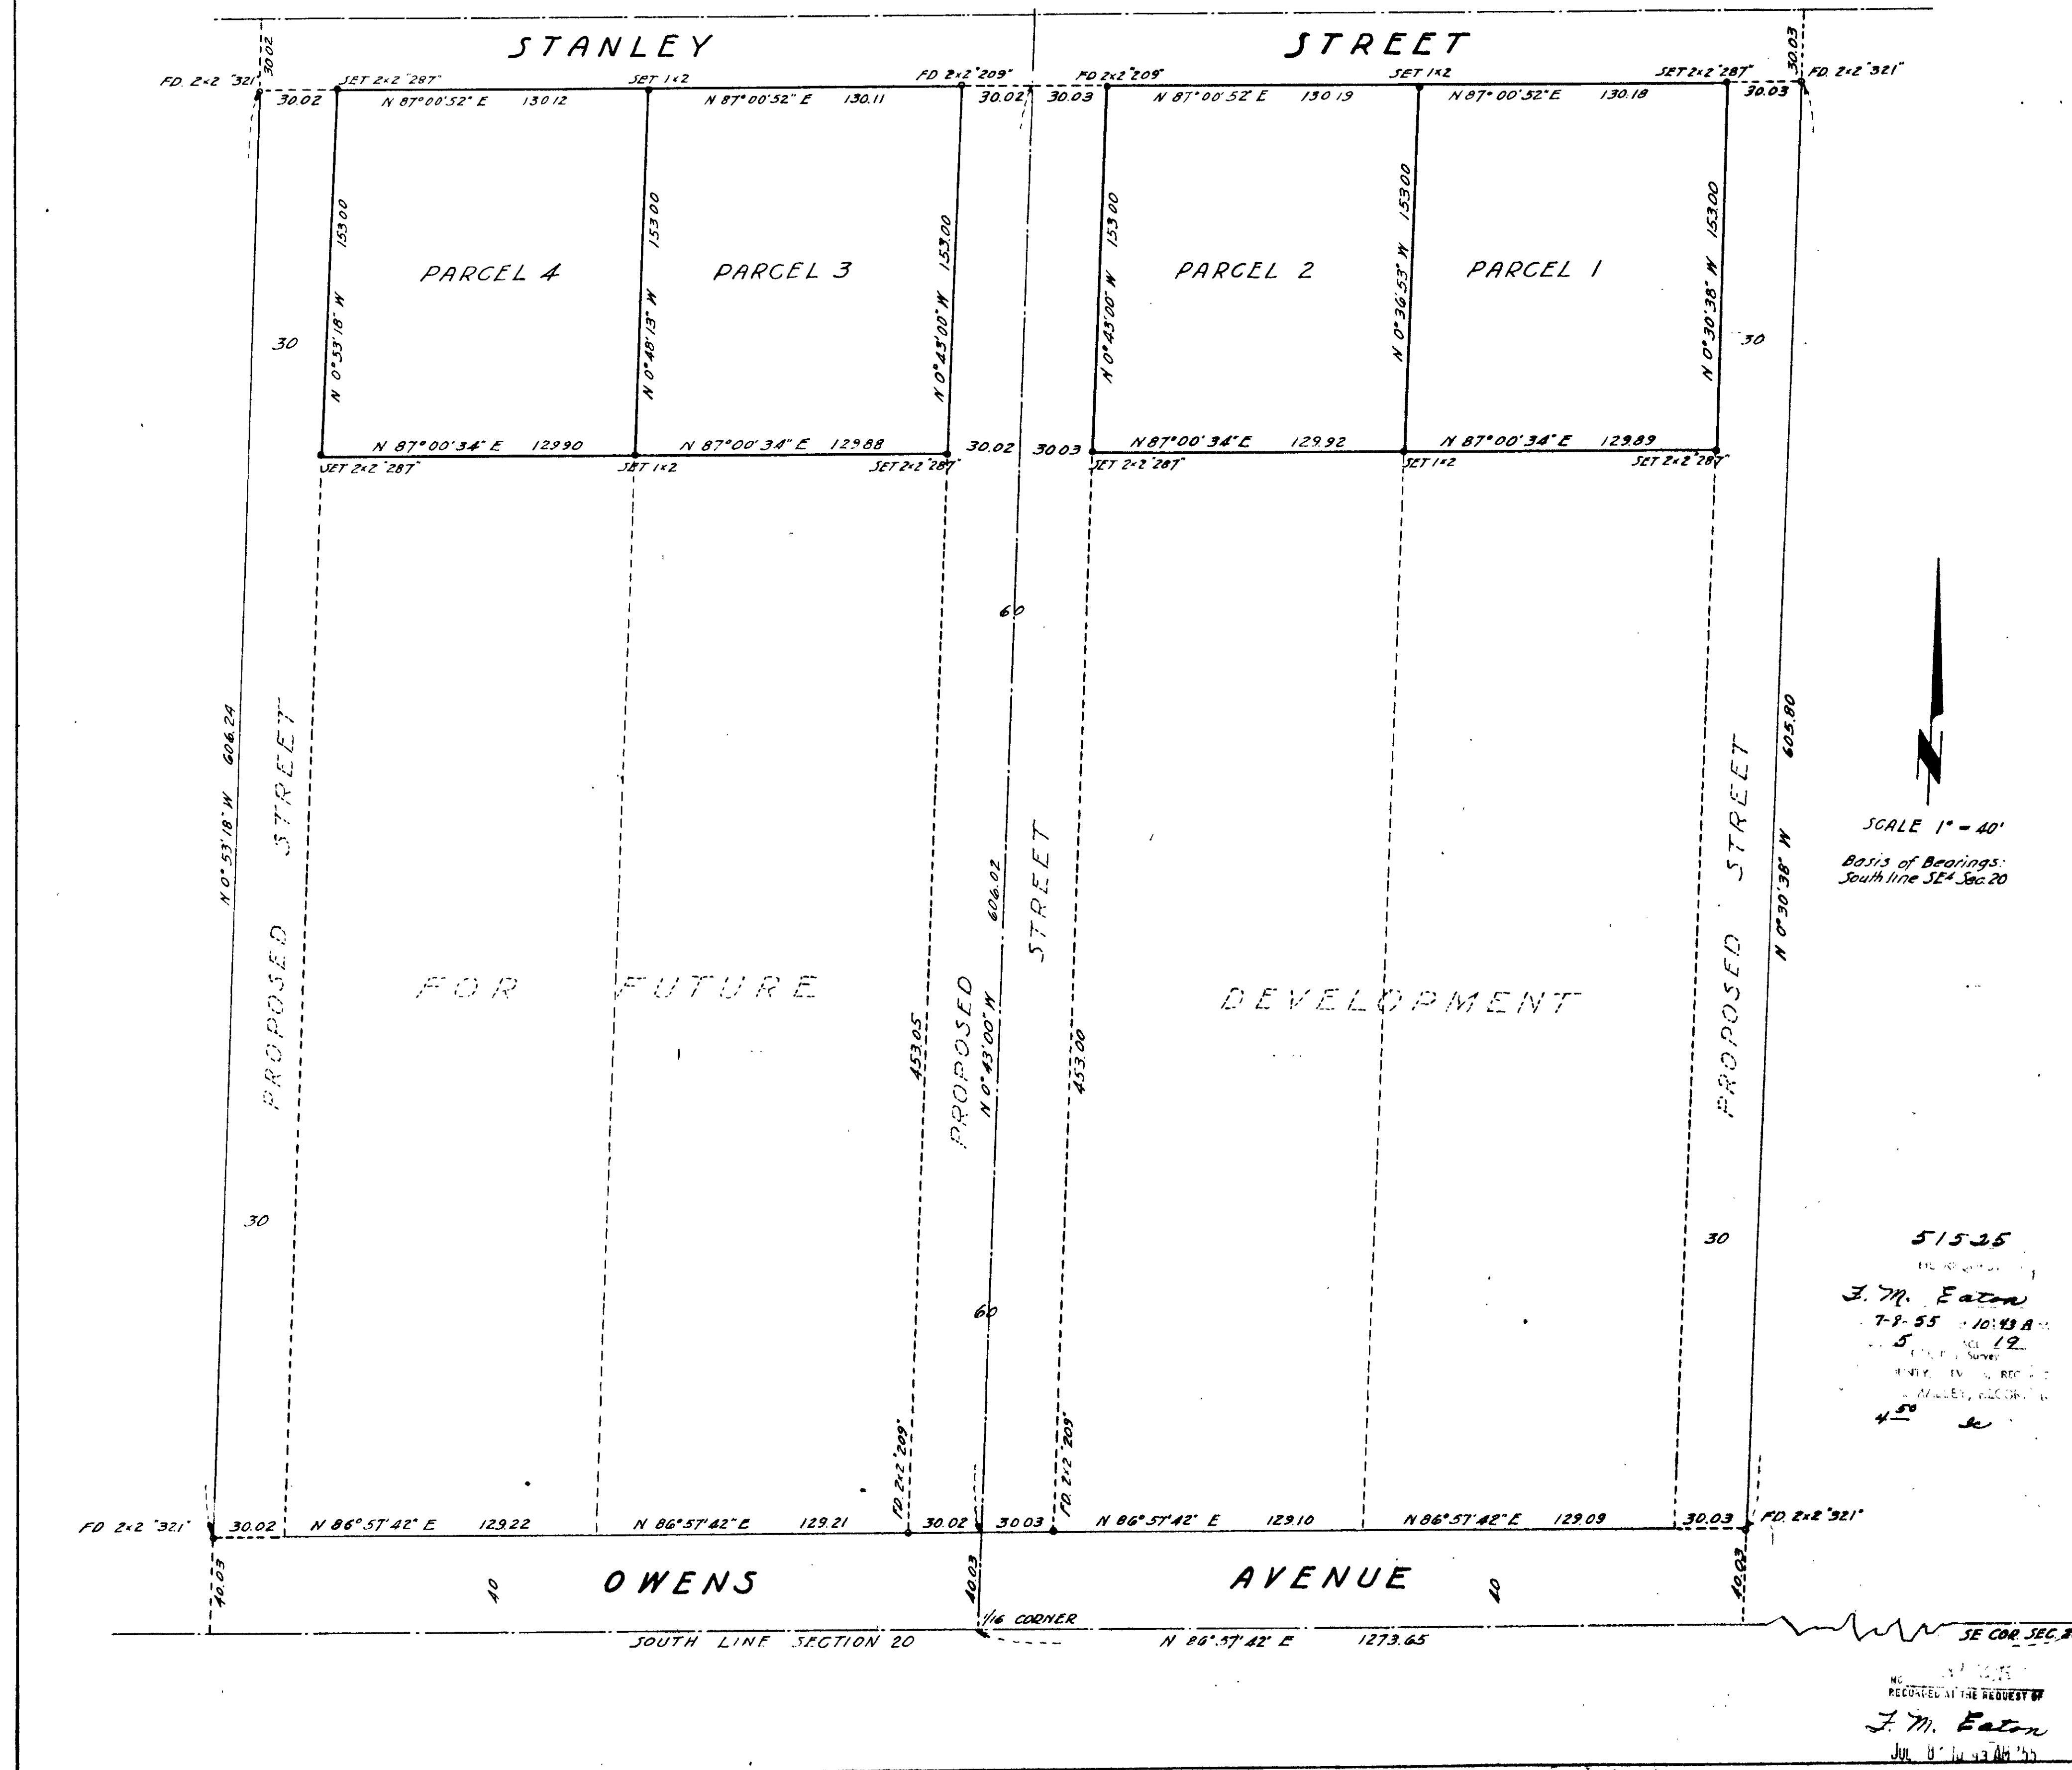

CERTIFICATE OF SURVEY
 I, J. M. Eaton, a duly Registered Civil Engineer and Land Surveyor, do hereby certify that the points found and the points set as plotted on the accompanying map accurately represent a survey made by me at the instance of ELSIE M. PAULL, and completed July 4th, 1955.
J. M. Eaton
 REGISTERED CIVIL ENGINEER & LAND SURVEYOR, NEV. 287

SURVEY OF
E2 SE4 SW4 SE4
W2 SW4 SE4 SE4
SECTION 20 T.20S. R.62E.
FOR
ELSIE M. PAULL
LAS VEGAS - NEVADA