


13-53

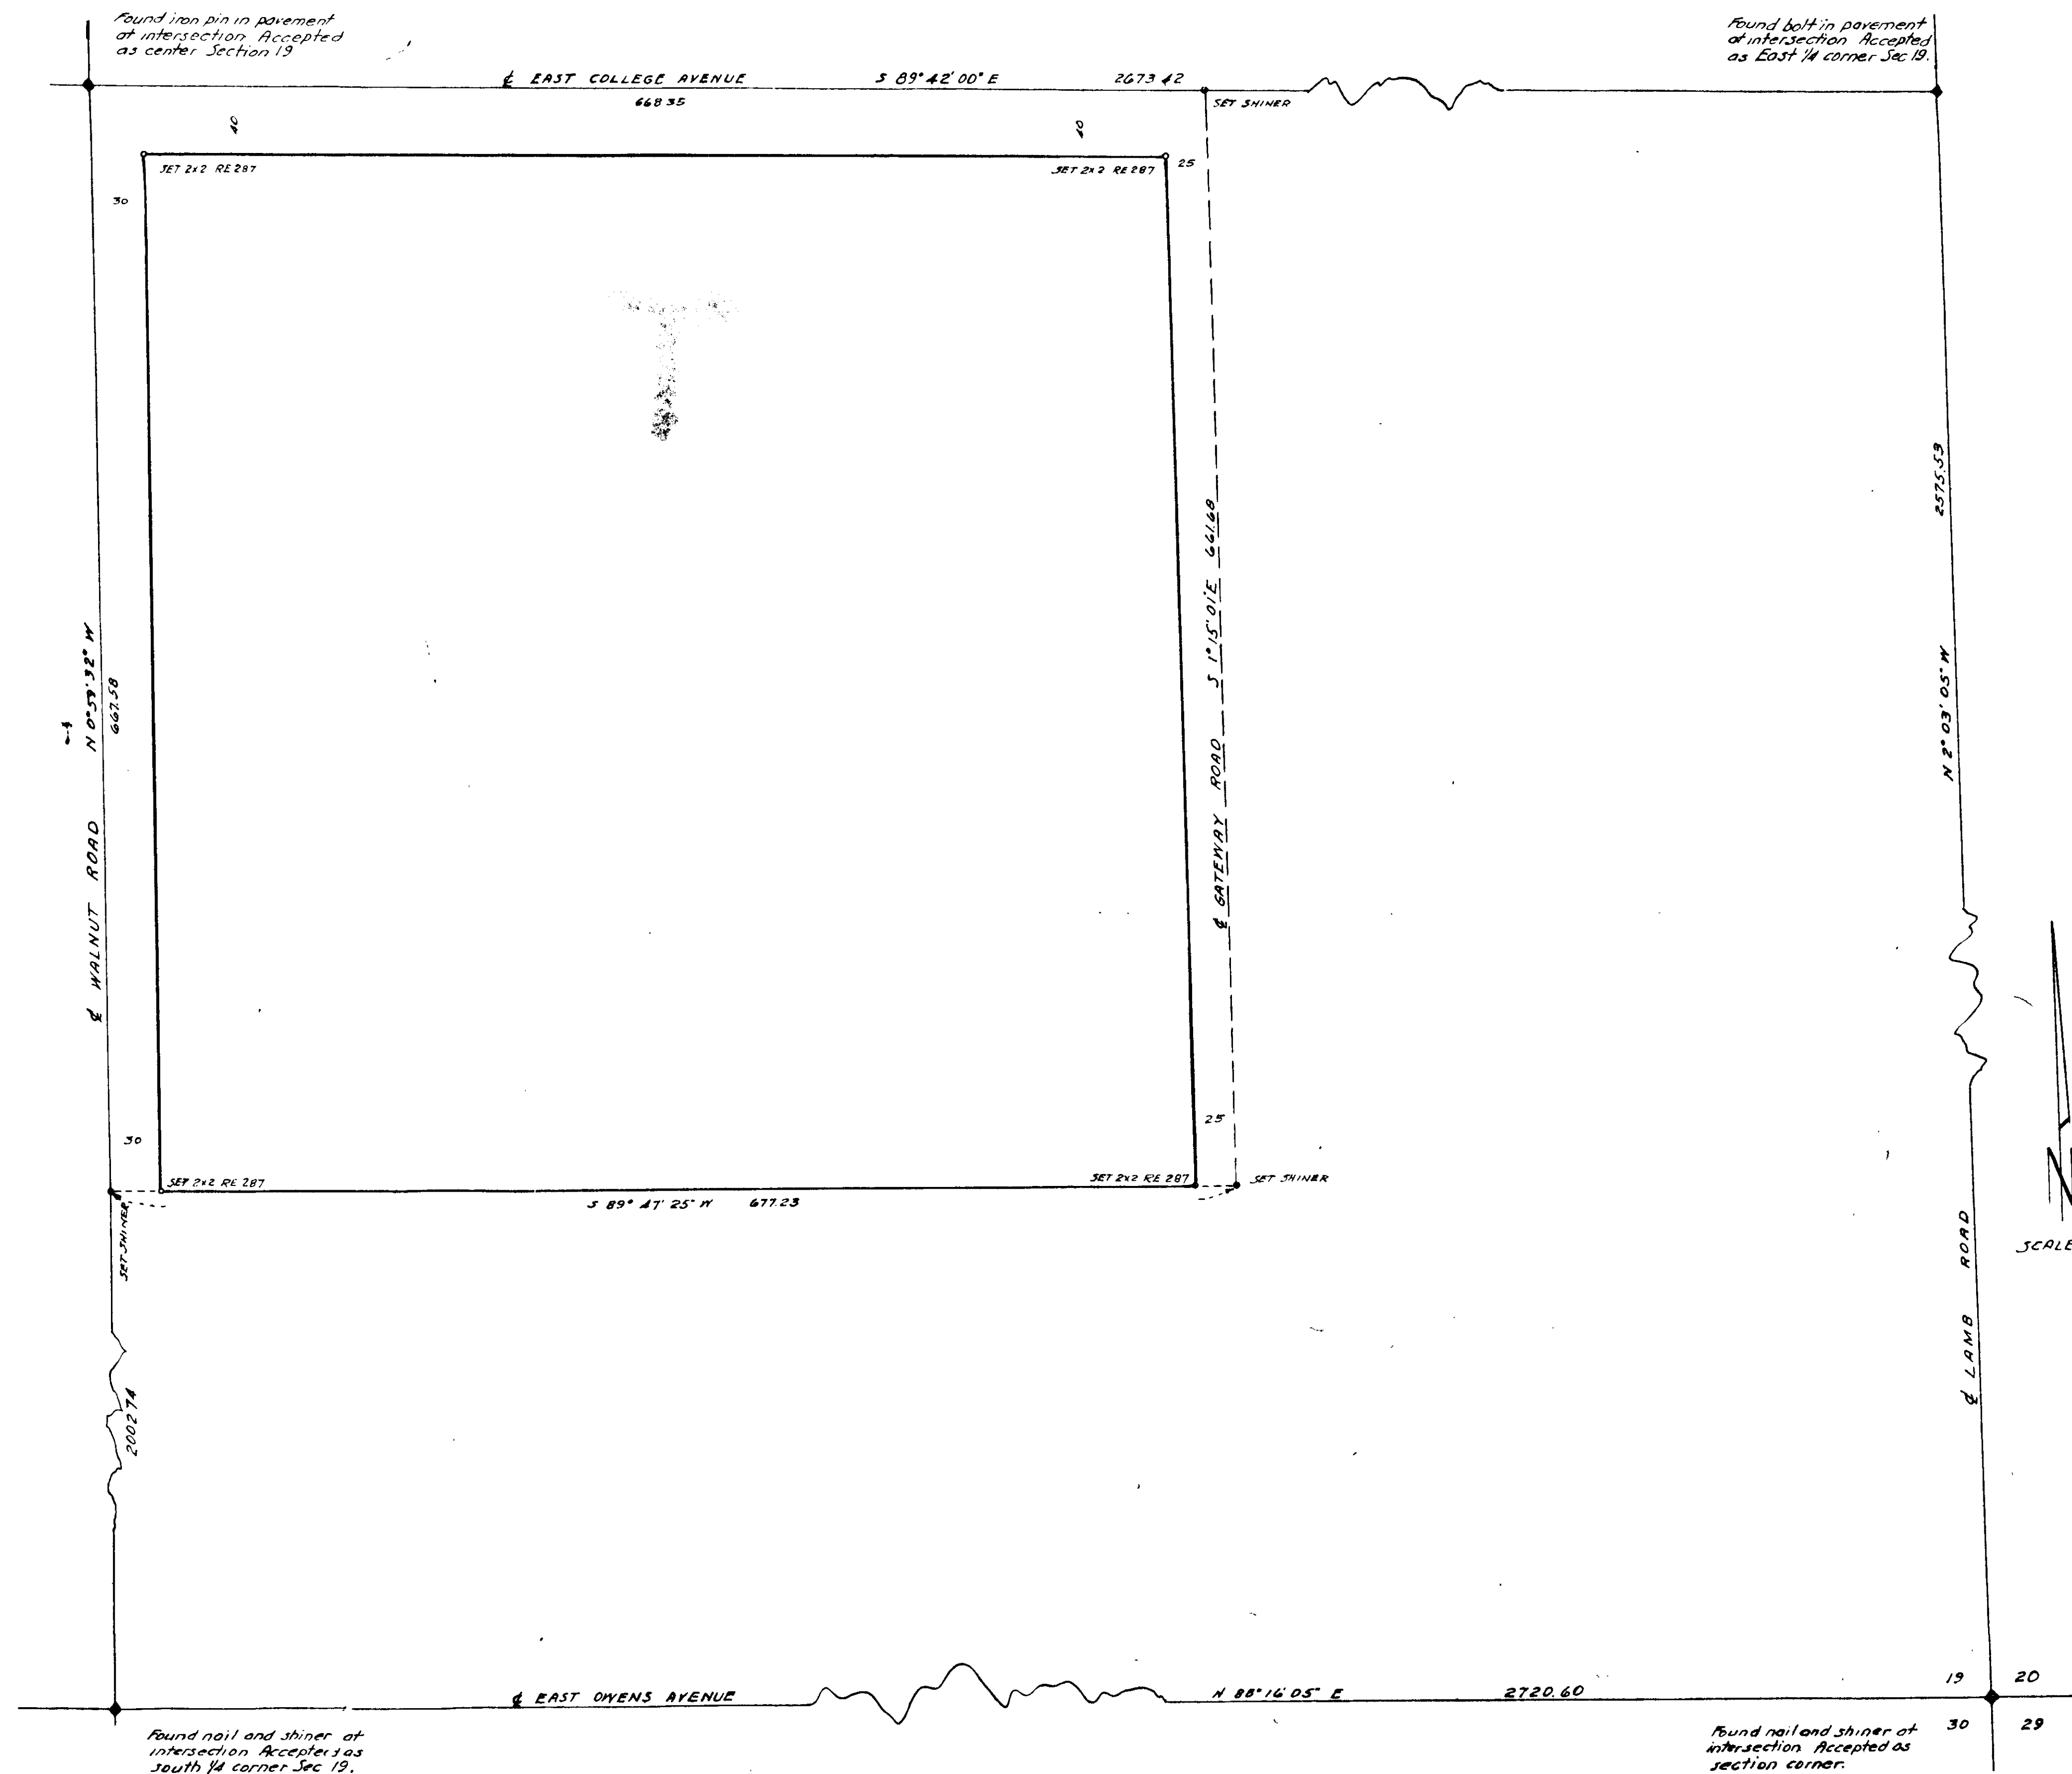

ENGINEER'S CERTIFICATE

I, F.M. Eaton, a duly Registered Civil Engineer and Land Surveyor, do hereby certify that this map truly and correctly represents the results of a survey made by me of the NW 1/4 NW 1/4 SE 1/4 Sec. 19, T. 20 S., R. 62 E., MDB & M. of the instance of WILLIAM PERRY, owner of said tract of land. Points found and points set are as shown hereon. This survey was completed on the 13th day of April, 1959. It is not intended as a subdivision.

F.M. Eaton
REGISTERED CIVIL ENGINEER & LAND SURVEYOR NEVADA 287

Basis of Bearings:
North line of SE 1/4 Sec 19 N 89° 42' W as shown on plat of METZ TRACT, Book 2 of Plats, Page 57.

SCALE 1" = 60'

RECORDER'S ST.

158242
FILED IN THE RECORDS OF
F.M. Eaton
4-17-59 11:26
FILE 8 PAGE 33
CITY OF LAS VEGAS
COUNTY OF CLAY, NV
2.52