


13-113

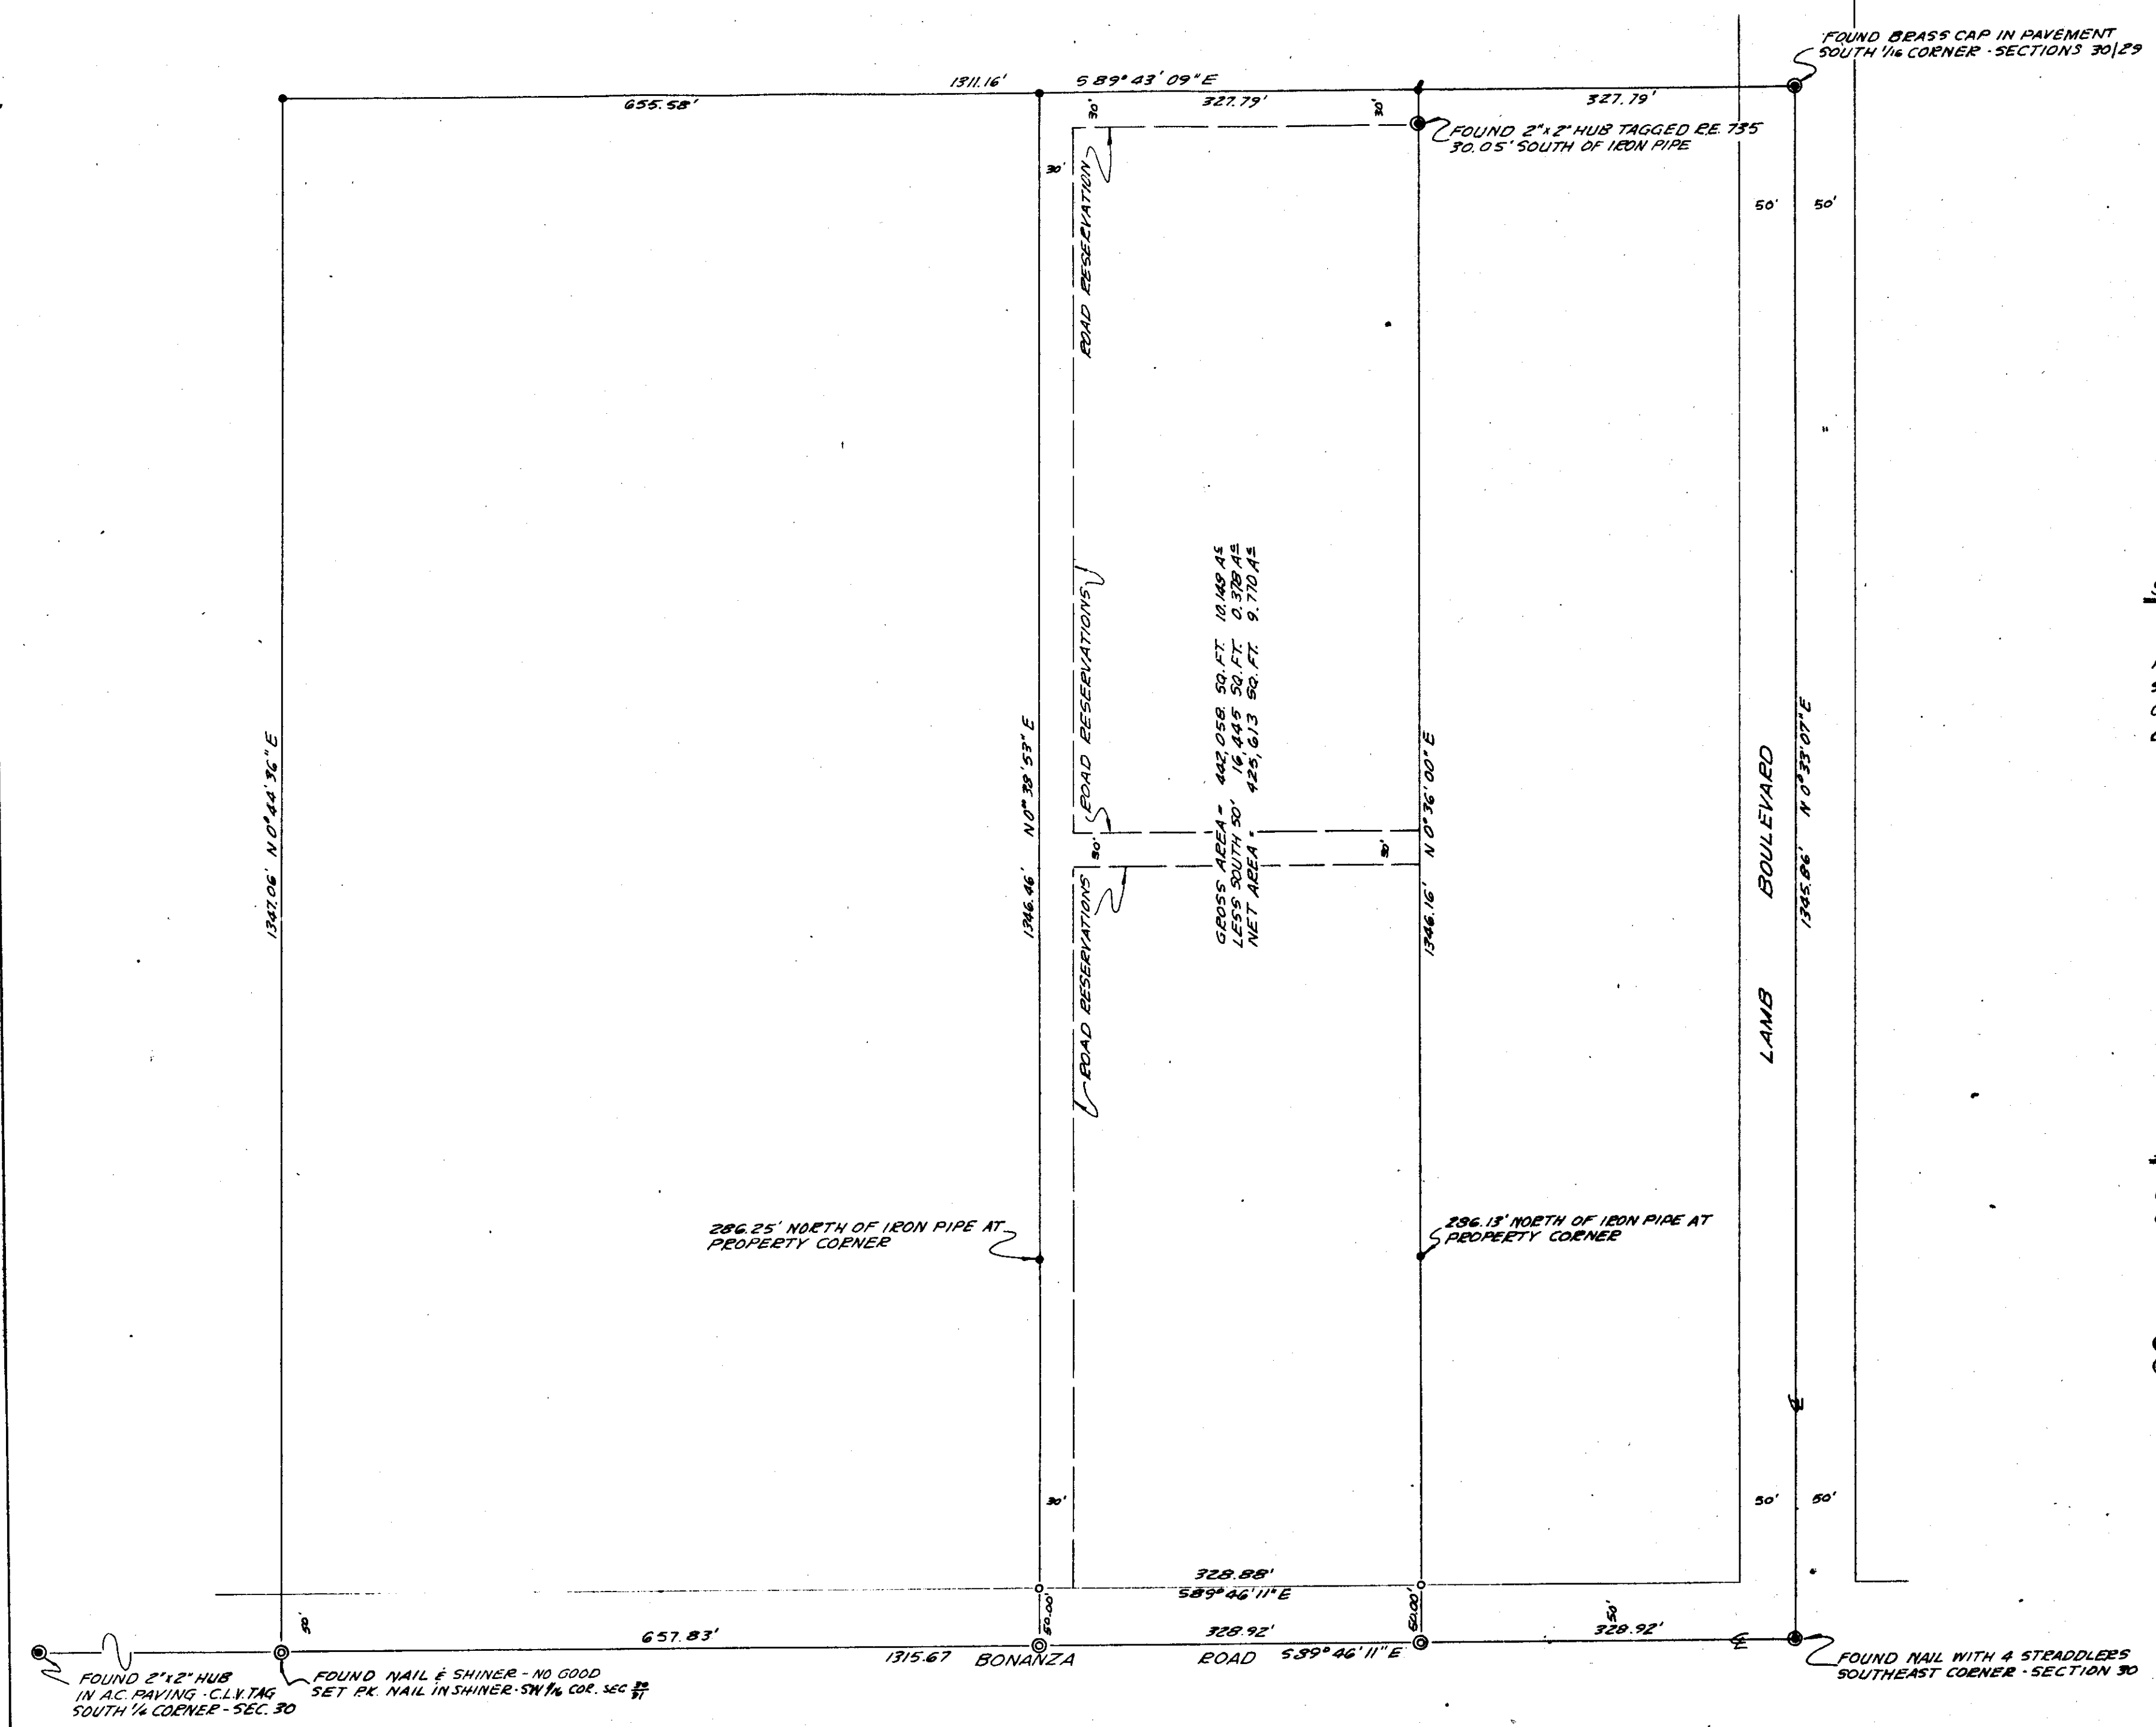

S E R T I T S A T E

I, Jack E. Leavitt, Registered Professional Engineer and Land Surveyor, do hereby certify that this map is a true and accurate representation of the lands shown hereon. All points found or set are correctly designated. This survey was completed on June 10, 1964 at the instance of Jack Miller and associates. This survey does not constitute a subdivision as defined by Nevada State Law.

Jack E. Leavitt
 JACK E. LEAVITT
 Registered Professional Engineer
 Land Surveyor R.L.S.807

- L E T E N D
- Indicates point found - 3/4" iron pipe tagged R.E. 675
 - Indicates point set - 3/4" iron pipe tagged R.L.S.807
 - Basis of Bearings: The East line of the SE 1/4 Section 30, T.20S, R.62E., as per R.P.E. File 2 Page 61, Clark County, Nevada Official Records.
 - Reference Survey: R.P.E. File 2, Page 61.
 - Scale: 1"=100'
 - Indicates point found - as shown
 - Indicates point set - nail & shiner

SCALE:

NO 441639
 FILED AT THE REQUEST OF
 Jack E. Leavitt
 Date 8-22-64 at 10:09 AM
 FILE 14 PAGE 95
 of Surveys
 OFFICIAL RECORDS BOOK NO 549
 CLARK COUNTY NEVADA RECORDS
 PAUL E. HORN RECORDER
 Fee \$ 3.50 MS Deputy

S U R V E Y M A P
 W 1/2 SE 1/4 SECTION 30, T.20S, R.62E., M.D.M.,
 CLARK COUNTY, NEVADA

Surveyed by:
 JACK E. LEAVITT
 Registered Professional Engineer
 Land Surveyor R.L.S.807

Scale: 1"=100'